HEIFER INTERNATIONAL CENTER
OFFICE BUILDING
LITTLE ROCK, ARKANSAS

PROJECT NO. 431C

JULY 1, 2004

100% ROLL-UP PACKAGE #7 - VOLUME 1

HEIFER INTERNATIONAL

v1

GENERAL

		FIRST ISSUED
G000	COVER SHEET WITH INDEX TO DRAWINGS	2-2-2004
G002	AERIAL PHOTOGRAPHIC OVERVIEW	11-17-2003
TS101	TOPOGRAPHIC & BOUNDARY SURVEY	11-17-2003

CIVIL

		FIRST ISSUED
C101	SITE EROSION CONTROL PLAN	11-17-2003
C102	SITE EROSION CONTROL DETAILS	11-17-2003
C201	SITE LAYOUT PLAN	12-15-2003
C211	PRELIMINARY SITE PLAN/LAYOUT	11-17-2003
C301	SITE DRAINAGE PLAN	12-15-2003
C302	SITE DRAINAGE PLAN	12-15-2003
C303	SITE DRAINAGE PLAN	12-15-2003
C311	SITE GRADING PLAN	11-17-2003
C312	ROUGH GRADING PLAN	11-17-2003
C313	ROUGH GRADING PLAN	11-17-2003
C401	SITE DRAINAGE LAYOUT	12-15-2003
C402	SITE DRAINAGE PLAN	12-15-2003
C403	SITE DRAINAGE PLAN	12-15-2003
C404	SITE DRAINAGE DETAILS	12-15-2003
C405	SITE DRAINAGE DETAILS	12-15-2003
C406	SITE DRAINAGE PROFILES	12-15-2003
C407	SITE DRAINAGE PROFILES	12-15-2003
C408	SITE DRAINAGE FORCEMAIN PROFILES	12-15-2003
C409	SITE DRAINAGE PLAN & PROFILE	12-15-2003
C501	SITE UTILITY LAYOUT	12-15-2003
C502	SITE UTILITY PLAN	12-15-2003
C503	SITE UTILITY DETAILS	12-15-2003
C504	SITE UTILITIES DETAILS	12-15-2003
C601	SITE PAVING LAYOUT	12-15-2003
C602	SITE PAVING PLAN	12-15-2003
C603	SITE PAVING PLAN	12-15-2003
C604	SITE PAVING DETAILS	12-15-2003
C701	GREY WATER VESSEL PLAN	12-15-2003

LANDSCAPE

		FIRST ISSUED
L101	SITE LANDSCAPE SHEET KEY AND DEDUCT ALTERNATE NO. 1 LIMITS	12-15-2003
L102	ENTRY GR. DRAIN/LAYOUT PLAN & DTLS.	12-15-2003
L103	EAST BLDG. GRADING AND DRAIN PLAN	12-15-2003
L104	WEST BLDG. GRADING AND DRAIN PLAN	12-15-2003
L105	SOUTH 3rd ST. WETLAND GRADING PLAN	12-15-2003
L106	SOUTH WETLAND CHANNEL DETAILS	12-15-2003
L107	NORTH WETLAND CHANNEL DETAILS	12-15-2003
L108	S. 3rd ST. WETLAND & BOARDWALK DETAILS	12-15-2003
L109	BOARDWALK LANDBRIDGE AND MISC. SITE DETAILS	1-16-2004
L201	SITE PLANTING PLAN	12-15-2003
L202	ENTRY PLANTING PLAN	12-15-2003
L203	BIOSWALE GRADING PLANTING AND DETAILS	12-15-2003
L204	PLANT LIST AND DETAILS	12-15-2003
L205	SOUTH 3rd ST. WETLAND PLANTING PLAN	12-15-2003
L206	RETENTION PLANTING PLAN	12-15-2003
L207	BIOSWALE GRADING PLANTING & DETAILS	12-15-2003
L208	PHASE I PLANT LIST AND DETAILS	12-15-2003
L209	PHASE IIA PLANT LIST AND DETAILS	12-15-2003
L301	SITE IRRIGATION PLAN - EAST	12-15-2003
L302	SITE IRRIGATION PLAN - WEST	12-15-2003
L303	IRRIGATION LEGEND NOTES AND DETAILS	12-15-2003

v2

ARCHITECTURAL

		FIRST ISSUED
G001	GENERAL DATA SHEET	7-15-2003
G003	COLUMN LOCATION PLAN	12-15-2003
A100	BASEMENT FLOOR PLAN	11-17-2003
A100a	BASEMENT FLOOR PLAN	11-17-2003
A101a	FIRST FLOOR PLAN-EAST END	12-15-2003
A101b	FIRST FLOOR PLAN-WEST END	12-15-2003
A101c	FIRST FLOOR CEILING PLAN-EAST END	12-15-2003
A101d	FIRST FLOOR CEILING PLAN-WEST END	12-15-2003
A102a	SECOND FLOOR PLAN-EAST END	12-15-2003
A102b	SECOND FLOOR PLAN-WEST END	12-15-2003
A102c	SECOND FLOOR CEILING PLAN-EAST END	2-2-2004
A102d	SECOND FLOOR CEILING PLAN-WEST END	2-2-2004
A103a	THIRD FLOOR PLAN-EAST END	12-15-2003
A103b	THIRD FLOOR PLAN-WEST END	12-15-2003
A103c	THIRD FLOOR CEILING PLAN-EAST END	2-2-2004
A103d	THIRD FLOOR CEILING PLAN-WEST END	2-2-2004
A104a	FOURTH FLOOR PLAN-EAST END	12-15-2003
A104b	FOURTH FLOOR PLAN-WEST END	12-15-2003
A104c	FOURTH FLOOR CEILING PLAN-EAST END	12-15-2003
A104d	FOURTH FLOOR CEILING PLAN-WEST END	12-15-2003
A105	ROOF PLAN	12-15-2003
A201	NORTH BUILDING ELEVATION	12-15-2003
A202	SOUTH BUILDING ELEVATION	12-15-2003
A203	EAST AND WEST BUILDING ELEVATIONS	12-15-2003
A301	BUILDING CROSS SECTION	12-15-2003
A302	BUILDING CROSS SECTION	12-15-2003
A303	BUILDING CROSS SECTION	12-15-2003
A304	BUILDING CROSS SECTION	12-15-2003
A305	BUILDING CROSS SECTION	7-1-2004
A306	BUILDING CROSS SECTION	7-1-2004
A401	COLUMN DETAILS	12-15-2003
A420	ROOF TREE SECTION	12-15-2003
A421	ROOF DETAILS	12-15-2003
A422	SEISMIC JOINT AND ROOF DETAILS	7-1-2004
A430	SECTIONS DETAILS	12-15-2003
A431	SECTION DETAILS	12-15-2003
A432	SECTION DETAILS	12-15-2003
A433	SECTIONS AND PLAN AT NORTH LAND BRIDGE	12-15-2003
A434	WALL SECTION DETAILS	12-15-2003
A435	SECTION DETAILS	12-15-2003
A436	SECTION DETAILS	12-15-2003
A440	DETAILS AT CORRUG MTL & ALUM COMP PANELS	12-15-2003
A480	WALL CONNECTIONS TO ROOF DETAILS	12-15-2003
A500	PARTITION SCHEDULE	2-2-2004
A501	DOOR AND FRAME SCHEDULE	2-2-2004
A502	DOOR AND FRAME SCHEDULE	2-2-2004
A503	INTERIOR FINISH SCHEDULE	12-15-2003
A504a	WINDOW SCHEDULE	12-15-2003
A504b	WINDOW SCHEDULE	12-15-2003
A506	DOOR DETAILS	2-2-2004
A507	DOOR DETAILS	2-2-2004
A508	DOOR DETAILS	12-15-2003
A509	DOOR DETAILS	7-1-2004
A510	SUNSHADE DETAILS	12-15-2003
A511	DETAILS AT ALUM. CURTAIN WALL	12-15-2003
A512	DETAILS AT ALUM. CURTAIN WALL	12-15-2003

ARCHITECTURAL

		FIRST ISSUED
A401	ENLARGED PLANS - ELEVATOR CORE	12-15-2003
A401a	ENLARGED PLANS - ELEVATOR CORE	12-15-2003
A401b	STAIR 3 SECTION	12-15-2003
A401c	ELEVATOR & STAIR CORE DETAILS	12-15-2003
A401d	SECTION DETAILS	12-15-2003
A401e	SECTION DETAILS	12-15-2003
A402	ENLARGED PLANS, SECTION - STAIR 1	12-15-2003
A403	ENLARGED PLANS - STAIR 2 AND FREIGHT ELEVATOR	12-15-2003
A403a	FREIGHT ELEVATOR SECTIONS	12-15-2003
A403b	STAIR 2 DETAILS	12-15-2003
A404	ENLARGED TOILET PLANS	12-15-2003
A101	INTERIOR ELEVATIONS	2-2-2004
A102	INTERIOR ELEVATIONS	2-2-2004
A103	INTERIOR ELEVATIONS	2-2-2004
A104	INTERIOR ELEVATIONS	2-2-2004
A901a	RAISED FIRST FLOOR PLAN-EAST END	7-15-2003
A901a(2)	1st FLR. RAISED FLR. INSTALLATION PLAN-EAST END	2-2-2004
A901b	RAISED FIRST FLOOR PLAN-WEST END	7-15-2003
A901b(2)	1st FLR. RAISED FLR. INSTALLATION PLAN-WEST END	2-2-2004
A902a	RAISED SECOND FLOOR PLAN-EAST END	7-15-2003
A902a(2)	2nd FLR. RAISED FLR. INSTALLATION PLAN - EAST END	2-2-2004
A902b	RAISED SECOND FLOOR PLAN-WEST END	7-15-2003
A902b(2)	2nd FLR. RAISED FLR. INSTALLATION PLAN - WEST END	2-2-2004
A903a	RAISED THIRD FLOOR PLAN-EAST END	7-15-2003
A903a(2)	3rd FLR. RAISED FLR. INSTALLATION PLAN - EAST END	2-2-2004
A903b	RAISED THIRD FLOOR PLAN-WEST END	7-15-2003
A903b(2)	3rd FLR. RAISED FLR. INSTALLATION PLAN - WEST END	2-2-2004
A904a	RAISED FOURTH FLOOR PLAN-EAST END	7-15-2003
A904a(2)	4th. FLR. RAISED FLR. INSTALLATION PLAN - EAST END	2-2-2004
A904b	RAISED FOURTH FLOOR PLAN-WEST END	7-15-2003
A904b(2)	4th. FLR. RAISED FLR. INSTALLATION PLAN - WEST END	2-2-2004
A990a	1st. FLR. MOVABLE PART. PLAN-EAST END	7-15-2003
A990b	1st. FLR. MOVABLE PART. PLAN-WEST END	7-15-2003
A991a	2nd. FLR. MOVABLE PART. PLAN-EAST END	7-15-2003
A991b	2nd. FLR. MOVABLE PART. PLAN-WEST END	7-15-2003
A992a	3rd. FLR. MOVABLE PART. PLAN-EAST END	7-15-2003
A992b	3rd. FLR. MOVABLE PART. PLAN-WEST END	7-15-2003
A993a	4th. FLR. MOVABLE PART. PLAN-EAST END	7-15-2003
A993b	4th. FLR. MOVABLE PART. PLAN-WEST END	7-15-2003

v3

STRUCTURAL

		FIRST ISSUED
S001	STRUCT. QUALITY CONTROL & GEN. NOTES	11-17-2003
S002	PLAN OF UNDERCUTS & PLAN OF SLAB ELEV'S AND THICKNESS AT FIRST FLOOR	11-17-2003
S100	BASEMENT FOUNDATION AND SLAB PLANS	11-17-2003
S101a	FOUNDATION PLAN - EAST END	11-17-2003
S101b	FOUNDATION PLAN - WEST END	11-17-2003
S101c	SLAB ON GR. & 1st. FLR. FRAMING PLAN - EAST END	11-17-2003
S101d	SLAB ON GRADE PLAN - WEST END	11-17-2003
S102a	SECOND FLOOR FRAMING PLAN - EAST END	11-17-2003
S102b	SECOND FLOOR FRAMING PLAN - WEST END	11-17-2003
S103a	THIRD FLOOR FRAMING PLAN - EAST END	11-17-2003
S103b	THIRD FLOOR FRAMING PLAN - WEST END	11-17-2003
S104a	FOURTH FLOOR FRAMING PLAN - EAST END	11-17-2003
S104b	FOURTH FLOOR FRAMING PLAN - WEST END	11-17-2003
S105a	ROOF FRAMING PLAN - EAST END	11-17-2003
S105b	ROOF FRAMING PLAN - WEST END	11-17-2003
S200	STAIR #1 FRAMING PLAN	12-15-2003
S201	STAIR #2 FRAMING PLAN	12-15-2003
S202	STAIR #3 FRAMING PLAN	12-15-2003
S203	STAIR #3 DETAILS	12-15-2003
S204	STAIR SECTIONS	12-15-2003
S205	STAIR SECTIONS	12-15-2003
S300	SHEAR WALL ELEVATIONS	1-18-2004
S301	SHEAR WALL ELEVATIONS	1-18-2004
S302	SHEAR WALL ELEVATIONS	1-18-2004
S400	SLAB AND FOUNDATION DETAILS	11-17-2003
S401	SLAB AND FOUNDATION DETAILS	11-17-2003
S402	SLAB AND FOUNDATION DETAILS	11-17-2003
S403	SLAB AND FOUNDATION DETAILS	11-17-2003
S500	FLOOR FRAMING DETAILS	11-17-2003
S501	FLOOR FRAMING DETAILS	11-17-2003
S502	FLOOR FRAMING DETAILS	11-17-2003
S600	ROOF FRAMING DETAILS	11-17-2003
S601	ROOF FRAMING DETAILS	12-1-2003
S100	STUD WALL DETAILS	12-15-2003

MECHANICAL

		FIRST ISSUED
M000	MECHANICAL LEGENDS	12-15-2003
M001	MECHANICAL SITE PLAN	12-15-2003
M100	BASEMENT HVAC PLAN	12-15-2003
M101a	FIRST FLOOR HVAC PLAN - EAST END	12-15-2003
M101b	FIRST FLOOR HVAC PLAN - WEST END	12-15-2003
M102a	SECOND FLOOR HVAC PLAN - EAST END	12-15-2003
M102b	SECOND FLOOR HVAC PLAN - WEST END	12-15-2003
M103a	THIRD FLOOR HVAC PLAN - EAST END	12-15-2003
M103b	THIRD FLOOR HVAC PLAN - WEST END	12-15-2003
M104a	FOURTH FLOOR HVAC PLAN - EAST END	12-15-2003
M104b	FOURTH FLOOR HVAC PLAN - WEST END	12-15-2003
M105a	1st FLR. HVAC PIPING PLAN - EAST END	12-15-2003
M105b	1st. FLR. HVAC PIPING PLAN - WEST END	12-15-2003
M104a	2nd FLR. HVAC PIPING PLAN - EAST END	12-15-2003
M104b	2nd FLR. HVAC PIPING PLAN - WEST END	12-15-2003
M107a	3rd. FLR. HVAC PIPING PLAN - EAST END	12-15-2003
M107b	3rd. FLR. HVAC PIPING PLAN - WEST END	12-15-2003
M108a	4rd. FLR. HVAC PIPING PLAN - EAST END	12-15-2003
M108b	4rd. FLR. HVAC PIPING PLAN - WEST END	12-15-2003
M109	HVAC ROOF PLAN	12-15-2003
M201	HVAC DETAILS	12-15-2003
M202	HVAC DETAILS	12-15-2003
M203	HVAC DETAILS	12-15-2003
M204	HVAC DETAILS	12-15-2003
M205	HVAC DETAILS	12-15-2003
M206	HVAC DETAILS	12-15-2003
M207	HVAC DETAILS	12-15-2003
M208	HVAC DETAILS	12-15-2003
M301	HVAC SCHEDULES	12-15-2003
M302	HVAC SCHEDULES	12-15-2003
M400	HVAC CONTROLS	12-15-2003
M401	HVAC CONTROLS	12-15-2003
M402	HVAC CONTROLS	12-15-2003
M403	HVAC CONTROLS	12-15-2003
M404	HVAC CONTROLS	12-15-2003
M405	HVAC CONTROLS	12-15-2003
M406	HVAC CONTROLS	12-15-2003

PLUMBING

		FIRST ISSUED
P100	BASEMENT PLUMBING PLAN	12-15-2003
P101a	FIRST FLOOR PLUMBING PLAN - EAST END	12-15-2003
P101b	FIRST FLOOR PLUMBING PLAN - WEST END	12-15-2003
P102a	SECOND FLOOR PLUMBING PLAN - EAST END	12-15-2003
P102b	SECOND FLOOR PLUMBING PLAN - WEST END	12-15-2003
P103a	THIRD FLOOR PLUMBING PLAN - EAST END	12-15-2003
P103b	THIRD FLOOR PLUMBING PLAN - WEST END	12-15-2003
P104a	FOURTH FLOOR PLUMBING PLAN - EAST END	12-15-2003
P104b	FOURTH FLOOR PLUMBING PLAN - WEST END	12-15-2003
P105a	ROOF PLUMBING PLAN - EAST END	12-15-2003
P105b	ROOF PLUMBING PLAN - WEST END	12-15-2003
P201	PLUMBING RISER DIAGRAMS	12-15-2003
P301	PLUMBING DETAILS	12-15-2003
P302	PLUMBING DETAILS	12-15-2003
P401	PLUMBING NOTES AND SCHEDULES	12-15-2003

FIRE ALARM

		FIRST ISSUED
FA001	FIRE ALARM DETAILS	12-15-2003
FA100	BASEMENT FIRE ALARM PLAN	12-15-2003
FA101a	1st FLOOR FIRE ALARM PLAN - EAST END	12-15-2003
FA101b	1st FLOOR FIRE ALARM PLAN - WEST END	12-15-2003
FA102a	2nd FLOOR FIRE ALARM PLAN - EAST END	12-15-2003
FA102b	2nd FLOOR FIRE ALARM PLAN - WEST END	12-15-2003
FA103a	3rd FLOOR FIRE ALARM PLAN - EAST END	12-15-2003
FA103b	3rd FLOOR FIRE ALARM PLAN - WEST END	12-15-2003
FA104a	4th FLOOR FIRE ALARM PLAN - EAST END	12-15-2003
FA104b	4th FLOOR FIRE ALARM PLAN - WEST END	12-15-2003

FIRE PROTECTION

		FIRST ISSUED
FP100	BASEMENT FIRE SPRINKLER PLAN	12-15-2003
FP101a	1st FLR. FIRE SPRINKLER PLAN - EAST END	12-15-2003
FP101b	1st FLR. FIRE SPRINKLER PLAN - WEST END	12-15-2003
FP102a	2nd FLR. FIRE SPRINKLER PLAN - EAST END	12-15-2003
FP102b	2nd FLR. FIRE SPRINKLER PLAN - WEST END	12-15-2003
FP103a	3rd FLR. FIRE SPRINKLER PLAN - EAST END	12-15-2003
FP103b	3rd FLR. FIRE SPRINKLER PLAN - WEST END	12-15-2003
FP104a	4th FLR. FIRE SPRINKLER PLAN - EAST END	12-15-2003
FP104b	4th FLR. FIRE SPRINKLER PLAN - WEST END	12-15-2003
FP301	UNDERGROUND FIRE LINE PLAN	12-15-2003

ELECTRICAL

		FIRST ISSUED
E000	ELECT. SYMBOLS & LIGHT FIXTURE SCHED.	12-15-2003
E001	ELECTRICAL SITE PLAN	12-15-2003
E100	BASEMENT LIGHTING PLAN	12-15-2003
E101a	FIRST FLR. LIGHTING PLAN - EAST END	12-15-2003
E101b	FIRST FLR. LIGHTING PLAN - WEST END	12-15-2003
E102a	SECOND FLR. LIGHTING PLAN - EAST END	12-15-2003
E102b	SECOND FLR. LIGHTING PLAN - WEST END	12-15-2003
E103a	THIRD FLR. LIGHTING PLAN - EAST END	12-15-2003
E103b	THIRD FLR. LIGHTING PLAN - WEST END	12-15-2003
E104a	FOURTH FLR. LIGHTING PLAN - EAST END	12-15-2003
E104b	FOURTH FLR. LIGHTING PLAN - WEST END	12-15-2003
E200	BASEMENT POWER PLAN	12-15-2003
E201a	FIRST FLOOR POWER PLAN - EAST END	12-15-2003
E201b	FIRST FLOOR POWER PLAN - WEST END	12-15-2003
E202a	SECOND FLOOR POWER PLAN - EAST END	12-15-2003
E202b	SECOND FLOOR POWER PLAN - WEST END	12-15-2003
E203a	THIRD FLOOR POWER PLAN - EAST END	12-15-2003
E203b	THIRD FLOOR POWER PLAN - WEST END	12-15-2003
E204a	FOURTH FLOOR POWER PLAN - EAST END	12-15-2003
E204b	FOURTH FLOOR POWER PLAN - WEST END	12-15-2003
E205a	ELECTRICAL ROOF PLAN - EAST END	12-15-2003
E205b	ELECTRICAL ROOF PLAN - WEST END	12-15-2003
E300	BASEMENT SYSTEMS PLAN	12-15-2003
E301a	FIRST FLOOR SYSTEMS PLAN - EAST END	12-15-2003
E301b	FIRST FLOOR SYSTEMS PLAN - WEST END	12-15-2003
E302a	2nd FLOOR SYSTEMS PLAN - EAST END	12-15-2003
E302b	2nd FLOOR SYSTEMS PLAN - WEST END	12-15-2003
E303a	THIRD FLOOR SYSTEMS PLAN - EAST END	12-15-2003
E303b	THIRD FLOOR SYSTEMS PLAN - WEST END	12-15-2003
E304a	4th FLOOR SYSTEMS PLAN - EAST END	12-15-2003
E304b	4th FLOOR SYSTEMS PLAN - WEST END	12-15-2003
E401	ELECTRICAL DETAILS	12-15-2003
E402	ELECTRICAL DETAILS	12-15-2003
E403	ELECTRICAL DETAILS	12-15-2003
ES01	ELECTRICAL SINGLE LINE DIAGRAM	12-15-2003
ES02	ELECTRICAL PANEL SCHEDULES	12-15-2003
ES03	ELECTRICAL PANEL SCHEDULES	12-15-2003
ES04	ELECTRICAL PANEL SCHEDULES	12-15-2003
ES05	ELECTRICAL PANEL SCHEDULES	12-15-2003
ES06	ELECTRICAL PANEL SCHEDULES	12-15-2003

NOTE: **BOLD TEXT INDICATES DRAWINGS IN THIS PACKAGE.**
LIGHT TEXT INDICATES DWGS. PREVIOUSLY ISSED BUT NOT IN THIS PACKAGE

OWNER'S PROJECT ADVISOR:
MOSES TUCKER REAL ESTATE, INC.

CIVIL ENGINEER:
McCLELLAND ENGINEERS

LANDSCAPE ARCHITECT:
LARSON BURNS SMITH

STRUCTURAL ENGINEER:
CROMWELL ENGINEERS INC.

MECHANICAL, ELECTRICAL, & PLUMBING ENGINEER:
CROMWELL ENGINEERS INC.

GLOBAL VILLAGE CONSULTANT:
CAMBRIDGE SEVEN ASSOCIATES

SUSTAINABLE CONSULTANT:
BNIM / ELEMENTS

INTERIOR DESIGNER:
POLK STANLEY YEARY

GENERAL CONTRACTOR:
CDI CONTRACTORS, INC.

POLK STANLEY YEARY
ARCHITECTS, LTD.

700 SOUTH SCHILLER STREET
LITTLE ROCK, AR 72201
VOICE: 501-378-0878
FAX: 501-378-0878

21 WEST MOUNTAIN, SUITE 227
FAYETTEVILLE, AR 72701
VOICE: 479-444-0473
FAX: 479-251-7216

8:53 AM Friday, July 02, 2004
P:\CAD-DWG\431C\CA\PrintDrawingsForCDI\PrintG000-CoverSheet-100%.DWG

ABBREVIATIONS

ALUM.	ALUMINUM
ABV	ABOVE
A.F.F.	ABOVE FINISHED FLOOR
AL.	ALUMINUM
ADJ.	ADJUSTABLE
A/C	AIR CONDITIONING
ACOUST.	ACOUSTICAL
ASPH.	ASPHALT
A.B.	ANCHOR BOLT
BLKG.	BLOCKING
BD.	BOARD
BLK.	BLOCK
BACKBD.	BACKBOARD
BLDG.	BUILDING
BOT.	BOTTOM
BM.	BEAM
BIT.	BITUMINOUS
C.B.	CHALKBOARD
C.J.	CONTROL JOINT
COL.	COLUMN
CO.	COMPANY
C.M.U.	CONCRETE MASONRY UNIT
CTRFLSHG.	COUNTERFLASHING
CONT.	CONTINUOUS
CONTIN.	CONTINUOUS
CLG.	CEILING
CONN.	CONNECTION
CAB.	CABINET
COV.	COVER
CONF.	CONFERENCE
DIAM.	DIAMETER
DIM.	DIMENSION
DN.	DOWN
DS.	DOWNSPOUT
DR.	DOOR
D.F.	DRINKING FOUNTAIN
D.W.	DISHWASHER
ELEV.	ELEVATION/ELEVATOR
EW.	EACH WAY
EQ.	EQUAL
ELEC.	ELECTRIC(AL)
EQPT.	EQUIPMENT
EXIST.	EXISTING
EXP.	EXPANSION
EWC	ELECTRIC WATER COOLER
EXH.	EXHAUST
E.I.F.S.	EXTERIOR INSULATION FINISH SYSTEM
E.J.	EXPANSION JOINT
E.	EAST
EX.	EXISTING
ENCL.	ENCLOSED/ENCLOSURE
EA.	EACH
EL.	ELEVATION
FURR.	FURRING
FEC	FIRE EXTINGUISHER CABINET
FIN.	FINISHED
FT.	FOOT/FEET
FB.	FACE BRICK
F.F.	FINISHED FLOOR
FLSHG.	FLASHING
FLSG.	FLASHING
FASTEN.	FASTENER
FDN.	FOUNDATION
FLR.	FLOOR
FOUND.	FOUNDATION
FTG.	FOOTING
FH.	FIRE HYDRANT
F.D.	FLOOR DRAIN
GYP.	GYPSUM
G.B.	GRAB BAR
GA.	GAUGE
H.R.	HAND RAIL
HD.	HAND
H.C.	HANDICAP(PED)
HORIZ.	HORIZONTAL
H.M.	HOLLOW METAL
HOL.	HOLLOW
HT.	HEIGHT
HYD.	HYDRANT
HR.	HOUR
INSUL.	INSULATION
JT.	JOINT
JAN.	JANITOR
LAM.	LAMINATED
L.C.S.	LIQUID CHALK SURFACE
L.P.	LIGHT POLE
MECH.	MECHANICAL
MACH.	MACHINE
MET.	METAL
MANUF.	MANUFACTURER
MID.	MIDDLE
MEMB.	MEMBRANE
MAX.	MAXIMUM
MIN.	MINIMUM
MED.	MEDIUM
MAT.	MATERIAL
MB.	MARKERBOARD
MEZZ.	MEZZANINE
MTR.	MOTOR
M.E.J.	MASONRY EXPANSION JOINT
MTL.	METAL
N.I.C.	NOT IN CONTRACT
N.W.	NORTH WEST
N	NORTH
OPP.	OPPOSITE
O.C.	ON CENTER
PLYWD.	PLYWOOD
PREFAB.	PREFABRICATED
P.	PROPERTY LINE
PVC	POLYVINYL CHLORIDE
PTD/WR	PAPER TOWEL DISPENSER/WASTE RECEPTACLE
P.P.	POWER POLE
RETAIN.	RETAINING
REINF.	REINFORCE(MENT)
R.R.	RAILROAD
ROOF.	ROOFING
RE.	REFER
RM.	ROOM
R.	RADIUS
RJ.	REVEAL JOINT
S.	SOUTH
S.S.	STAINLESS STEEL
SUSP.	SUSPEND(ED)
S.C.	SOLID CORE
STL.	STEEL
SHELV.	SHELVING
S.E.	SOUTH EAST
STRUCT.	STRUCTURAL
STAND.	STANDARD
STOR.	STORAGE
SD	SOAP DISPENSER
STO.	STORAGE
SIM.	SIMILAR
SHT.	SHEET
SDG.	SIDING
TREAT.	TREATED
TOIL.	TOILET
TYP.	TYPICAL
TAPER.	TAPERED
TEL.	TELEPHONE
T.O.C.	TOP OF CURB
T.O.B.	TOP OF BEAM
TP.	TOILET PARTITION
TB.	TACK BOARD
T.B.R.	TO BE REMOVED
TK.	THICK
T.J.	TOOLED JOINT
U.N.O.	UNLESS NOTED OTHERWISE
UL DES.	UNDERWRITER'S LABRATORY DESIGN
V.T.R.	VENT THRU ROOF
VEST.	VESTIBULE
W/	WITH
W.W.M.	WELDED WIRE MESH
W	WEST
WASH.	WASHER
WD.	WOOD
WDW.	WINDOW

SYMBOL LEGEND

SECTION NUMBER 5 / SHEET NUMBER A401 — BUILDING SECTION

SECTION NUMBER 1 / SHEET NUMBER A305 — WALL SECTION

DETAIL NUMBER 2 / SHEET NO. A401 — DETAIL REFERENCE

4/A501 — ELEV. NO./SHEET NO. — INTERIOR WALL ELEVATION OR MILLWORK ELEVATION

AL1 — WINDOW TYPE

21 — STRUCTURAL GRID

FLOOR LEVEL

A1E — WALL TYPE

AL12 — WINDOW KEY

120 — DOOR KEY

MATCH LINE - SEE SHEET A104b - WEST END
MATCH LINE - SEE SHEET A104e - EAST END
MATCH LINE

S — SMOKE DETECTOR
F — FIRE PULL STATION
F — FIRE ALARM HORN
V — FIRE ALARM STROBE

MATERIAL LEGEND

CONCRETE

STONE

CONCRETE MASONRY UNIT

STEEL

RIGID INSULATION

WALL INSULATION

WOOD - FINISHED

WOOD - ROUGH

PLYWOOD

FIRE PROOFING

METAL STUD AND GYPSUM BOARD

METAL STUD AND COMPOSITE PANELS

MOVEABLE WALL PARTITION

STONE ON ELEVATIONS

CORRUG. METAL PANEL SYSTEM ON ELEVATIONS

SPANDREL ON ELEVATIONS

BRICK ON ELEVATIONS

1 HR. FIRE RATED PARTITION

2 HR. FIRE RATED PARTITION

BUILDING CODE DATA

APPLICABLE CODES: International Building Code - 2000
Americans with Disabilities Act (ADA) - 1990
Life Safety Code - 1994
Standard Mech. Code 1997
Standard Elect. Code 1997
Standard Plumbing Code 1997
National Electrical Code

OCCUPANCY: Business - Group B (Section 304, page 24)

PHYSICAL PROPERTIES OF BUILDING:

Int. Sq. Ft. @ Basement Flr.:	4,033 gross square feet
Int. Sq. Ft. @ 1st. Flr.:	21,616 gross square feet
Int. Sq. Ft. @ 2nd. Flr.:	25,102 gross square feet
Int. Sq. Ft. @ 3rd. Flr.:	25,102 gross square feet
Int. Sq. Ft. @ 4th. Flr.:	22,196 gross square feet
Total Building Int. Sq. Ft.:	98,049 gross square feet
Ext. Sq. Ft. @ 1st. Flr. Covered:	3,435 gross square feet
Ext. Sq. Ft. @ 2nd. Flr. Covered:	630 gross square feet
Ext. Sq. Ft. @ 3rd. Flr. Covered:	630 gross square feet
Ext. Sq. Ft. @ 4th. Flr. Covered:	2,054 gross square feet
Total Building Ext. Sq. Ft.:	6,749 gross square feet
Finished Grade Elevation:	212.0'
Height Above Finished Grade:	65
Number of Stories:	4
Distance from Property Line:	South 189'

TYPE OF CONSTRUCTION (Chapter 6): 4 Story Office Building Structure
TYPE III B, SPRINKLERED

Max. Allowable Height:	75'-0" (Table 503, page 71)
Max. Allowable Stories:	5 (Table 503, page 71)
Maximum Allowable Area Per Floor:	53,438 square feet per floor with area modifications (Sect. 506, page 72)

PHYSICAL PROPERTIES OF SITE:

	Parking Spaces
Handicapped Vehicle Parking Spaces:	6 spaces min. - 1 that is van space
Vehicle Carpool Parking Spaces:	12 spaces min.
Bicycle Parking Spaces:	24 spaces min.
Total Vehicle Parking Spaces:	199 spaces max.

MEANS OF EGREES:
Maximum Occupant Load (Table 1003.2.2, page 184)
Business Occupancy @ 100 gross (Floor area in sq. ft. per occupant)
Egress width per occupant with sprinkler system @ stairway = 0.2 inches.
Egress width per occupant with sprinkler system @ exit corridors = 0.15 inches
Total Occupancy: 94016 Sq. Ft. /100 sq. ft. = 940 People Load Max.

Minimum Number of Exits:	3 Exits (Table 1005.2.1, page 203)
One Means of Egress to be Accessible (1003.2.13.1.1, page 189)	
Maximum Distance Between Exits:	1/2 diag. length of building (1004.2.2.2, page 199) 459'-4" lenght of bulding with 3 exits 270' max. distance
Maximum Travel Distance to Exit:	300 ft. (Table 1004.2.4, page 200)
Minimum Egress Width:	Occupant load / 3 exits = 313 per exit
Stair:	940 / 4 = 235 People x 0.2 inches = 47 inches
Level:	940 / 4 = 235 People x 0.15 inches = 35 inches
Minimum Egress Width of Corridors:	44 inches (1004.3.3, page 202)
Minimum Egress Width of Exit Doors:	32 inches (1003.3.1.1, page 190)
Minimum Stair Width:	44 inches (1003.3.3.1, page 195)

FIRE EXTINGUISHER: Portable, 2 per floor (Section 906) as per International Fire Code

Fire Classification:	Class A
Occupancy Classification:	Light Hazard
Area Per Extinguisher:	12,551 sq. ft. (Not required)
Distance To Extinguisher:	229 ft. (Not required)
Min. Extinguisher Size Rating:	1-A (2 lb.)

LIFE SAFETY CODE (1994):
To provide for window emergency rescue and ventilation:
(Section 1009, page 213)

Max. window sill height:	44 inches
Clear opening:	20 in. min. width 24 in. min. height 5.7 sq. ft. minimum area

DETAILED CONSTRUCTION REQUIREMENTS:
Fire-Resistance Rating Requirements For Building Elements: (Table 601, page 77)

Structural frame:	0 hrs.
Bearing ext. walls:	2 hrs.
Bearing int. walls:	0 hrs.
Non-bearing ext. walls:	N/A
Non-bearing int. walls:	N/A
Floor construction:	0 hrs.
Roof construction:	0 hrs.

U.S. GREEN BUILDING COUNCIL - LEED CRITERIA

APPLICABLE REFERENCES: U.S. Green Building Council (USGBC) - Leadership in Energy and Environmental Design (LEED)
Reference Guide - Version 2.0 dated June 2001 and Version 2.1 dated July 2002
Rating System - Version 2.0 dated June 2001

INCORPORATED INTO THIS BUILDING DESIGN:
RECYCLED MATERIALS: Storage bins on-site (collectors on 1st floor)
Cardboard, white office paper, newsprint (each separate)
Glass
Plastic
Ferrious metals and aluminum (each separate)
Organic waste

AUTOMOBILES AND BICYCLES: Parking spaces and racks on-site

Vehicle Carpool Parking Spaces:	12 spaces minimum
Bicycle Parking Spaces:	24 spaces minimum
Total Vehicle Parking Spaces:	199 spaces maximum

INTERIOR SHOWERS FOR BIKERS: 3 showers minimumL1 thru L4 finish-out/2 showers minimum L1, L3, and L4 finish-out

ENVIRONMENTAL CONSIDERATIONS:
This project is designed and constructed with practices and procedures to meet the project's environmental considerations and goals. These considerations and goals are to establish a facility which is environmentally responsible, profitable, and a healthy place to live and work. Refer to Project Manual Sections listed below for environmental considerations and goals, and applicable paragraphs of the specification section. The Contractor shall ensure that the requirements related to these considerations and goals, as defined in the Contract Documents are implemented to the fullest extent.
A. Project environmental goals; refer to Secification Section 01011.
B. Leed requirements; refer to Specifications Section 01350.
C. Disposal of unreclaimed materials and waste materials in containers designed at site; refer to Specifications Section 01736.

GENERAL BUILDING NOTES:

1. ALL DIMENSIONS SHOWN ARE TO FACE OF FINISH UNLESS NOTED OTHERWISE.

POLK STANLEY YEARY ARCHITECTS, LTD.
700 SOUTH SCHILLER
LITTLE ROCK, AR 72201
501 378-0878
FAX 372-7629

21 W. MOUNTAIN, SUITE 227
FAYETTEVILLE, AR 72701
479-444-0473

CONSULTANTS:

OWNER'S PROJECT ADVISOR:
MOSES TUCKER REAL ESTATE, INC.

CIVIL ENGINEER:
McCLELLAND ENGINEERS

LANDSCAPE ARCHITECT:
LARSON BURNS SMITH

STRUCTURAL ENGINEER:
CROMWELL ENGINEERS INC.

MECH., ELEC., PLUMB. ENGINEER:
CROMWELL ENGINEERS INC.

SUSTAINABLE CONSULTANT:
BNIM / ELEMENTS

GLOBAL VILLAGE CONSULTANT
CAMBRIDGE SEVEN ASSOCIATES

INTERIOR DESIGNER:
POLK STANLEY YEARY

GENERAL CONTRACTOR:
CDI CONTRACTORS, INC.

GENERAL NOTES:

NOTES:

ISSUE DATE:
100% GMP
PACKAGE #6
FEBRUARY 2, 2004

REVISIONS:

#	DATE	DESCRIPTION
1	01JUL04	PACKAGE 7

HEIFER INTERNATIONAL CENTER OFFICE BUILDING

LITTLE ROCK, ARKANSAS

PSY PROJECT NUMBER:
431C

POLK STANLEY WILSON CURZON-SMITH & YEARY CORPORATION C-138 ARKANSAS REGISTERED

CONTENTS:
GENERAL DATA SHEET

SHEET NUMBER:
G001

R:\LD-DWGS\431C\Cad Files\Drawings\G001.dwg 3:34 PM

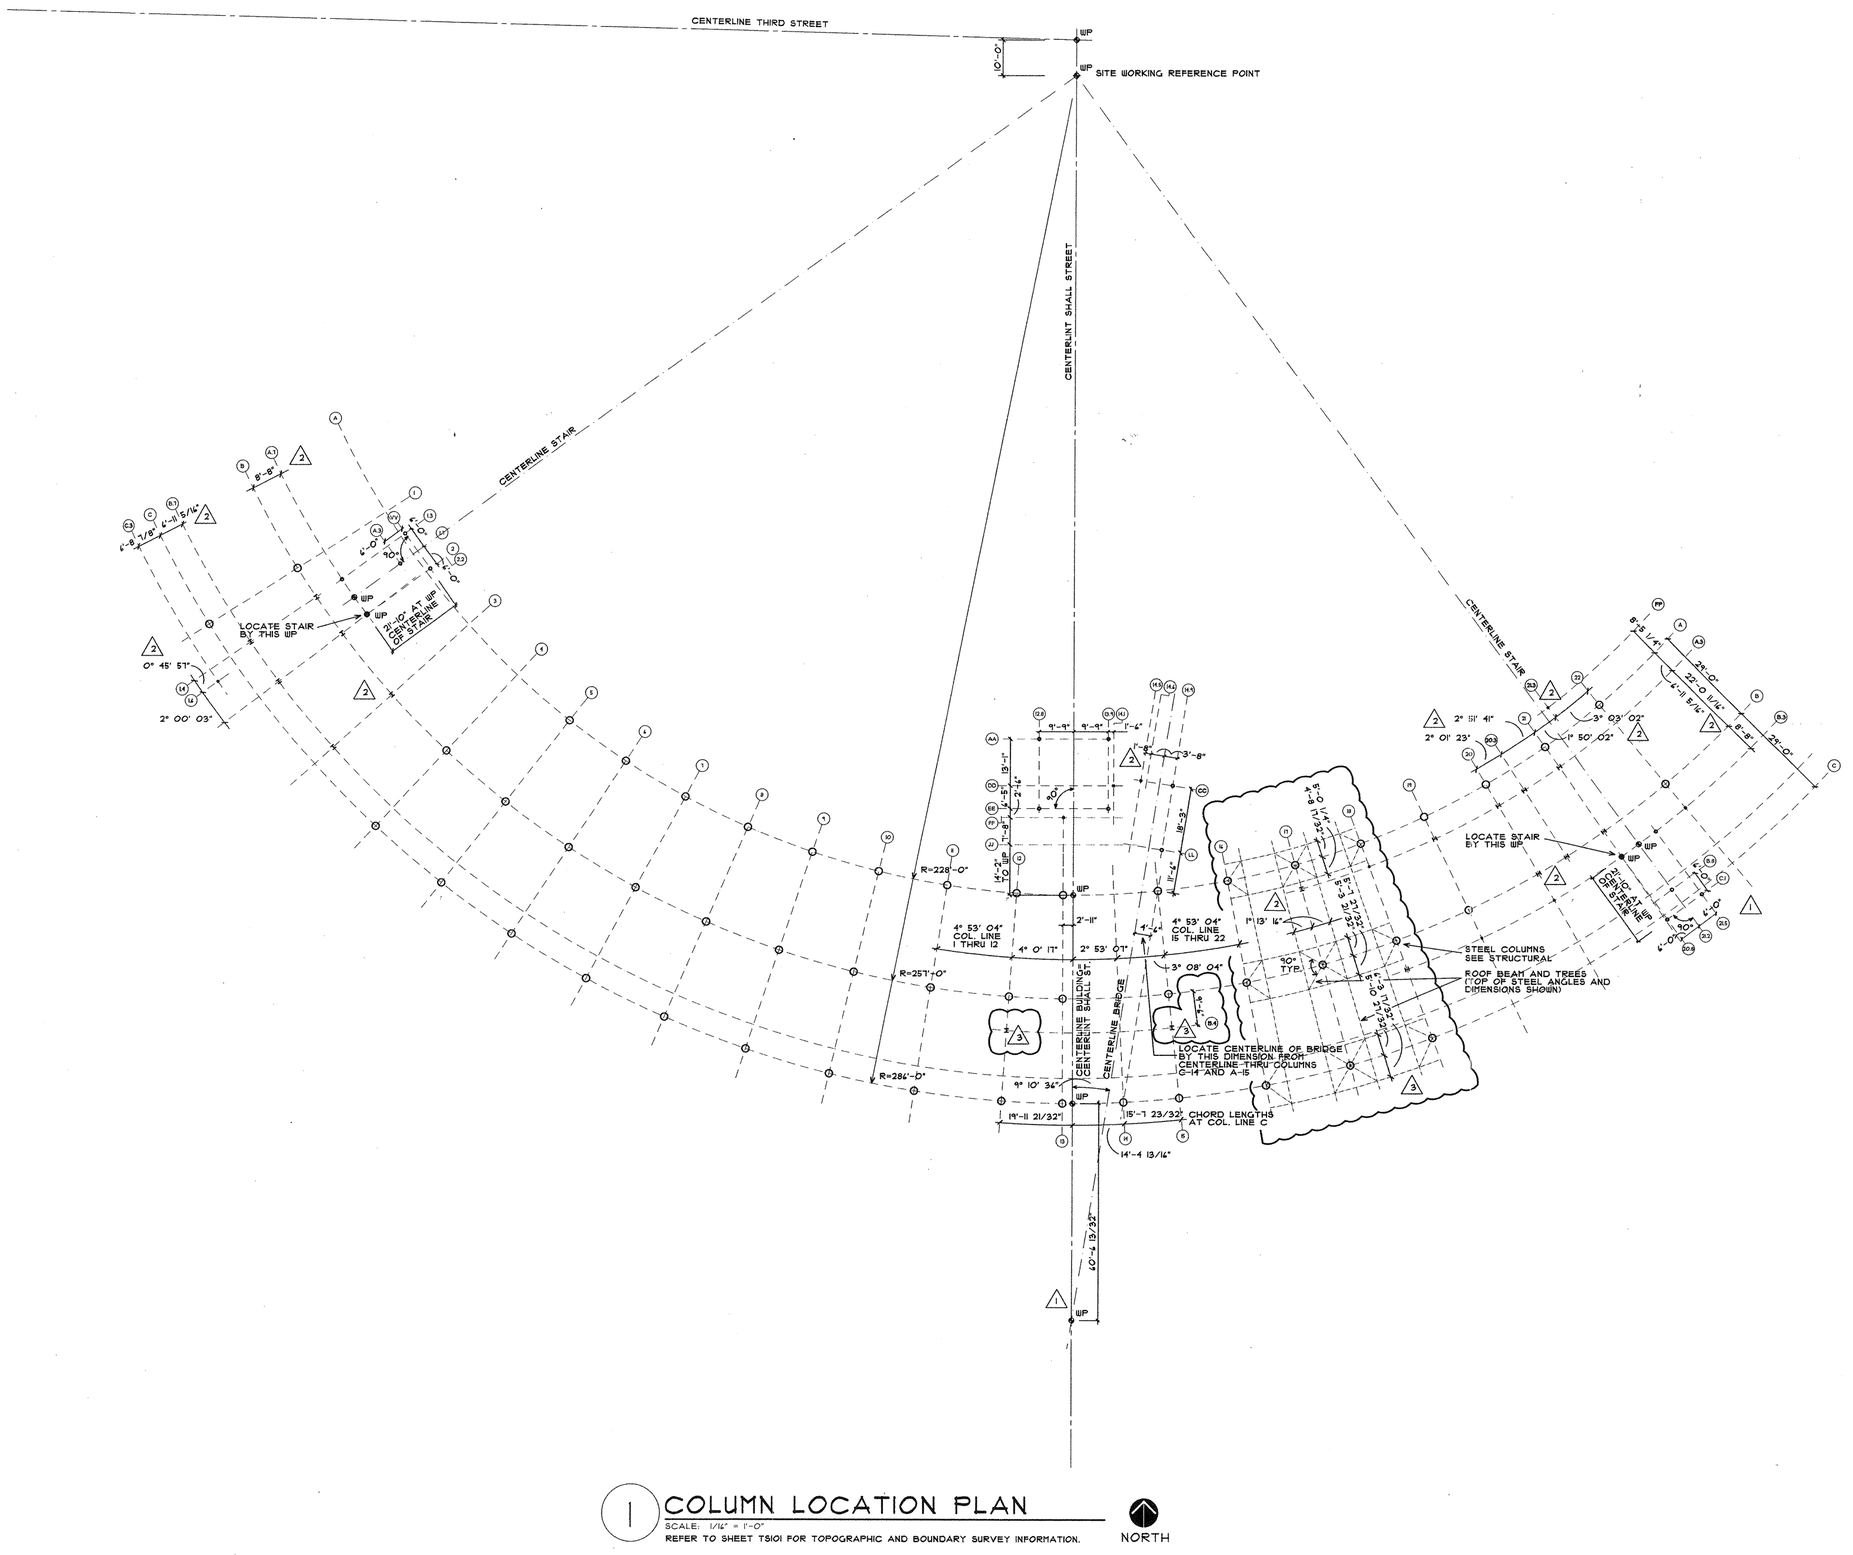

1 COLUMN LOCATION PLAN

SCALE: 1/16" = 1'-0"

REFER TO SHEET TS101 FOR TOPOGRAPHIC AND BOUNDARY SURVEY INFORMATION.

POLK
STANLEY
YEARY

ARCHITECTS, LTD.

700 SOUTH SCHILLER
LITTLE ROCK, AR 72201
501 378-0878
FAX 372-7629

21 W. MOUNTAIN, SUITE 227
FAYETTEVILLE, AR 72701
479-444-0473

CONSULTANTS:

OWNER'S PROJECT ADVISOR:
MOSES TUCKER REAL ESTATE, INC.

CIVIL ENGINEER:
McCLELLAND ENGINEERS

LANDSCAPE ARCHITECT:
LARSON BURNS SMITH

STRUCTURAL ENGINEER:
CROMWELL ENGINEERS INC.

MECH., ELEC., PLUMB. ENGINEER:
CROMWELL ENGINEERS INC.

SUSTAINABLE CONSULTANT:
BNIM / ELEMENTS

GLOBAL VILLAGE CONSULTANT
CAMBRIDGE SEVEN ASSOCIATES

INTERIOR DESIGNER:
POLK STANLEY YEARY

GENERAL CONTRACTOR:
CDI

GENERAL NOTES:

NOTES:

ISSUE DATE:
STRUCTURAL/FOUNDATION PACKAGE #4
NOVEMBER 17, 2003

REVISIONS:

#	DATE	DESCRIPTION
1	24FEB04	PACKAGE 04, ADDM 05
2	13APR04	PACKAGE 04, ADDM 09
3	01JUL04	PACKAGE 07

HEIFER INTERNATIONAL CENTER OFFICE BUILDING

LITTLE ROCK, ARKANSAS

PSY PROJECT NUMBER:
431C

POLK STANLEY YEARY ARCHITECTS LTD. CORPORATE SEAL ARKANSAS C-136

CONTENTS:
COLUMN LOCATION PLAN

SHEET NUMBER:

G003

P:\PROJECTS\431C\CAD\ARCHITECTURAL\SHEETS\G003.DWG Wednesday, June 30, 2004 2:08 PM Duane Lasseter/Fayetteville

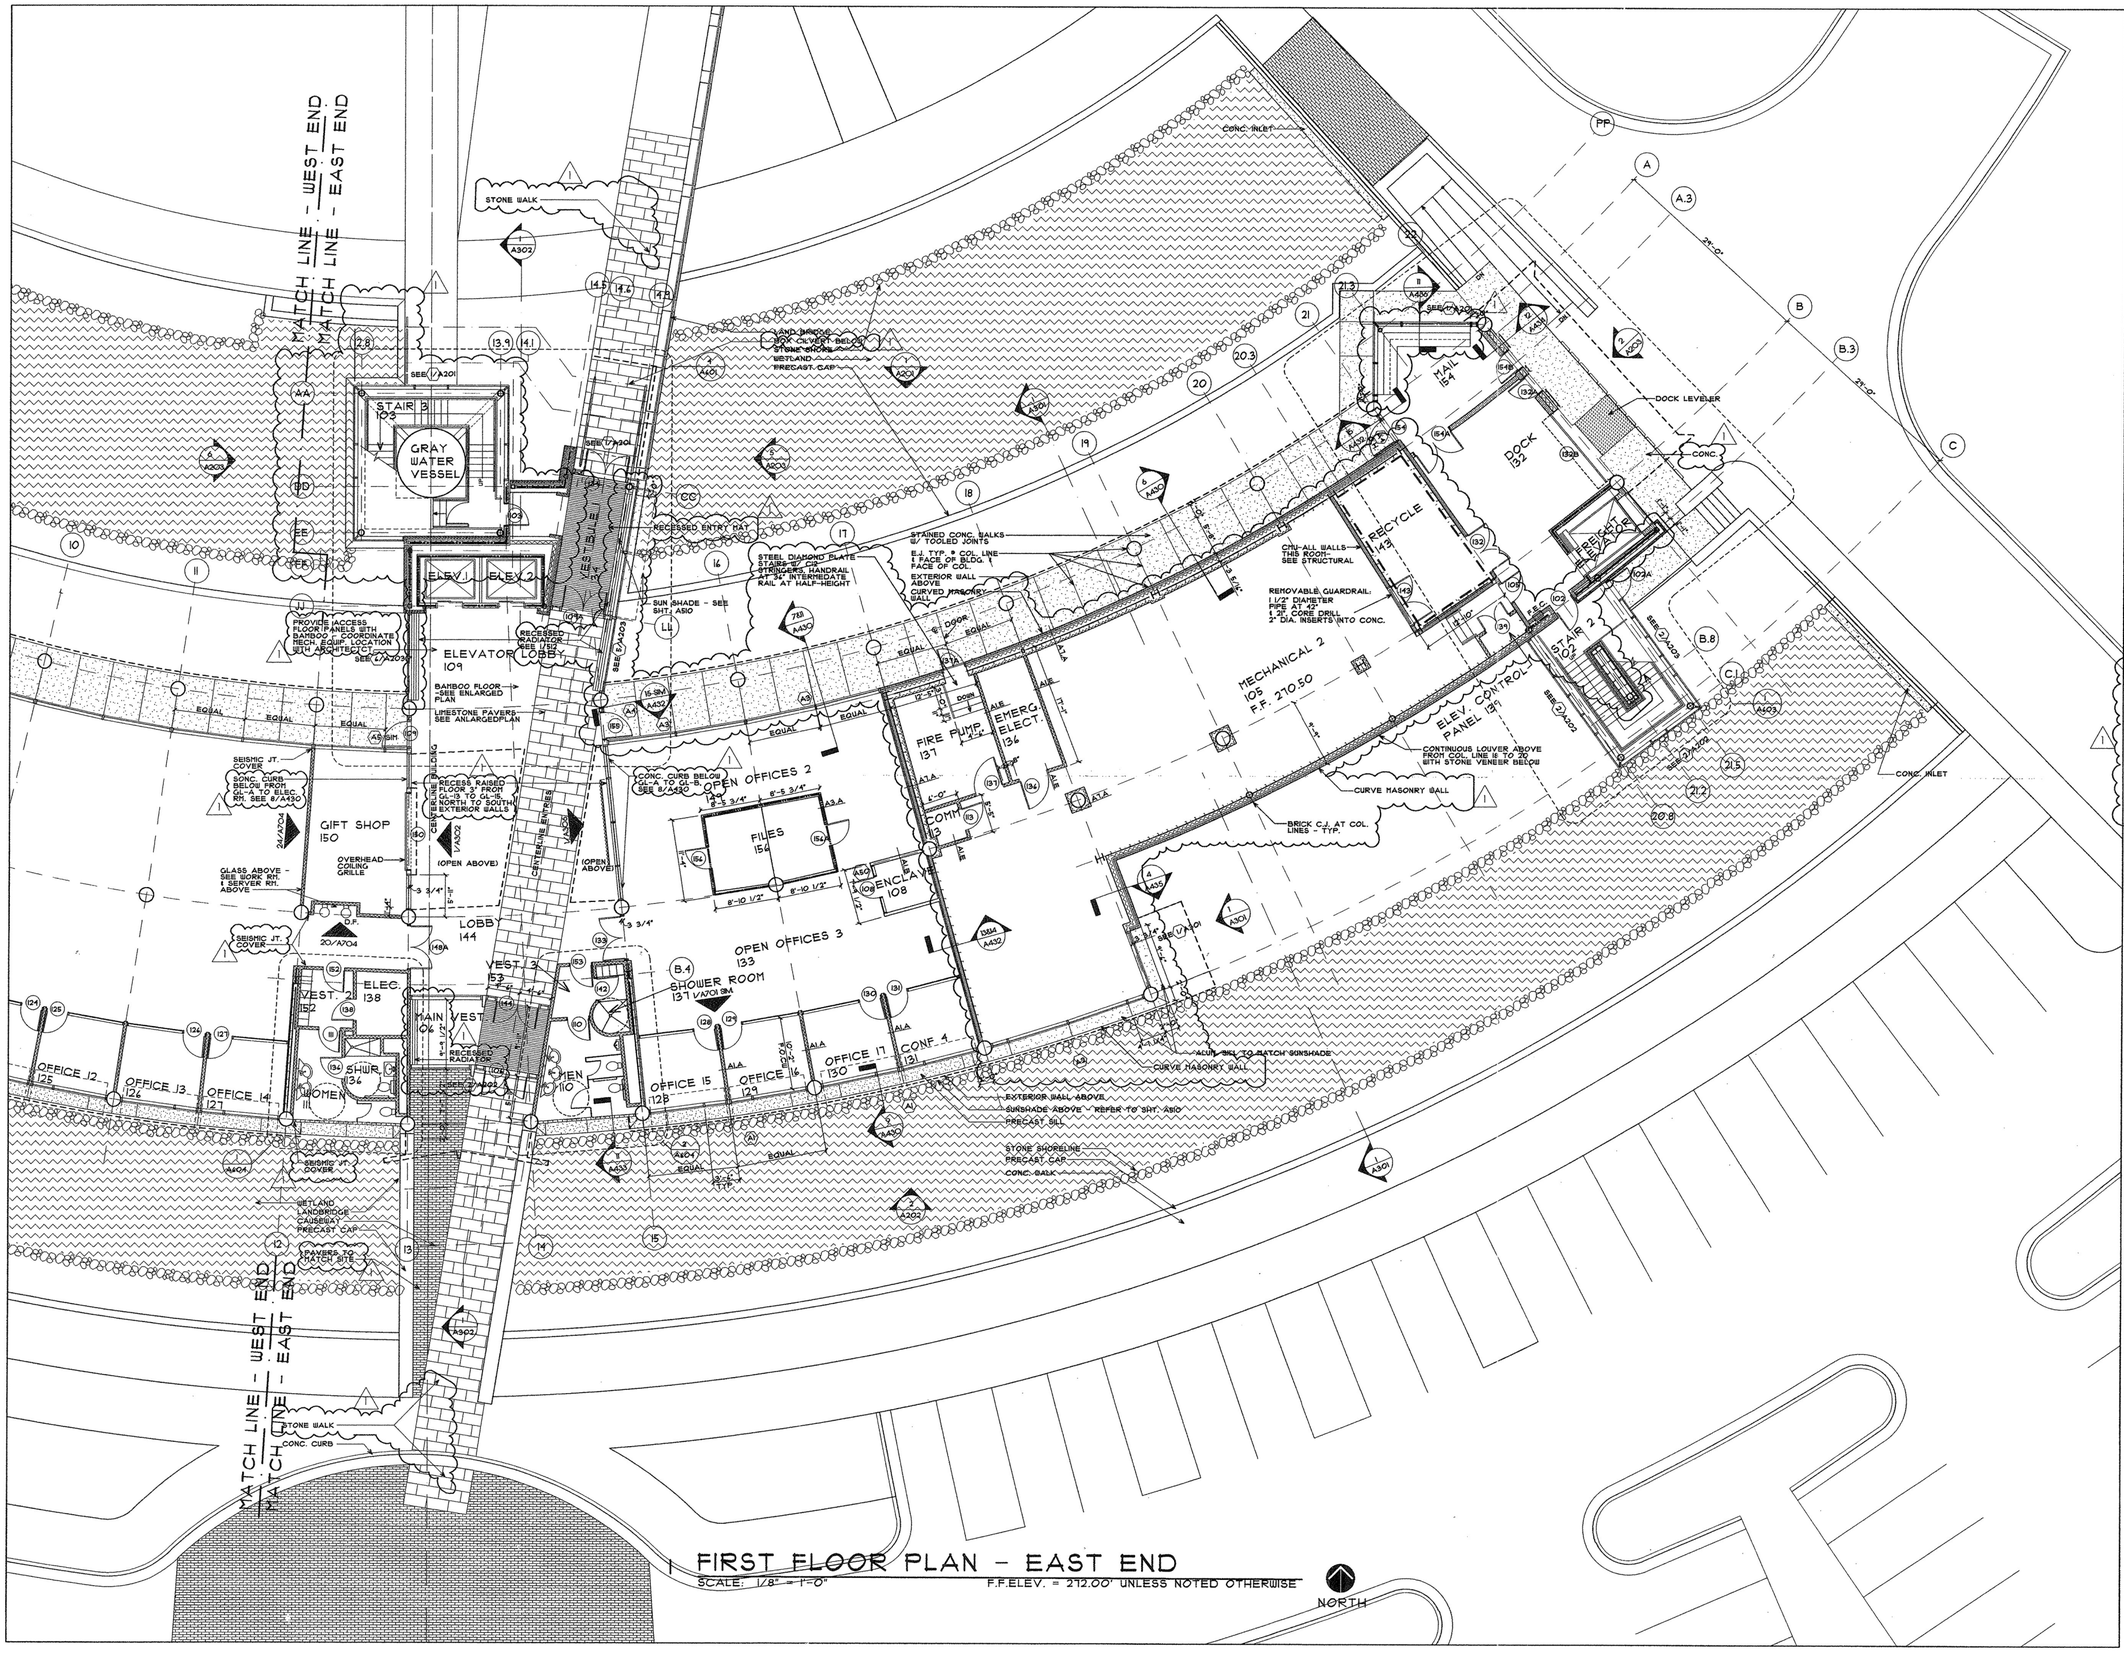

FIRST FLOOR PLAN - EAST END

SCALE: 1/8" = 1'-0"

F.F.ELEV. = 212.00' UNLESS NOTED OTHERWISE

POLK STANLEY YEARY ARCHITECTS, LTD.

700 SOUTH SCHILLER
LITTLE ROCK, AR 72201
501 378-0878
FAX 372-7629

21 W. MOUNTAIN, SUITE 227
FAYETTEVILLE, AR 72701
479-444-0473

CONSULTANTS:

OWNER'S PROJECT ADVISOR:
MOSES TUCKER REAL ESTATE, INC.

CIVIL ENGINEER:
McCLELLAND ENGINEERS

LANDSCAPE ARCHITECT:
LARSON BURNS SMITH

STRUCTURAL ENGINEER:
CROMWELL ENGINEERS INC.

MECH., ELEC., PLUMB. ENGINEER:
CROMWELL ENGINEERS INC.

SUSTAINABLE CONSULTANT:
BNIM / ELEMENTS

GLOBAL VILLAGE CONSULTANT
CAMBRIDGE SEVEN ASSOCIATES

INTERIOR DESIGNER:
POLK STANLEY YEARY

GENERAL CONTRACTOR:
CDI

GENERAL NOTES:

1. LOCATE WALLS & PARTITIONS ON CENTERLINE OF COLUMNS UNLESS NOTED OTHERWISE.
2. SEE SHEET G003 FOR COLUMN DIMENSION PLAN.
3. ALL WALLS ARE SEGMENTED TO FOLLOW CURVE OF BUILDING UNLESS NOTED OTHERWISE.
4. PROVIDE 1 HR. SPRAYED FIRE PROOFING FOR COLUMNS B-18 THRU B-20, B-11 (EASTSIDE), AND SHEAR WALL A.3/11 TO A.3/20. INCLUDING COLUMNS.
5. PROVIDE 1 HR. INTUMESCENT FIRE PROOFING FOR COLUMNS A-14 THRU A-20, B-14 THRU B-11 (WESTSIDE).

NOTES:

ISSUE DATE:
100% GMP
PACKAGE #6
FEBRUARY 2, 2004

REVISIONS:

#	DATE	DESCRIPTION
1	04\JUL\04	PACKAGE #1

HEIFER INTERNATIONAL CENTER OFFICE BUILDING

LITTLE ROCK, ARKANSAS

PSY PROJECT NUMBER:
431C

POLK STANLEY YEARY CORPORATION ARCHITECTS LTD. C-136 ARKANSAS

CONTENTS:
FIRST FLOOR PLAN - EAST END

SHEET NUMBER:

A101a

P:\D-DISC\13\C\CAD*.rvt\Drawings\For CDs\Final\A101a - FirstFloorPlan - East End.dwg Thursday, July 01, 2004 4:38 PM

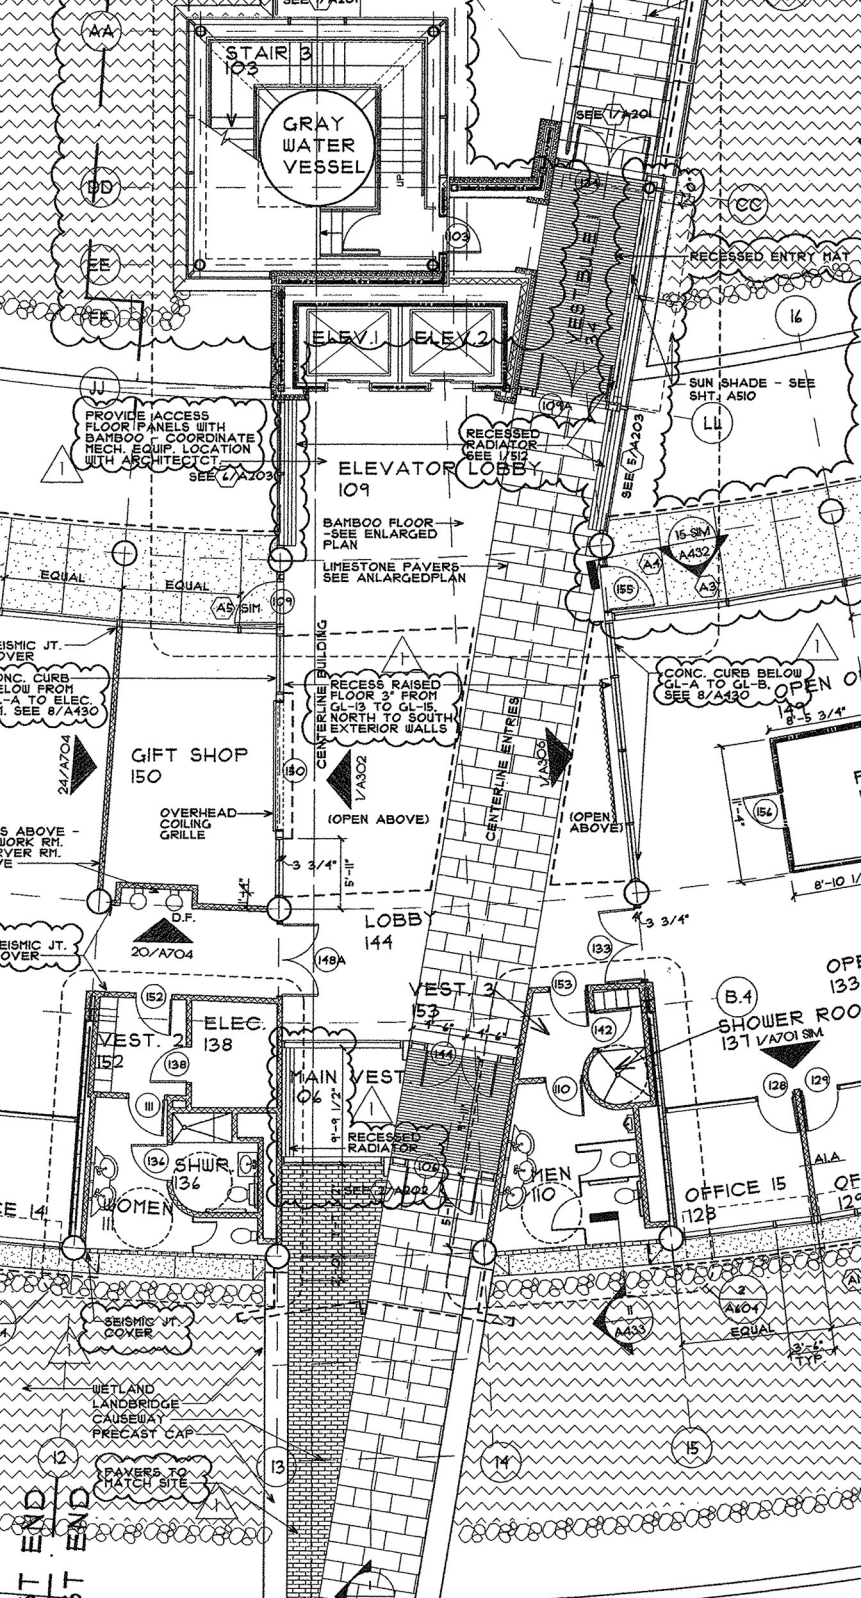
STAIR 3
103
GRAY WATER VESSEL
ELEV.1
ELEV.2
ELEVATOR LOBBY
109
PROVIDE ACCESS FLOOR PANELS WITH BAMBOO - COORDINATE MECH. EQUIP. LOCATION WITH ARCHITECT.
BAMBOO FLOOR -SEE ENLARGED PLAN
LIMESTONE PAVERS SEE ANLARGEDPLAN
RECESSED RADIATOR SEE 1/S12
RECESSED ENTRY MAT
SUN SHADE - SEE SHT. A510
GIFT SHOP
150
OVERHEAD COILING GRILLE
(OPEN ABOVE)
RECESS RAISED FLOOR 3" FROM GL-13 TO GL-15. NORTH TO SOUTH EXTERIOR WALLS
CENTERLINE BUILDING
CENTERLINE ENTRIES
CONC. CURB BELOW GL-A TO GL-B. SEE 8/A430
LOBBY
144
VEST. 3
153
VEST. 2
152
ELEC.
138
MAIN VEST.
104
SHWR.
136
WOMEN
111
MEN
110
OFFICE 15
128
SHOWER ROO
137
SEISMIC JT. COVER
WETLAND LANDBRIDGE CAUSEWAY PRECAST CAP
PAVERS TO MATCH SITE
RECESSED RADIATOR
EQUAL
TYP.
OPEN
AA
BB
CC
DD
EE
FF
JJ
LL
12
13
14
15
16

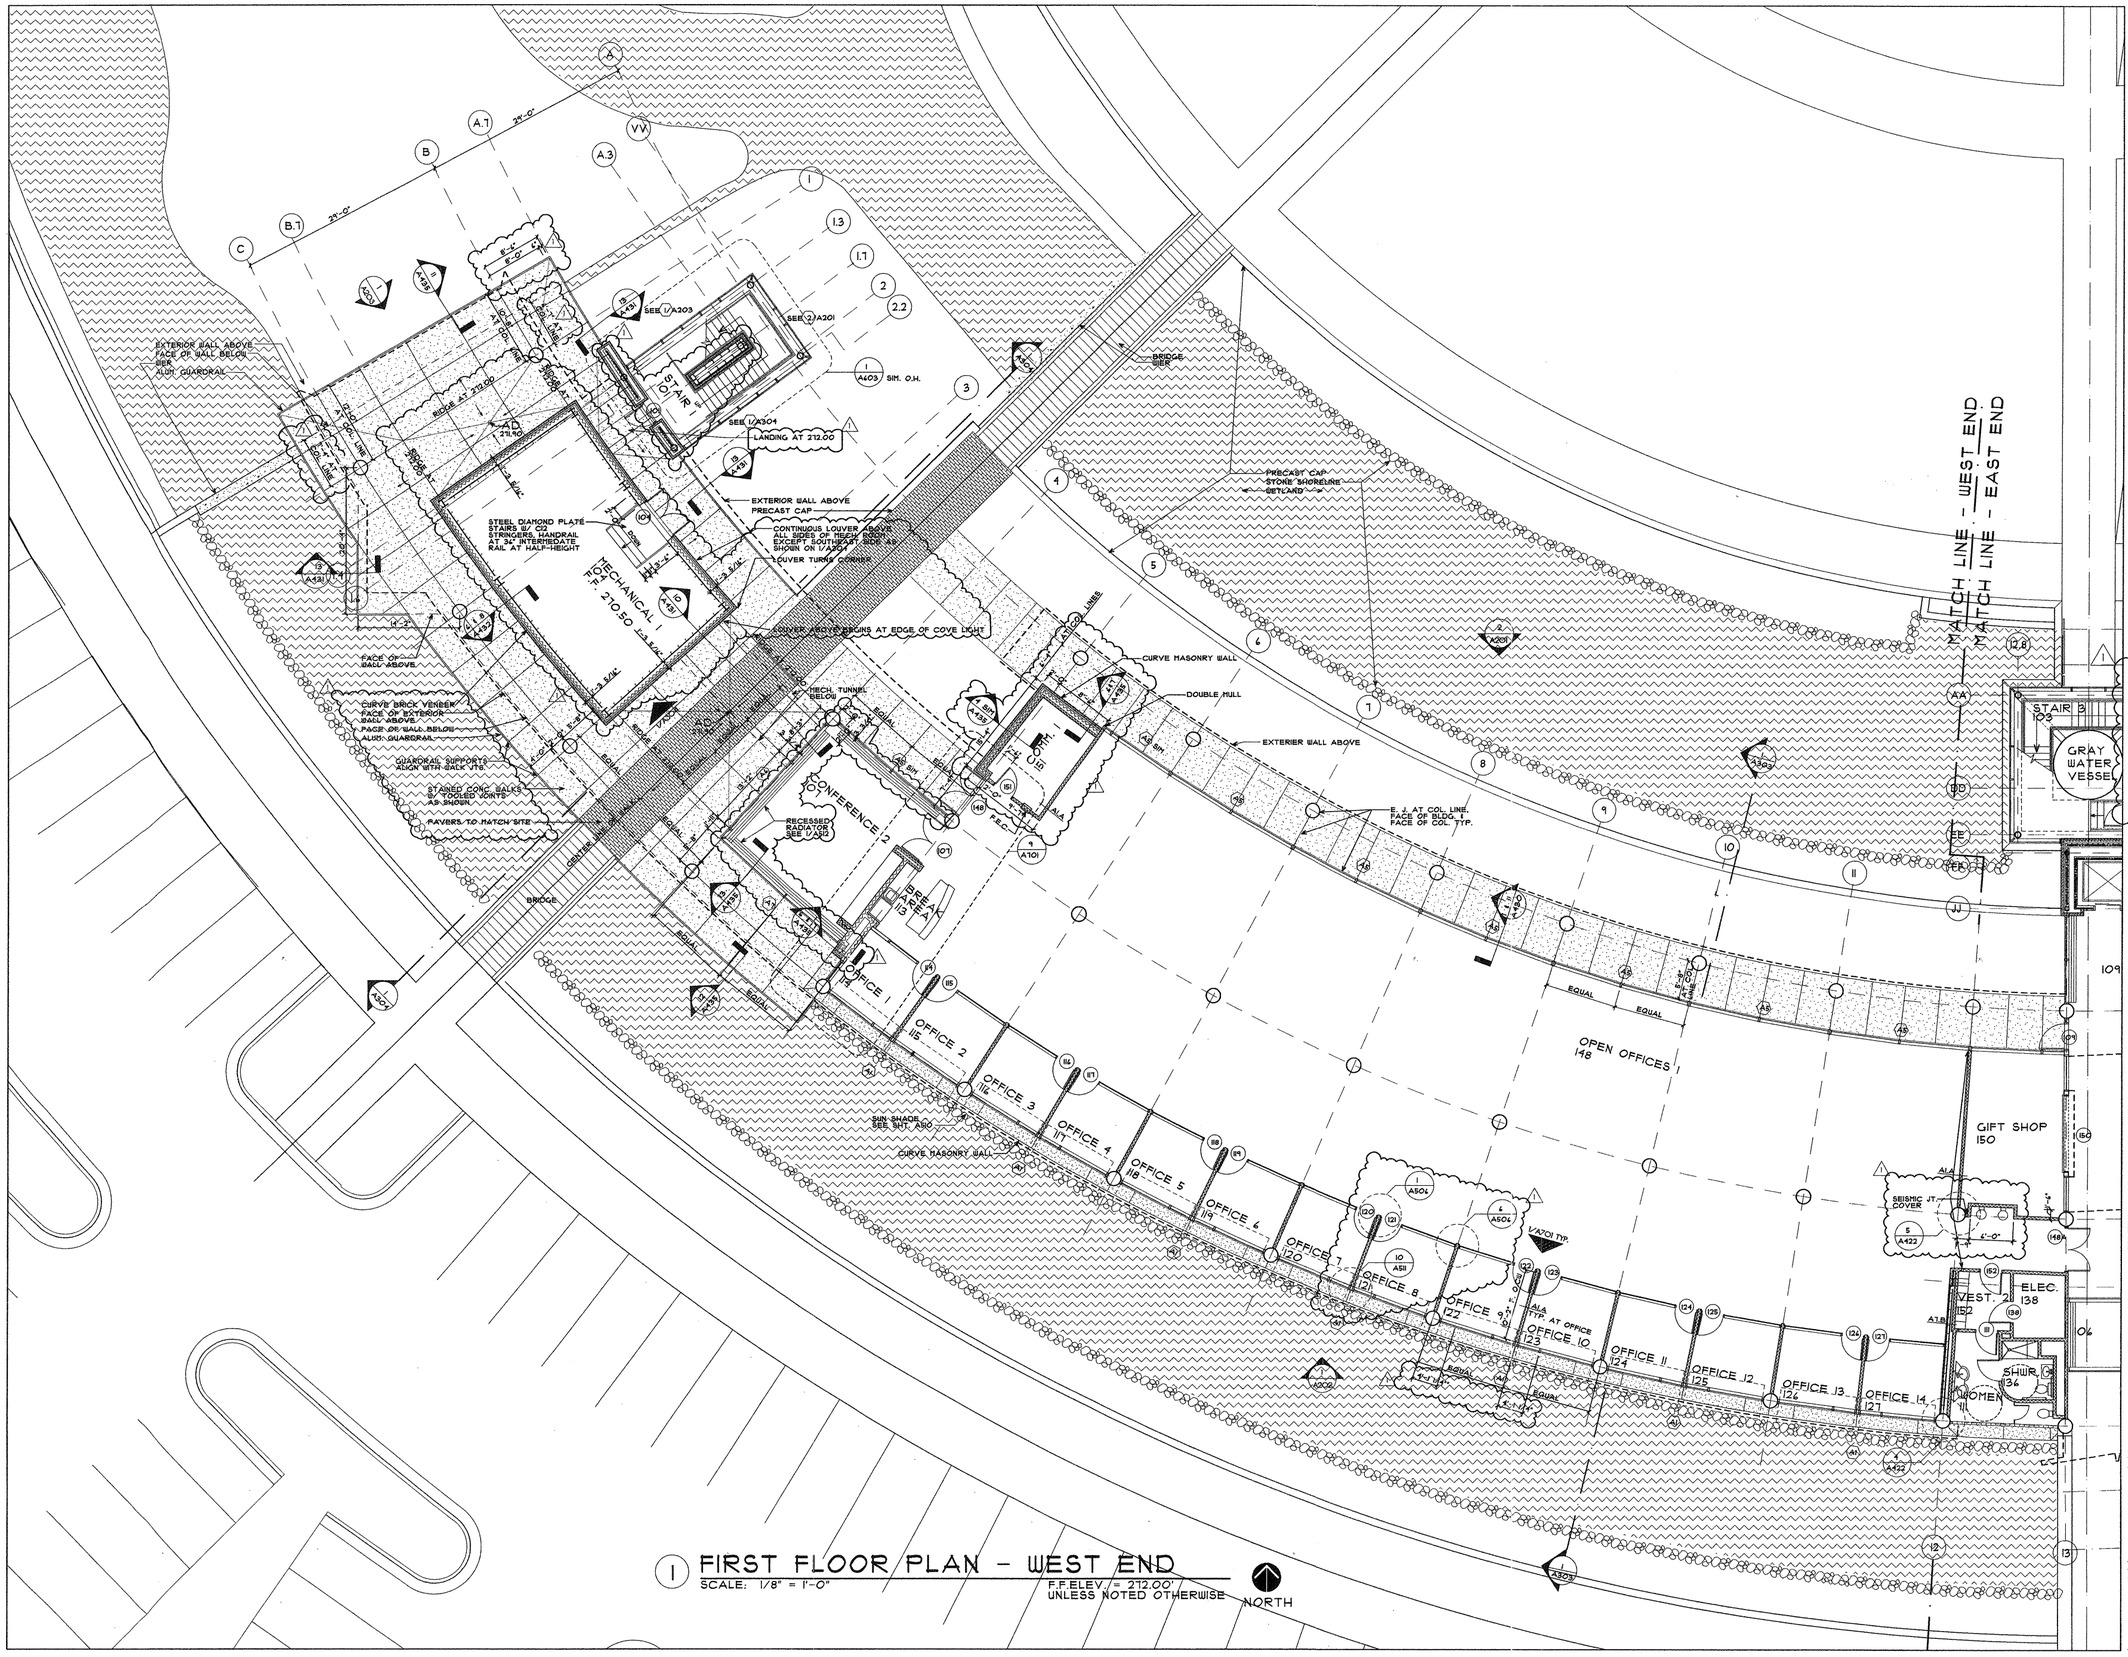

1 FIRST FLOOR PLAN - WEST END

SCALE: 1/8" = 1'-0"

F.F.ELEV. = 212.00' UNLESS NOTED OTHERWISE

NORTH

P:\D-DISC\43C\Cd's\Fnd\Drawings\Arc\Cds\Finals\A101b-FirstFloorPlan-West.tcl Tuesday, June 29, 2004 1:44 PM

POLK
STANLEY
YEARY
ARCHITECTS, LTD.

700 SOUTH SCHILLER
LITTLE ROCK, AR 72201
501 378-0878
FAX 372-7629

21 W. MOUNTAIN, SUITE 227
FAYETTEVILLE, AR 72701
479-444-0473

CONSULTANTS:

OWNER'S PROJECT ADVISOR:
MOSES TUCKER REAL ESTATE, INC.

CIVIL ENGINEER:
McCLELLAND ENGINEERS

LANDSCAPE ARCHITECT:
LARSON BURNS SMITH

STRUCTURAL ENGINEER:
CROMWELL ENGINEERS INC.

MECH., ELEC., PLUMB. ENGINEER:
CROMWELL ENGINEERS INC.

SUSTAINABLE CONSULTANT:
BNIM / ELEMENTS

GLOBAL VILLAGE CONSULTANT
CAMBRIDGE SEVEN ASSOCIATES

INTERIOR DESIGNER:
POLK STANLEY YEARY

GENERAL CONTRACTOR:
CDI

GENERAL NOTES:

1. LOCATE WALLS & PARTITIONS ON CENTERLINE OF COLUMNS UNLESS NOTED OTHERWISE.
2. SEE SHEET G003 FOR COLUMN DIMENSION PLAN.
3. ALL WALLS ARE SEGMENTED TO FOLLOW CURVE OF BUILDING UNLESS NOTED OTHERWISE.

NOTES:

ISSUE DATE:
100% GMP
PACKAGE #6
FEBRUARY 2, 2004

REVISIONS:

#	DATE	DESCRIPTION
1	01JUL04	PACKAGE #7

HEIFER INTERNATIONAL CENTER OFFICE BUILDING

LITTLE ROCK, ARKANSAS

PSY PROJECT NUMBER:
431C

CONTENTS:
FIRST FLOOR PLAN - WEST END

SHEET NUMBER:

A101b

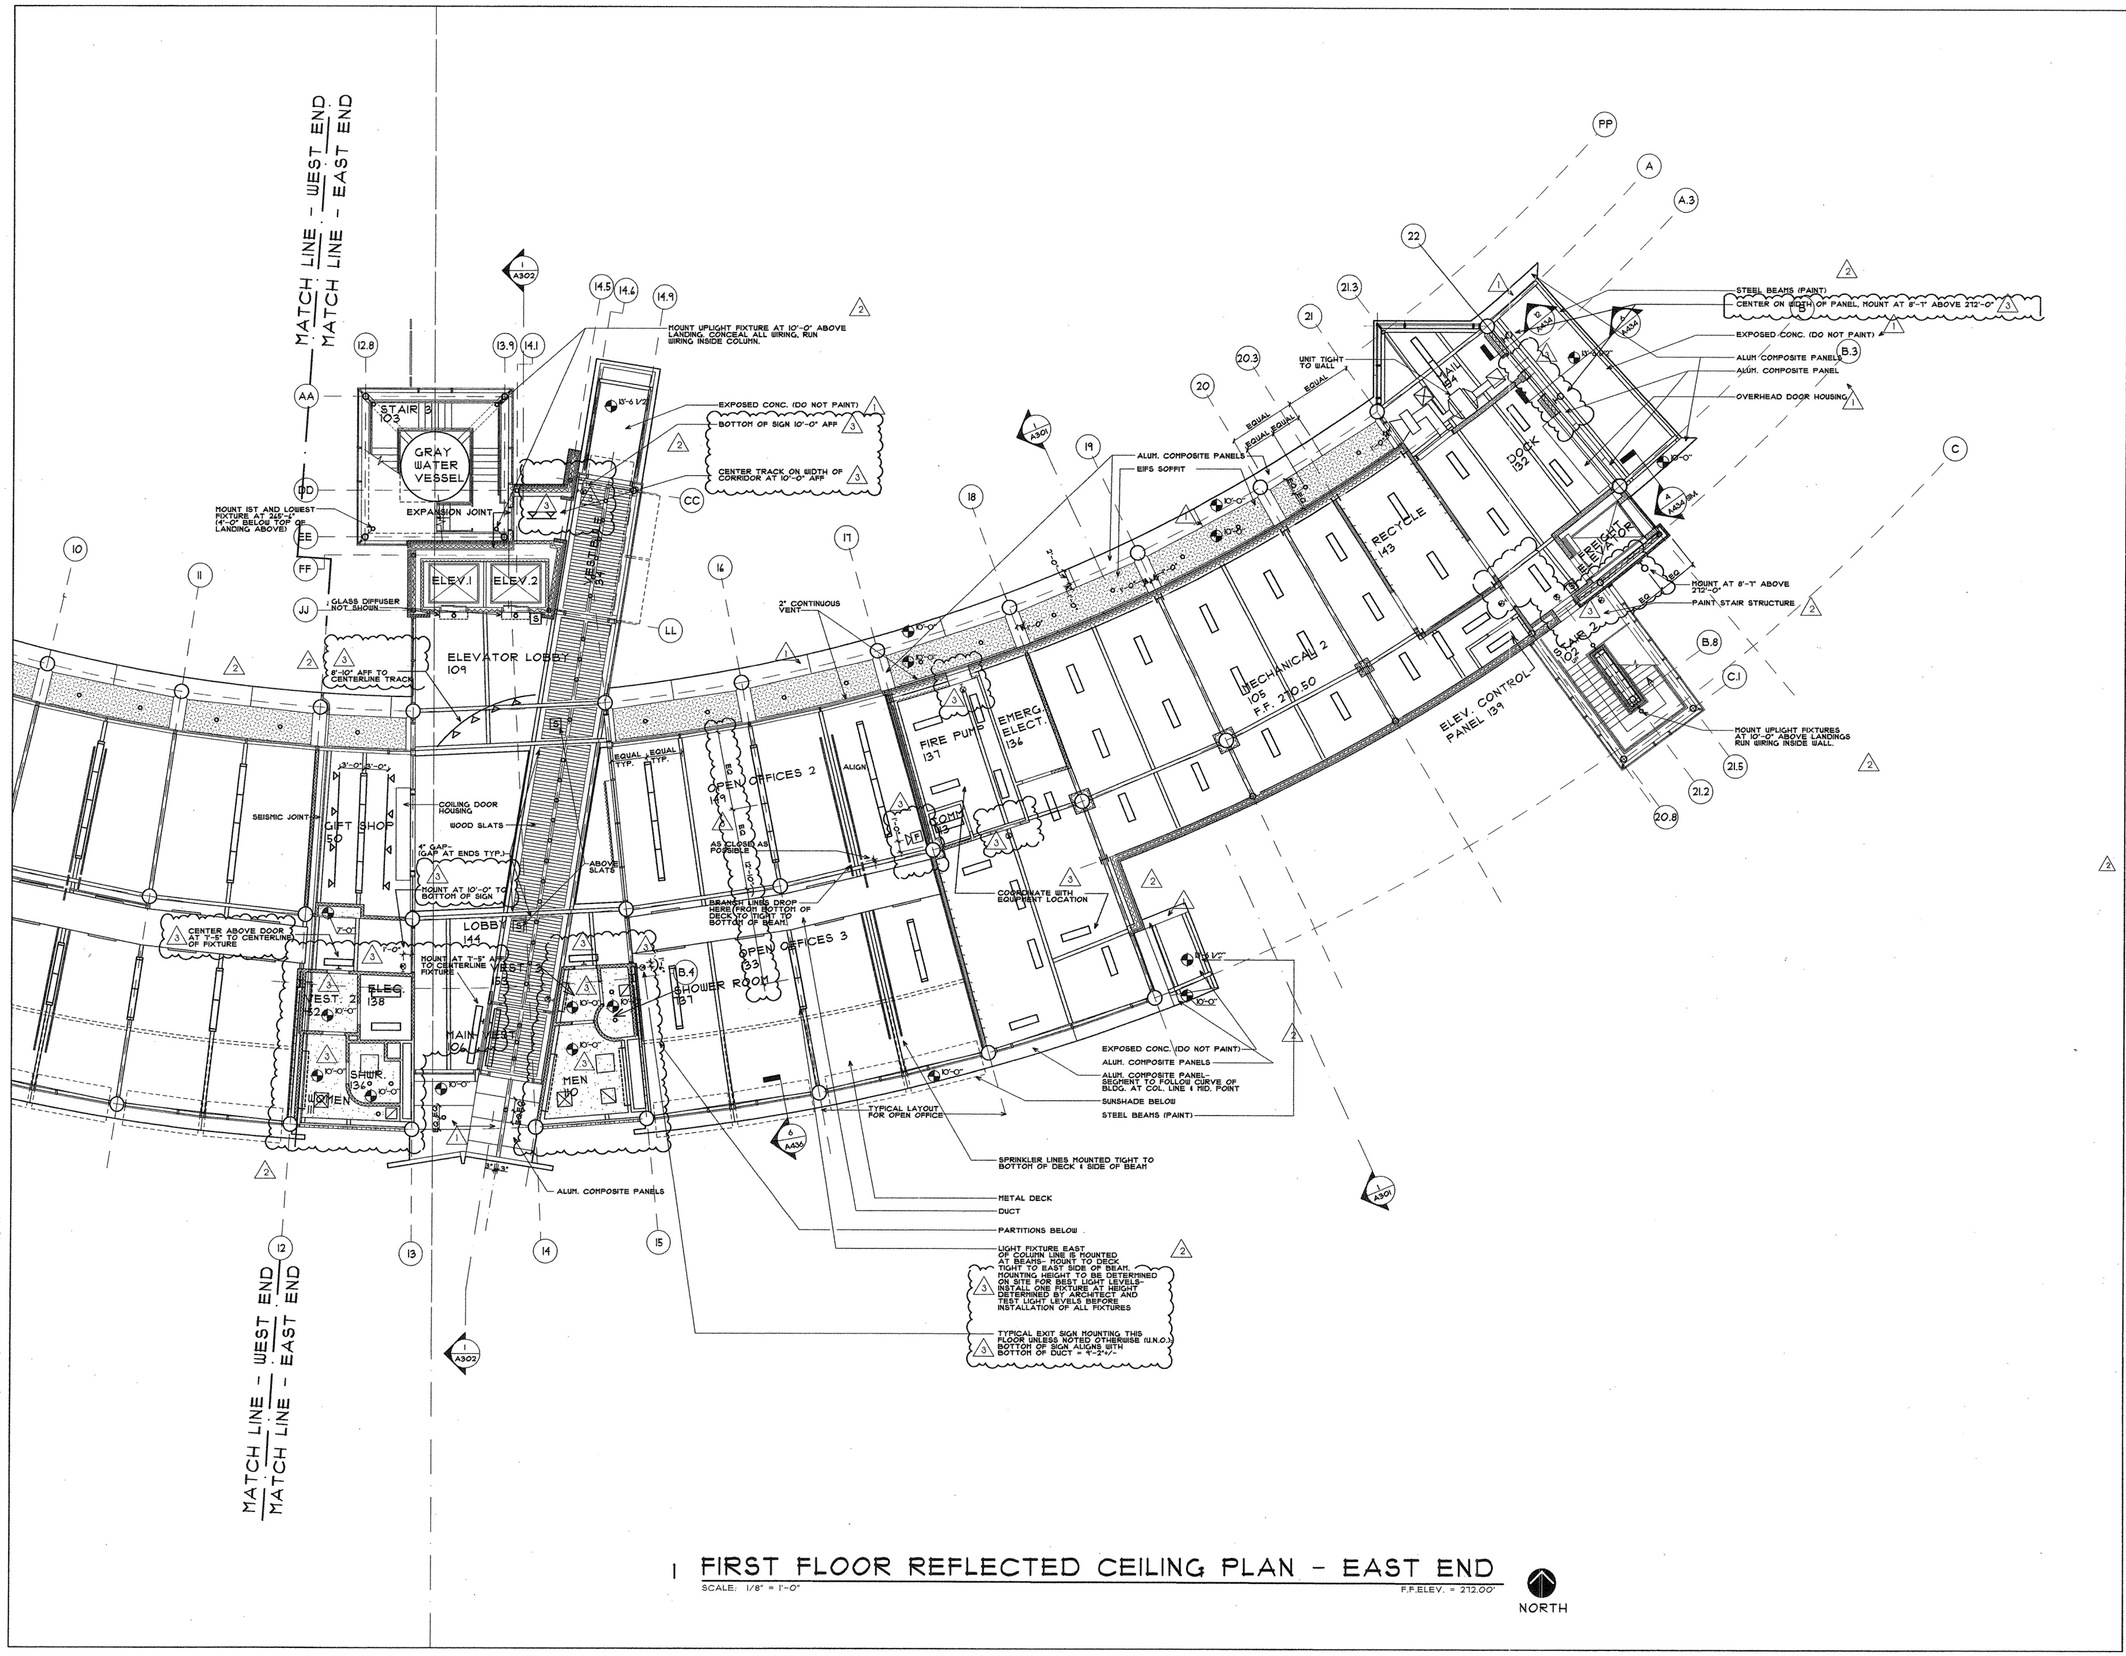

1 FIRST FLOOR REFLECTED CEILING PLAN - EAST END

SCALE: 1/8" = 1'-0"

F.F.ELEV. = 212.00'

NORTH

POLK
STANLEY
YEARY
ARCHITECTS, LTD.

700 SOUTH SCHILLER
LITTLE ROCK, AR 72201
501 378-0878
FAX 372-7629

21 W. MOUNTAIN, SUITE 227
FAYETTEVILLE, AR 72701
479-444-0473

CONSULTANTS:

OWNER'S PROJECT ADVISOR:
MOSES TUCKER REAL ESTATE, INC.

CIVIL ENGINEER:
McCLELLAND ENGINEERS

LANDSCAPE ARCHITECT:
LARSON BURNS SMITH

STRUCTURAL ENGINEER:
CROMWELL ENGINEERS INC.

MECH., ELEC., PLUMB. ENGINEER:
CROMWELL ENGINEERS INC.

SUSTAINABLE CONSULTANT:
BNIM / ELEMENTS

GLOBAL VILLAGE CONSULTANT
CAMBRIDGE SEVEN ASSOCIATES

INTERIOR DESIGNER:
POLK STANLEY YEARY

GENERAL CONTRACTOR:
CDI

GENERAL NOTES:
1. PAINT ALL EXPOSED STEEL DECK & STRUCTURE - SEE SPEC'S FOR SCHEDULE.
2. DO NOT PAINT EXPOSED CONC. DECK.
3. DO NOT PAINT EXPOSED DUCTS.
4. PAINT ALL OTHER EXPOSED SYSTEMS - SEE SPEC'S FOR SCHED.
5. DO NOT PAINT ANY ALUM. MAT.
6. ELEC. CONDUIT SHALL RUN THRU FLOOR PLENUM ABOVE THEN DROP TO FIXTURE AND DEVICE J-BOX.
NAILER.
7. PENDANT FIXTURES: MOUNT TIGHT TO SIDES OF BEAMS INDICATED UNLESS NOTED OTHERWISE. SEE BUILDING SECTIONS FOR ADDITIONAL INFORMATION.
8. LOCATION OF ALL DEVICES, FIXTURES, ETC. SHALL BE REVIEWED WITH ARCHITECT BEFORE INSTALLATION.
9. SEE BUILDING SECTIONS FOR ADDITIONAL INFORMATION ON SPRINKLER LINE LOCATIONS.

NOTES:
[S] SMOKE DETECTOR
[F] FIRE STROBE/HORN (8'-0")

ISSUE DATE:
100% GMP
PACKAGE #6
FEBRUARY 2, 2004

REVISIONS:

#	DATE	DISCRIPTION
1	1/16/04	PACKAGE 5, ADDN. 01
2	01JUL04	PACKAGE #7
3	15NOV04	ASI NO. 25

HEIFER INTERNATIONAL CENTER OFFICE BUILDING

LITTLE ROCK, ARKANSAS

PSY PROJECT NUMBER:
431C

CONTENTS:
FIRST FLOOR RELECTED CEILING PLAN - EAST END
SHEET NUMBER:

A101c

P:\0-DWG\431C\Cd's and Design\Pr-DD's\Final\A101c-FirstFloorReflectedCeilingPlan-EastEnd.dwg November 15, 2004 4:31 PM

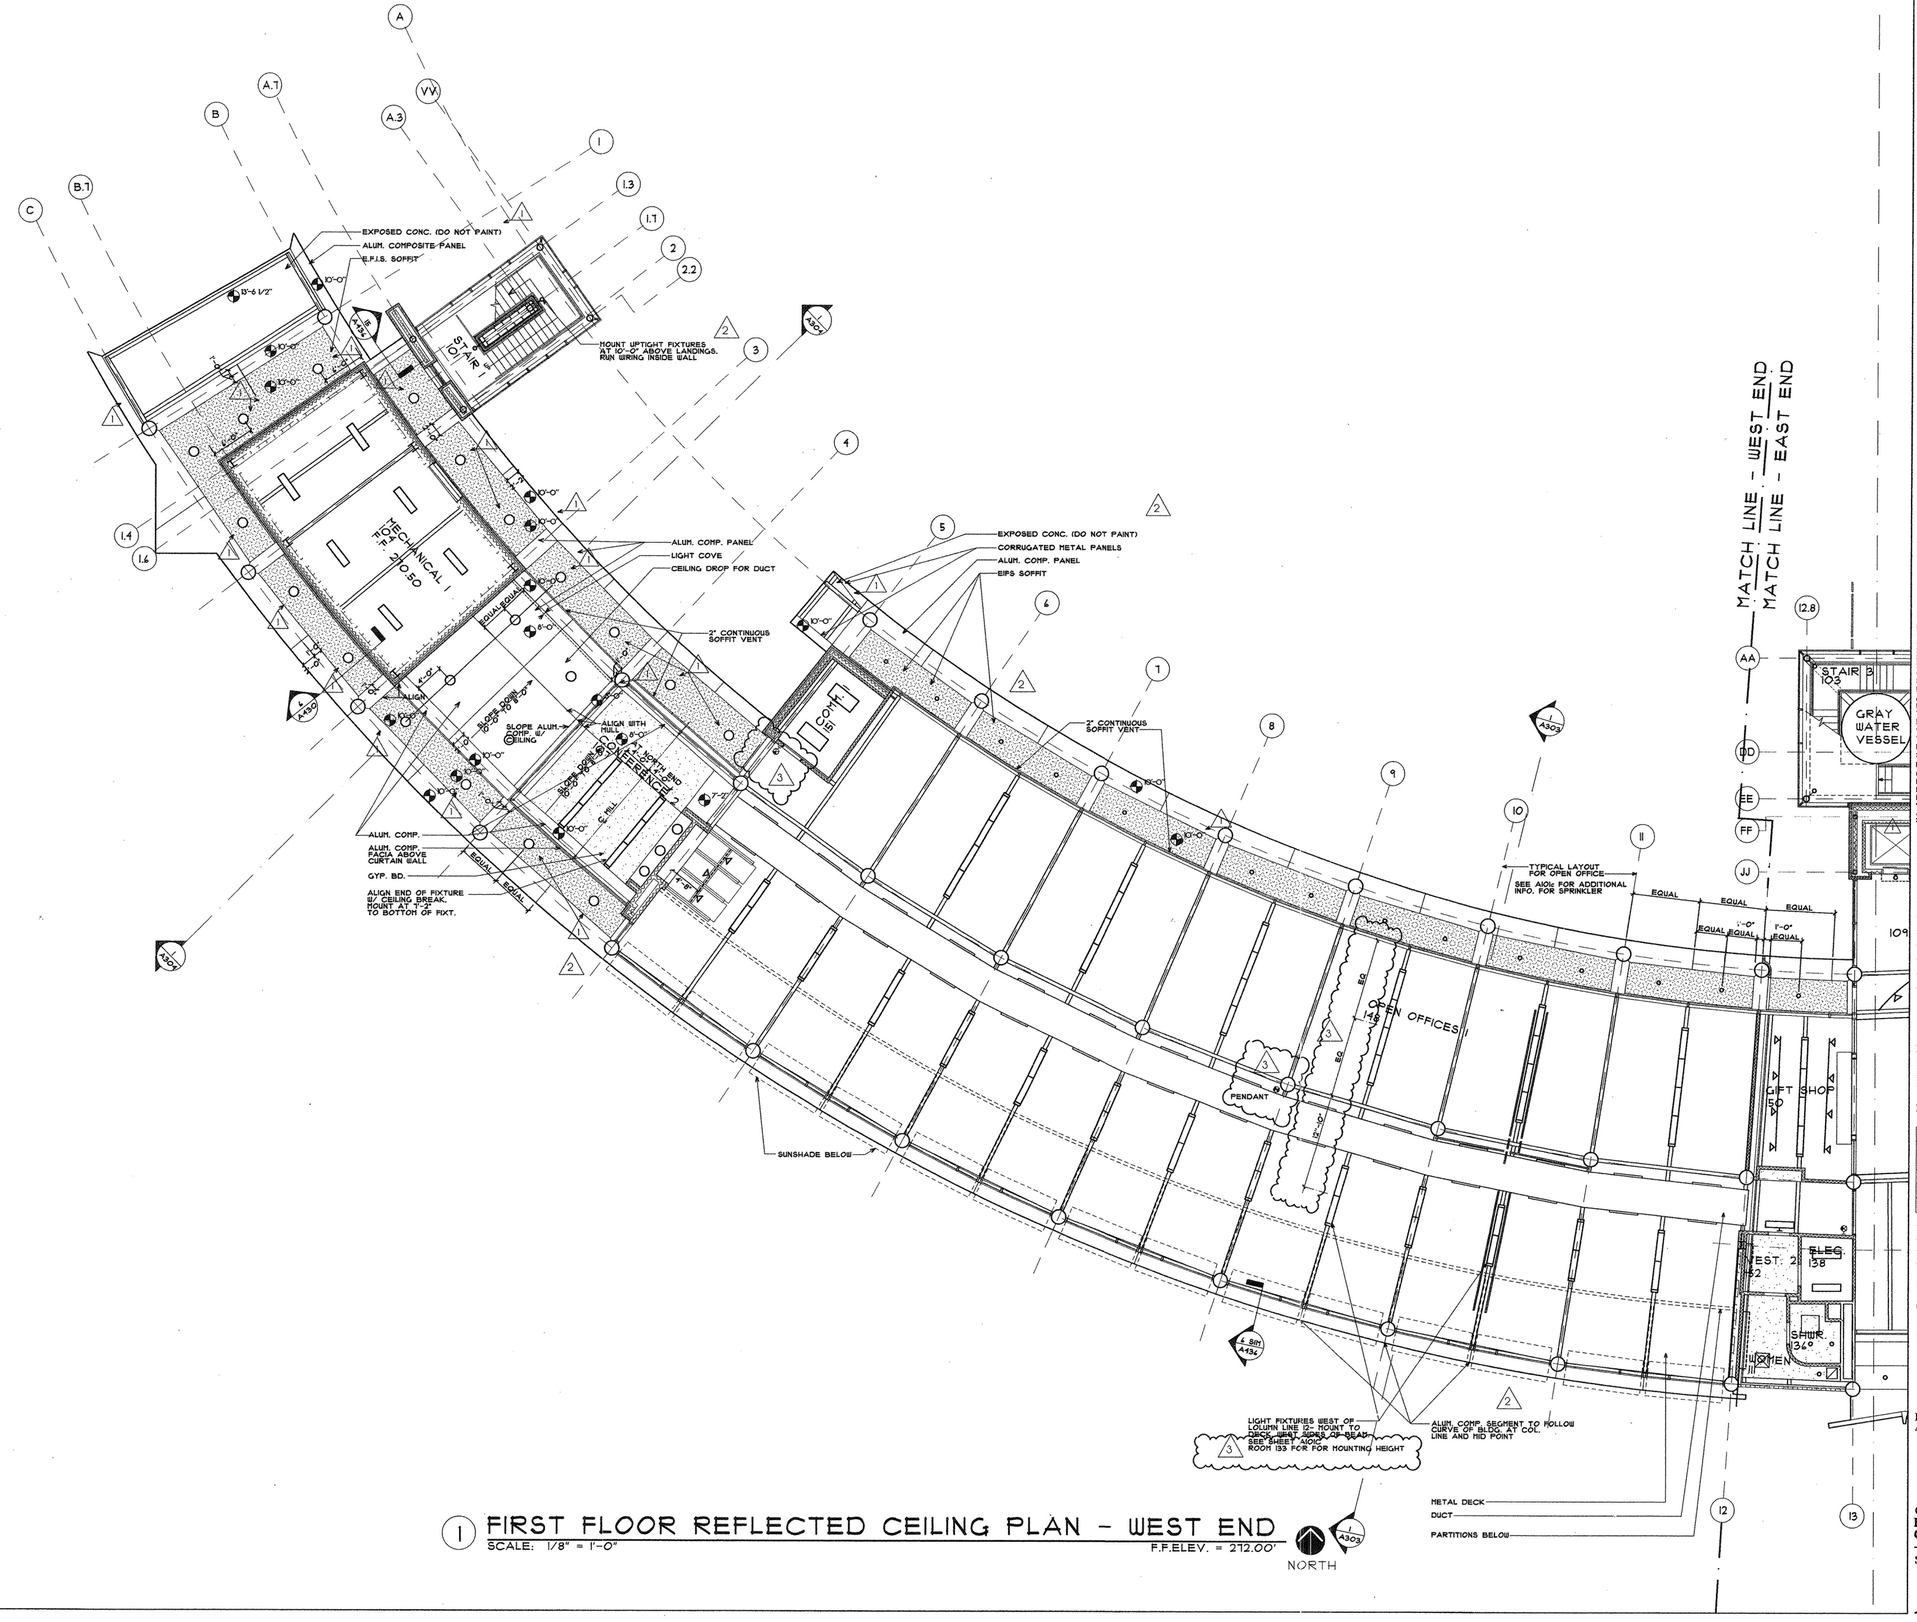

1 FIRST FLOOR REFLECTED CEILING PLAN - WEST END

SCALE: 1/8" = 1'-0"


POLK
STANLEY
YEARY
ARCHITECTS, LTD.

700 SOUTH SCHILLER
LITTLE ROCK, AR 72201
501 378-0878
FAX 372-7629

21 W. MOUNTAIN, SUITE 227
FAYETTEVILLE, AR 72701
479-444-0473

CONSULTANTS:

OWNER'S PROJECT ADVISOR:
MOSES TUCKER REAL ESTATE, INC.

CIVIL ENGINEER:
McCLELLAND ENGINEERS

LANDSCAPE ARCHITECT:
LARSON BURNS SMITH

STRUCTURAL ENGINEER:
CROMWELL ENGINEERS INC.

MECH., ELEC., PLUMB. ENGINEER:
CROMWELL ENGINEERS INC.

SUSTAINABLE CONSULTANT:
BNIM / ELEMENTS

GLOBAL VILLAGE CONSULTANT
CAMBRIDGE SEVEN ASSOCIATES

INTERIOR DESIGNER:
POLK STANLEY YEARY

GENERAL CONTRACTOR:
CDI

GENERAL NOTES:

1. PAINT ALL EXPOSED STEEL DECK & STRUCTURE - SEE SPEC'S FOR SCHEDULE.
2. DO NOT PAINT EXPOSED CONC. DECK.
3. DO NOT PAINT EXPOSED DUCTS.
4. PAINT ALL OTHER EXPOSED SYSTEMS - SEE SPEC'S FOR SCHED.
5. DO NOT PAINT ANY ALUM. MAT.
6. ELEC. CONDUIT SHALL RUN THRU FLOOR PLENUM ABOVE THEN DROP TO FIXTURE AND DEVICE J-BOX.
7. PENDANT FIXTURES: MOUNT TIGHT TO SIDES OF BEAMS INDICATED UNLESS NOTED OTHERWISE. SEE BUILDING SECTIONS FOR ADDITIONAL INFORMATION.
8. LOCATION OF ALL DEVICES, FIXTURES, ETC. SHALL BE REVIEWED WITH ARCHITECT BEFORE INSTALLATION.
9. SEE BUILDING SECTIONS FOR ADDITIONAL INFORMATION ON SPRINKLER LINE LOCATIONS.

NOTES:

ISSUE DATE:
100% GMP
PACKAGE #6
FEBRUARY 2, 2004

REVISIONS:

#	DATE	DESCRIPTION
1	1/16/04	PACKAGE 5, ADDM. 01
2	01JUL04	PACKAGE #7
3	15NOV04	ASI NO. 25

HEIFER INTERNATIONAL CENTER OFFICE BUILDING

LITTLE ROCK, ARKANSAS

PSY PROJECT NUMBER:
431C

CONTENTS:
FIRST FLOOR REFLECTED CEILING PLAN - WEST END
SHEET NUMBER:

A101d

P:\0-DWG\431C\Cd's\Pdf\Drawings\Arch\A104-FirstFloorReflectedCeilingPlan-WestEndSpreadsheet 15, 2004 4:34 PM

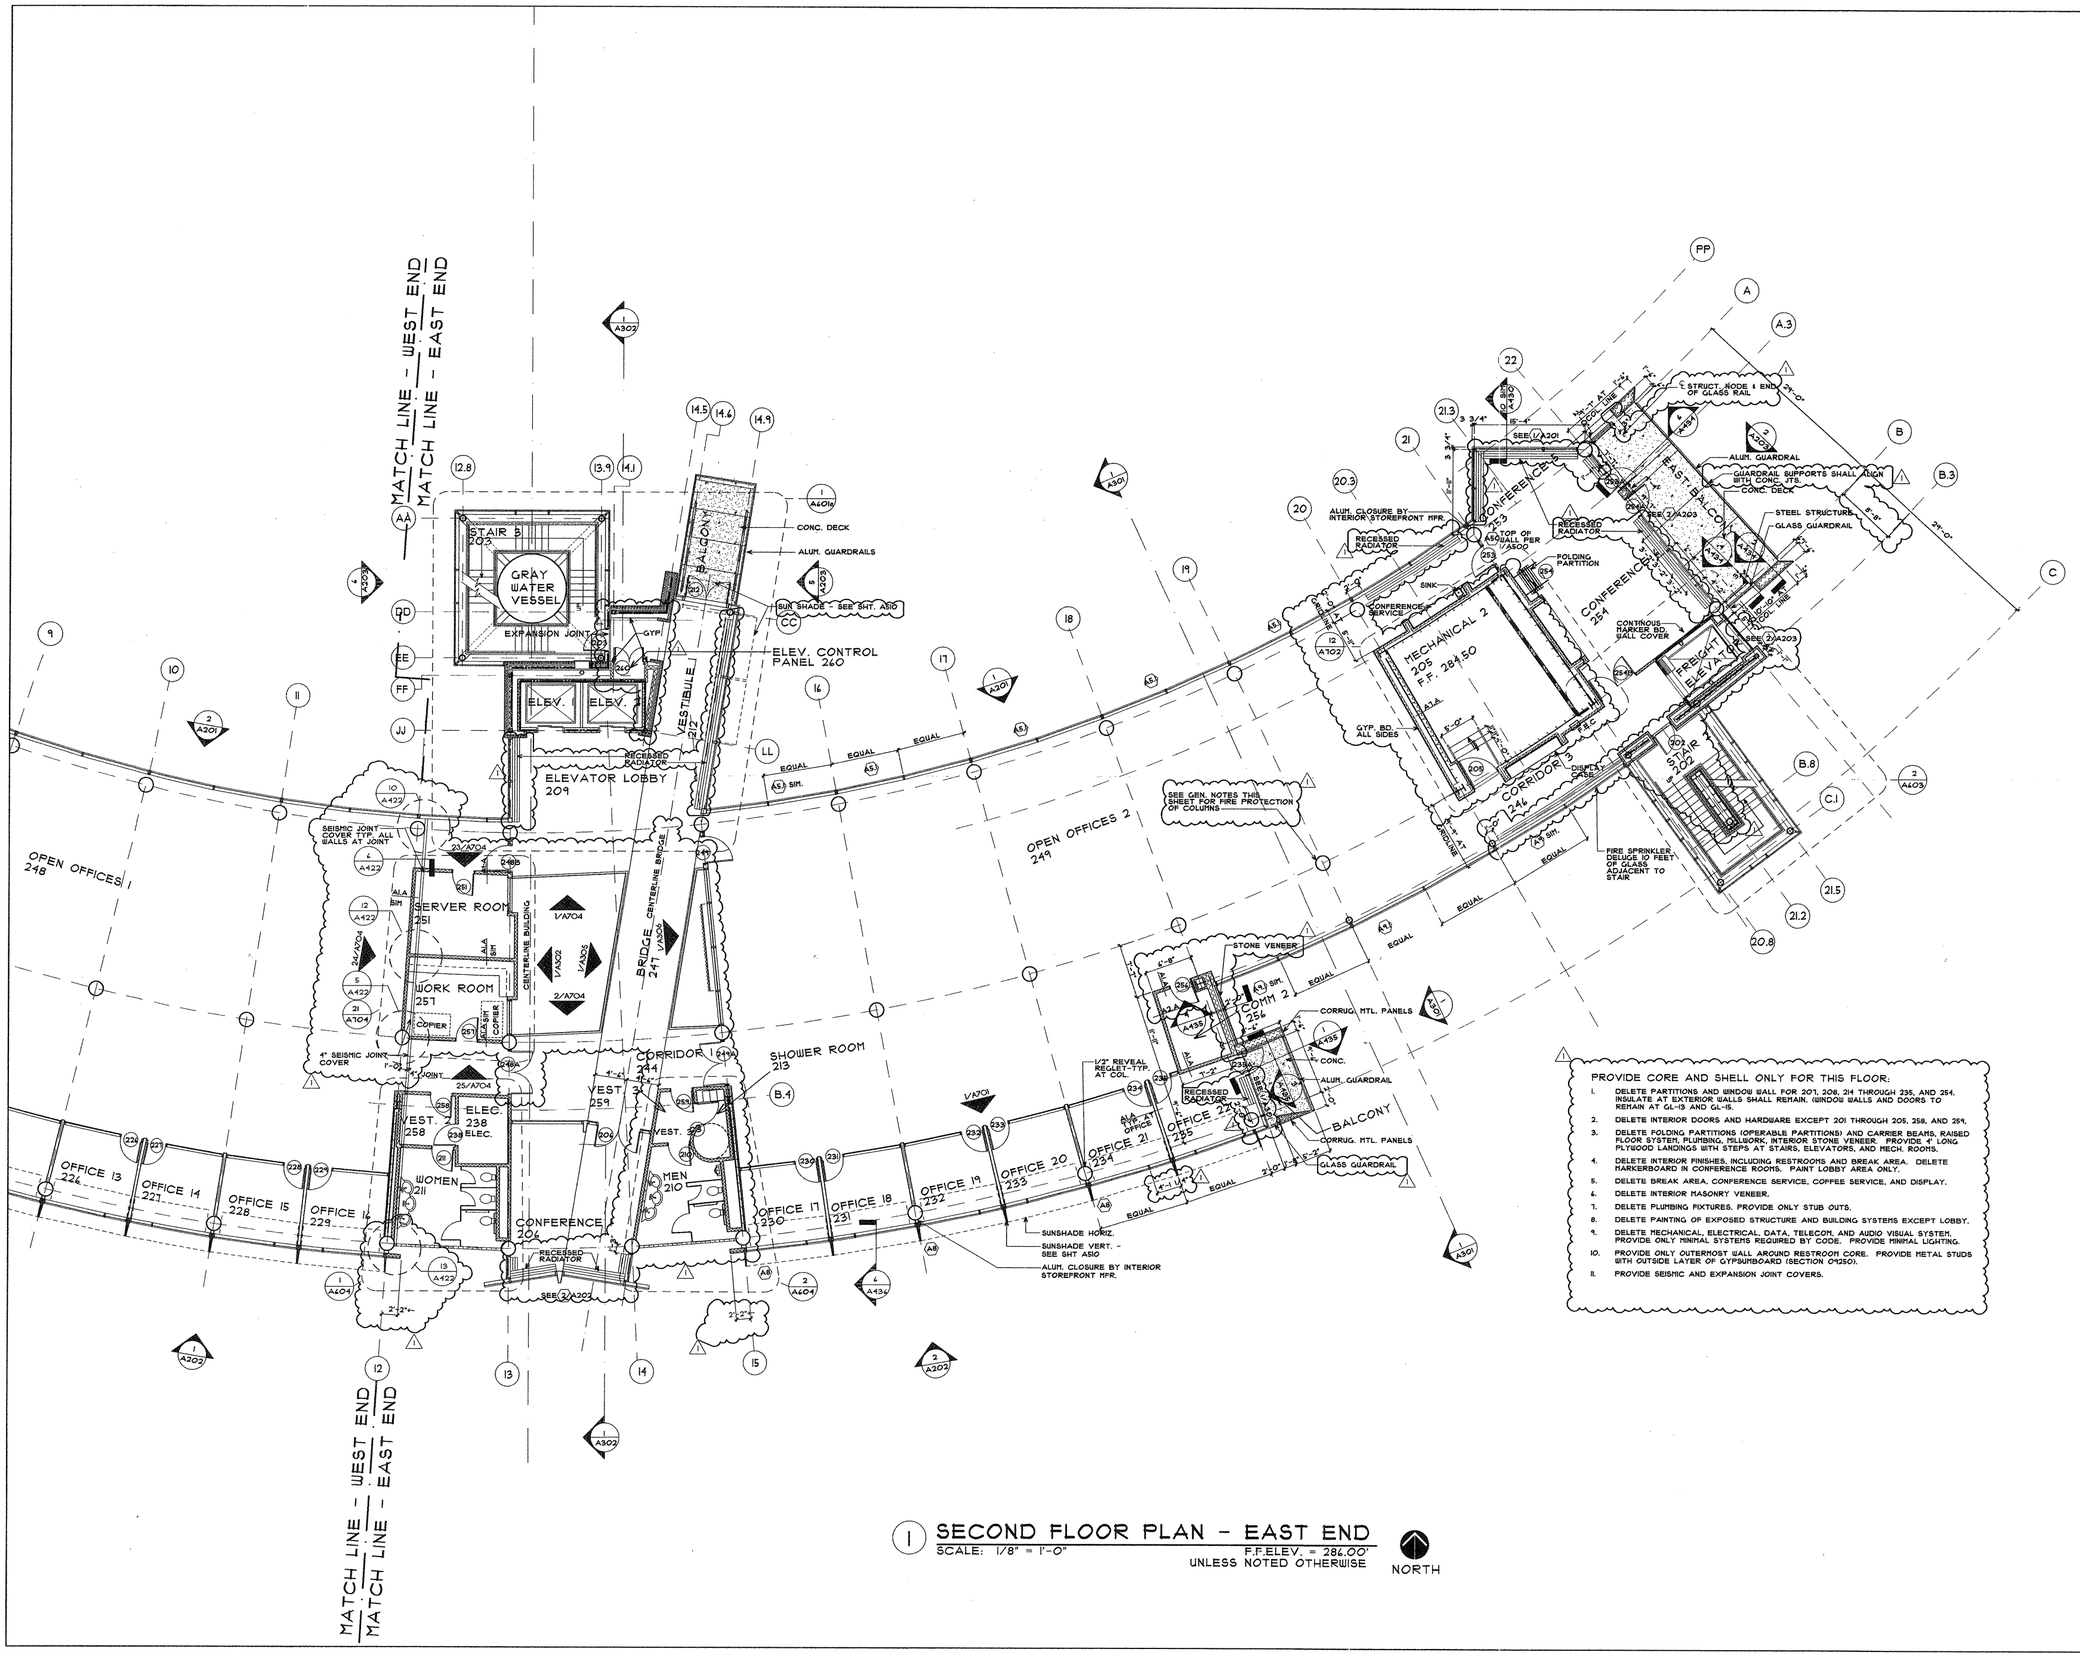

(1) SECOND FLOOR PLAN - EAST END

SCALE: 1/8" = 1'-0" F.F.ELEV. = 284.00' UNLESS NOTED OTHERWISE

NORTH

PROVIDE CORE AND SHELL ONLY FOR THIS FLOOR:

1. DELETE PARTITIONS AND WINDOW WALLS FOR 207, 208, 214 THROUGH 235, AND 254. INSULATE AT EXTERIOR WALLS SHALL REMAIN. WINDOW WALLS AND DOORS TO REMAIN AT GL-13 AND GL-15.
2. DELETE INTERIOR DOORS AND HARDWARE EXCEPT 201 THROUGH 205, 256, AND 259.
3. DELETE FOLDING PARTITIONS (OPERABLE PARTITIONS) AND CARRIER BEARS, RAISED FLOOR SYSTEM, PLUMBING, MILLWORK, INTERIOR STONE VENEER. PROVIDE 4" LONG PLYWOOD LANDINGS WITH STEPS AT STAIRS, ELEVATORS, AND MECH. ROOMS.
4. DELETE INTERIOR FINISHES, INCLUDING RESTROOMS AND BREAK AREA. DELETE MARKERBOARD IN CONFERENCE ROOMS. PAINT LOBBY AREA ONLY.
5. DELETE BREAK AREA, CONFERENCE SERVICE, COFFEE SERVICE, AND DISPLAY.
6. DELETE INTERIOR MASONRY VENEER.
7. DELETE PLUMBING FIXTURES. PROVIDE ONLY STUB OUTS.
8. DELETE PAINTING OF EXPOSED STRUCTURE AND BUILDING SYSTEMS EXCEPT LOBBY.
9. DELETE MECHANICAL, ELECTRICAL, DATA, TELECOM, AND AUDIO VISUAL SYSTEM. PROVIDE ONLY MINIMAL SYSTEMS REQUIRED BY CODE. PROVIDE MINIMAL LIGHTING.
10. PROVIDE ONLY OUTERMOST WALL AROUND RESTROOM CORE. PROVIDE METAL STUDS WITH OUTSIDE LAYER OF GYPSUMBOARD (SECTION 09250).
11. PROVIDE SEISMIC AND EXPANSION JOINT COVERS.

GENERAL NOTES:

1. LOCATE WALLS & PARTITIONS ON CENTERLINE OF COLUMNS UNLESS NOTED OTHERWISE.
2. SEE SHEET G003 FOR COLUMN DIMENSION PLAN.
3. ALL WALLS ARE SEGMENTED TO FOLLOW CURVE OF BUILDING UNLESS NOTED OTHERWISE.
4. PROVIDE 1 HR. INTUMESCENT FIRE PROOFING FOR COLUMNS A-4 THRU A-20, B-16 THRU B-19.

POLK
STANLEY
YEARY
ARCHITECTS, LTD.

700 SOUTH SCHILLER
LITTLE ROCK, AR 72201
501 378-0878
FAX 372-7529

21 W. MOUNTAIN, SUITE 227
FAYETTEVILLE, AR 72701
479-444-0473

CONSULTANTS:

OWNER'S PROJECT ADVISOR:
MOSES TUCKER REAL ESTATE, INC.

CIVIL ENGINEER:
McCLELLAND ENGINEERS

LANDSCAPE ARCHITECT:
LARSON BURNS SMITH

STRUCTURAL ENGINEER:
CROMWELL ENGINEERS INC.

MECH., ELEC., PLUMB. ENGINEER:
CROMWELL ENGINEERS INC.

SUSTAINABLE CONSULTANT:
BNIM / ELEMENTS

GLOBAL VILLAGE CONSULTANT
CAMBRIDGE SEVEN ASSOCIATES

INTERIOR DESIGNER:
POLK STANLEY YEARY

GENERAL CONTRACTOR:
CDI

NOTES:

ISSUE DATE:
100% GMP
PACKAGE #6
FEBRUARY 2, 2004

REVISIONS:

#	DATE	DESCRIPTION
1	04JUL04	PACKAGE #1

HEIFER INTERNATIONAL CENTER OFFICE BUILDING

LITTLE ROCK, ARKANSAS

PSY PROJECT NUMBER:
431C

CONTENTS:
SECOND FLOOR PLAN - EAST END

SHEET NUMBER:

A102a


PROVIDE DORE AND SHELL ONLY THIS FLOOR

SEE A102a FOR SCOPE

1 SECOND FLOOR PLAN - WEST END

SCALE: 1/8" = 1'-0"

F.F.ELEV. = 286.00'
UNLESS NOTED OTHERWISE

NORTH

POLK STANLEY YEARY ARCHITECTS, LTD.

700 SOUTH SCHILLER
LITTLE ROCK, AR 72201
501 378-0878
FAX 372-7629

21 W. MOUNTAIN, SUITE 227
FAYETTEVILLE, AR 72701
479-444-0473

CONSULTANTS:

OWNER'S PROJECT ADVISOR:
MOSES TUCKER REAL ESTATE, INC.

CIVIL ENGINEER:
McCLELLAND ENGINEERS

LANDSCAPE ARCHITECT:
LARSON BURNS SMITH

STRUCTURAL ENGINEER:
CROMWELL ENGINEERS INC.

MECH., ELEC., PLUMB. ENGINEER:
CROMWELL ENGINEERS INC.

SUSTAINABLE CONSULTANT:
BNIM / ELEMENTS

GLOBAL VILLAGE CONSULTANT
CAMBRIDGE SEVEN ASSOCIATES

INTERIOR DESIGNER:
POLK STANLEY YEARY

GENERAL CONTRACTOR:
CDI

GENERAL NOTES:

1. LOCATE WALLS & PARTITIONS ON CENTERLINE OF COLUMNS UNLESS NOTED OTHERWISE.
2. SEE SHEET G003 FOR COLUMN DIMENSION PLAN.
3. ALL WALLS ARE SEGMENTED TO FOLLOW CURVE OF BUILDING UNLESS NOTED OTHERWISE.

NOTES:

ISSUE DATE:
100% GMP
PACKAGE #6
FEBRUARY 2, 2004

REVISIONS:

#	DATE	DESCRIPTION
1	04JUL04	PACKAGE #7

HEIFER INTERNATIONAL CENTER OFFICE BUILDING

LITTLE ROCK, ARKANSAS

PSY PROJECT NUMBER:
431C

CONTENTS:
SECOND FLOOR PLAN - WEST END

SHEET NUMBER:

A102b

P:\0-DWG\431C\CA\Final Drawings\Arch\A102b-SecondFloorPlan-West.dwg Tuesday, June 29, 2004 10:00 AM

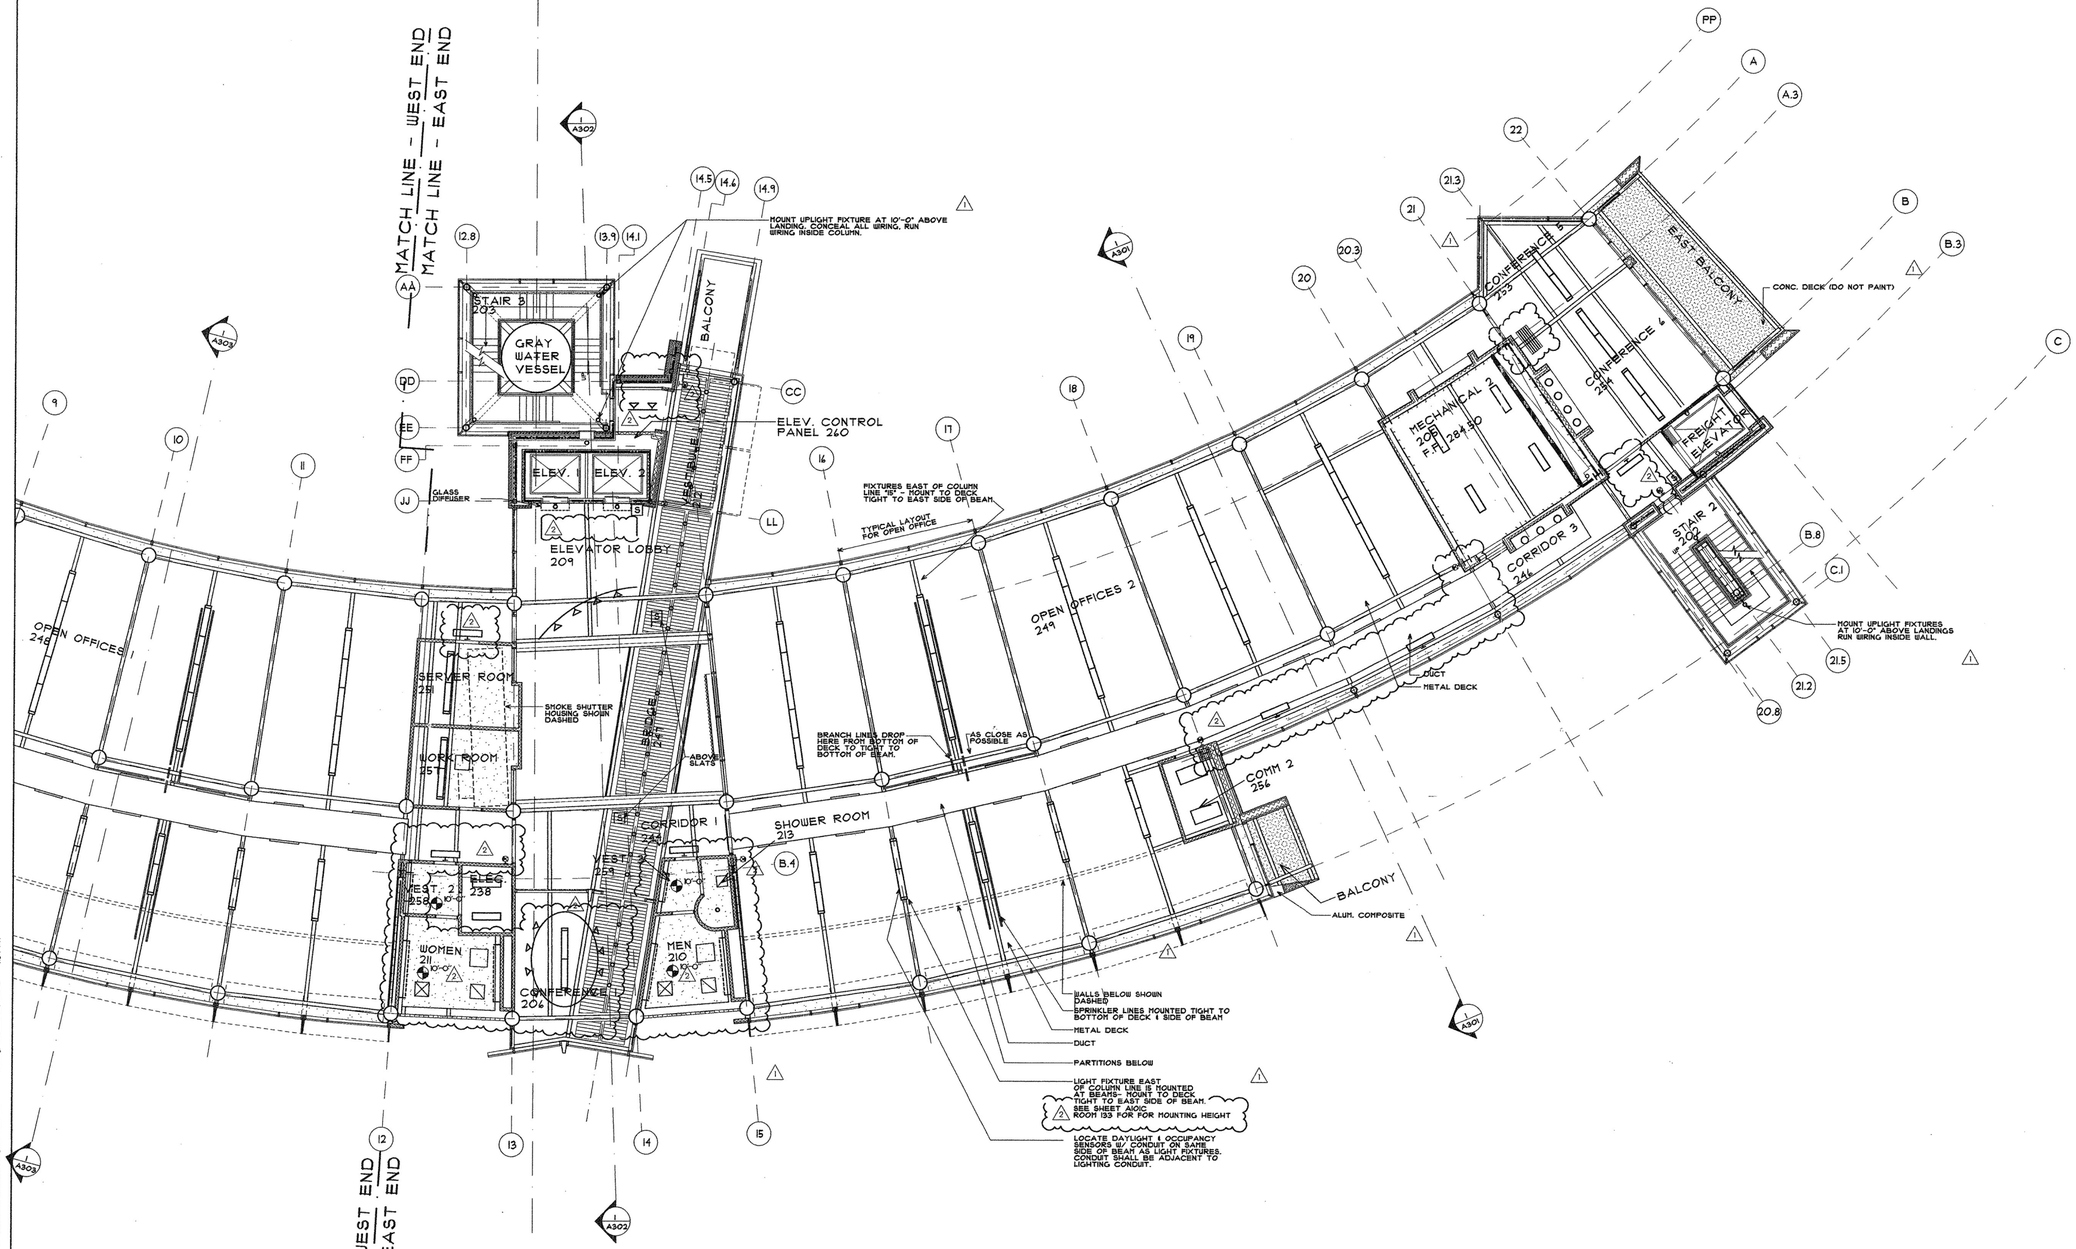

1 SECOND FLOOR REFLECTED CEILING PLAN - EAST END

SCALE: 1/8" = 1'-0" F.F.ELEV. = 284.00'

NORTH

PROVIDE CORE AND SHELL ONLY THIS FLOOR

SEE A102a FOR SCOPE

P:\D-DRG\431C\CAD\ArchDrawings\ReCDs\Final\A102c-SecondFloorReflectedCeilingPlan-East End Monday, November 15, 2004 4:34 PM

POLK
STANLEY
YEARY
ARCHITECTS, LTD.

700 SOUTH SCHILLER
LITTLE ROCK, AR 72201
501 378-0878
FAX 372-7629

21 W. MOUNTAIN, SUITE 227
FAYETTEVILLE, AR 72701
479-444-0473

CONSULTANTS:

OWNER'S PROJECT ADVISOR:
MOSES TUCKER REAL ESTATE, INC.

CIVIL ENGINEER:
McCLELLAND ENGINEERS

LANDSCAPE ARCHITECT:
LARSON BURNS SMITH

STRUCTURAL ENGINEER:
CROMWELL ENGINEERS INC.

MECH., ELEC., PLUMB. ENGINEER:
CROMWELL ENGINEERS INC.

SUSTAINABLE CONSULTANT:
BNIM / ELEMENTS

GLOBAL VILLAGE CONSULTANT
CAMBRIDGE SEVEN ASSOCIATES

INTERIOR DESIGNER:
POLK STANLEY YEARY

GENERAL CONTRACTOR:
CDI

GENERAL NOTES:
1. PAINT ALL EXPOSED STEEL DECK & STRUCTURE - SEE SPEC'S FOR SCHEDULE.
2. DO NOT PAINT EXPOSED CONC. DECK.
3. DO NOT PAINT EXPOSED DUCTS.
4. PAINT ALL OTHER EXPOSED SYSTEMS - SEE SPEC'S FOR SCHED.
5. DO NOT PAINT ANY ALUM. MAT.
6. ELEC. CONDUIT SHALL RUN THRU FLOOR PLENUM ABOVE THEN DROP TO FIXTURE AND DEVICE J-BOX.
7. PENDANT FIXTURES, MOUNT TIGHT TO SIDES OF BEAMS INDICATED UNLESS NOTED OTHERWISE. SEE BUILDING SECTIONS FOR ADDITIONAL INFORMATION.
8. LOCATION OF ALL DEVICES, FIXTURES, ETC. SHALL BE REVIEWED WITH ARCHITECT BEFORE INSTALLATION.
9. SEE BUILDING SECTIONS FOR ADDITIONAL INFORMATION ON SHIMMER CHANNEL CEILINGS.
10. SEE 3RD FLOOR PLANS FOR LOCATION OF FIXTURES.

NOTES:

ISSUE DATE:
100% GMP
PACKAGE #6
FEBRUARY 2, 2004

REVISIONS:

#	DATE	DESCRIPTION
1	01JUL04	PACKAGE #7
2	15NOV04	ASI NO. 25

HEIFER
INTERNATIONAL
CENTER
OFFICE BUILDING

LITTLE ROCK, ARKANSAS

PSY PROJECT NUMBER:
431C

CONTENTS:
SECOND FLOOR REFLECTED CEILING PLAN - EAST END

SHEET NUMBER:

A102c

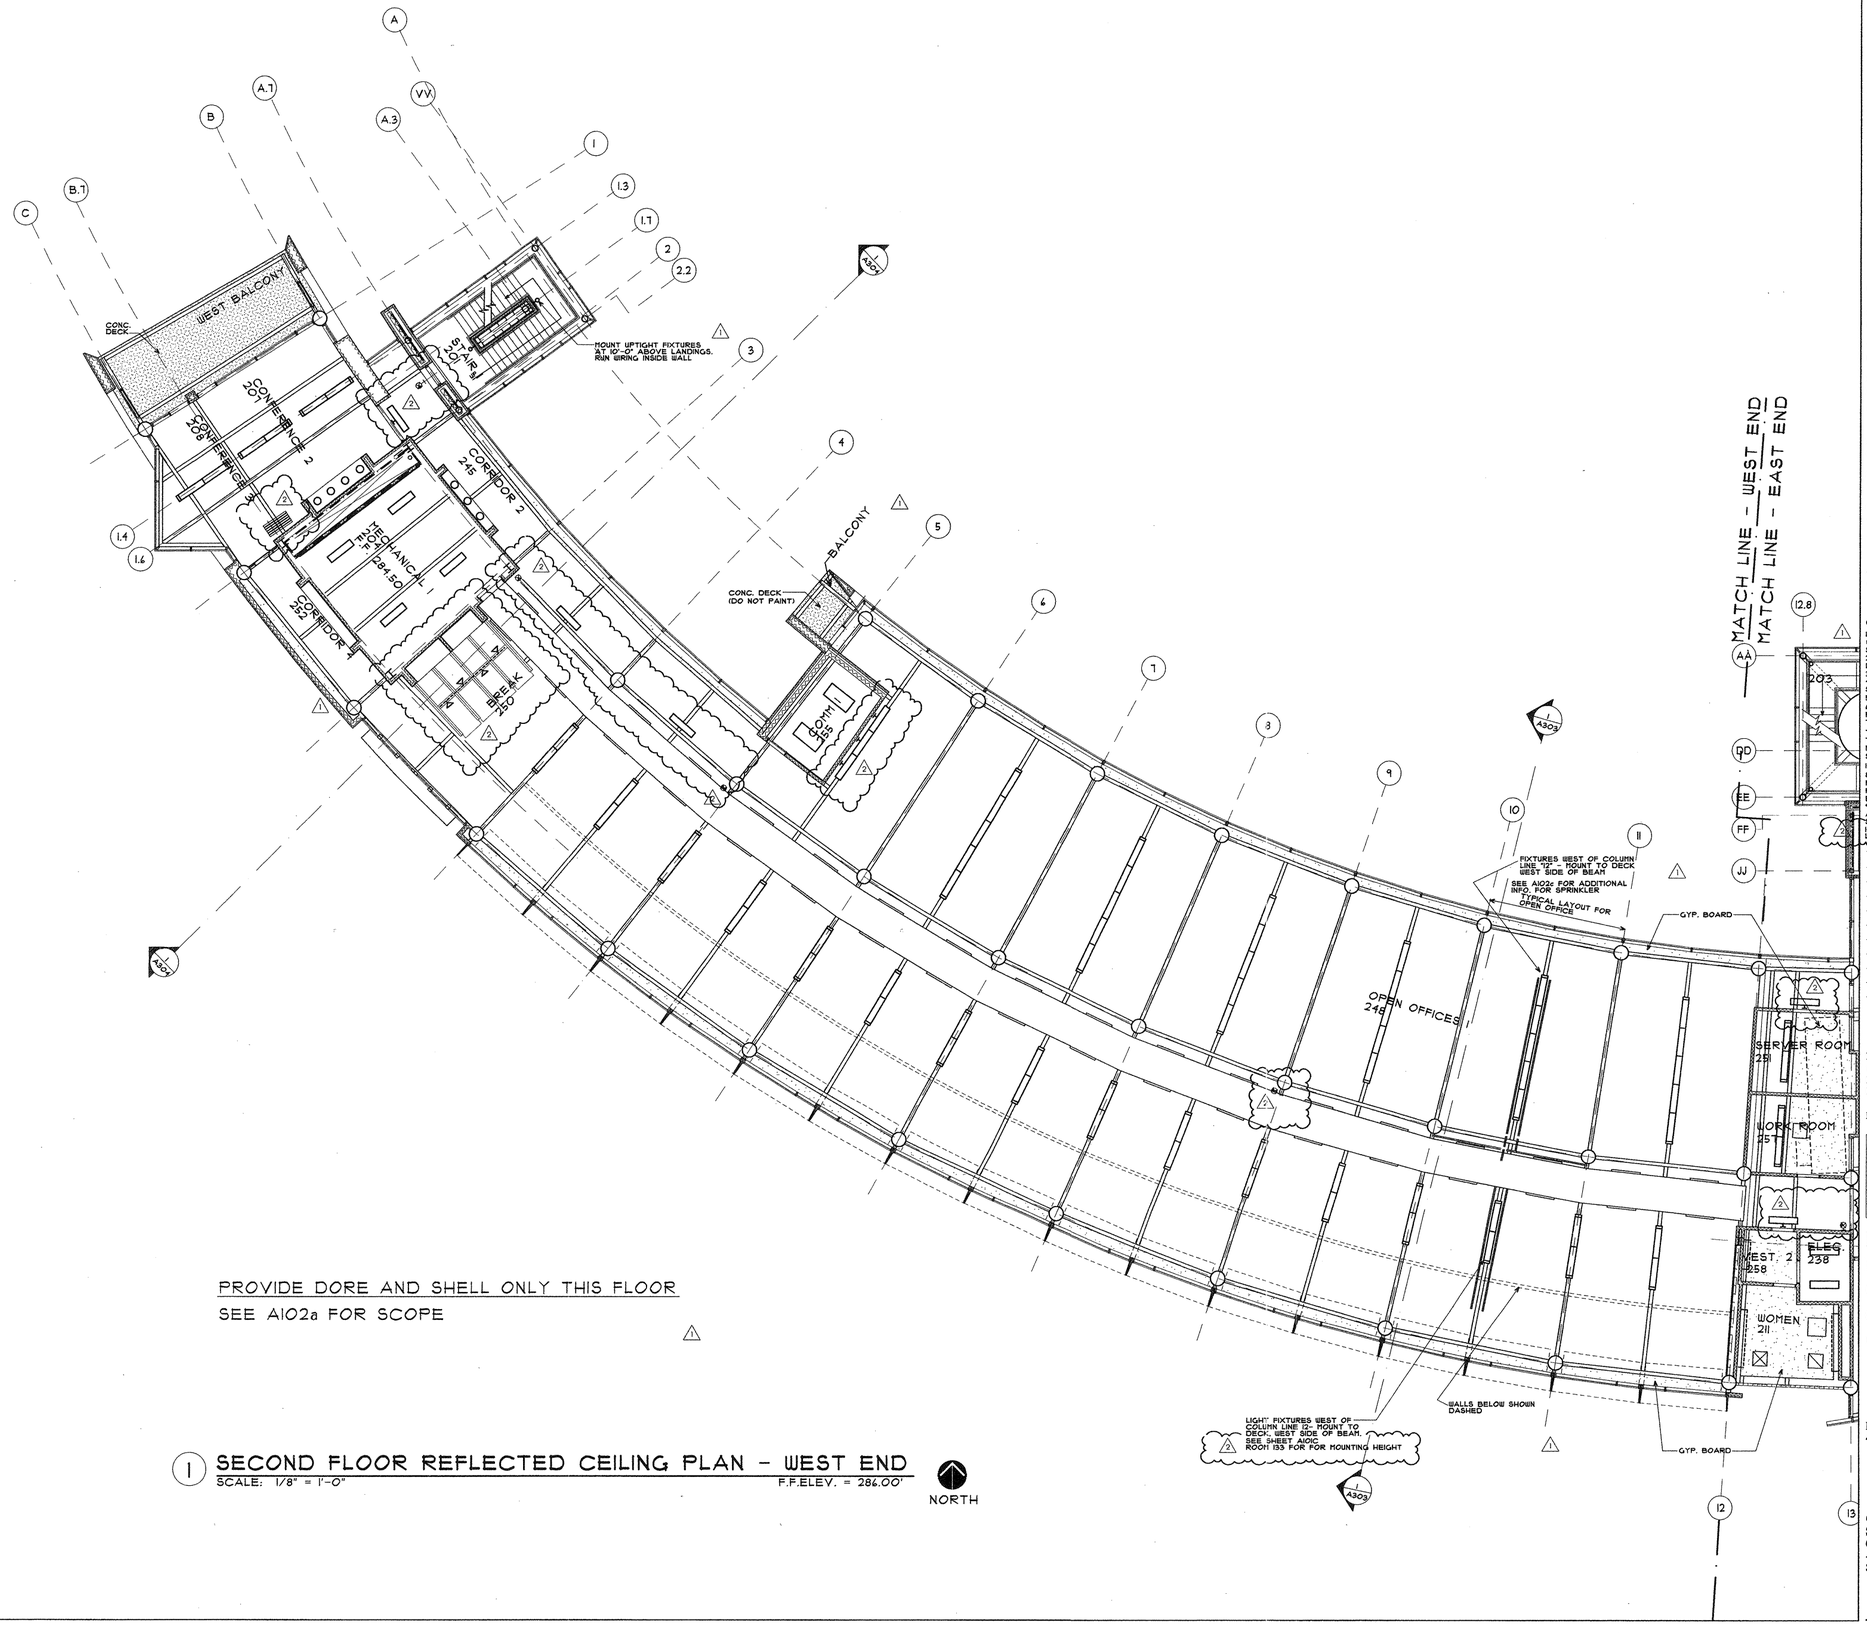

PROVIDE DORE AND SHELL ONLY THIS FLOOR

SEE A102a FOR SCOPE

1 SECOND FLOOR REFLECTED CEILING PLAN - WEST END

SCALE: 1/8" = 1'-0" F.F.ELEV. = 286.00'

POLK
STANLEY
YEARY
ARCHITECTS, LTD.

700 SOUTH SCHILLER
LITTLE ROCK, AR 72201
501 378-0878
FAX 372-7629

21 W. MOUNTAIN, SUITE 227
FAYETTEVILLE, AR 72701
479-444-0473

CONSULTANTS:

OWNER'S PROJECT ADVISOR:
MOSES TUCKER REAL ESTATE, INC.

CIVIL ENGINEER:
McCLELLAND ENGINEERS

LANDSCAPE ARCHITECT:
LARSON BURNS SMITH

STRUCTURAL ENGINEER:
CROMWELL ENGINEERS INC.

MECH., ELEC., PLUMB. ENGINEER:
CROMWELL ENGINEERS INC.

SUSTAINABLE CONSULTANT:
BNIM / ELEMENTS

GLOBAL VILLAGE CONSULTANT
CAMBRIDGE SEVEN ASSOCIATES

INTERIOR DESIGNER:
POLK STANLEY YEARY

GENERAL CONTRACTOR:
CDI

GENERAL NOTES:
1. PAINT ALL EXPOSED STEEL DECK & STRUCTURE - SEE SPEC'S FOR SCHEDULE.
2. DO NOT PAINT EXPOSED CONC. DECK.
3. DO NOT PAINT EXPOSED DUCTS.
4. PAINT ALL OTHER EXPOSED SYSTEMS - SEE SPEC'S FOR SCHED.
5. DO NOT PAINT ANY ALUM. MAT.
6. ELEC. CONDUIT SHALL RUN THRU FLOOR PLENUM ABOVE THEN DROP TO FIXTURE AND DEVICE J-BOX.
7. PENDANT FIXTURES; MOUNT TIGHT TO SIDES OF BEAMS INDICATED UNLESS NOTED OTHERWISE. SEE BUILDING SECTIONS FOR ADDITIONAL INFORMATION.
8. LOCATION OF ALL DEVICES, FIXTURES, ETC. SHALL BE REVIEWED WITH ARCHITECT BEFORE INSTALLATION.
9. SEE BUILDING SECTIONS FOR ADDITIONAL INFORMATION ON SPRINKLER LINE LOCATIONS.
10. SEE 3RD FLOOR PLANS FOR LOCATION OF FIXTURES.

NOTES:

ISSUE DATE:
100% GMP
PACKAGE #6
FEBRUARY 2, 2004

REVISIONS:

#	DATE	DESCRIPTION
1	01JUL04	PACKAGE #7
2	15NOV04	ASI NO. 25

HEIFER INTERNATIONAL CENTER OFFICE BUILDING

LITTLE ROCK, ARKANSAS

PSY PROJECT NUMBER:
431C

CONTENTS:
SECOND FLOOR REFLECTED CEILING PLAN - WEST END
SHEET NUMBER:

A102d

P:\D-DRAWING\431C\Cad\Drawings\Arch\A102c-SecondFloorReflectedCeilingPlan.dwg, Rasterizer, 15, 2004 4:32 PM

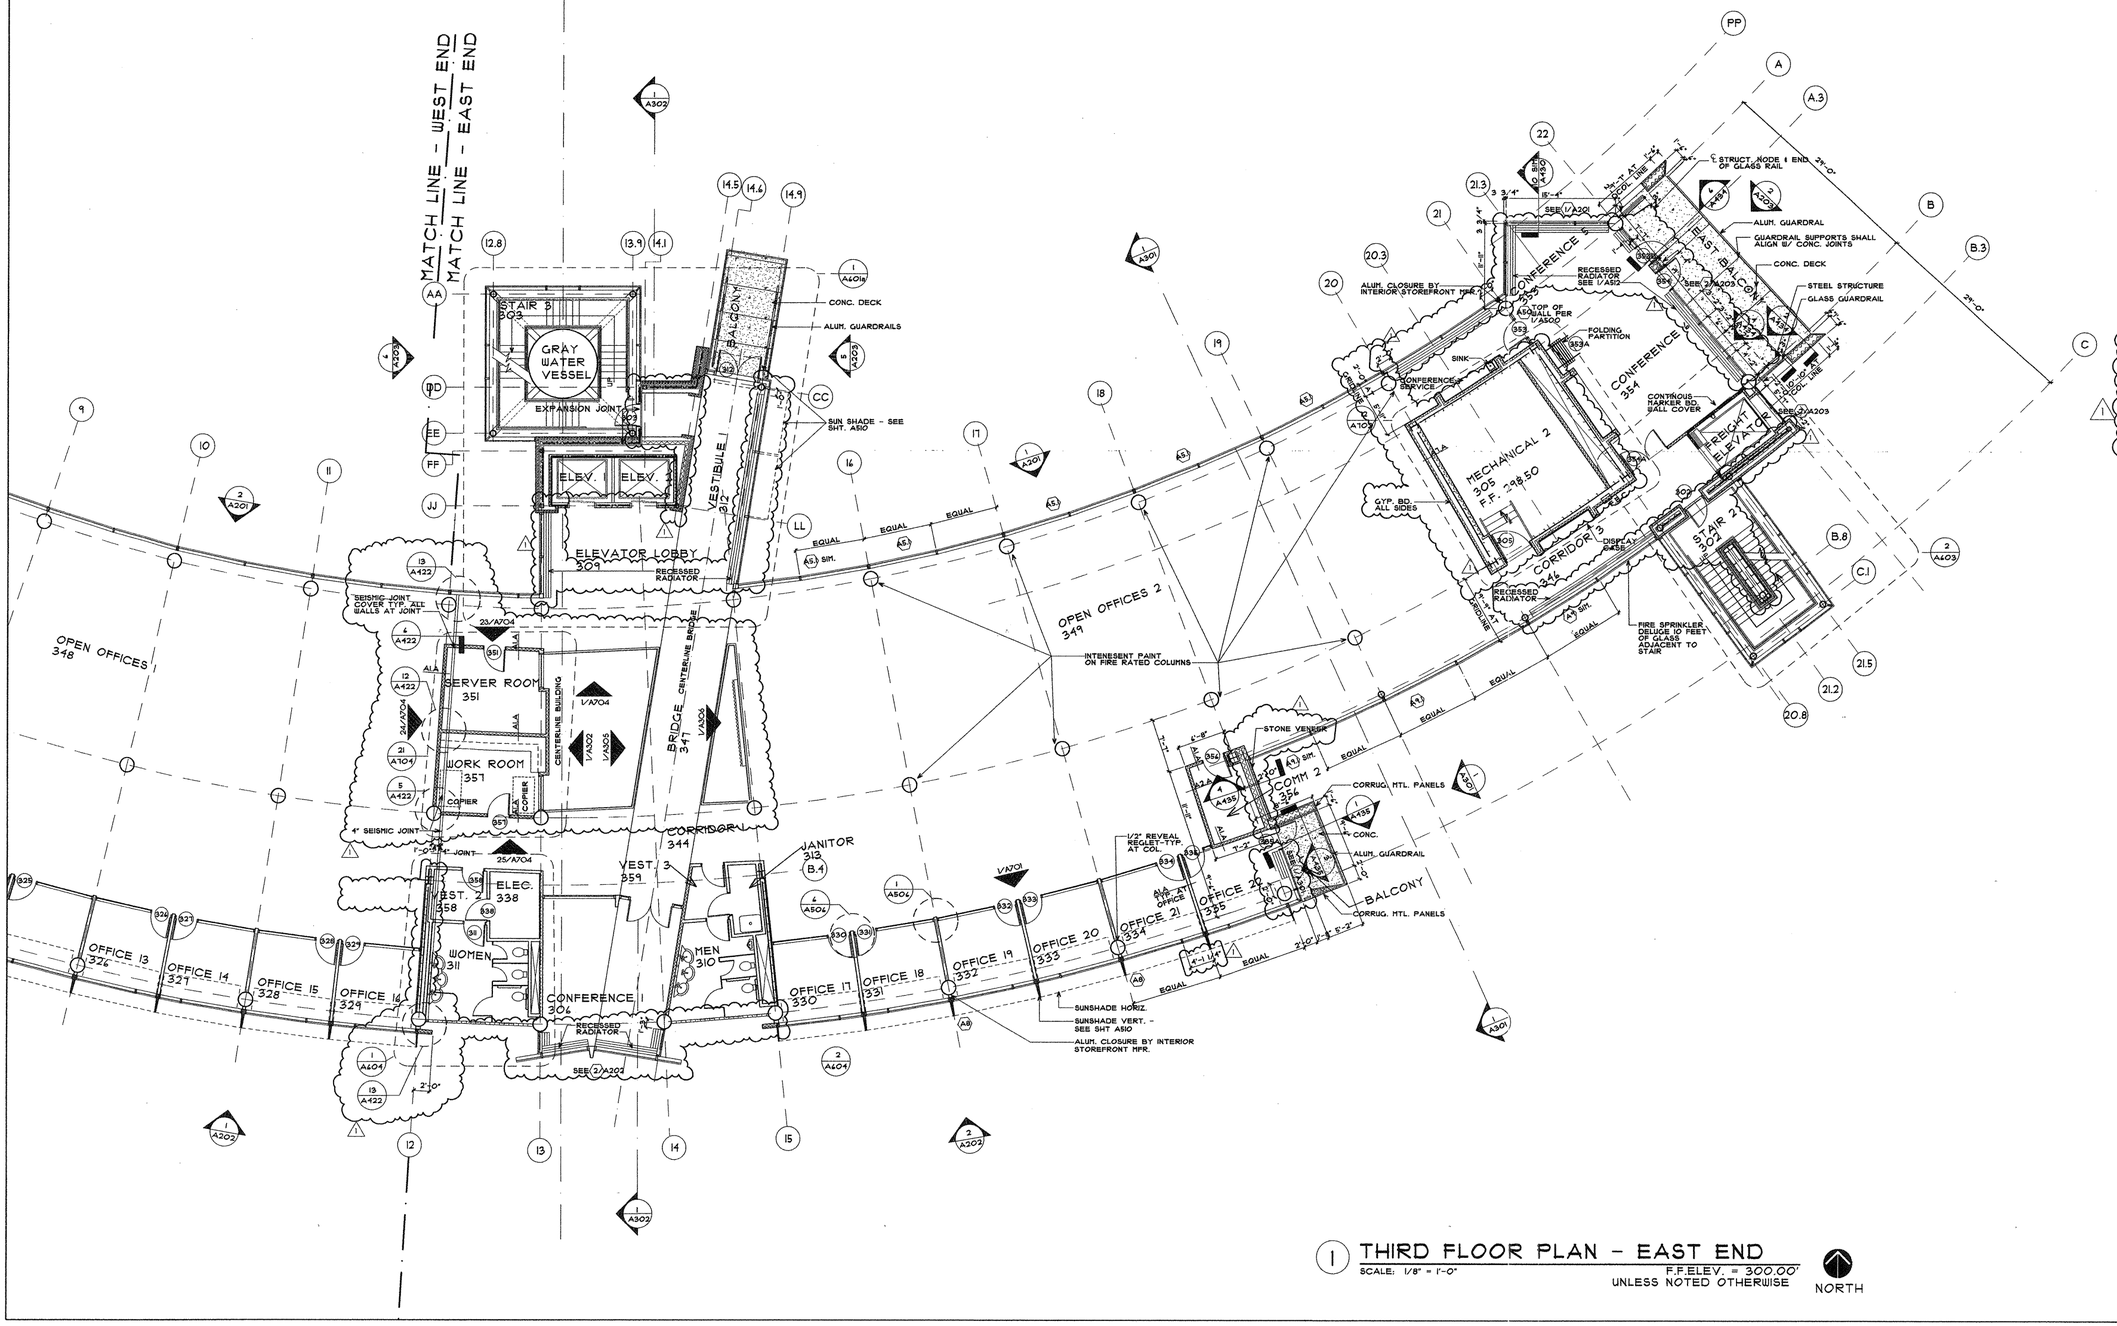

1 THIRD FLOOR PLAN - EAST END

SCALE: 1/8" = 1'-0"

F.F.ELEV. = 300.00' UNLESS NOTED OTHERWISE

NORTH

POLK STANLEY YEARY ARCHITECTS, LTD.

700 SOUTH SCHILLER
LITTLE ROCK, AR 72201
501 378-0878
FAX 372-7629

21 W. MOUNTAIN, SUITE 227
FAYETTEVILLE, AR 72701
479-444-0473

CONSULTANTS:

OWNER'S PROJECT ADVISOR:
MOSES TUCKER REAL ESTATE, INC.

CIVIL ENGINEER:
McCLELLAND ENGINEERS

LANDSCAPE ARCHITECT:
LARSON BURNS SMITH

STRUCTURAL ENGINEER:
CROMWELL ENGINEERS INC.

MECH., ELEC., PLUMB. ENGINEER:
CROMWELL ENGINEERS INC.

SUSTAINABLE CONSULTANT:
BNIM / ELEMENTS

GLOBAL VILLAGE CONSULTANT
CAMBRIDGE SEVEN ASSOCIATES

INTERIOR DESIGNER:
POLK STANLEY YEARY

GENERAL CONTRACTOR:
CDI

GENERAL NOTES:

1. LOCATE WALLS & PARTITIONS ON CENTERLINE OF COLUMNS UNLESS NOTED OTHERWISE.

2. SEE SHEET G003 FOR COLUMN DIMENSION PLAN.

3. ALL WALLS ARE SEGMENTED TO FOLLOW CURVE OF BUILDING UNLESS NOTED OTHERWISE.

4. PROVIDE 1 HR. INTUMESCENT FIRE PROOFING FOR COLUMNS A-14 THRU A-20, B-14 THRU B-19.

NOTES:

ISSUE DATE:
100% GMP
PACKAGE #6
FEBRUARY 2, 2004

REVISIONS:

#	DATE	DESCRIPTION
1	04.JUL.04	PACKAGE #7

HEIFER INTERNATIONAL CENTER OFFICE BUILDING

LITTLE ROCK, ARKANSAS

PSY PROJECT NUMBER:
431C

CONTENTS:
THIRD FLOOR PLAN - EAST END

SHEET NUMBER:

A103a

P:\3-Dwg\431C\Cad\Final Drawings\<CSDs\Final\A103a-ThirdFloorPlan-East.dwg Tuesday, July 06, 2004 4:32 PM

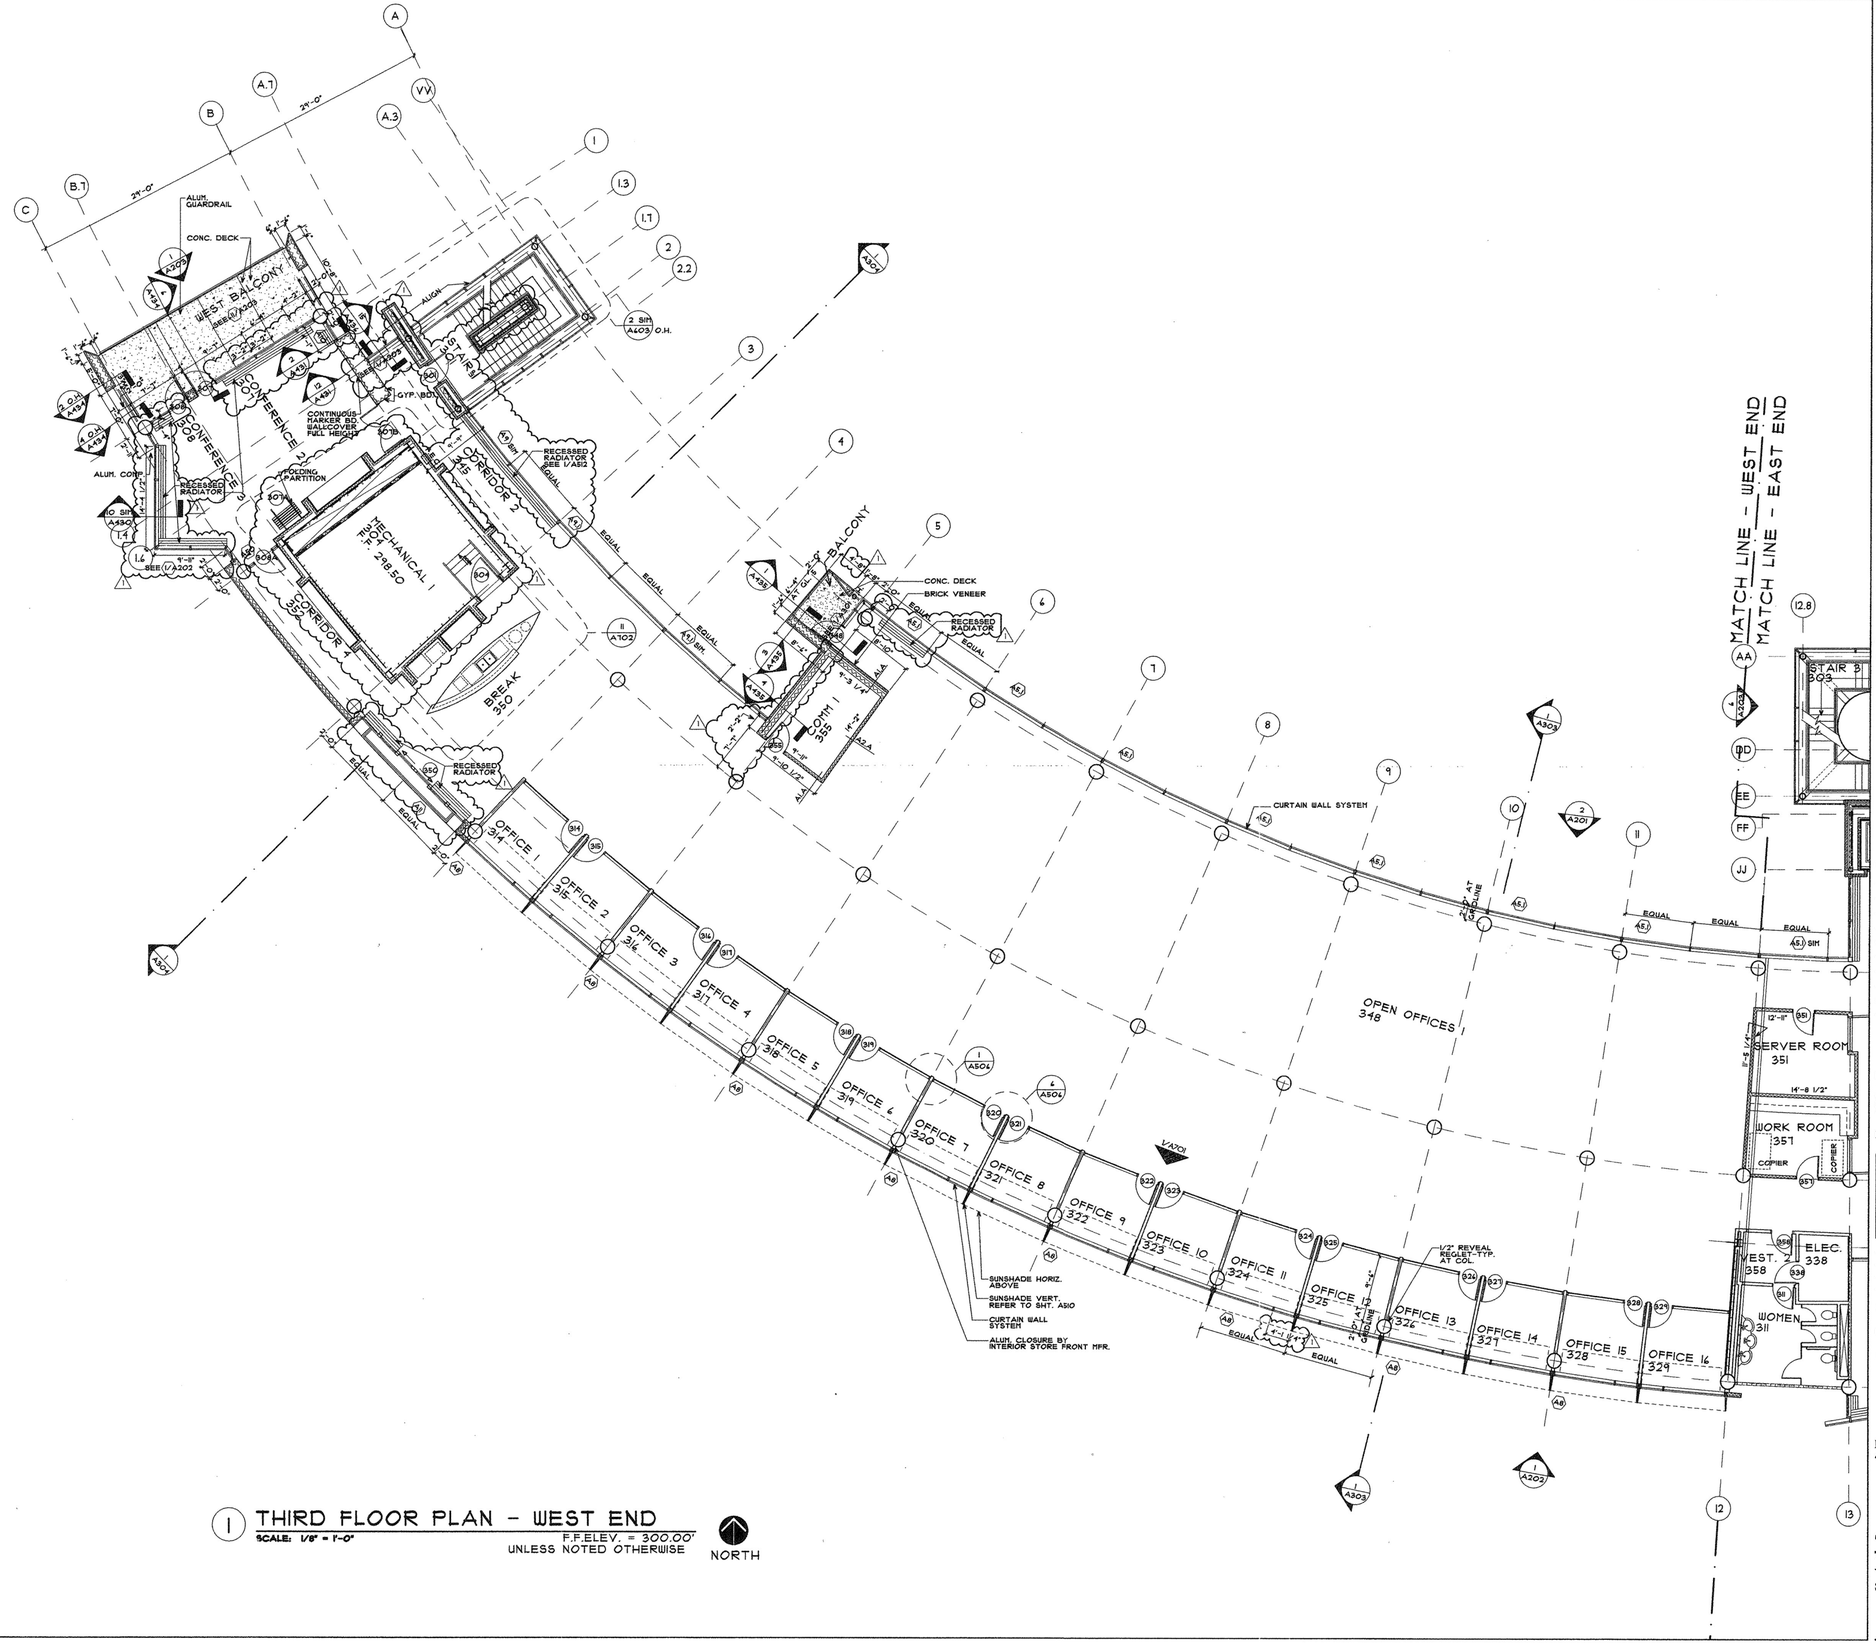

1 THIRD FLOOR PLAN - WEST END

SCALE: 1/8" = 1'-0"

F.F.ELEV. = 300.00' UNLESS NOTED OTHERWISE

NORTH

POLK STANLEY YEARY
ARCHITECTS, LTD.

700 SOUTH SCHILLER
LITTLE ROCK, AR 72201
501 378-0878
FAX 372-7629

21 W. MOUNTAIN, SUITE 227
FAYETTEVILLE, AR 72701
479-444-0473

CONSULTANTS:

OWNER'S PROJECT ADVISOR:
MOSES TUCKER REAL ESTATE, INC.

CIVIL ENGINEER:
McCLELLAND ENGINEERS

LANDSCAPE ARCHITECT:
LARSON BURNS SMITH

STRUCTURAL ENGINEER:
CROMWELL ENGINEERS INC.

MECH., ELEC., PLUMB. ENGINEER:
CROMWELL ENGINEERS INC.

SUSTAINABLE CONSULTANT:
BNIM / ELEMENTS

GLOBAL VILLAGE CONSULTANT
CAMBRIDGE SEVEN ASSOCIATES

INTERIOR DESIGNER:
POLK STANLEY YEARY

GENERAL CONTRACTOR:
CDI

GENERAL NOTES:

1. LOCATE WALLS & PARTITIONS ON CENTERLINE OF COLUMNS UNLESS NOTED OTHERWISE.
2. SEE SHEET G003 FOR COLUMN DIMENSION PLAN.
3. ALL WALLS ARE SEGMENTED TO FOLLOW CURVE OF BLDG. UNLESS NOTED OTHERWISE.

NOTES:

ISSUE DATE:
100% GMP
PACKAGE #6
FEBRUARY 2, 2004

REVISIONS:

#	DATE	DESCRIPTION
1	04JUL04	PACKAGE #1

HEIFER INTERNATIONAL CENTER OFFICE BUILDING

LITTLE ROCK, ARKANSAS

PSY PROJECT NUMBER:
431C

CONTENTS:
THIRD FLOOR PLAN - WEST END

SHEET NUMBER:

A103b

McCLELLAND CURZON PORTER CORPORATION
C-138
ARKANSAS
REGISTERED

P:\JOBS\431C\CAD\Final Drawings\Part Cds\Final\A103b - Third Floor Plan - West End Tuesday, June 29, 2004 10:58 AM

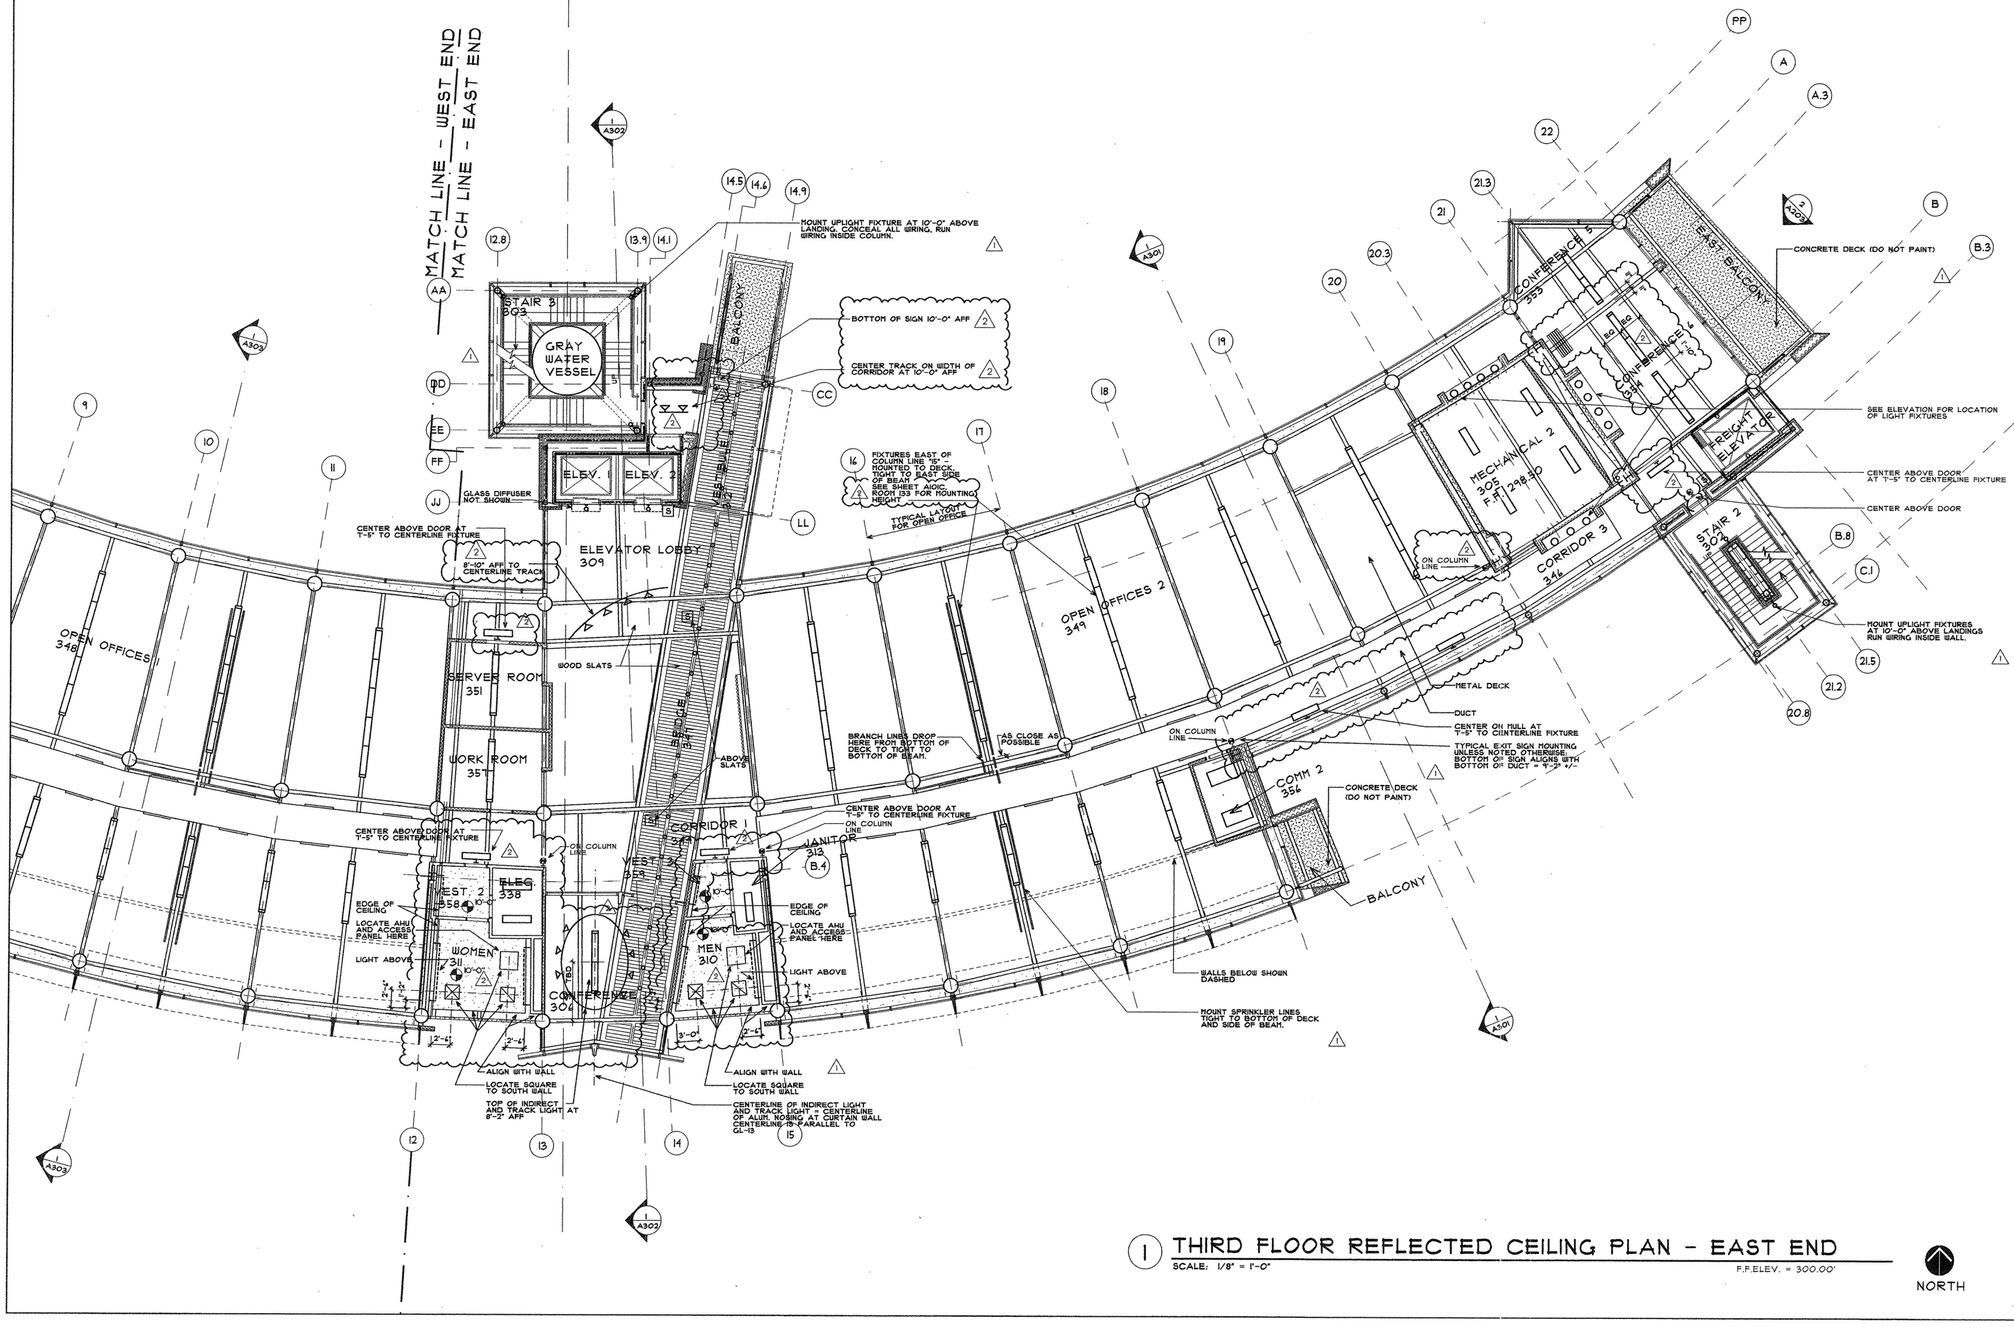

1 THIRD FLOOR REFLECTED CEILING PLAN - EAST END

SCALE: 1/8" = 1'-0"

F.F.ELEV. = 300.00'

NORTH


POLK
STANLEY
YEARY
ARCHITECTS, LTD.

700 SOUTH SCHILLER
LITTLE ROCK, AR 72201
501 378-0878
FAX 372-7629

21 W. MOUNTAIN, SUITE 227
FAYETTEVILLE, AR 72701
479-444-0473

CONSULTANTS:

OWNER'S PROJECT ADVISOR:
MOSES TUCKER REAL ESTATE, INC.

CIVIL ENGINEER:
McCLELLAND ENGINEERS

LANDSCAPE ARCHITECT:
LARSON BURNS SMITH

STRUCTURAL ENGINEER:
CROMWELL ENGINEERS INC.

MECH., ELEC., PLUMB. ENGINEER:
CROMWELL ENGINEERS INC.

SUSTAINABLE CONSULTANT:
BNIM / ELEMENTS

GLOBAL VILLAGE CONSULTANT
CAMBRIDGE SEVEN ASSOCIATES

INTERIOR DESIGNER:
POLK STANLEY YEARY

GENERAL CONTRACTOR:
CDI

GENERAL NOTES:
1. PAINT ALL EXPOSED STEEL DECK I STRUCTURE - SEE SPEC'S FOR SCHEDULE.
2. DO NOT PAINT EXPOSED CONC. DECK.
3. DO NOT PAINT EXPOSED DUCTS.
4. PAINT ALL OTHER EXPOSED SYSTEMS - SEE SPEC'S FOR SCHED.
5. DO NOT PAINT ANY ALUM. MAT.
6. ELEC. CONDUIT SHALL RUN THRU FLOOR PLENUM ABOVE THEN DROP TO FIXTURE AND DEVICE J-BOX. NAILER.
7. PENDANT FIXTURES: MOUNT TIGHT TO SIDES OF BEAMS INDICATED UNLESS NOTED OTHERWISE. SEE BUILDING SECTIONS FOR ADDITIONAL INFORMATION.
8. LOCATION OF ALL DEVICES, FIXTURES, ETC. SHALL BE REVISED WITH ARCHITECT BEFORE RE INSTALLATION.
9. SEE BUILDING SECTIONS FOR ADDITIONAL INFORMATION ON SPRINKLER LINE LOCATIONS.

NOTES:

ISSUE DATE:
100% GMP
PACKAGE #6
FEBRUARY 2, 2004

REVISIONS:

#	DATE	DESCRIPTION
1	04JUL04	PACKAGE #1

HEIFER
INTERNATIONAL
CENTER
OFFICE BUILDING
LITTLE ROCK, ARKANSAS

PSY PROJECT NUMBER:
431C

CONTENTS:
THIRD FLOOR REFLECTED CEILING PLAN - EAST
SHEET NUMBER:

A103c

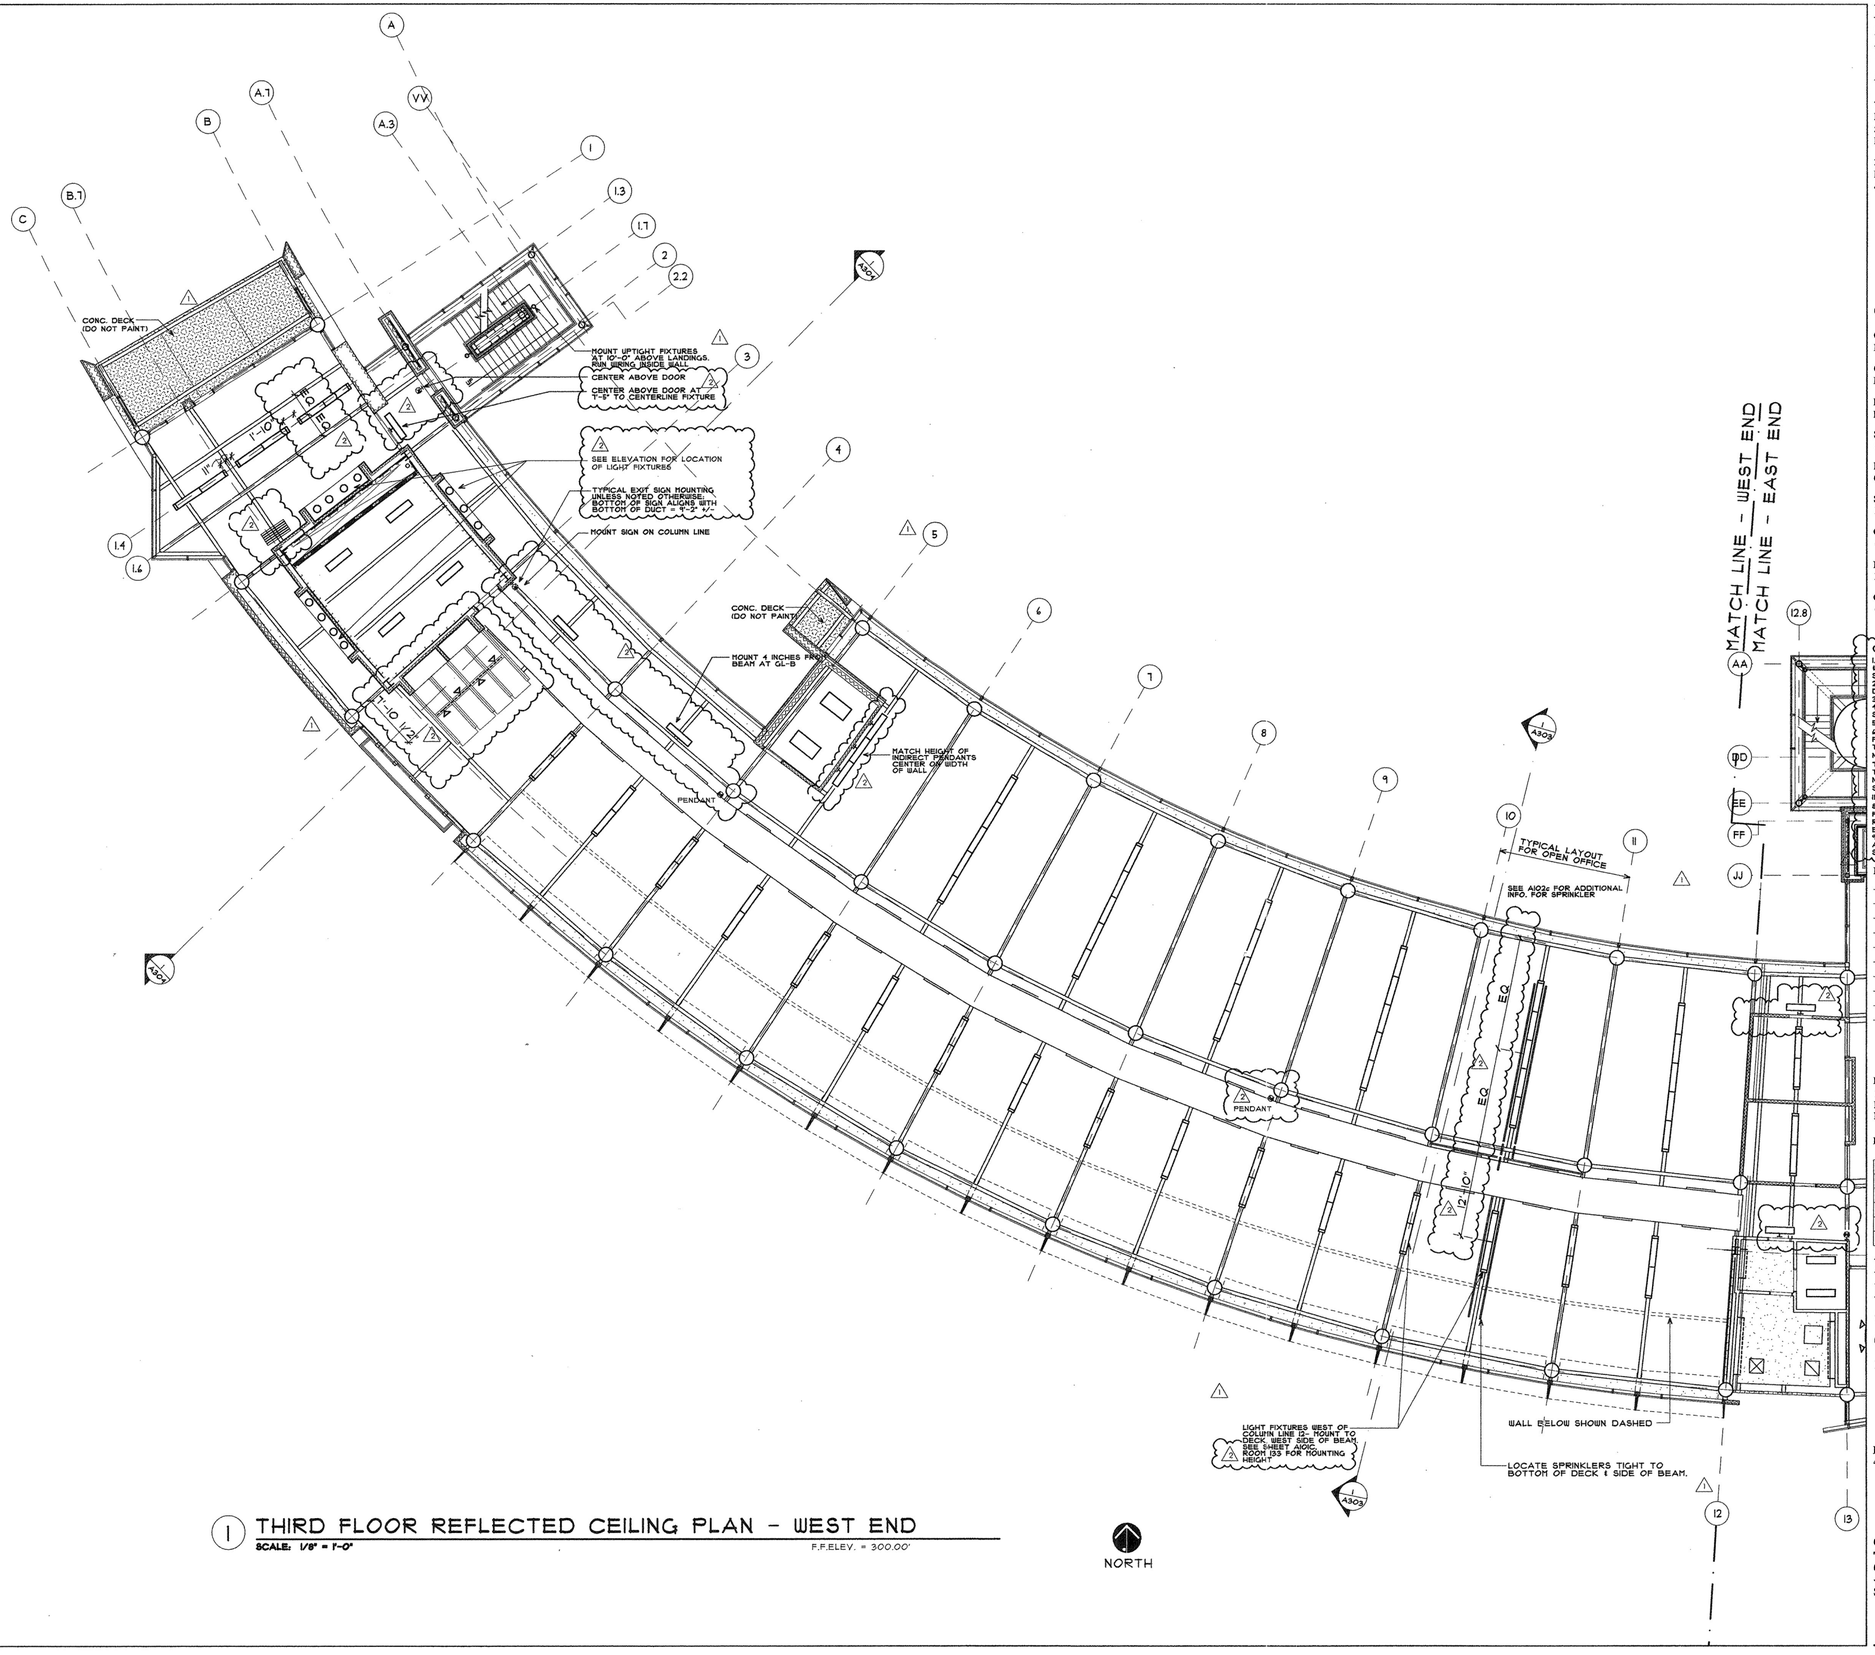

1 THIRD FLOOR REFLECTED CEILING PLAN - WEST END

SCALE: 1/8" = 1'-0"

F.F.ELEV. = 300.00'

NORTH

POLK
STANLEY
YEARY
ARCHITECTS, LTD.

700 SOUTH SCHILLER
LITTLE ROCK, AR 72201
501 378-0878
FAX 372-7629

21 W. MOUNTAIN, SUITE 227
FAYETTEVILLE, AR 72701
479-444-0473

CONSULTANTS:

OWNER'S PROJECT ADVISOR:
MOSES TUCKER REAL ESTATE, INC.

CIVIL ENGINEER:
McCLELLAND ENGINEERS

LANDSCAPE ARCHITECT:
LARSON BURNS SMITH

STRUCTURAL ENGINEER:
CROMWELL ENGINEERS INC.

MECH., ELEC., PLUMB. ENGINEER:
CROMWELL ENGINEERS INC.

SUSTAINABLE CONSULTANT:
BNIM / ELEMENTS

GLOBAL VILLAGE CONSULTANT
CAMBRIDGE SEVEN ASSOCIATES

INTERIOR DESIGNER:
POLK STANLEY YEARY

GENERAL CONTRACTOR:
CDI

GENERAL NOTES:
1. PAINT ALL EXPOSED STEEL DECK & STRUCTURE - SEE SPEC'S FOR SCHEDULE.
2. DO NOT PAINT EXPOSED CONC. DECK.
3. DO NOT PAINT EXPOSED DUCTS.
4. PAINT ALL OTHER EXPOSED SYSTEMS - SEE SPEC'S FOR SCHED.
5. DO NOT PAINT ANY ALUM. MAT.
6. ELEC. CONDUIT SHALL RUN THRU FLOOR PLENUM ABOVE THEN DROP TO FIXTURE AND DEVICE J-BOX. NAILER.
7. PENDANT FIXTURES: MOUNT TIGHT TO SIDES OF BEAMS INDICATED UNLESS NOTED OTHERWISE. SEE BUILDING SECTIONS FOR ADDITIONAL INFORMATION.
8. LOCATION OF ALL DEVICES, FIXTURES, ETC. SHALL BE REVIEWED WITH ARCHITECT BEFORE INSTALLATION.
9. SEE BUILDING SECTIONS FOR ADDITIONAL INFORMATION ON SPRINKLER LINE LOCATIONS.

NOTES:

ISSUE DATE:
100% GMP
PACKAGE #6
FEBRUARY 2, 2004

REVISIONS:

#	DATE	DESCRIPTION
1	01JUL04	PACKAGE #1
2	15NOV04	ASI NO. 25

HEIFER INTERNATIONAL CENTER OFFICE BUILDING

LITTLE ROCK, ARKANSAS

PSY PROJECT NUMBER:
431C

CONTENTS:
THIRD FLOOR REFLECTED CEILING PLAN - WEST END
SHEET NUMBER:

A103d

P:\Dwgs\431C\Arch\Drawings\Floor\3rd\A103c-ThirdFloorReflectedCeiling.dwg, 15 Nov 2004 4:29 PM

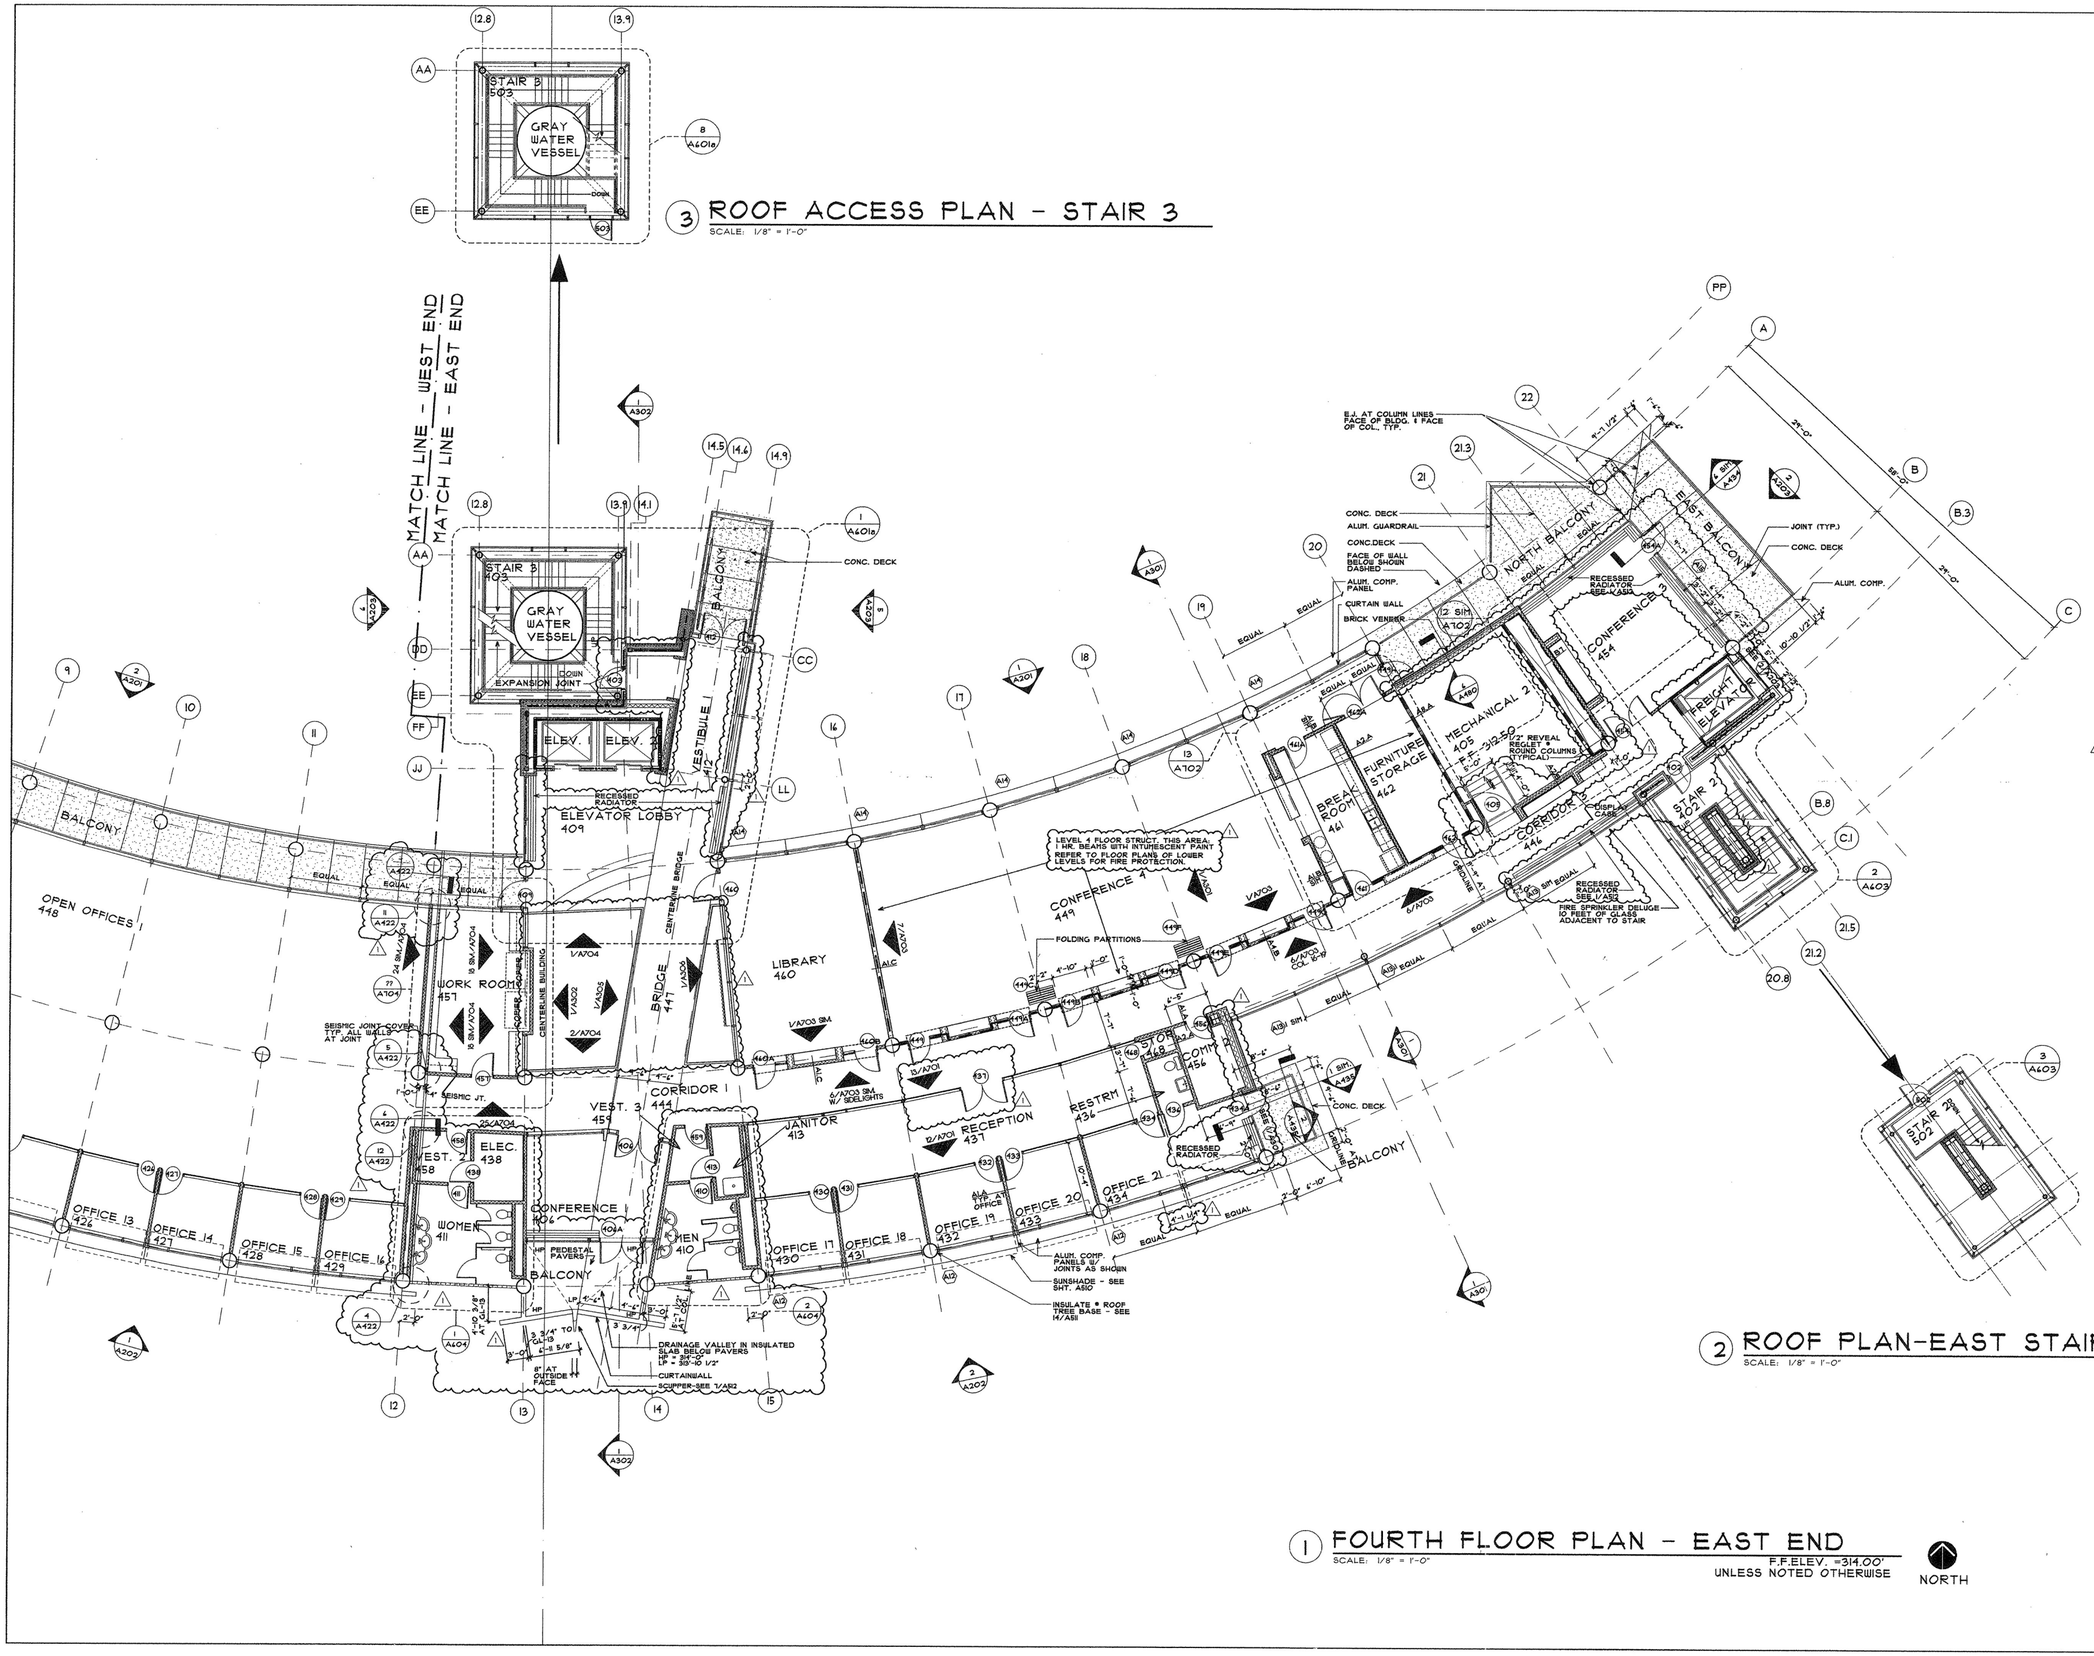

3 ROOF ACCESS PLAN - STAIR 3
SCALE: 1/8" = 1'-0"

2 ROOF PLAN-EAST STAIR
SCALE: 1/8" = 1'-0"

1 FOURTH FLOOR PLAN - EAST END
SCALE: 1/8" = 1'-0"

F.F.ELEV. =314.00'
UNLESS NOTED OTHERWISE

NORTH

POLK
STANLEY
YEARY
ARCHITECTS, LTD.

700 SOUTH SCHILLER
LITTLE ROCK, AR 72201
501 378-0878
FAX 372-7629

21 W. MOUNTAIN, SUITE 227
FAYETTEVILLE, AR 72701
479-444-0473

CONSULTANTS:

OWNER'S PROJECT ADVISOR:
MOSES TUCKER REAL ESTATE, INC.

CIVIL ENGINEER:
McCLELLAND ENGINEERS

LANDSCAPE ARCHITECT:
LARSON BURNS SMITH

STRUCTURAL ENGINEER:
CROMWELL ENGINEERS INC.

MECH., ELEC., PLUMB. ENGINEER:
CROMWELL ENGINEERS INC.

SUSTAINABLE CONSULTANT:
BNIM / ELEMENTS

GLOBAL VILLAGE CONSULTANT
CAMBRIDGE SEVEN ASSOCIATES

INTERIOR DESIGNER:
POLK STANLEY YEARY

GENERAL CONTRACTOR:
CDI

GENERAL NOTES:

1. LOCATE WALLS / PARTITIONS ON CENTERLINE OF COLUMNS UNLESS NOTED OTHERWISE.
2. SEE SHEET G003 FOR COLUMN DIMENSION PLAN.
3. ALL WALLS ARE SEGMENTED TO FOLLOW CURVE OF BUILDING UNLESS NOTED OTHERWISE.
4. PROVIDE 1 HR. INTUMESCENT FIRE PROOFING FOR COLUMNS A-14 THRU A-20, B-14 THRU B-19.

1

NOTES:

ISSUE DATE:
100% GMP
PACKAGE #6
FEBRUARY 2, 2004

REVISIONS:

#	DATE	DISCRIPTION
1	04.01.04	PACKAGE #7

HEIFER
INTERNATIONAL
CENTER
OFFICE BUILDING
LITTLE ROCK, ARKANSAS

PSY PROJECT NUMBER:
431C

ARKANSAS REGISTERED ARCHITECT
C-135

CONTENTS:
FOURTH FLOOR PLAN
- EAST END

SHEET NUMBER:
A104a

P:\D-DWGS\431C\CA\FinalDrawingsForCDs\Final\A104a-FourthFloorPlan-East End Thursday, July 01, 2004 4:47 PM

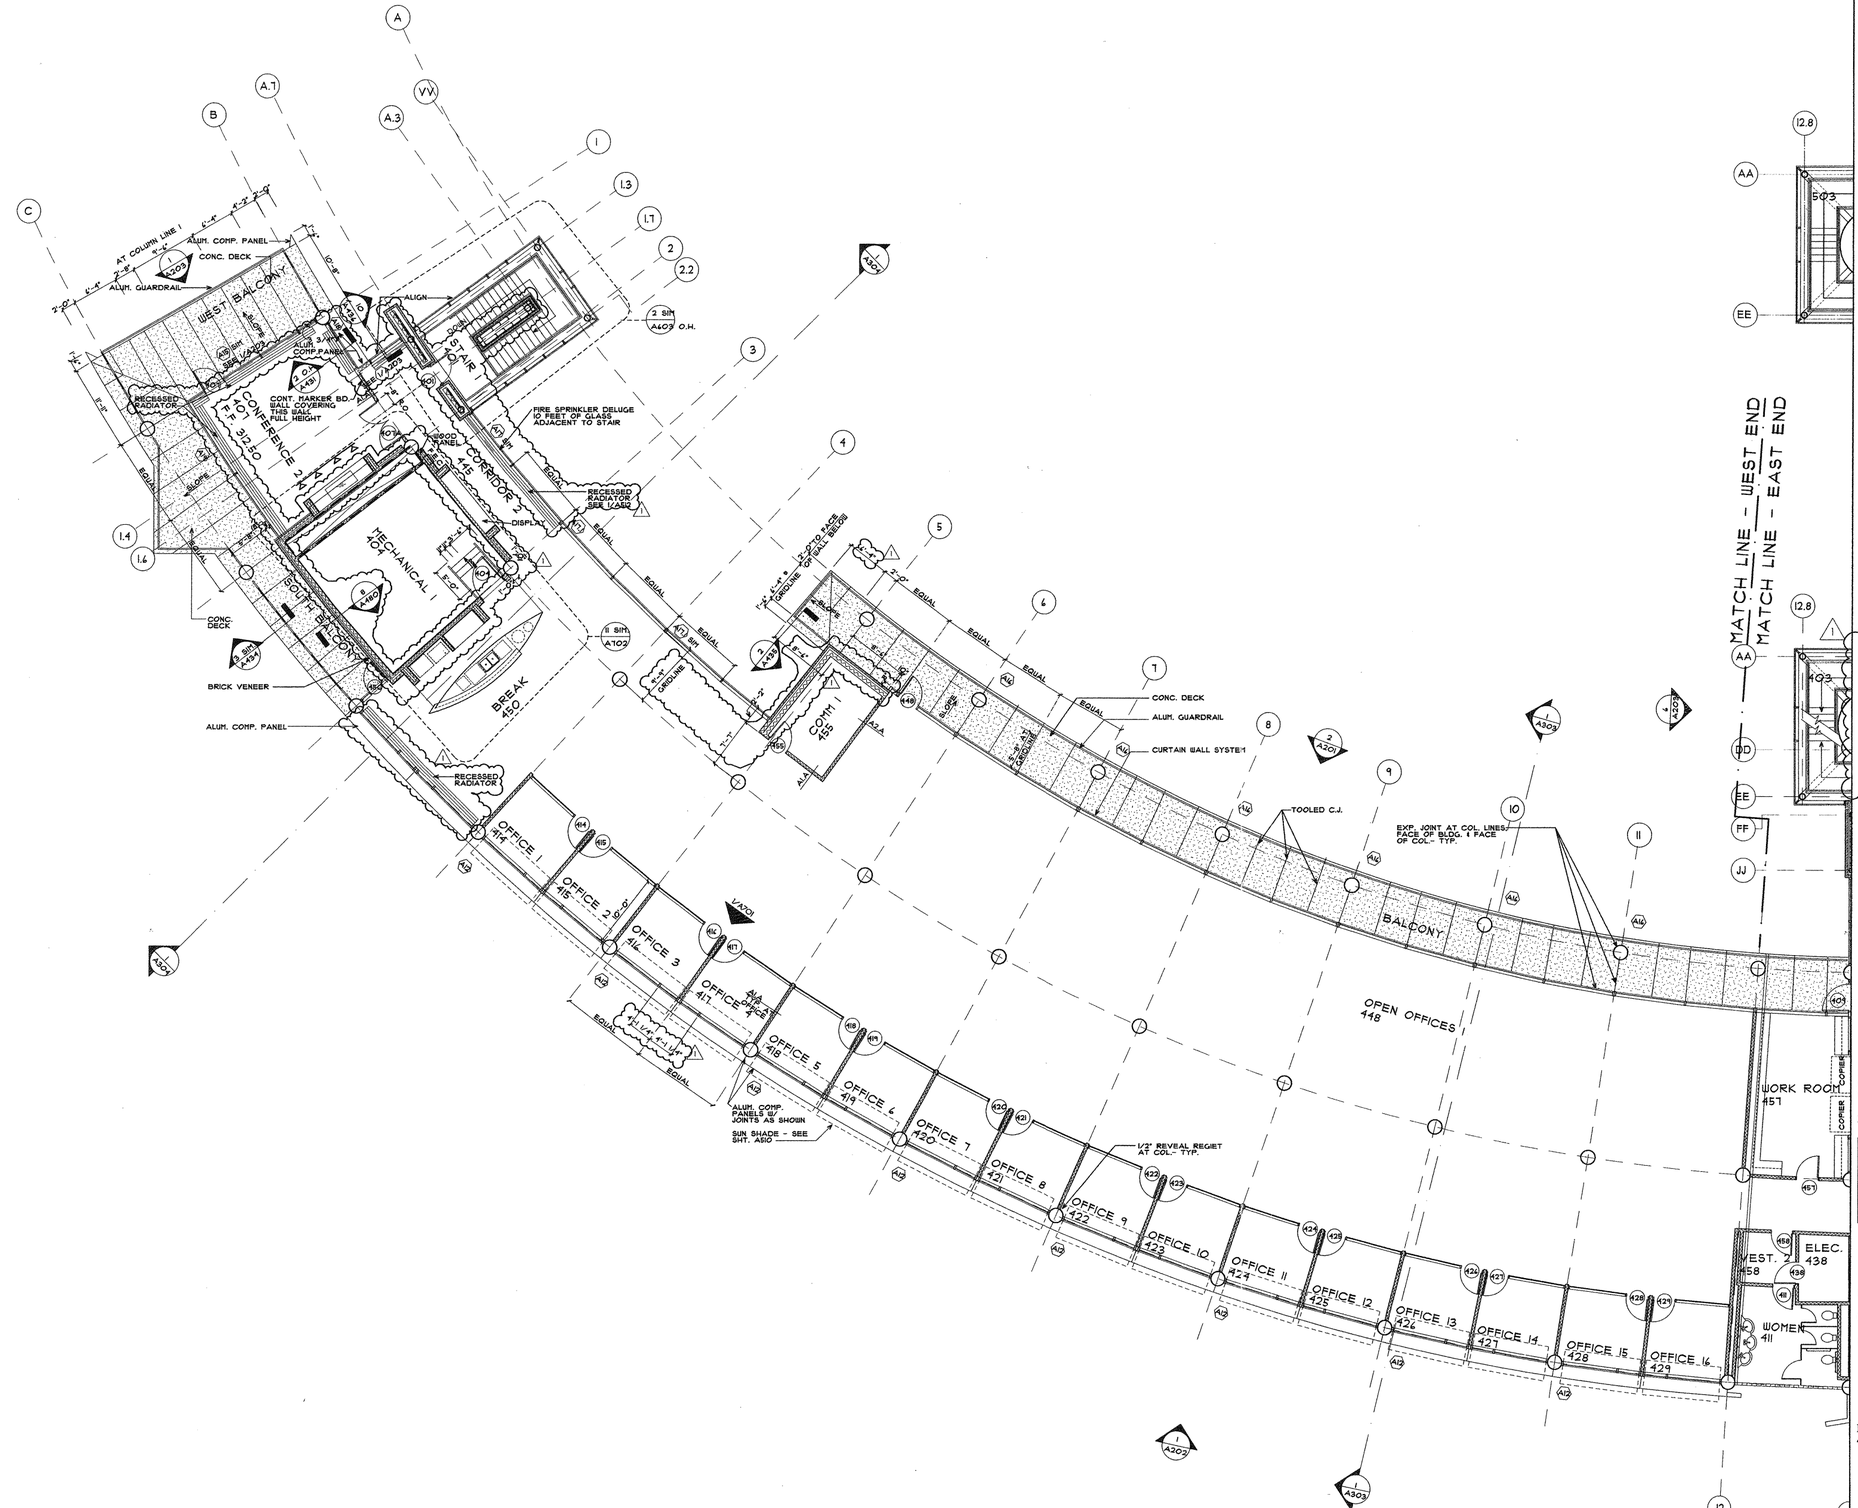

1 FOURTH FLOOR PLAN - WEST END

SCALE: 1/8" = 1'-0"

F.F.ELEV. = 314.00' UNLESS NOTED OTHERWISE

NORTH

POLK STANLEY YEARY
ARCHITECTS, LTD.

700 SOUTH SCHILLER
LITTLE ROCK, AR 72201
501 378-0878
FAX 372-7629

21 W. MOUNTAIN, SUITE 227
FAYETTEVILLE, AR 72701
479-444-0473

CONSULTANTS:

OWNER'S PROJECT ADVISOR:
MOSES TUCKER REAL ESTATE, INC.

CIVIL ENGINEER:
McCLELLAND ENGINEERS

LANDSCAPE ARCHITECT:
LARSON BURNS SMITH

STRUCTURAL ENGINEER:
CROMWELL ENGINEERS INC.

MECH., ELEC., PLUMB. ENGINEER:
CROMWELL ENGINEERS INC.

SUSTAINABLE CONSULTANT:
BNIM / ELEMENTS

GLOBAL VILLAGE CONSULTANT
CAMBRIDGE SEVEN ASSOCIATES

INTERIOR DESIGNER:
POLK STANLEY YEARY

GENERAL CONTRACTOR:
CDI

GENERAL NOTES:
1. LOCATE WALLS & PARTITIONS ON CENTERLINE OF COLUMNS UNLESS NOTED OTHERWISE.
2. SEE SHEET G003 FOR COLUMN DIMENSION PLAN.
3. ALL WALLS ARE SEGMENTED TO FOLLOW CURVE OF BUILDING UNLESS NOTED OTHERWISE.

NOTES:

ISSUE DATE:
100% GMP
PACKAGE #6
FEBRUARY 2, 2004

REVISIONS:

#	DATE	DESCRIPTION
1	04JUL04	PACKAGE #7

HEIFER INTERNATIONAL CENTER OFFICE BUILDING

LITTLE ROCK, ARKANSAS

PSY PROJECT NUMBER:
431C


CONTENTS:
FOURTH FLOOR PLAN - WEST END

SHEET NUMBER:

A104b

P:\Dwg\431C\CAD Files\Drawings\Floor Plans\A104b-Fourth Floor Plan - West End Wednesday, June 30, 2004 5:36 PM

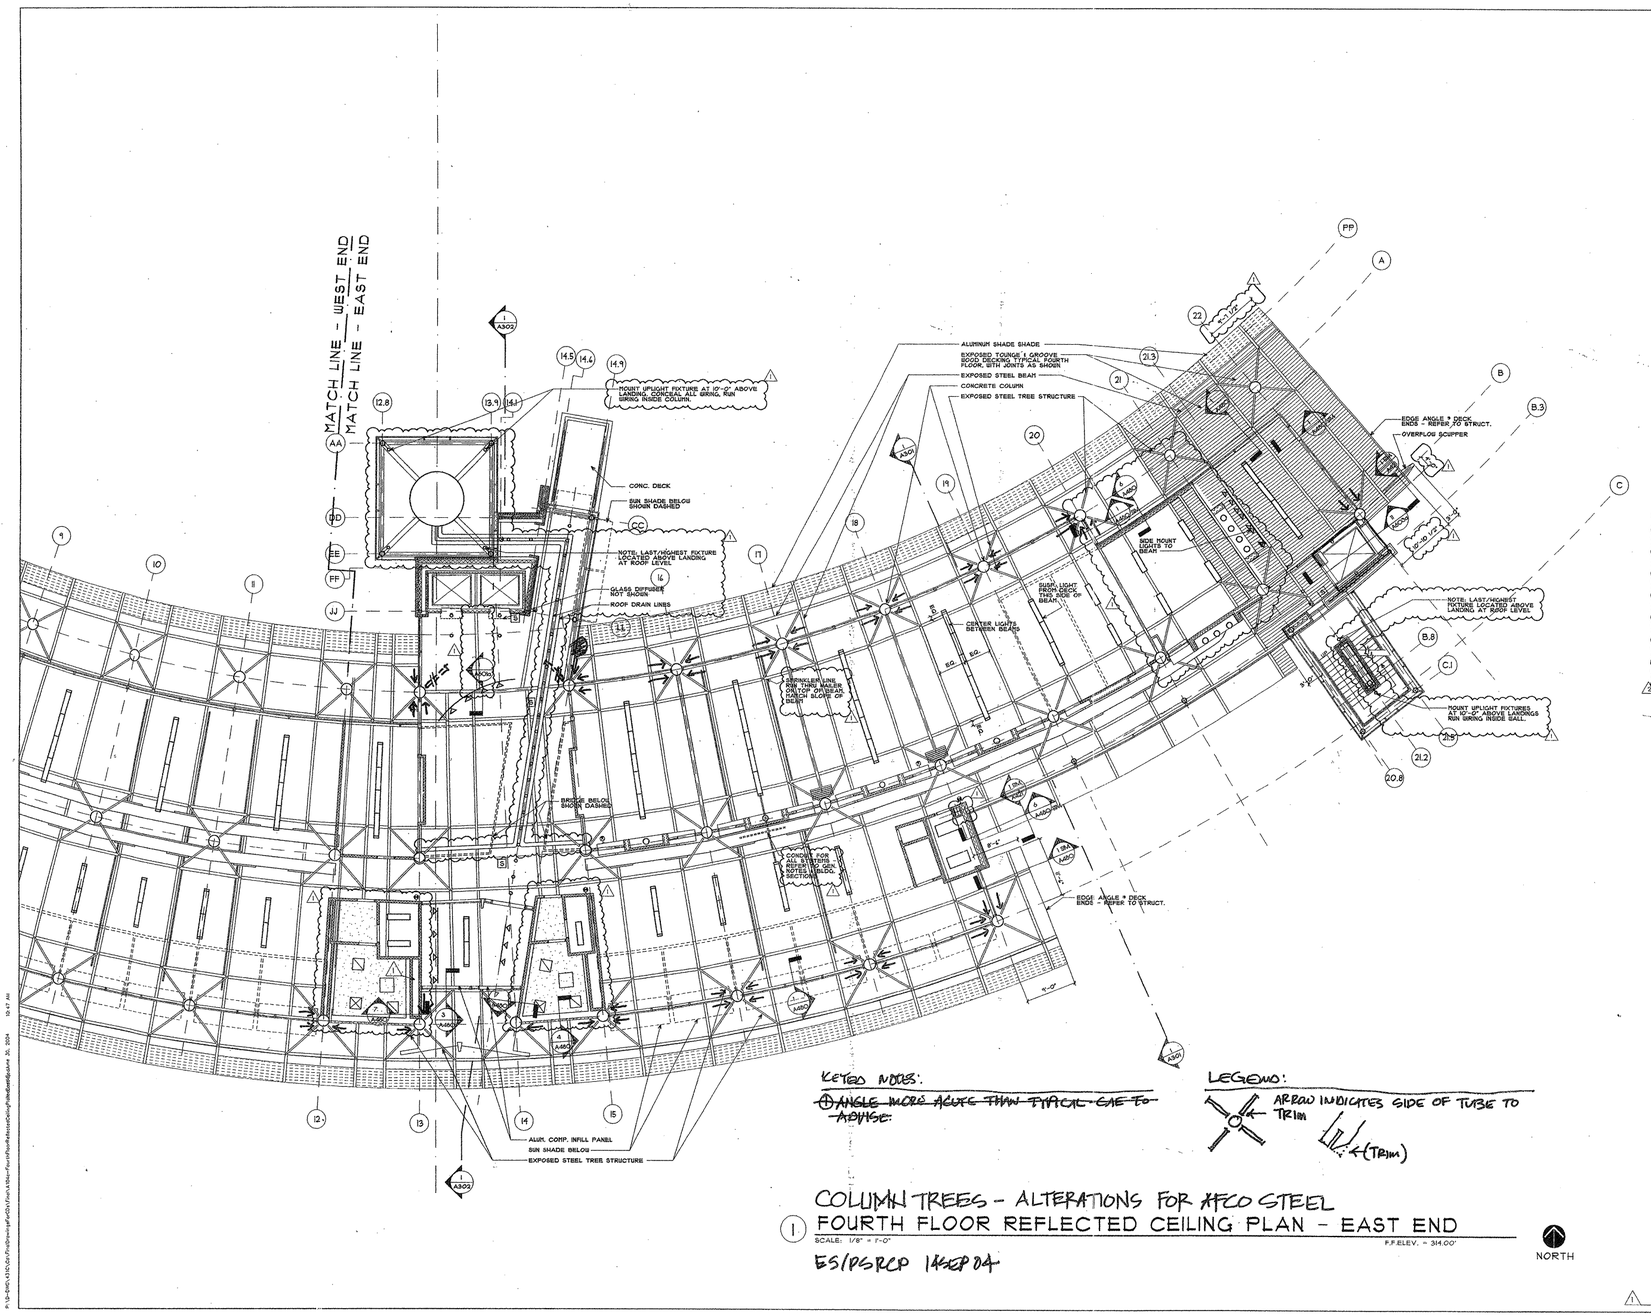

KEYED NOTES:

~~① ANGLE MORE ACUTE THAN TYPICAL USE TO ADVISE:~~

LEGEND:

ARROW INDICATES SIDE OF TUBE TO TRIM

4 (TRIM)

COLUMN TREES - ALTERATIONS FOR AFCO STEEL
① FOURTH FLOOR REFLECTED CEILING PLAN - EAST END

SCALE: 1/8" = 1'-0" F.F.ELEV. = 314.00'

NORTH

ES/PSRCP 14SEP04

POLK
STANLEY
YEARY
ARCHITECTS, LTD.

700 SOUTH SCHILLER
LITTLE ROCK, AR 72201
501 378-0878
FAX 372-7629

21 W. MOUNTAIN, SUITE 227
FAYETTEVILLE, AR 72701
479-444-0473

CONSULTANTS:

OWNER'S PROJECT ADVISOR:
MOSES TUCKER REAL ESTATE, INC.

CIVIL ENGINEER:
McCLELLAND ENGINEERS

LANDSCAPE ARCHITECT:
LARSON BURNS SMITH

STRUCTURAL ENGINEER:
CROMWELL ENGINEERS INC.

MECH., ELEC., PLUMB. ENGINEER:
CROMWELL ENGINEERS INC.

SUSTAINABLE CONSULTANT:
BNIM / ELEMENTS

GLOBAL VILLAGE CONSULTANT
CAMBRIDGE SEVEN ASSOCIATES

INTERIOR DESIGNER:
POLK STANLEY YEARY

GENERAL CONTRACTOR:
CDI

GENERAL NOTES:
1. PAINT ALL EXPOSED STEEL DECK & STRUCTURE - SEE SPEC'S FOR SCHEDULE.
2. DO NOT PAINT EXPOSED CONC. DECK.
3. DO NOT PAINT EXPOSED DUCTS.
4. PAINT ALL OTHER EXPOSED SYSTEMS - SEE SPEC'S FOR SCHED.
5. DO NOT PAINT ANY ALUM. MAT.
6. ELEC. CONDUIT SHALL RUN THRU FLOOR PLENUM ABOVE THEN DROP TO FIXTURE AND DEVICE J-BOX. MAILER.
7. PENDANT FIXTURES: MOUNT TIGHT TO SIDES OF BEAMS INDICATED UNLESS NOTED OTHERWISE. SEE BUILDING SECTIONS FOR ADDITIONAL INFORMATION.
8. LOCATION OF ALL DEVICES, FIXTURES, ETC. SHALL BE REVIEWED WITH ARCHITECT BEFORE INSTALLATION.
9. SEE REFLECTED PLANS FOR ADDITIONAL INFORMATION ON SPRINKLER LINE LOCATIONS.

NOTES:

ISSUE DATE:
100% CMP
PACKAGE #6
FEBRUARY 2, 2004

REVISIONS:

#	DATE	DESCRIPTION
1	CUMULOS	PACKAGE #7
	11/29/04	ASI # 67

HEIFER
INTERNATIONAL
CENTER
OFFICE BUILDING

LITTLE ROCK, ARKANSAS

ROOF TREE TUBE TRIMS - ~~9-29-04~~ 9-14-04 BY ED SCHEDULE PSRCP

PSY PROJECT NUMBER:
431C

CONTENTS:
FOURTH FLOOR REFLECTED CEILING PLAN - EAST END
SHEET NUMBER:

A104c

P:\2k-Proj\431C-Cdi-FtrsBuilding\pdf\A104c-FourthFloorReflectedCeilingPlan-EastEnd.dwg, 10:47 AM, September 30, 2004

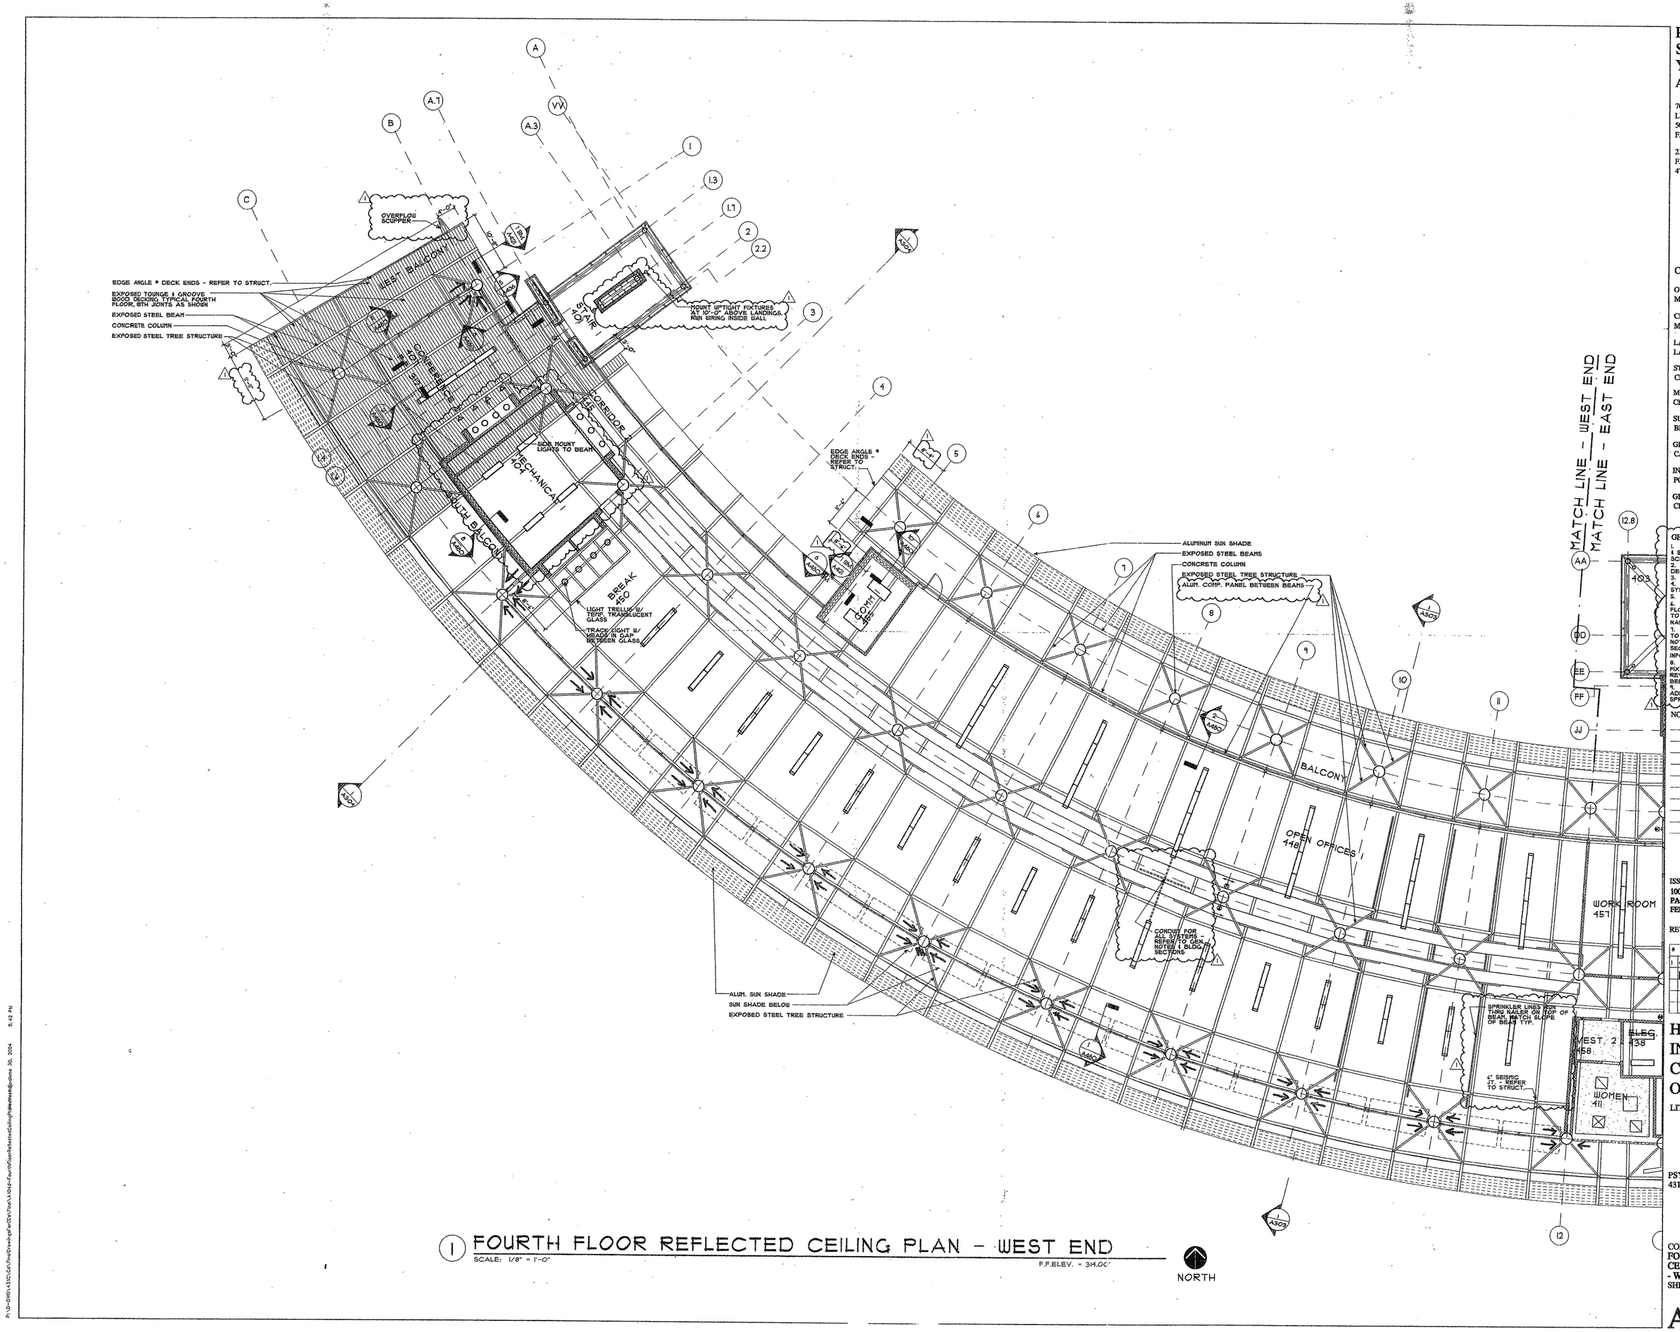

1 FOURTH FLOOR REFLECTED CEILING PLAN - WEST END

SCALE: 1/8" = 1'-0"

F.F.ELEV. = 314.00'

NORTH

POLK
STANLEY
YEARY
ARCHITECTS, LTD.

700 SOUTH SCHILLER
LITTLE ROCK, AR 72201
501 378-0878
FAX 372-7629

21 W. MOUNTAIN, SUITE 227
FAYETTEVILLE, AR 72701
479-444-0473

CONSULTANTS:

OWNER'S PROJECT ADVISOR:
MOSES TUCKER REAL ESTATE, INC.

CIVIL ENGINEER:
McCLELLAND ENGINEERS

LANDSCAPE ARCHITECT:
LARSON BURNS SMITH

STRUCTURAL ENGINEER:
CROMWELL ENGINEERS INC.

MECH., ELEC., PLUMB. ENGINEER:
CROMWELL ENGINEERS INC.

SUSTAINABLE CONSULTANT:
BNIM / ELEMENTS

GLOBAL VILLAGE CONSULTANT
CAMBRIDGE SEVEN ASSOCIATES

INTERIOR DESIGNER:
POLK STANLEY YEARY

GENERAL CONTRACTOR:
CDI

GENERAL NOTES:
1. PAINT ALL EXPOSED STEEL DECK & STRUCTURE - SEE SPEC'S FOR SCHEDULE.
2. DO NOT PAINT EXPOSED CONC. DECK.
3. DO NOT PAINT EXPOSED CUSTS.
4. PAINT ALL OTHER EXPOSED SYSTEMS - SEE SPEC'S FOR SCHED.
5. DO NOT PAINT ANY ALUM. MAT.
6. ELEC. CONDUIT SHALL RUN THRU FLOOR PLENUM ABOVE THEN DROP TO FIXTURE AND DEVICE J-BOX. NAILER.
7. PENDANT FIXTURES: MOUNT TIGHT TO SIDES OF BEAMS INDICATED UNLESS NOTED OTHERWISE. SEE BUILDING SECTIONS FOR ADDITIONAL INFORMATION.
8. LOCATION OF ALL DEVICES, FIXTURES, ETC. SHALL BE REVISED WITH ARCHITECT BEFORE INSTALLATION.
9. SEE BUILDING SECTIONS FOR ADDITIONAL INFORMATION ON SPRINKLER LINE LOCATIONS.

NOTES:

ISSUE DATE:
100% GMP
PACKAGE #6
FEBRUARY 2, 2004

REVISIONS:

#	DATE	DESCRIPTION
1	09JUL04	PACKAGE #1
	11/2/04	ASI # 07

HEIFER
INTERNATIONAL
CENTER
OFFICE BUILDING

LITTLE ROCK, ARKANSAS

ROOF TREE TUBE TRIMS
PER ED SERGEANT - PSRCP
9-14-04

PSY PROJECT NUMBER:
431C

CONTENTS:
FOURTH FLOOR REFLECTED CEILING PLAN - WEST END

SHEET NUMBER:

A104d

P:\D-DWG\431C\Dwg\Sht\A104d-FourthFloorReflectedCeilingPlan-WestEnd.dwg 20, 2004 5:43 PM

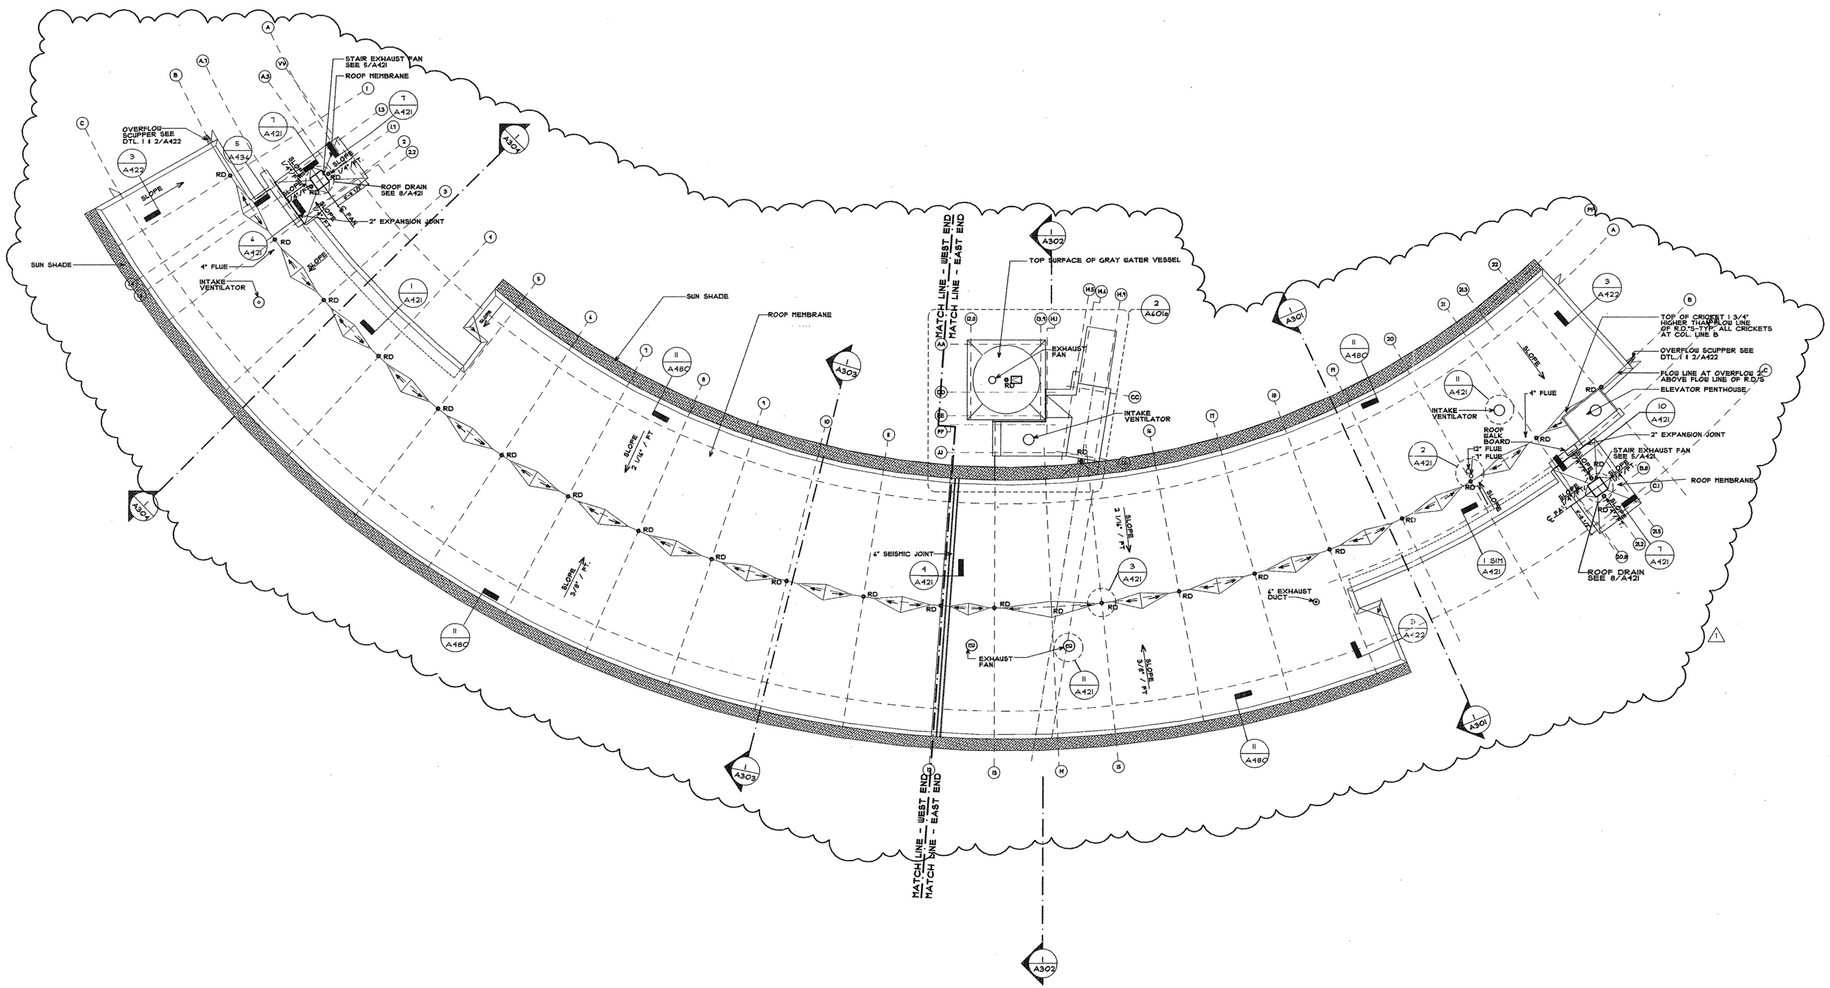

1 ROOF PLAN
SCALE: 1/16" = 1'-0"

NORTH

P:\LD-DWG\431C\CA\ConstDrawings\ConDocs\Final\A105-ROOFPLAN 9:28 AM Thursday, July 01, 2004

POLK
STANLEY
YEARY
ARCHITECTS, LTD.

700 SOUTH SCHILLER
LITTLE ROCK, AR 72201
501 378-0878
FAX 372-7629

21 W. MOUNTAIN, SUITE 227
FAYETTEVILLE, AR 72701
479-444-0473

CONSULTANTS:

OWNER'S PROJECT ADVISOR:
MOSES TUCKER REAL ESTATE, INC.

CIVIL ENGINEER:
McCLELLAND ENGINEERS

LANDSCAPE ARCHITECT:
LARSON BURNS SMITH

STRUCTURAL ENGINEER:
CROMWELL ENGINEERS INC.

MECH., ELEC., PLUMB. ENGINEER:
CROMWELL ENGINEERS INC.

SUSTAINABLE CONSULTANT:
BNIM / ELEMENTS

GLOBAL VILLAGE CONSULTANT
CAMBRIDGE SEVEN ASSOCIATES

INTERIOR DESIGNER:
POLK STANLEY YEARY

GENERAL CONTRACTOR:
CDI

GENERAL NOTES:

NOTES:

ISSUE DATE:
100% GMP
PACKAGE #6
FEBRUARY 2, 2004

REVISIONS:

#	DATE	DESCRIPTION
1	01JUL04	PACKAGE 01

HEIFER INTERNATIONAL CENTER OFFICE BUILDING

LITTLE ROCK, ARKANSAS

PSY PROJECT NUMBER:
431C

CONTENTS:
ROOF PLAN

SHEET NUMBER:

A105

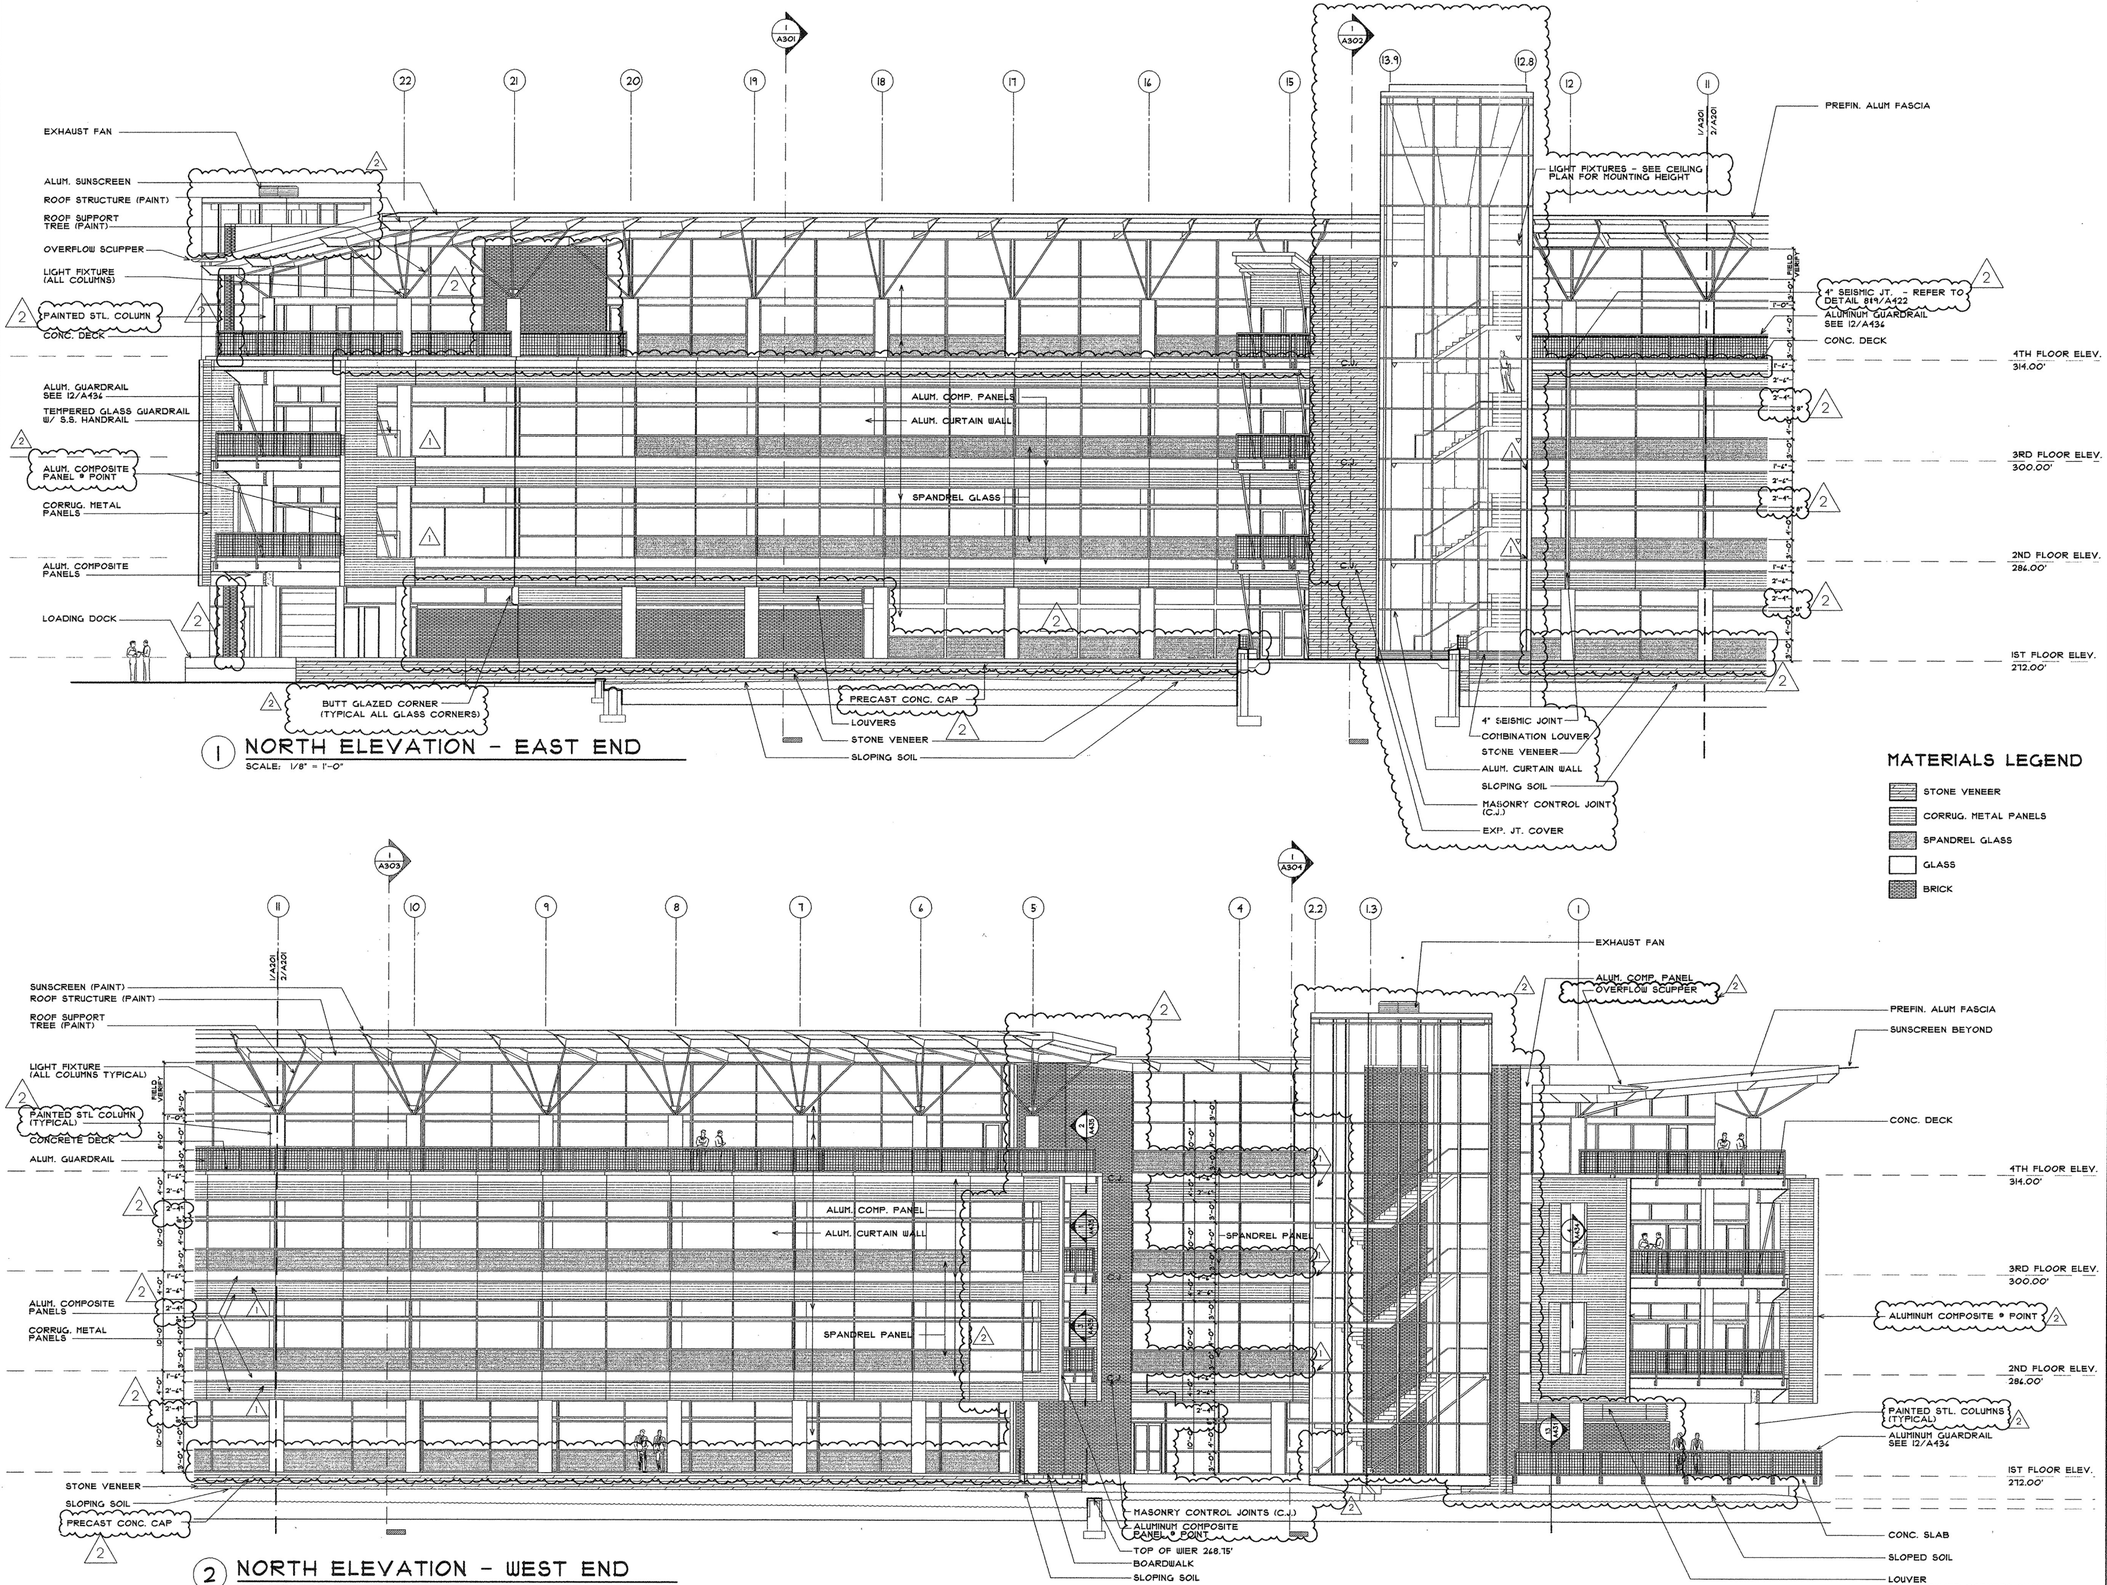

MATERIALS LEGEND

- STONE VENEER
- CORRUG. METAL PANELS
- SPANDREL GLASS
- GLASS
- BRICK

POLK
STANLEY
YEARY
ARCHITECTS, LTD.

700 SOUTH SCHILLER
LITTLE ROCK, AR 72201
501 378-0878
FAX 372-7629

21 W. MOUNTAIN, SUITE 227
FAYETTEVILLE, AR 72701
479-444-0473

CONSULTANTS:

OWNER'S PROJECT ADVISOR:
MOSES TUCKER REAL ESTATE, INC.

CIVIL ENGINEER:
McCLELLAND ENGINEERS

LANDSCAPE ARCHITECT:
LARSON BURNS SMITH

STRUCTURAL ENGINEER:
CROMWELL ENGINEERS INC.

MECH., ELEC., PLUMB. ENGINEER:
CROMWELL ENGINEERS INC.

SUSTAINABLE CONSULTANT:
BNIM / ELEMENTS

GLOBAL VILLAGE CONSULTANT
CAMBRIDGE SEVEN ASSOCIATES

INTERIOR DESIGNER:
POLK STANLEY YEARY

GENERAL CONTRACTOR:
CDI CONTRACTORS, INC.

GENERAL NOTES:

NOTES:

ISSUE DATE:
100% GMP
PACKAGE #6
FEBRUARY 2, 2004

REVISIONS:

#	DATE	DESCRIPTION
1	16JAN04	PACKAGE 5, ADDM 01
2	01JUL04	PACKAGE #7

HEIFER INTERNATIONAL CENTER OFFICE BUILDING

LITTLE ROCK, ARKANSAS

PSY PROJECT NUMBER:
431C

CONTENTS:
NORTH BUILDING ELEVATION

SHEET NUMBER:
A201

Thursday, July 01, 2004 3:01 PM

P:\D-DWG\431C\Cd\FinalDrawingsForCDs\Final\A201-NorthBldgElevation

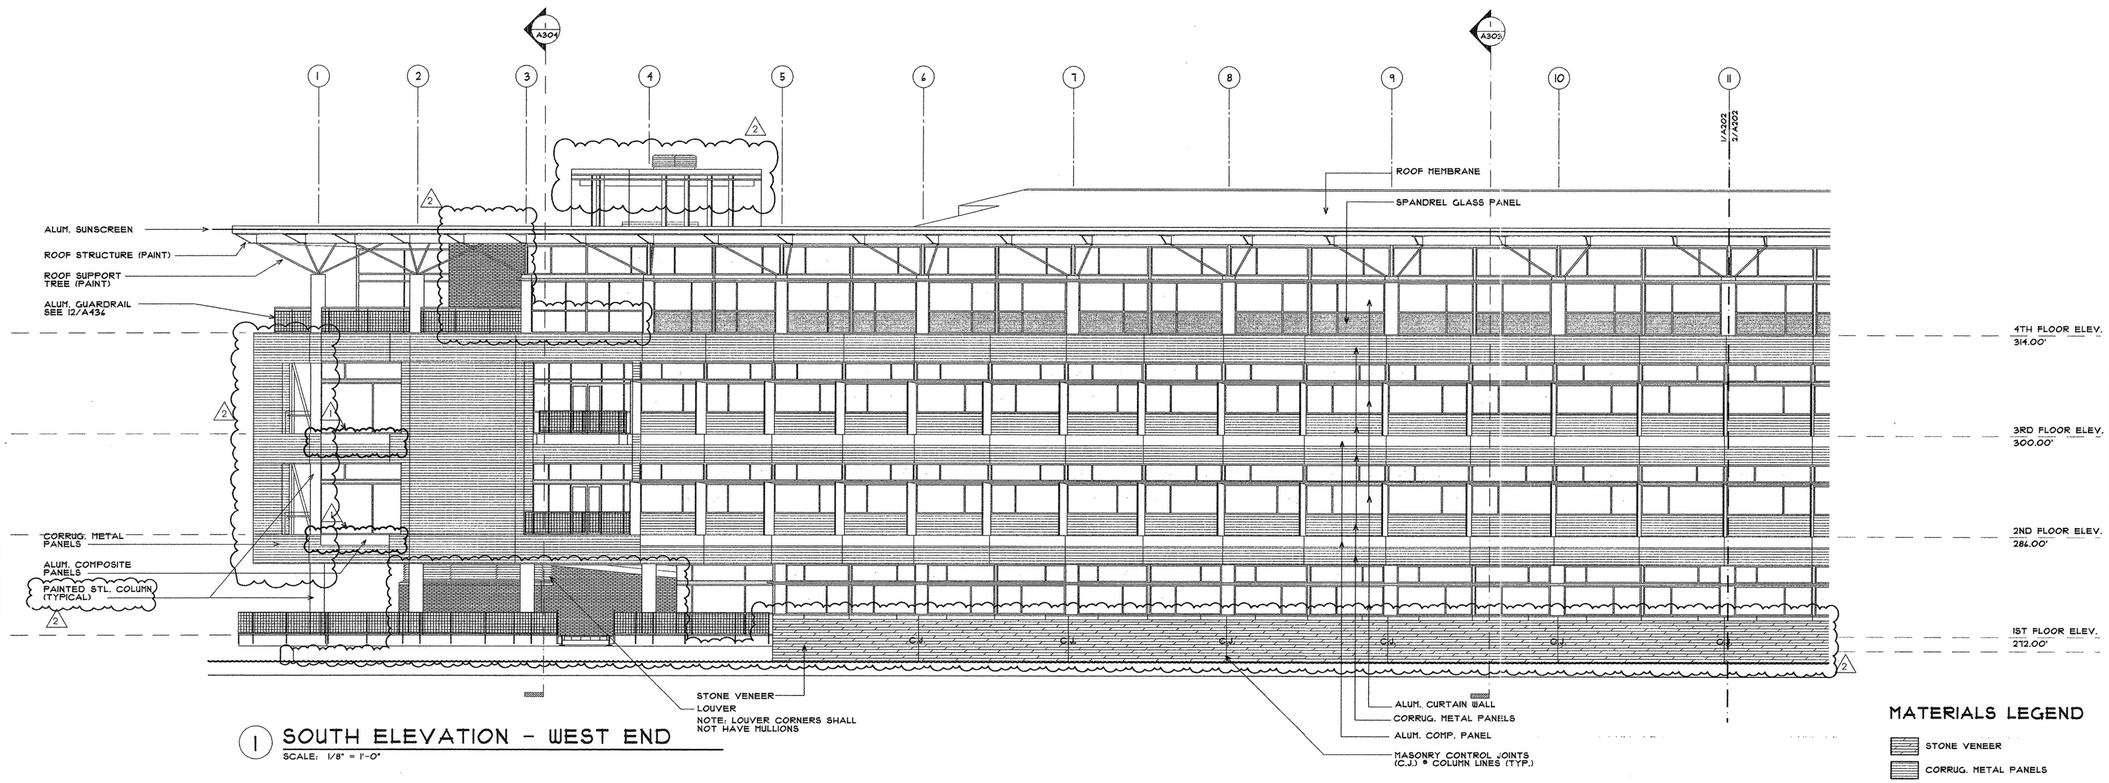

1 SOUTH ELEVATION - WEST END

SCALE: 1/8" = 1'-0"

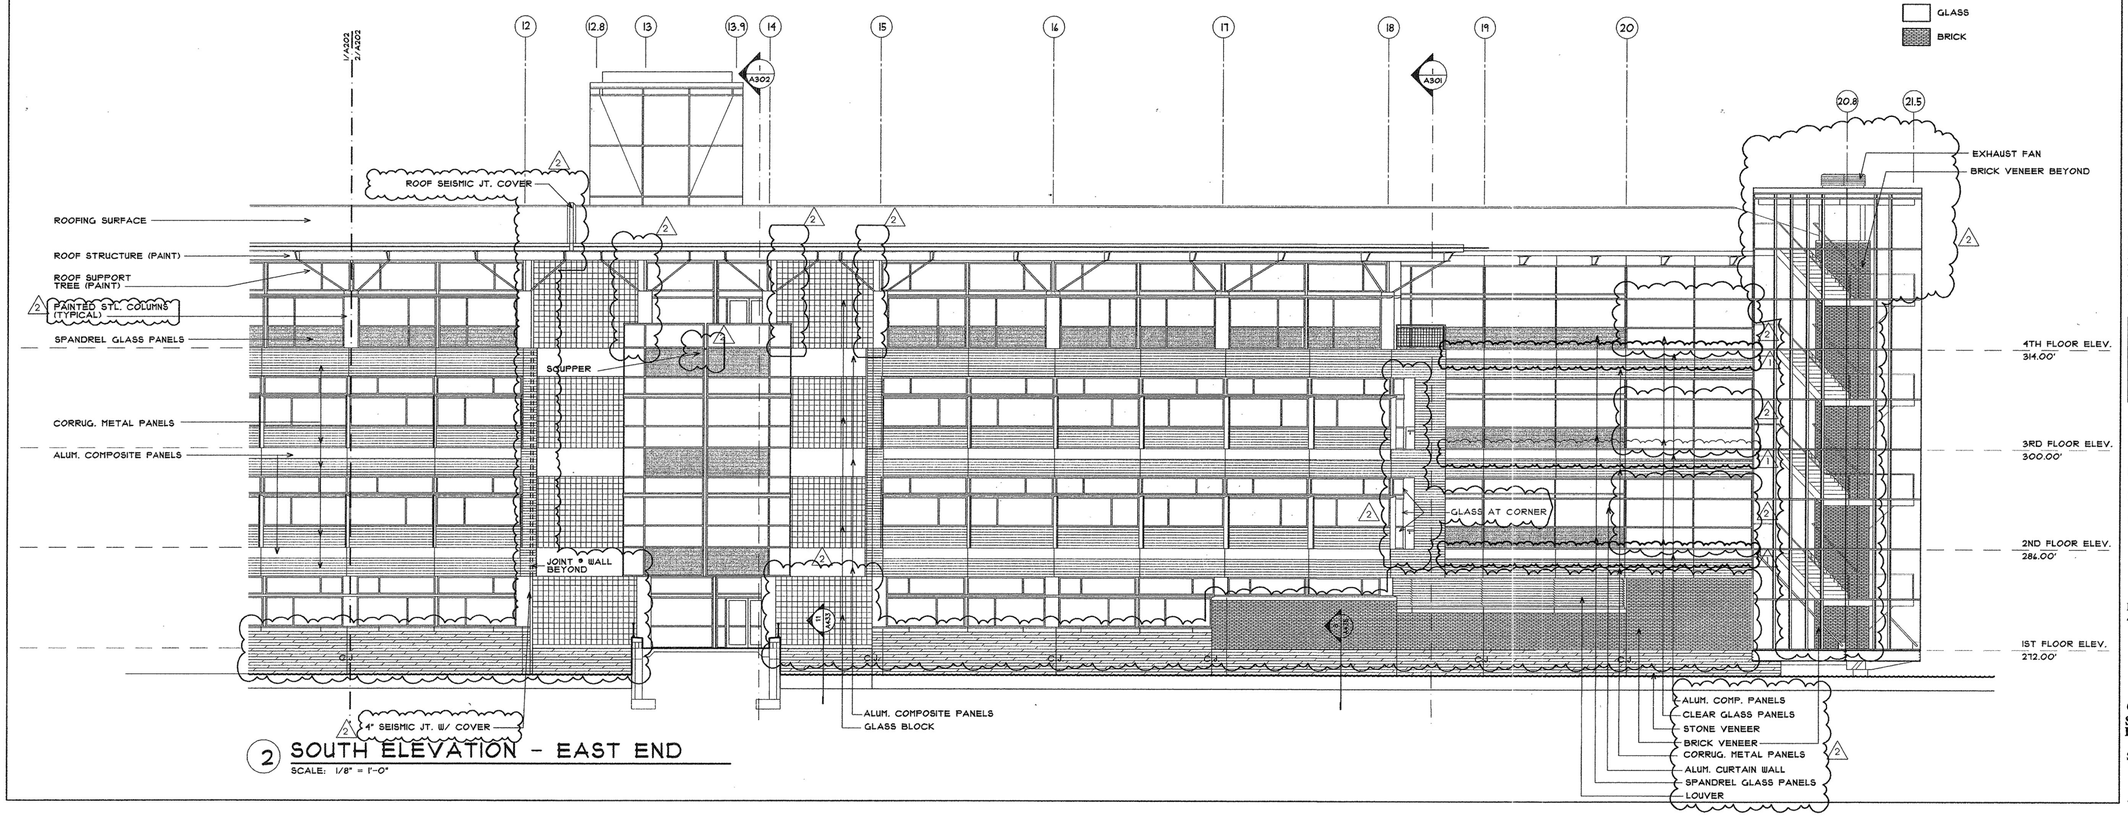

2 SOUTH ELEVATION - EAST END

SCALE: 1/8" = 1'-0"

MATERIALS LEGEND

- STONE VENEER
- CORRUG. METAL PANELS
- SPANDREL GLASS
- GLASS
- BRICK

POLK STANLEY YEARY ARCHITECTS, LTD.

700 SOUTH SCHILLER
LITTLE ROCK, AR 72201
501 378-0878
FAX 372-7629

21 W. MOUNTAIN, SUITE 227
FAYETTEVILLE, AR 72701
479-444-0473

CONSULTANTS:

OWNER'S PROJECT ADVISOR:
MOSES TUCKER REAL ESTATE, INC.

CIVIL ENGINEER:
McCLELLAND ENGINEERS

LANDSCAPE ARCHITECT:
LARSON BURNS SMITH

STRUCTURAL ENGINEER:
CROMWELL ENGINEERS INC.

MECH., ELEC., PLUMB. ENGINEER:
CROMWELL ENGINEERS INC.

SUSTAINABLE CONSULTANT:
BNIM / ELEMENTS

GLOBAL VILLAGE CONSULTANT
CAMBRIDGE SEVEN ASSOCIATES

INTERIOR DESIGNER:
POLK STANLEY YEARY

GENERAL CONTRACTOR:
CDI CONTRACTORS, INC.

GENERAL NOTES:

NOTES:

ISSUE DATE:
100% GMP
PACKAGE #6
FEBRUARY 2, 2004

REVISIONS:

#	DATE	DESCRIPTION
1	16JAN04	PACKAGE 5, ADDM. 01
2	01JUL04	PACKAGE #7

HEIFER INTERNATIONAL CENTER OFFICE BUILDING

LITTLE ROCK, ARKANSAS

PSY PROJECT NUMBER:
431C

CONTENTS:
SOUTH BUILDING ELEVATION

SHEET NUMBER:

A202

P:\2-DWG\431C\CA\PrintDrawingFiles\Dist\Final\A202-SouthBldgElevation Thursday, July 01, 2004 1:45 PM

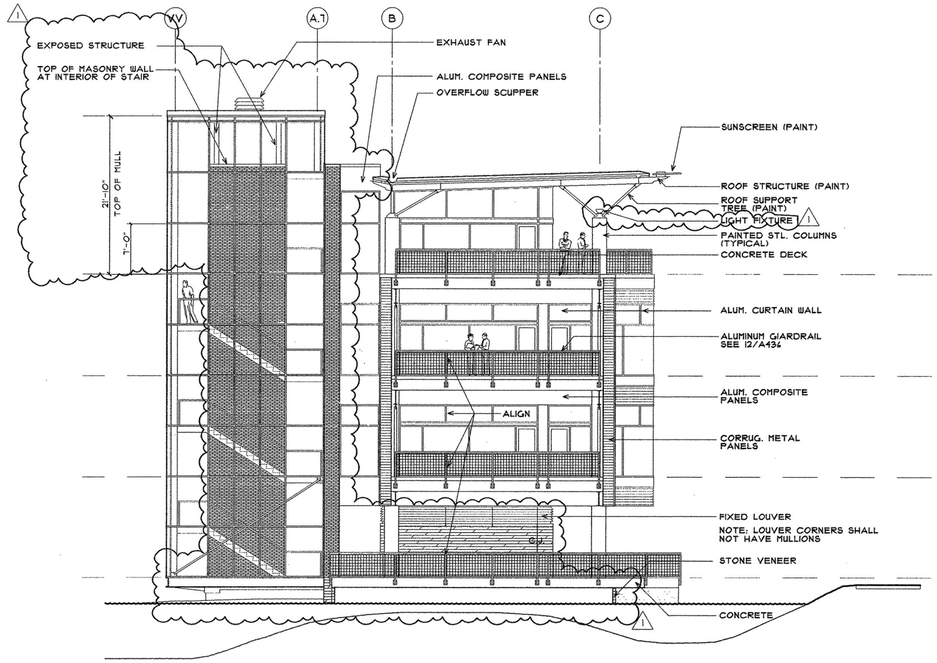

1 WEST ELEVATION

SCALE: 1/8" = 1'-0"

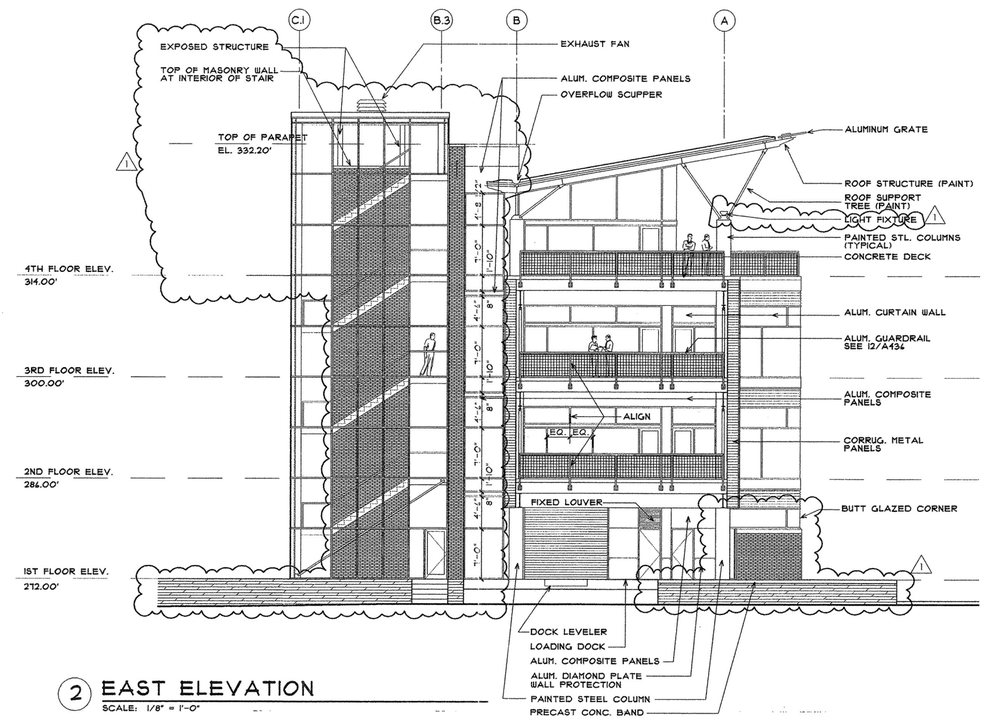

2 EAST ELEVATION

SCALE: 1/8" = 1'-0"

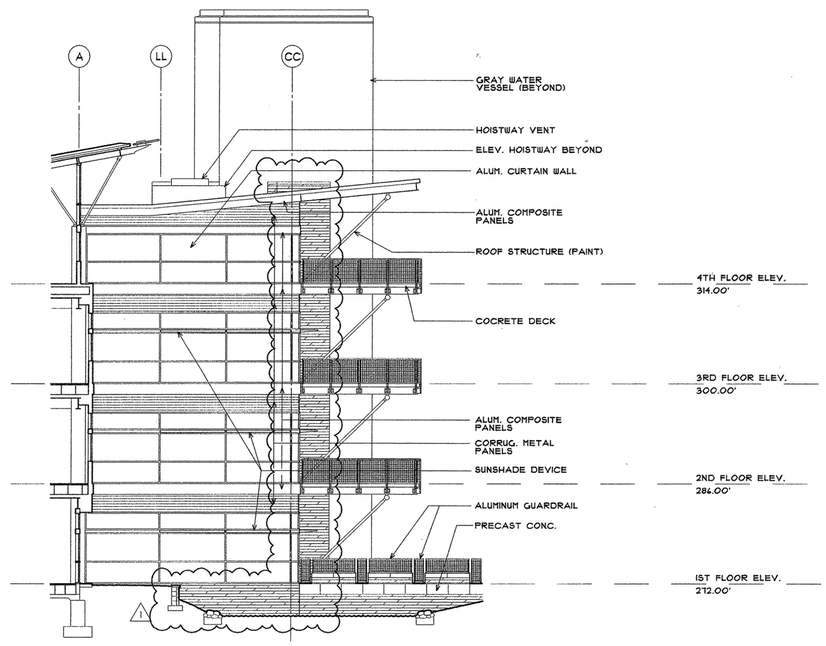

5 CORE - EAST ELEVATION

SCALE: 1/8" = 1'-0"

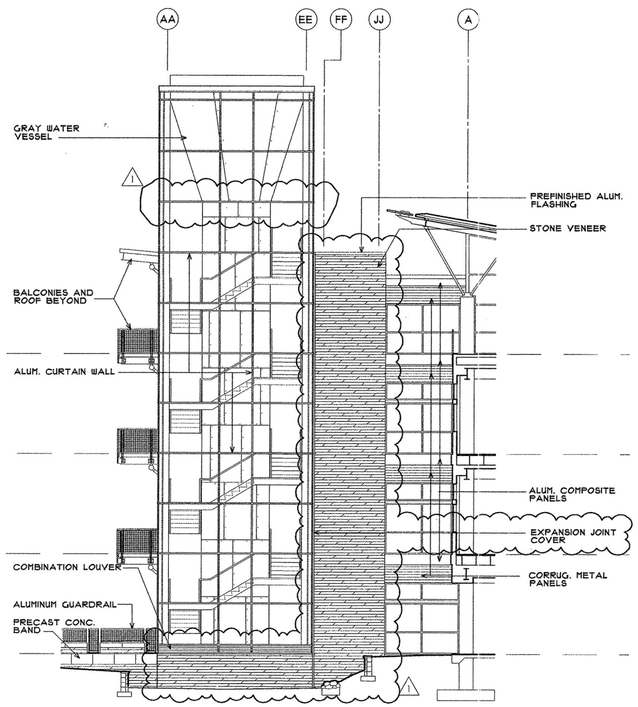

6 CORE - WEST ELEVATION

SCALE: 1/8" = 1'-0"

MATERIALS LEGEND

- STONE VENEER
- CORRUG. METAL PANELS
- SPANDREL GLASS
- GLASS
- BRICK

POLK STANLEY YEARY
ARCHITECTS, LTD.

700 SOUTH SCHILLER
LITTLE ROCK, AR 72201
501 378-0878
FAX 372-7629

21 W. MOUNTAIN, SUITE 227
FAYETTEVILLE, AR 72701
479-444-0473

CONSULTANTS:

OWNER'S PROJECT ADVISOR:
MOSES TUCKER REAL ESTATE, INC.

CIVIL ENGINEER:
McCLELLAND ENGINEERS

LANDSCAPE ARCHITECT:
LARSON BURNS SMITH

STRUCTURAL ENGINEER:
CROMWELL ENGINEERS INC.

MECH., ELEC., PLUMB. ENGINEER:
CROMWELL ENGINEERS INC.

SUSTAINABLE CONSULTANT:
BNIM / ELEMENTS

GLOBAL VILLAGE CONSULTANT
CAMBRIDGE SEVEN ASSOCIATES

INTERIOR DESIGNER:
POLK STANLEY YEARY

GENERAL CONTRACTOR:
CDI CONTRACTORS, INC.

GENERAL NOTES:

NOTES:

ISSUE DATE:
100% GMP
PACKAGE #6
FEBRUARY 2, 2003

REVISIONS:

#	DATE	DESCRIPTION
1	01JUL04	PACKAGE #7

HEIFER INTERNATIONAL CENTER OFFICE BUILDING

LITTLE ROCK, ARKANSAS

PSY PROJECT NUMBER:
431C

REGISTERED LANDSCAPE ARCHITECT CORPORATE SEAL — Kenneth Rowell C-138 — ARKANSAS

CONTENTS:
EAST & WEST BUILDING ELEVATIONS

SHEET NUMBER:

A203

P:\2k-DWG\431C\Cd Files\Drawings\Arch\Sht\A203-EastWestBldgElevs.dwg, July 01, 2004 5:42 PM

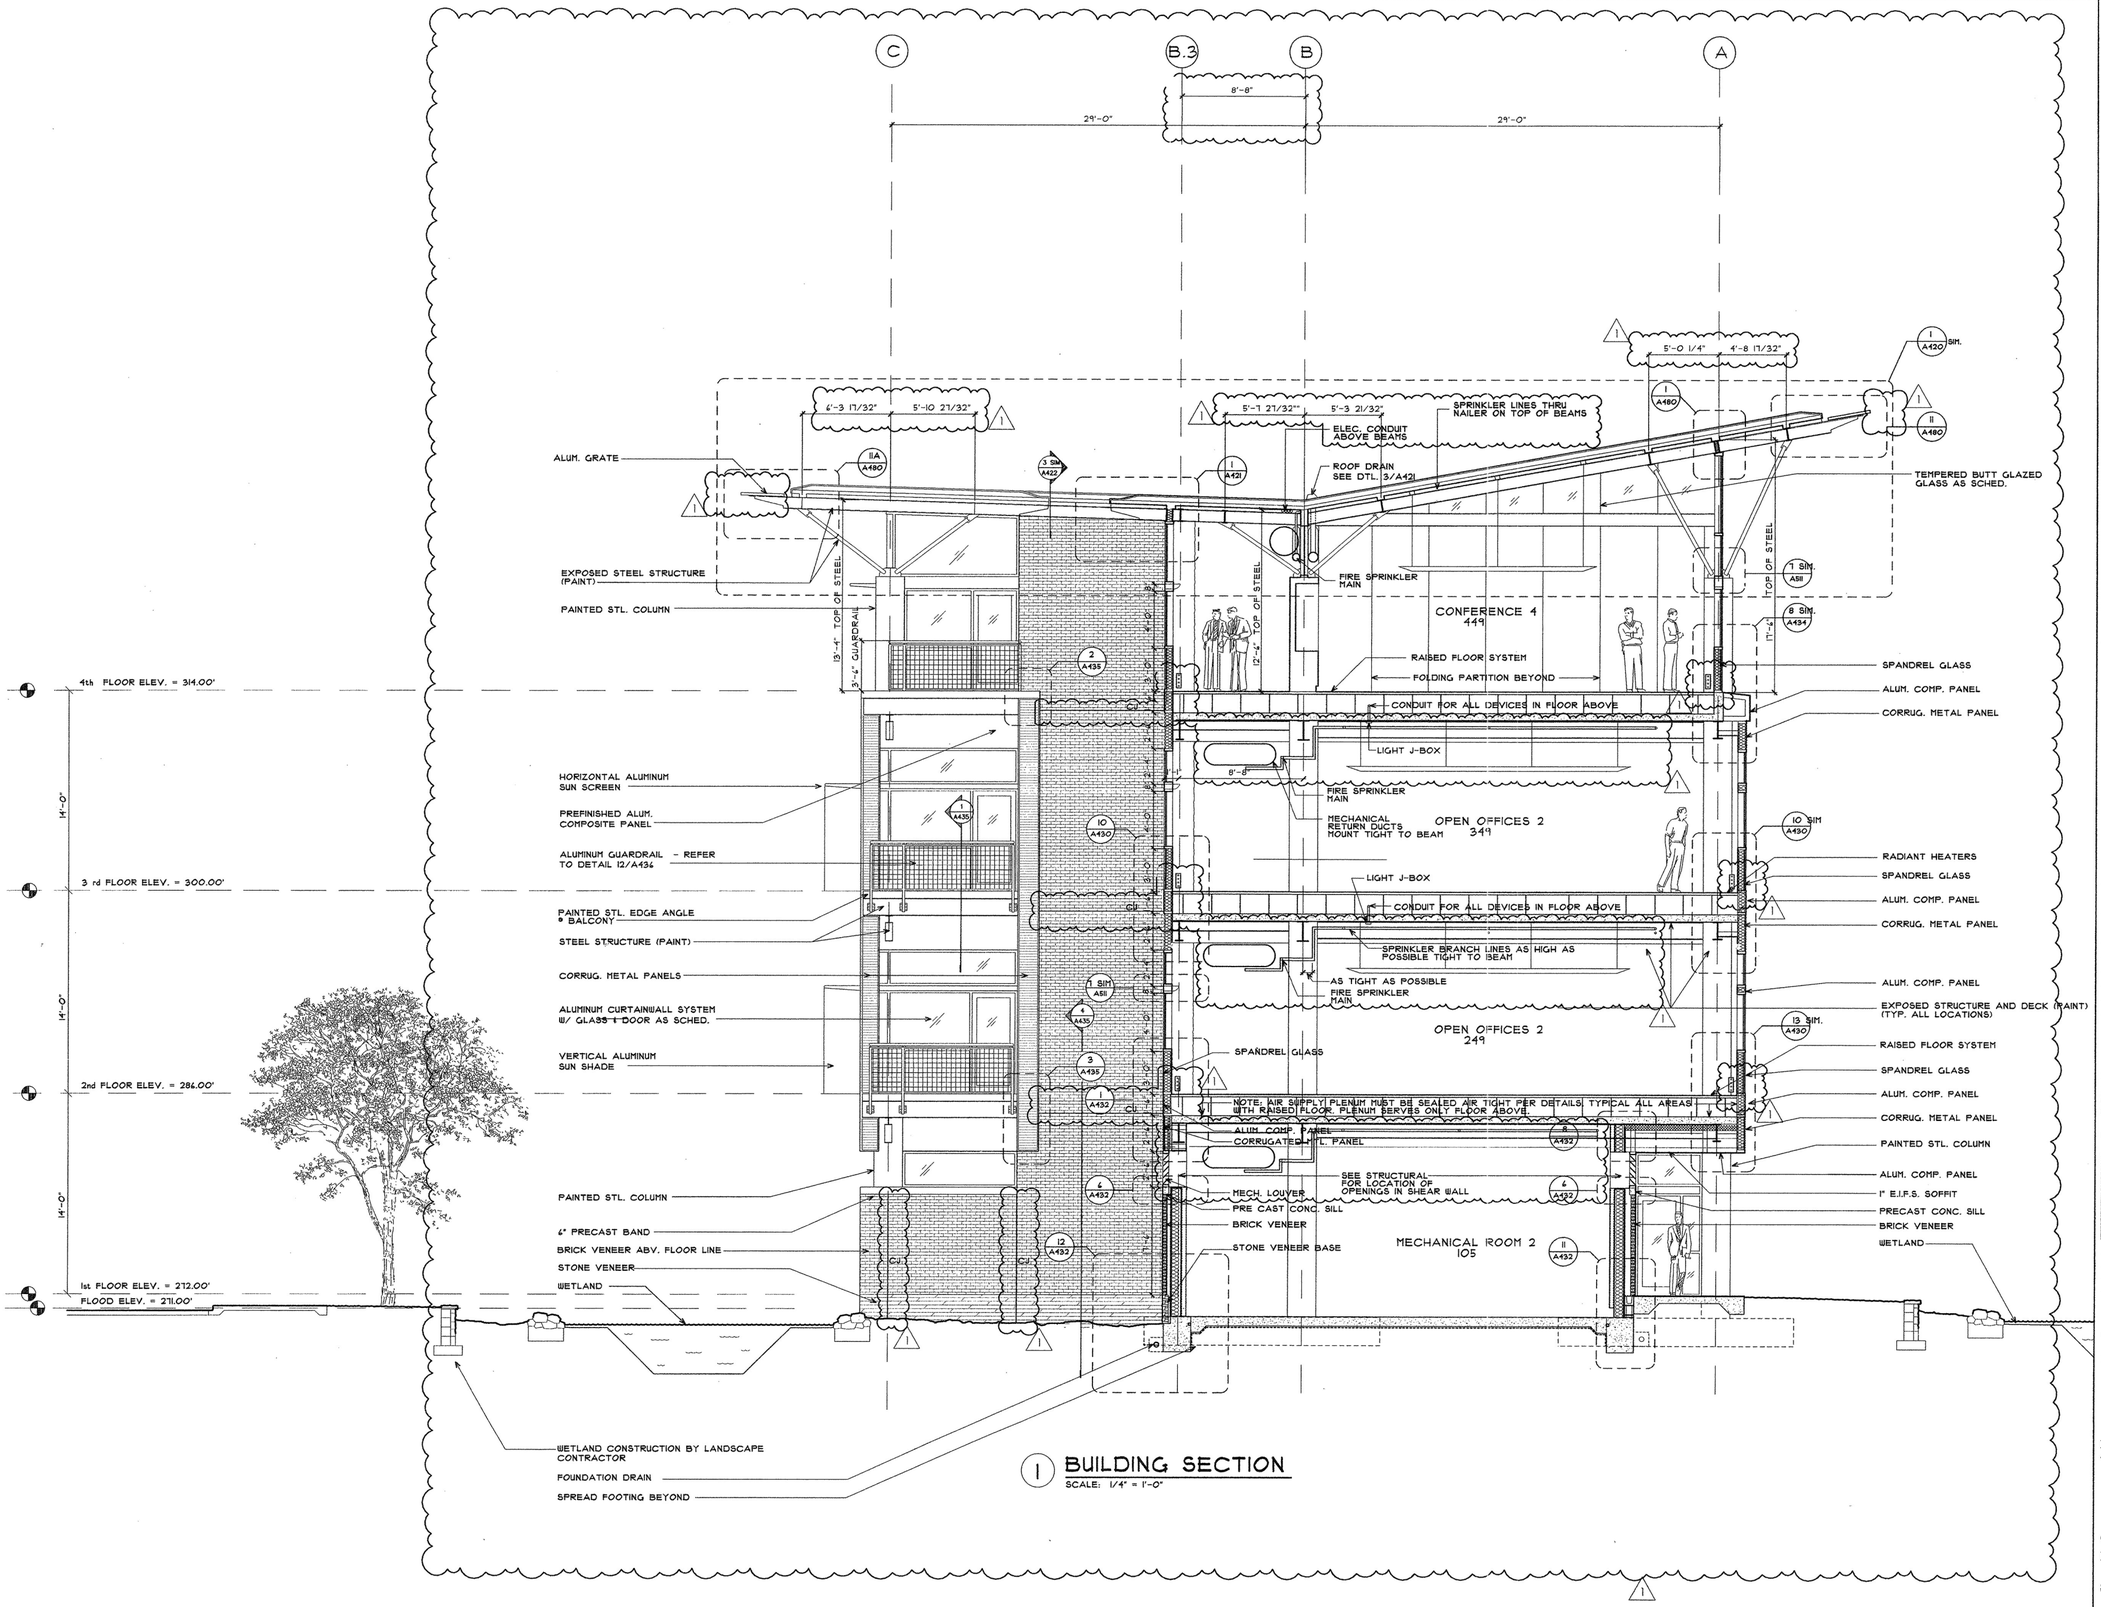

1 BUILDING SECTION

SCALE: 1/4" = 1'-0"

POLK STANLEY YEARY
ARCHITECTS, LTD.

700 SOUTH SCHILLER
LITTLE ROCK, AR 72201
501 378-0878
FAX 372-7629

21 W. MOUNTAIN, SUITE 227
FAYETTEVILLE, AR 72701
479-444-0473

CONSULTANTS:

OWNER'S PROJECT ADVISOR:
MOSES TUCKER REAL ESTATE, INC.

CIVIL ENGINEER:
McCLELLAND ENGINEERS

LANDSCAPE ARCHITECT:
LARSON BURNS SMITH

STRUCTURAL ENGINEER:
CROMWELL ENGINEERS INC.

MECH., ELEC., PLUMB. ENGINEER:
CROMWELL ENGINEERS INC.

SUSTAINABLE CONSULTANT:
BNIM / ELEMENTS

GLOBAL VILLAGE CONSULTANT
CAMBRIDGE SEVEN ASSOCIATES

INTERIOR DESIGNER:
POLK STANLEY YEARY

GENERAL CONTRACTOR:
CDI CONTRACTORS, INC.

GENERAL NOTES:

NOTES:

ISSUE DATE:
100% GMP
PACKAGE #6
FEBRUARY 02, 2004

REVISIONS:

#	DATE	DESCRIPTION
1	04.01.04	PACKAGE #7

HEIFER INTERNATIONAL CENTER OFFICE BUILDING

LITTLE ROCK, ARKANSAS

PSY PROJECT NUMBER:
431C

CONTENTS:
BUILDING CROSS SECTON

SHEET NUMBER:

A301

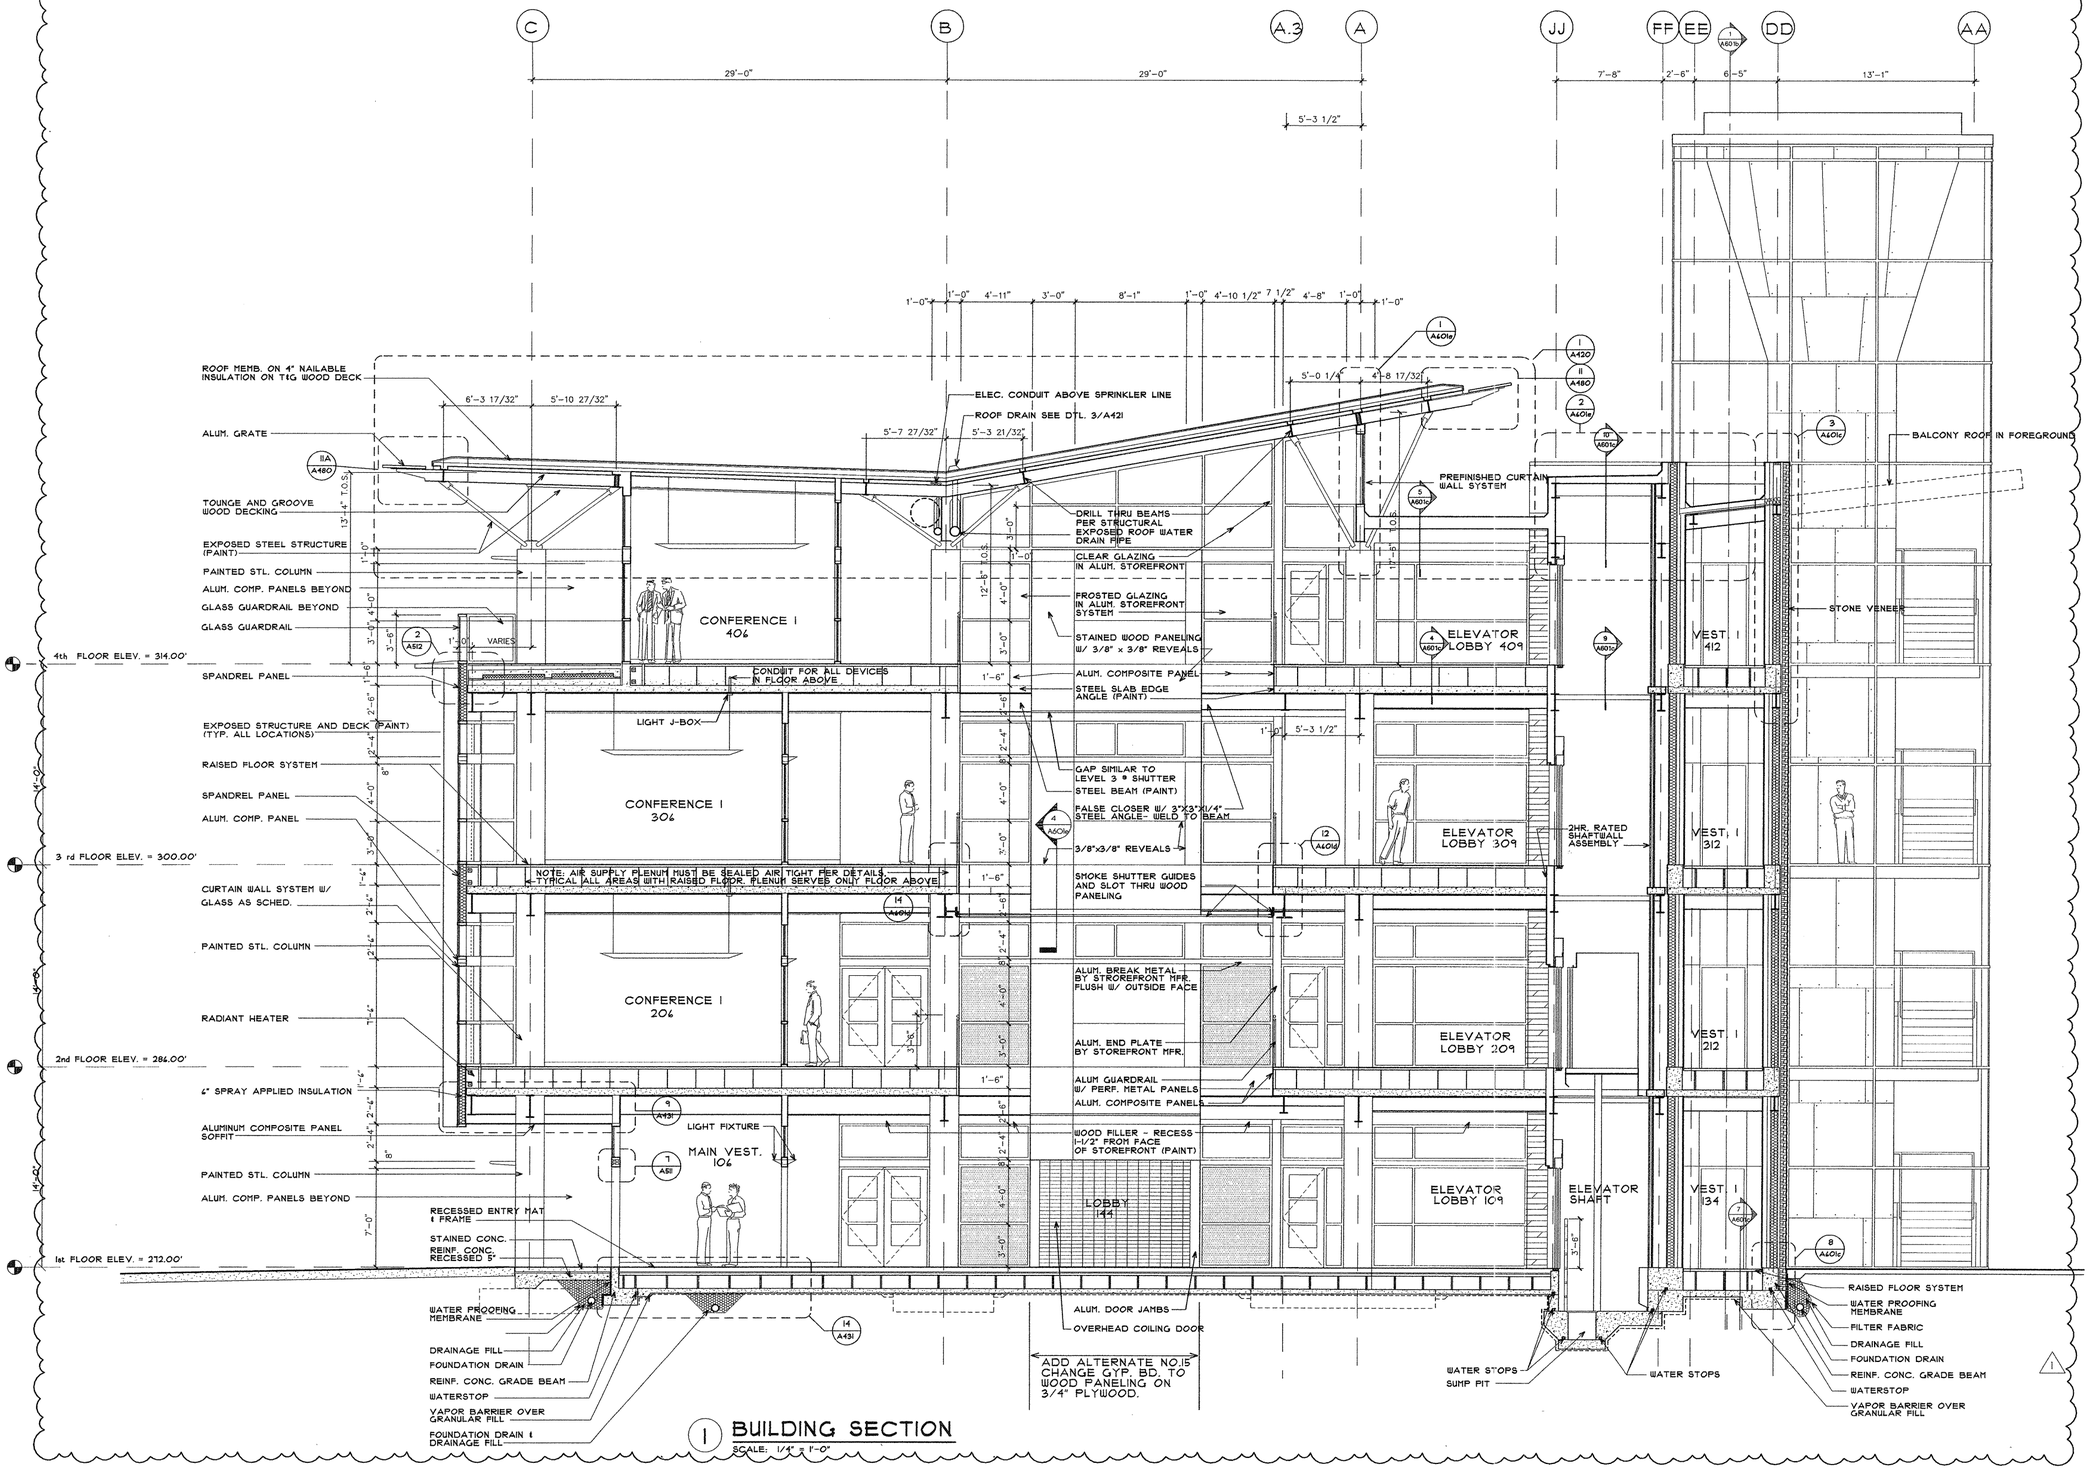

1 BUILDING SECTION

SCALE: 1/4" = 1'-0"

P:\D-Dlbl\413C\CA\Final\Drawings\Fin-CDs\Final\A302-BuildingSection.Dc5
Tuesday, July 06, 2004
10:02 AM

POLK STANLEY YEARY
ARCHITECTS, LTD.

700 SOUTH SCHILLER
LITTLE ROCK, AR 72201
501 378-0878
FAX 372-7629

21 W. MOUNTAIN, SUITE 227
FAYETTEVILLE, AR 72701
479-444-0473

CONSULTANTS:

OWNER'S PROJECT ADVISOR:
MOSES TUCKER REAL ESTATE, INC.

CIVIL ENGINEER:
McCLELLAND ENGINEERS

LANDSCAPE ARCHITECT:
LARSON BURNS SMITH

STRUCTURAL ENGINEER:
CROMWELL ENGINEERS INC.

MECH., ELEC., PLUMB. ENGINEER:
CROMWELL ENGINEERS INC.

SUSTAINABLE CONSULTANT:
BNIM / ELEMENTS

GLOBAL VILLAGE CONSULTANT
CAMBRIDGE SEVEN ASSOCIATES

INTERIOR DESIGNER:
POLK STANLEY YEARY

GENERAL CONTRACTOR:
CDI CONTRACTORS, INC.

GENERAL NOTES:

NOTES:

ISSUE DATE:
100% GMP
PACKAGE #6
FEBRUARY 2, 2004

REVISIONS:

#	DATE	DESCRIPTION
1	01JUL04	PACKAGE #7

HEIFER INTERNATIONAL CENTER OFFICE BUILDING

LITTLE ROCK, ARKANSAS

PSY PROJECT NUMBER:
431C

CONTENTS:
BUILDING CROSS SECTION

SHEET NUMBER:
A302

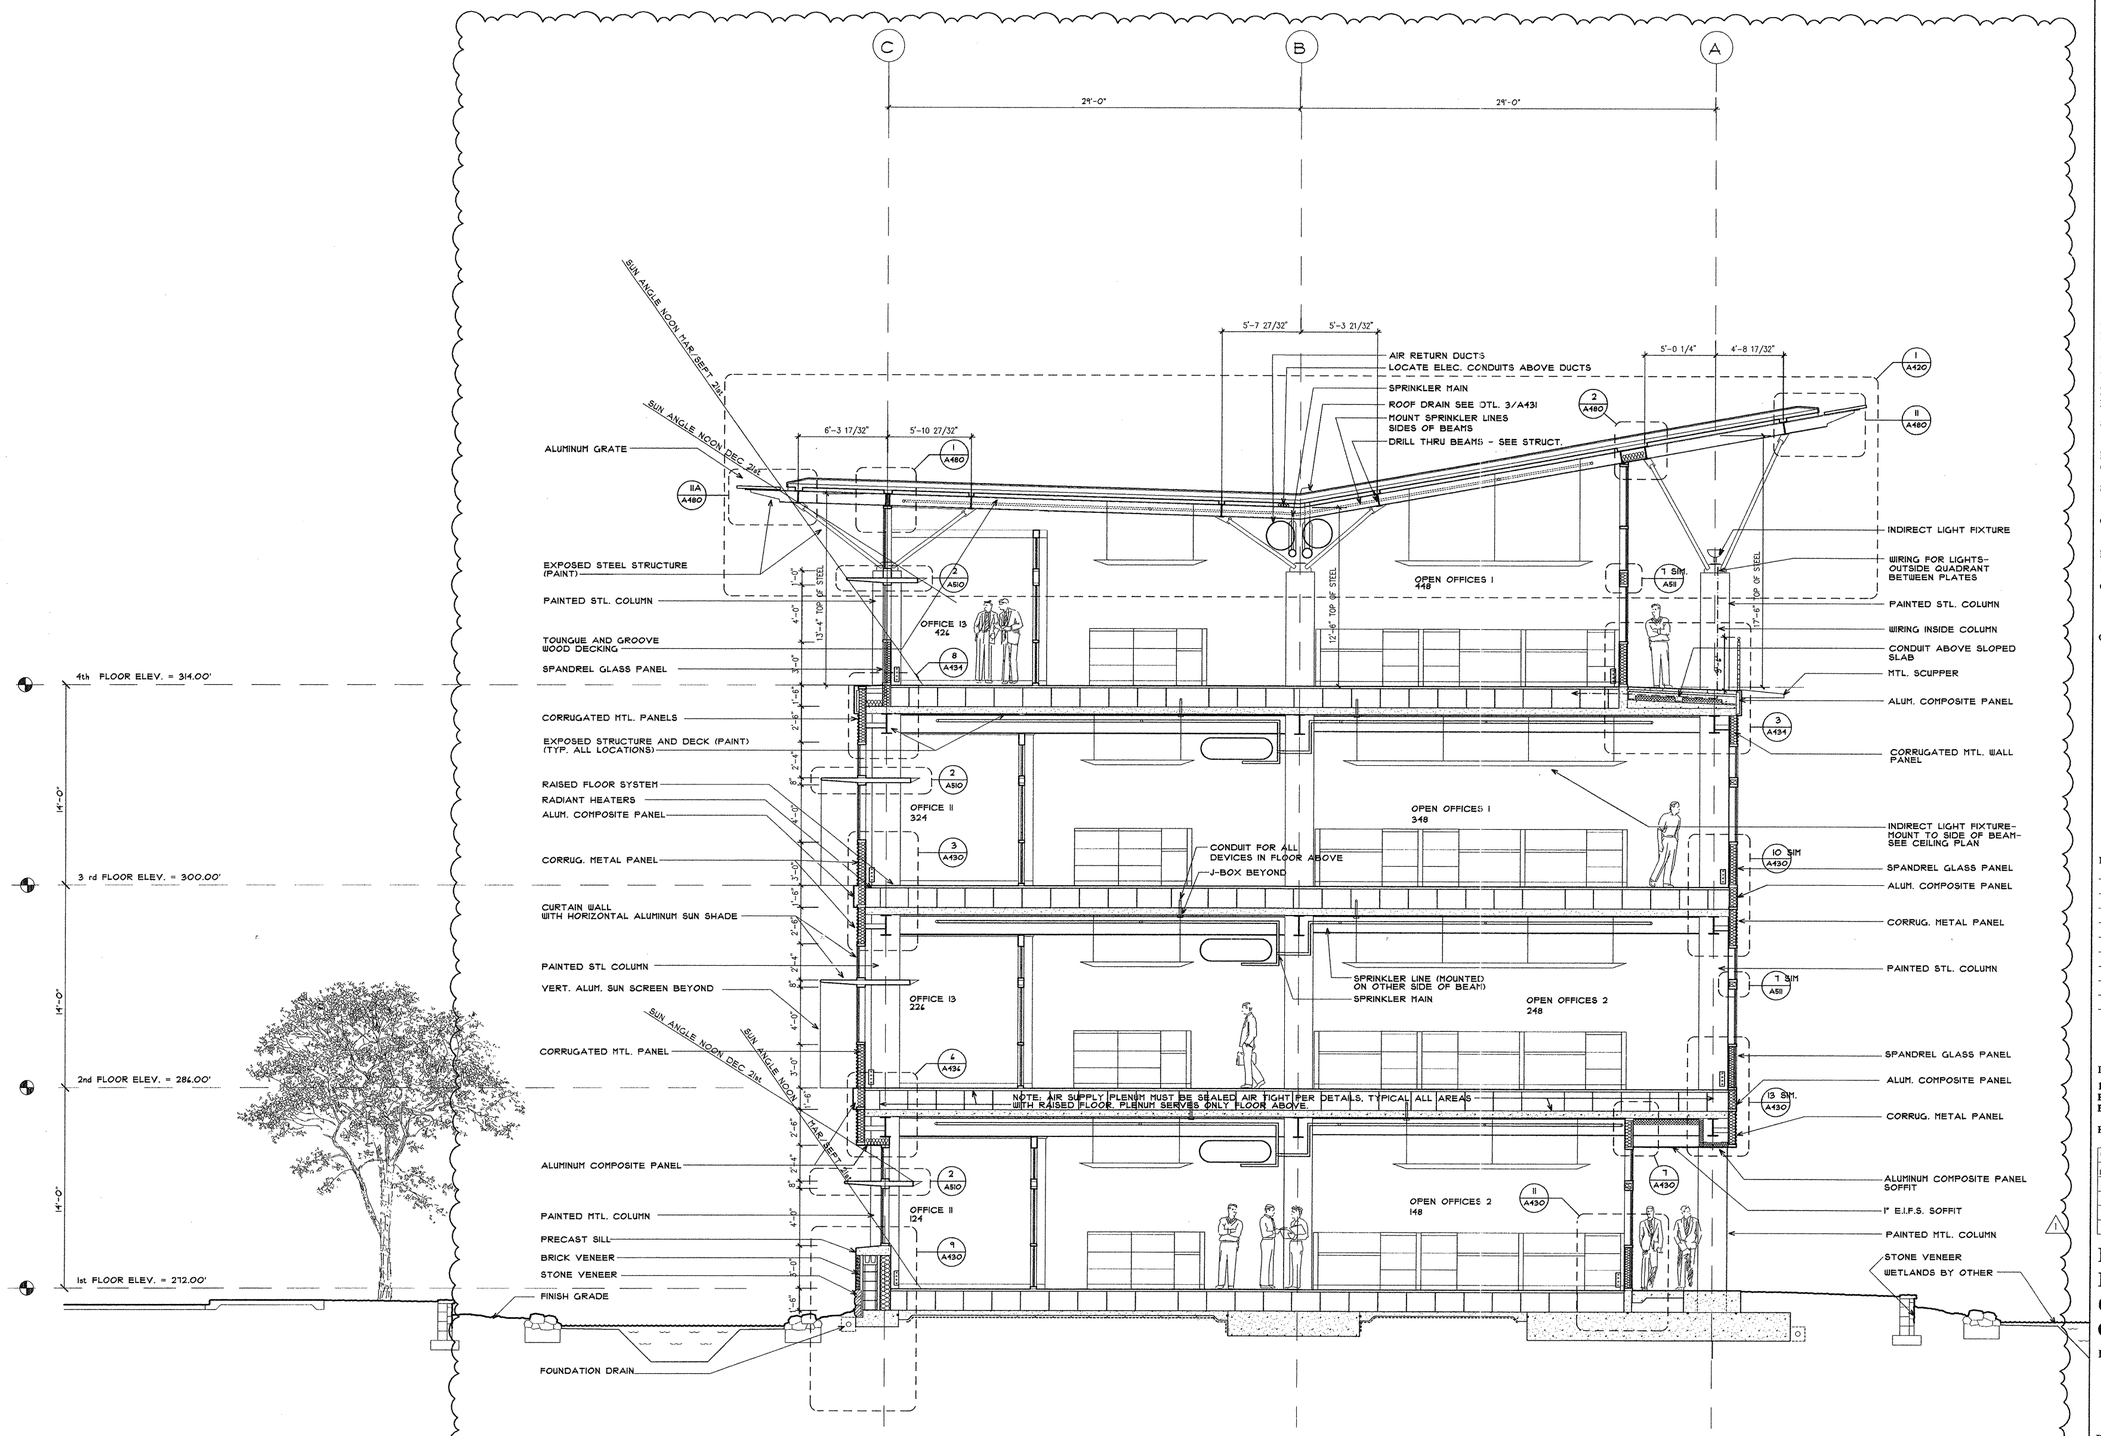

1 BUILDING SECTION
SCALE: 1/4" = 1'-0"

POLK
STANLEY
YEARY
ARCHITECTS, LTD.

700 SOUTH SCHILLER
LITTLE ROCK, AR 72201
501 378-0878
FAX 372-7629

21 W. MOUNTAIN, SUITE 227
FAYETTEVILLE, AR 72701
479-444-0473

CONSULTANTS:

OWNER'S PROJECT ADVISOR:
MOSES TUCKER REAL ESTATE, INC.

CIVIL ENGINEER:
McCLELLAND ENGINEERS

LANDSCAPE ARCHITECT:
LARSON BURNS SMITH

STRUCTURAL ENGINEER:
CROMWELL ENGINEERS INC.

MECH., ELEC., PLUMB. ENGINEER:
CROMWELL ENGINEERS INC.

SUSTAINABLE CONSULTANT:
BNIM / ELEMENTS

GLOBAL VILLAGE CONSULTANT
CAMBRIDGE SEVEN ASSOCIATES

INTERIOR DESIGNER:
POLK STANLEY YEARY

GENERAL CONTRACTOR:
CDI CONTRACTORS, INC.

GENERAL NOTES:

NOTES:

ISSUE DATE:
100% GMP
PACKAGE #6
FEBRUARY 02, 2004

REVISIONS:

#	DATE	DESCRIPTION
1	01JUL04	PACKAGE 07

HEIFER INTERNATIONAL CENTER OFFICE BUILDING

LITTLE ROCK, ARKANSAS

PSY PROJECT NUMBER:
431C

CONTENTS:
BUILDING CROSS SECTION

SHEET NUMBER:

A303

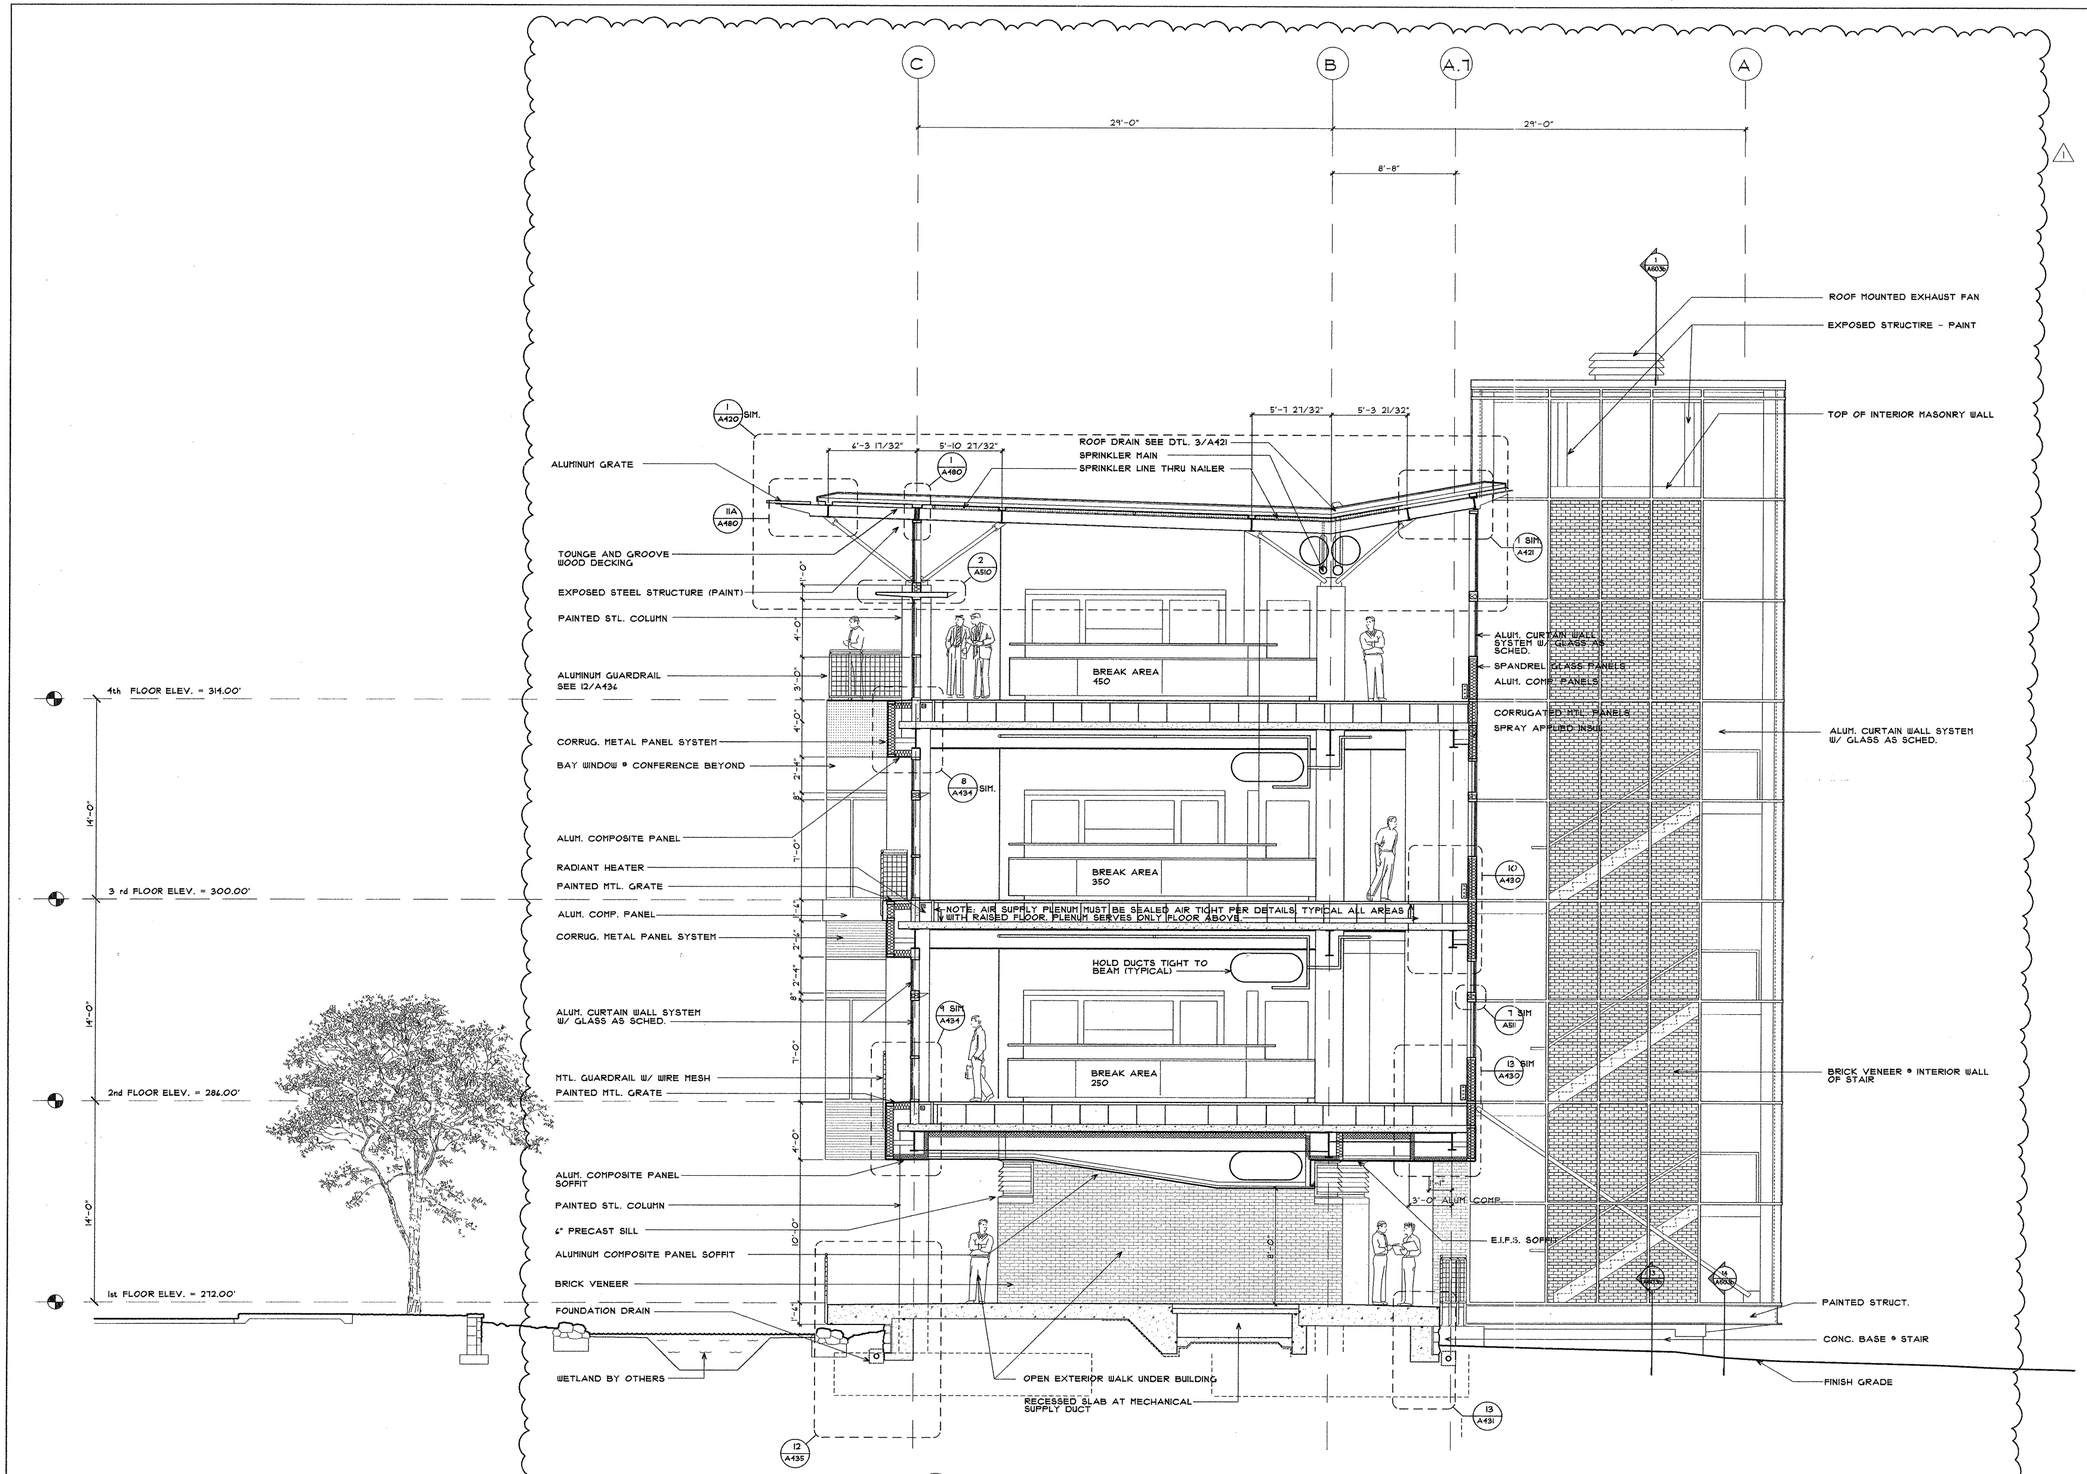

1 BUILDING SECTION

SCALE: 1/4" = 1'-0"

POLK STANLEY YEARY
ARCHITECTS, LTD.

700 SOUTH SCHILLER
LITTLE ROCK, AR 72201
501 378-0878
FAX 372-7629

21 W. MOUNTAIN, SUITE 227
FAYETTEVILLE, AR 72701
479-444-0473

CONSULTANTS:

OWNER'S PROJECT ADVISOR:
MOSES TUCKER REAL ESTATE, INC.

CIVIL ENGINEER:
McCLELLAND ENGINEERS

LANDSCAPE ARCHITECT:
LARSON BURNS SMITH

STRUCTURAL ENGINEER:
CROMWELL ENGINEERS INC.

MECH., ELEC., PLUMB. ENGINEER:
CROMWELL ENGINEERS INC.

SUSTAINABLE CONSULTANT:
BNIM / ELEMENTS

GLOBAL VILLAGE CONSULTANT
CAMBRIDGE SEVEN ASSOCIATES

INTERIOR DESIGNER:
POLK STANLEY YEARY

GENERAL CONTRACTOR:
CDI CONTRACTORS, INC.

GENERAL NOTES:

NOTES:

ISSUE DATE:
100% GMP
PACKAGE #6
FEBRUARY 2, 2004

REVISIONS:

#	DATE	DESCRIPTION
1	01JUL04	PACKAGE 7

HEIFER INTERNATIONAL CENTER OFFICE BUILDING

LITTLE ROCK, ARKANSAS

PSY PROJECT NUMBER:
431C

CONTENTS:
BUILDING CROSS SECTION

SHEET NUMBER:

A304

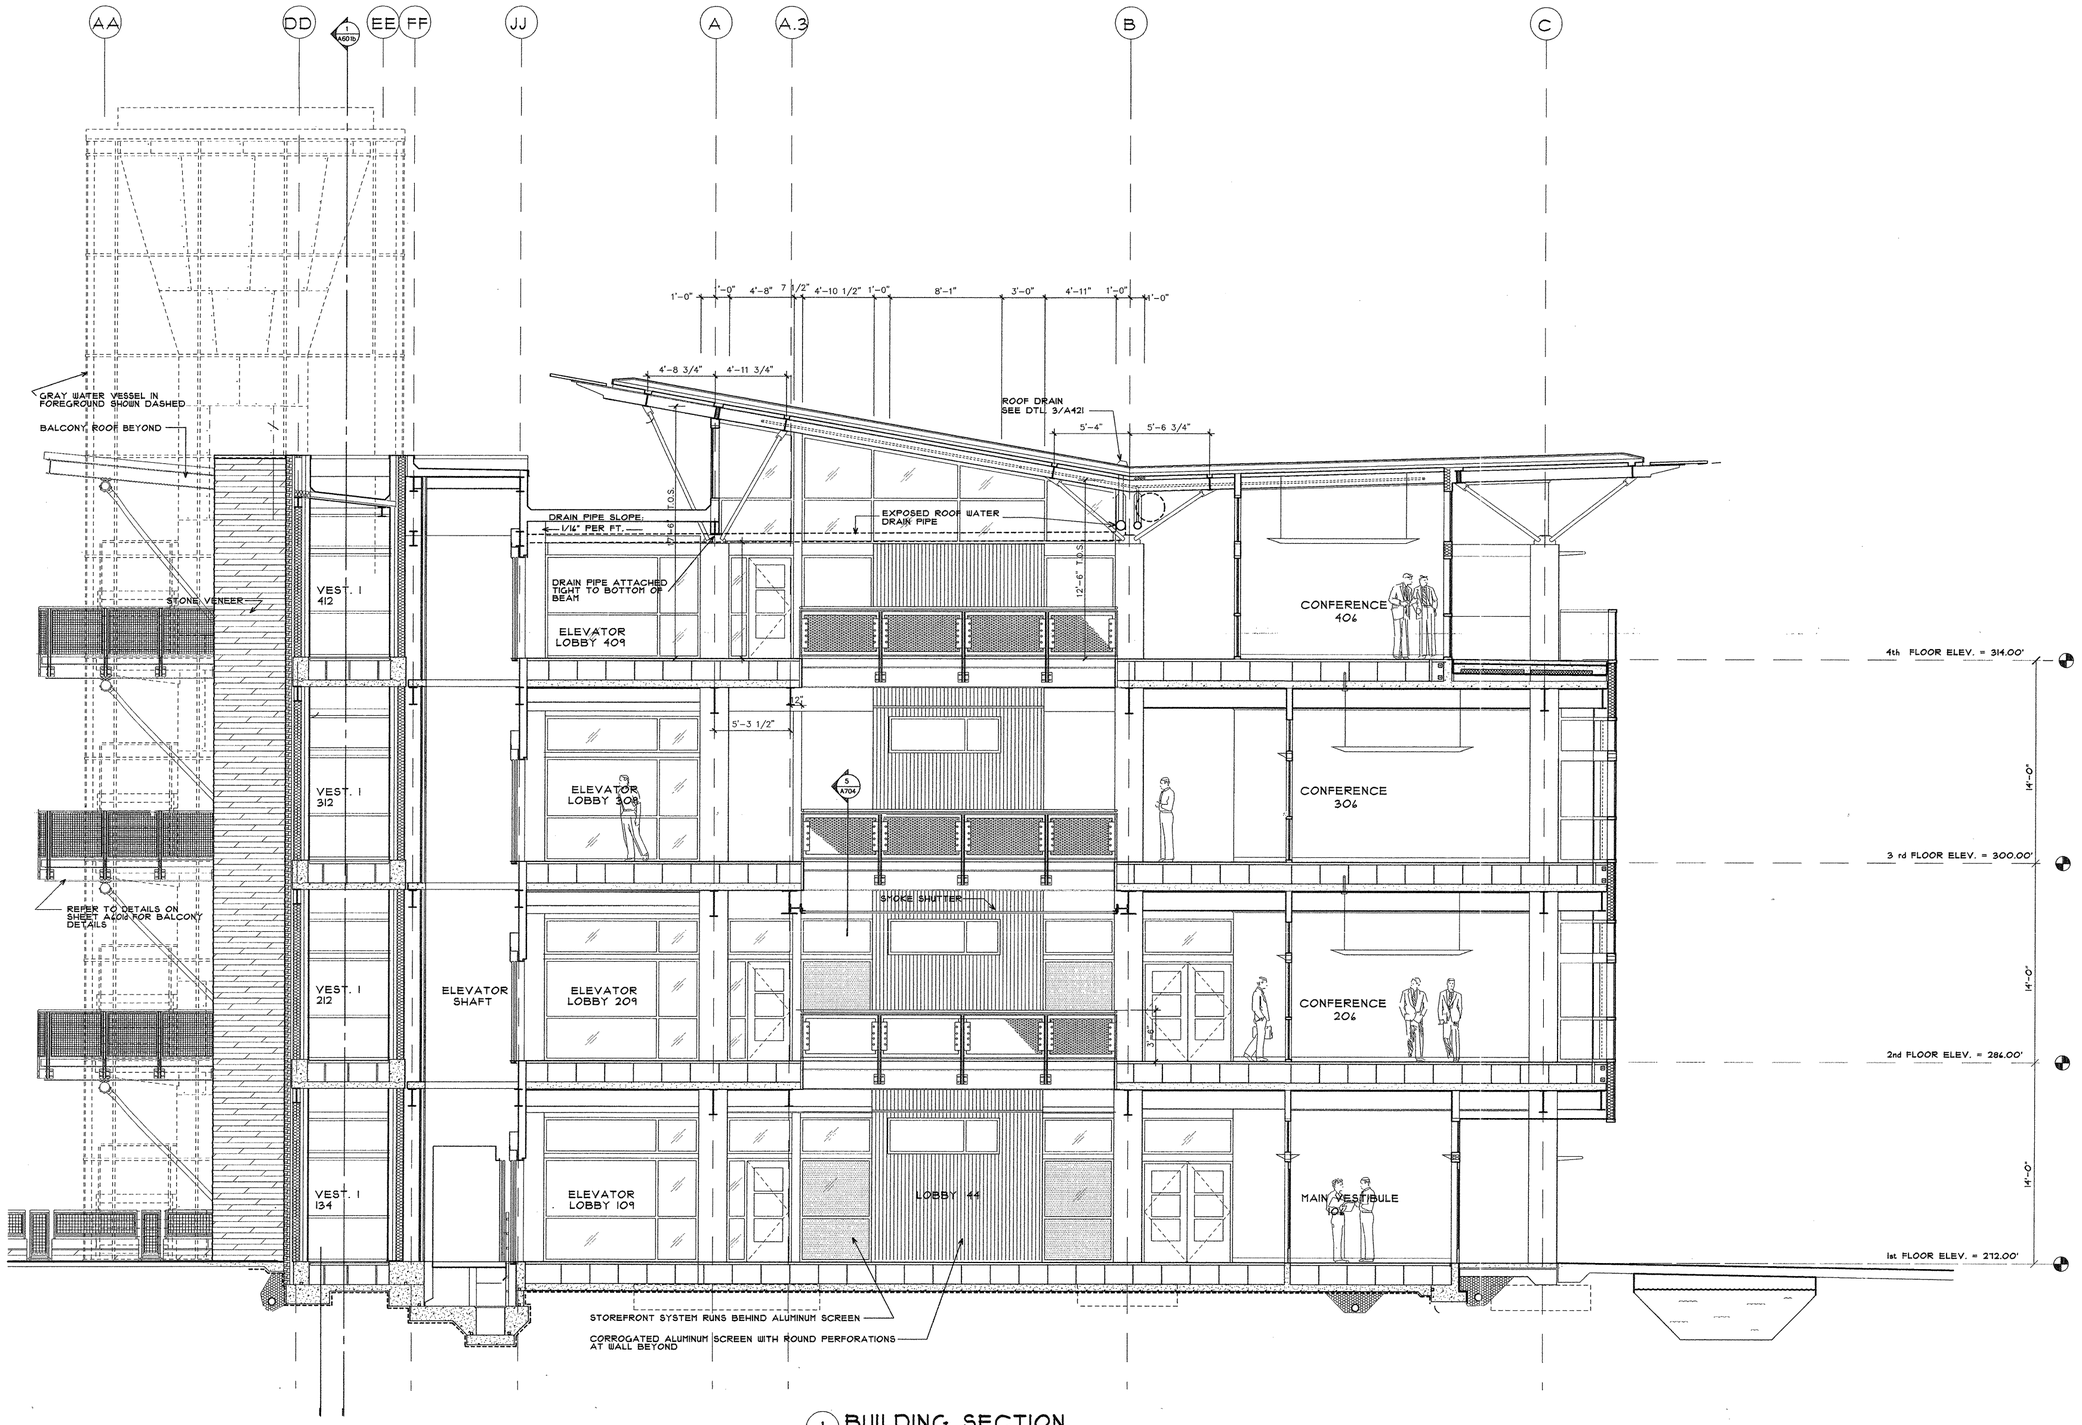

1 BUILDING SECTION
SCALE: 1/4" = 1'-0"

POLK STANLEY YEARY
ARCHITECTS, LTD.

700 SOUTH SCHILLER
LITTLE ROCK, AR 72201
501 378-0878
FAX 372-7629

21 W. MOUNTAIN, SUITE 227
FAYETTEVILLE, AR 72701
479-444-0473

CONSULTANTS:

OWNER'S PROJECT ADVISOR:
MOSES TUCKER REAL ESTATE, INC.

CIVIL ENGINEER:
McCLELLAND ENGINEERS

LANDSCAPE ARCHITECT:
LARSON BURNS SMITH

STRUCTURAL ENGINEER:
CROMWELL ENGINEERS INC.

MECH., ELEC., PLUMB. ENGINEER:
CROMWELL ENGINEERS INC.

SUSTAINABLE CONSULTANT:
BNIM / ELEMENTS

GLOBAL VILLAGE CONSULTANT
CAMBRIDGE SEVEN ASSOCIATES

INTERIOR DESIGNER:
POLK STANLEY YEARY

GENERAL CONTRACTOR:
CDI CONTRACTORS, INC.

GENERAL NOTES:

NOTES:

ISSUE DATE:
100% ROLL-UP
PACKAGE #7
JULY 1, 2004

REVISIONS:

#	DATE	DESCRIPTION
1	01JUL04	PACKAGE 7

HEIFER INTERNATIONAL CENTER OFFICE BUILDING

LITTLE ROCK, ARKANSAS

PSY PROJECT NUMBER:
431C

POLK STANLEY WILSON ARCHITECTS AND PLANNERS, INC. LITTLE ROCK, ARKANSAS

CONTENTS:
BUILDING CROSS SECTION

SHEET NUMBER:
A305

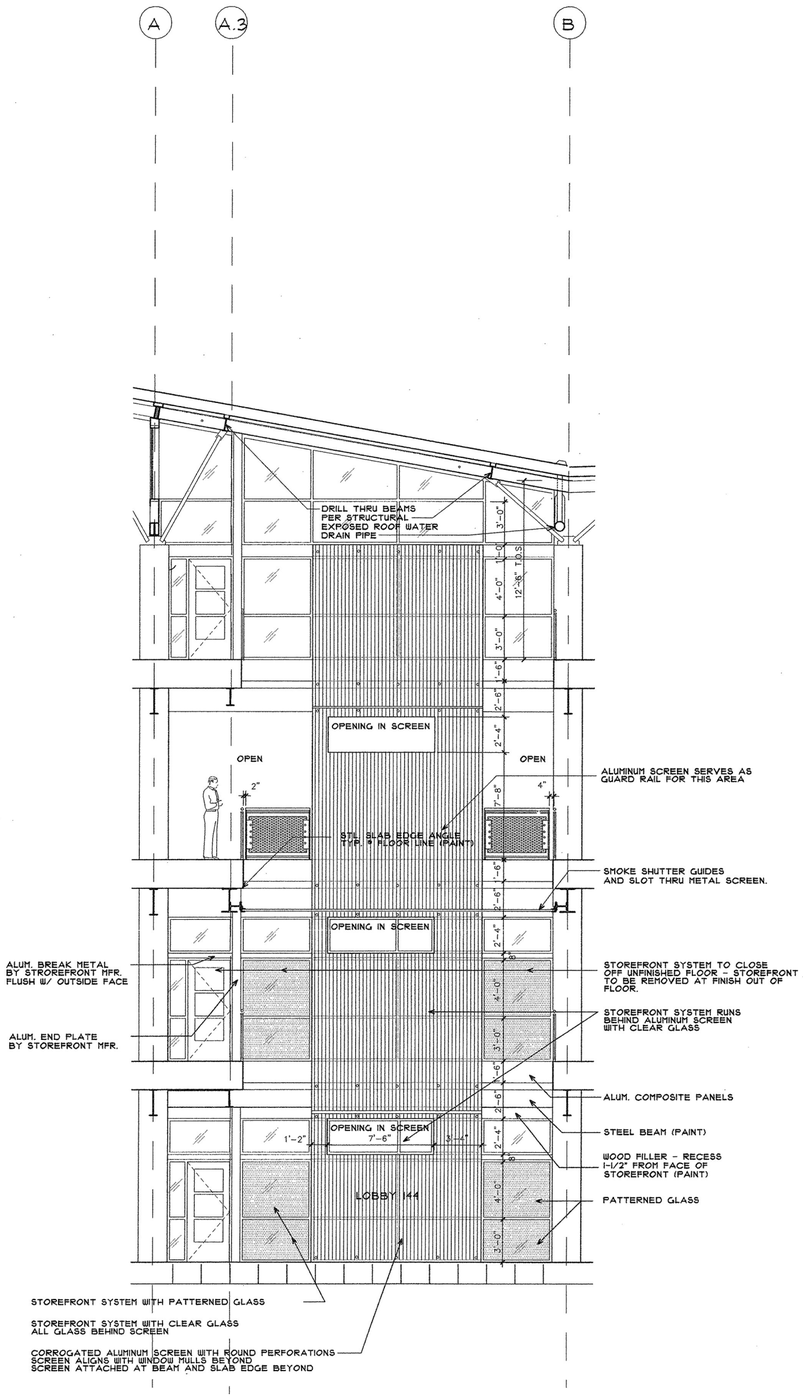

1 EAST LOBBY ELEVATION

SCALE: 1/4" = 1'-0"

POLK STANLEY YEARY
ARCHITECTS, LTD.

700 SOUTH SCHILLER
LITTLE ROCK, AR 72201
501 378-0878
FAX 372-7629

21 W. MOUNTAIN, SUITE 227
FAYETTEVILLE, AR 72701
479-444-0473

CONSULTANTS:

OWNER'S PROJECT ADVISOR:
MOSES TUCKER REAL ESTATE, INC.

CIVIL ENGINEER:
McCLELLAND ENGINEERS

LANDSCAPE ARCHITECT:
LARSON BURNS SMITH

STRUCTURAL ENGINEER:
CROMWELL ENGINEERS INC.

MECH., ELEC., PLUMB. ENGINEER:
CROMWELL ENGINEERS INC.

SUSTAINABLE CONSULTANT:
BNIM / ELEMENTS

GLOBAL VILLAGE CONSULTANT
CAMBRIDGE SEVEN ASSOCIATES

INTERIOR DESIGNER:
POLK STANLEY YEARY

GENERAL CONTRACTOR:
CDI CONTRACTORS, INC.

GENERAL NOTES:

NOTES:

ISSUE DATE:
100% ROLL-UP
PACKAGE #7
JULY 1, 2004

REVISIONS:

#	DATE	DESCRIPTION
1	01JUL04	PACKAGE 7

HEIFER INTERNATIONAL CENTER OFFICE BUILDING

LITTLE ROCK, ARKANSAS

PSY PROJECT NUMBER:
431C

CONTENTS:
BUILDING SECTIONS

SHEET NUMBER:
A306 1

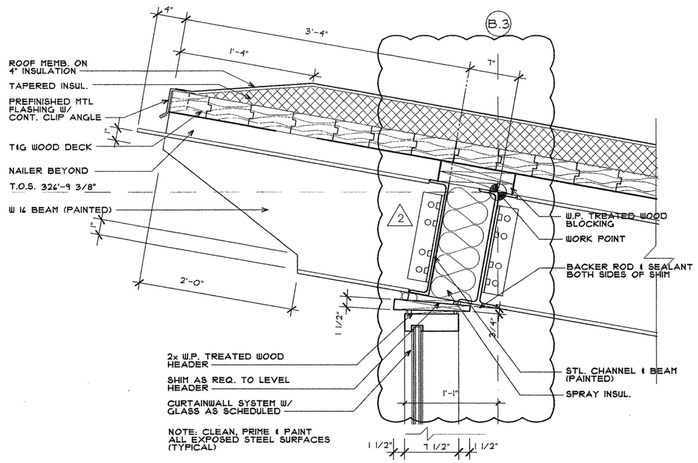

1 RAFTER TAIL DETAIL
SCALE: 1 1/2" = 1'-0"

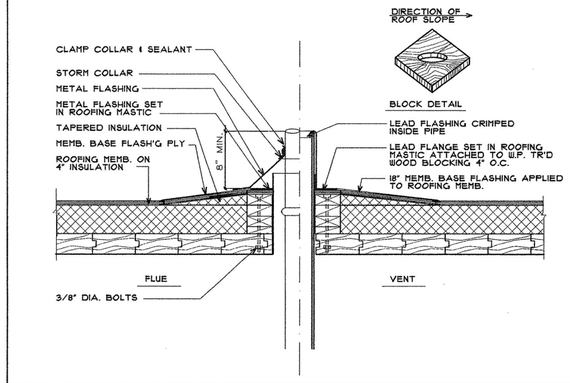

2 VENT/FLUE THRU ROOF DETAIL
SCALE: 1 1/2" = 1'-0"

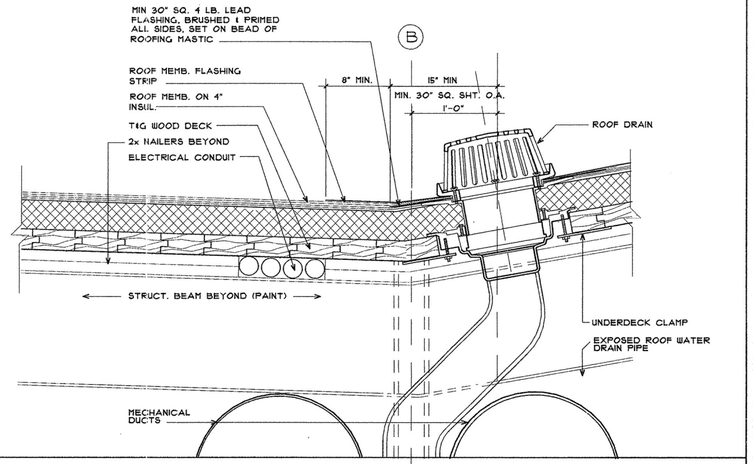

3 ROOF DRAIN DETAIL
SCALE: 1 1/2" = 1'-0"

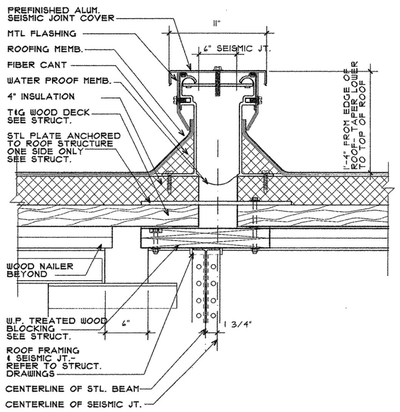

4 ROOF SEISMIC JT. COVER DTL
SCALE: 1 1/2" = 1'-0"

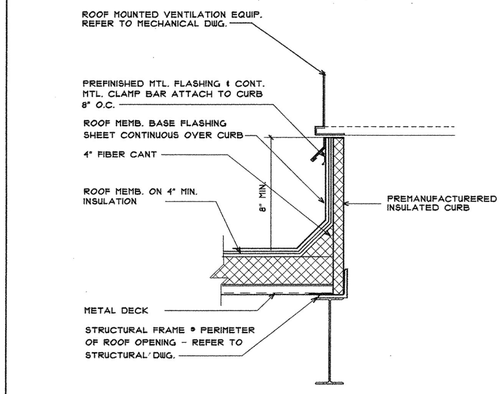

5 MECH. EQUIP. CURB DTL.
SCALE: 1 1/2" = 1'-0"

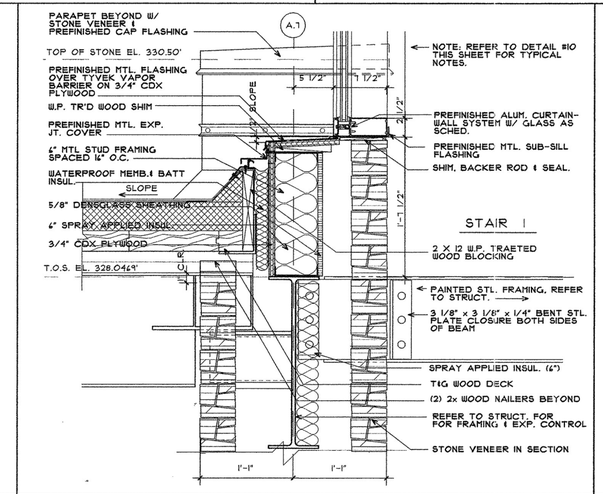

6 ROOF - WALL EXP. JT. DETAIL
SCALE: 1 1/2" = 1'-0"

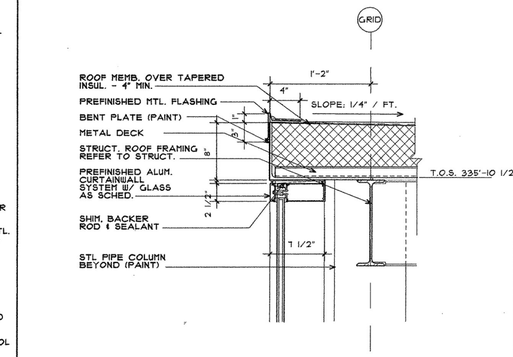

7 ROOF PARAPET DETAIL
SCALE: 1 1/2" = 1'-0"

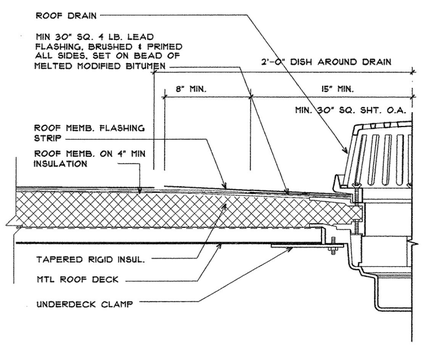

8 ROOF DRAIN DETAIL
SCALE: 1 1/2" = 1'-0"

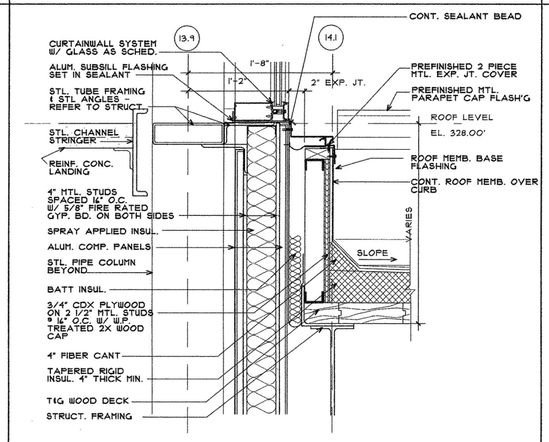

9 ROOF - WALL EXP. JT. DETAIL
SCALE: 1 1/2" = 1'-0"

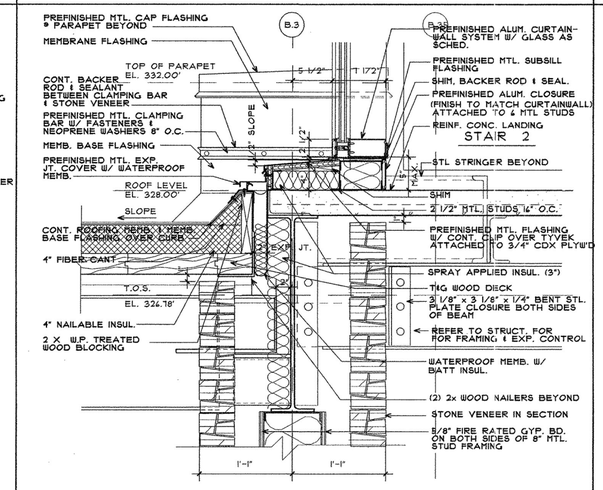

10 ROOF - WALL EXP. JT. DETAIL
SCALE: 1 1/2" = 1'-0"

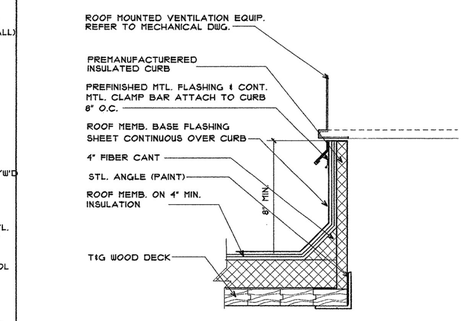

11 MECH. EQUIPMENT CURB DTL.
SCALE: 1 1/2" = 1'-0"

POLK STANLEY YEARY
ARCHITECTS, LTD.

700 SOUTH SCHILLER
LITTLE ROCK, AR 72201
501 378-0878
FAX 372-7629

21 W. MOUNTAIN, SUITE 227
FAYETTEVILLE, AR 72701
479-444-0473

CONSULTANTS:

OWNER'S PROJECT ADVISOR:
MOSES TUCKER REAL ESTATE, INC.

CIVIL ENGINEER:
McCLELLAND ENGINEERS

LANDSCAPE ARCHITECT:
LARSON BURNS SMITH

STRUCTURAL ENGINEER:
CROMWELL ENGINEERS INC.

MECH., ELEC., PLUMB. ENGINEER:
CROMWELL ENGINEERS INC.

SUSTAINABLE CONSULTANT:
BNIM / ELEMENTS

GLOBAL VILLAGE CONSULTANT
CAMBRIDGE SEVEN ASSOCIATES

INTERIOR DESIGNER:
POLK STANLEY YEARY

GENERAL CONTRACTOR:
CDI

GENERAL NOTES:

NOTES:

ISSUE DATE:
100% GMP
PACKAGE #6
FEBRUARY 2, 2004

REVISIONS:

#	DATE	DESCRIPTION
1	04JULY04	PACKAGE #7
2	01NOV04	ASI NO. 21

HEIFER INTERNATIONAL CENTER OFFICE BUILDING

LITTLE ROCK, ARKANSAS

PSY PROJECT NUMBER:
431C

CONTENTS:
ROOF DETAILS

SHEET NUMBER:
A421

P:\CD-DWG\V93\C4\FinalDrawingsForCD's\FinalA421-Roof Details 11/1/2004

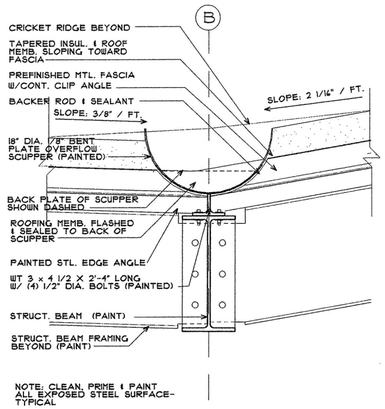

1 ROOF SCUPPER DETAIL
SCALE: 1 1/2" = 1'-0"

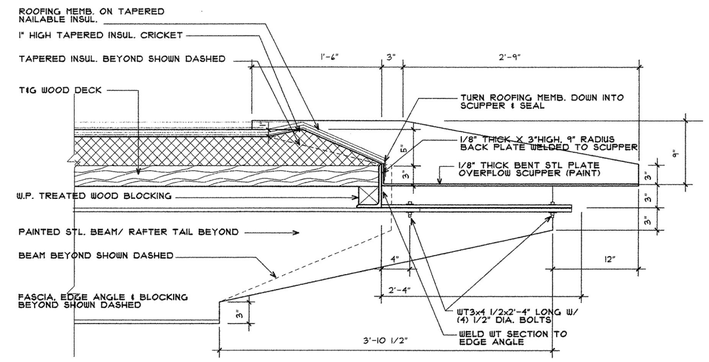

2 ROOF SCUPPER DETAIL
SCALE: 1 1/2" = 1'-0"

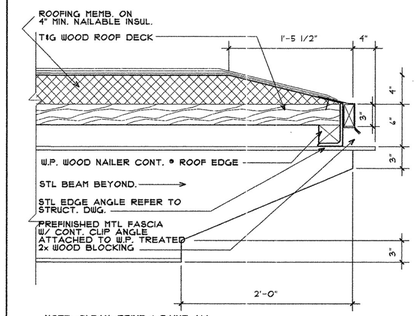

3 ROOF EDGE DETAIL
SCALE: 1 1/2" = 1'-0"

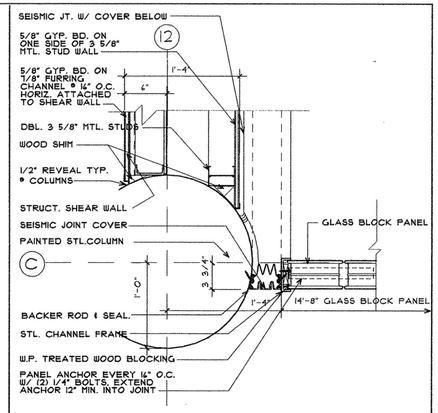

4 WALL SEISMIC JT. DTL.
SCALE: 1 1/2" = 1'-0"

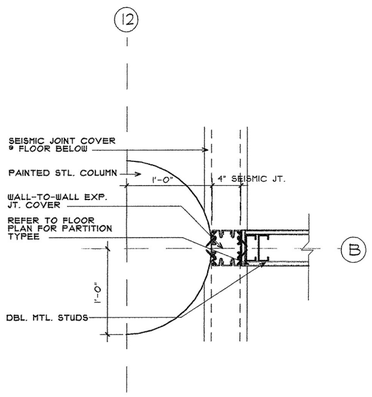

5 WALL SEISMIC JT. DTL.
SCALE: 1 1/2" = 1'-0"

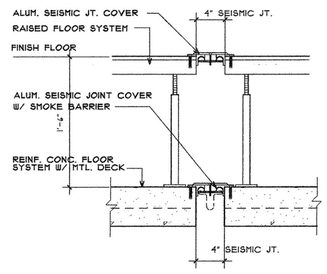

6 FLR. SEISMIC JT. DETAIL
SCALE: 1 1/2" = 1'-0"

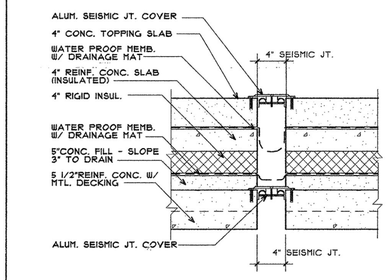

7 B'CONY SEISMIC JT. DTL.
SCALE: 1 1/2" = 1'-0"

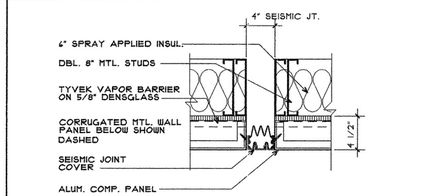

8 WALL SEISMIC JT. DTL.
SCALE: 1 1/2" = 1'-0"

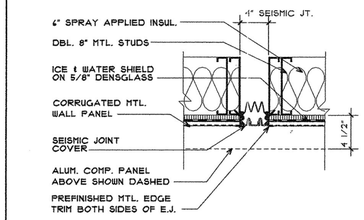

9 WALL SEISMIC JT. DTL.
SCALE: 1 1/2" = 1'-0"

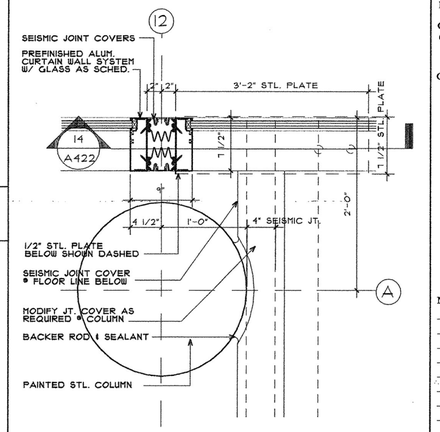

10 C'WALL SEISMIC JT. DTL.
SCALE: 1 1/2" = 1'-0"

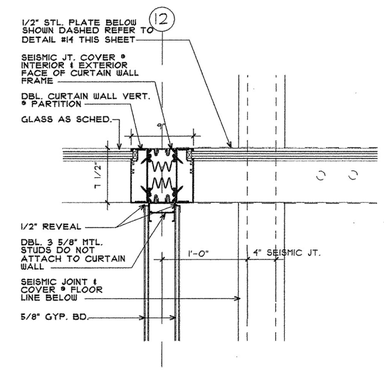

11 C'WALL SEISMIC JT. DTL.
SCALE: 1 1/2" = 1'-0"

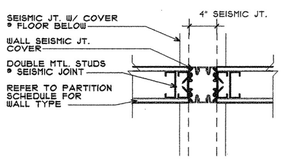

12 WALL SEISMIC JT. DTL.
SCALE: 1 1/2" = 1'-0"

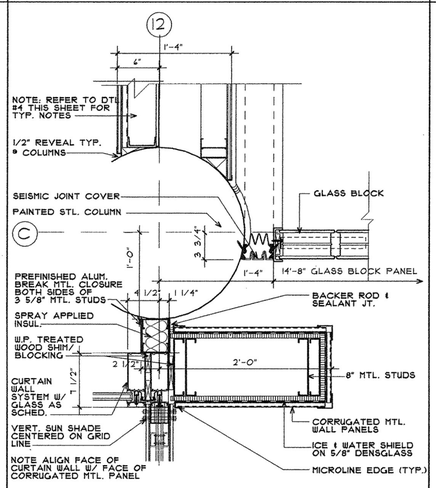

13 WALL SEISMIC JT. DTL.
SCALE: 1 1/2" = 1'-0"

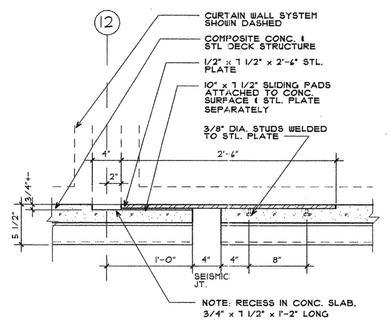

14 FL'R SEISMIC JT. DTL.
SCALE: 1 1/2" = 1'-0"

POLK STANLEY YEARY
ARCHITECTS, LTD.

700 SOUTH SCHILLER
LITTLE ROCK, AR 72201
501 378-0878
FAX 372-7629

21 W. MOUNTAIN, SUITE 227
FAYETTEVILLE, AR 72701
479-444-0473

CONSULTANTS:

OWNER'S PROJECT ADVISOR:
MOSES TUCKER REAL ESTATE, INC.

CIVIL ENGINEER:
McCLELLAND ENGINEERS

LANDSCAPE ARCHITECT:
LARSON BURNS SMITH

STRUCTURAL ENGINEER:
CROMWELL ENGINEERS INC.

MECH., ELEC., PLUMB. ENGINEER:
CROMWELL ENGINEERS INC.

SUSTAINABLE CONSULTANT:
BNIM / ELEMENTS

GLOBAL VILLAGE CONSULTANT
CAMBRIDGE SEVEN ASSOCIATES

INTERIOR DESIGNER:
POLK STANLEY YEARY

GENERAL CONTRACTOR:
CDI

GENERAL NOTES:

NOTES:

ISSUE DATE:
100% ROLL-UP
PACKAGE #7
JULY 1, 2004

REVISIONS:

#	DATE	DESCRIPTION
1	01JUL04	PACKAGE 7

HEIFER INTERNATIONAL CENTER OFFICE BUILDING

LITTLE ROCK, ARKANSAS

PSY PROJECT NUMBER:
431C

CONTENTS:
SEISMIC JOINT & ROOF DETAILS

SHEET NUMBER:
A422 1

P:\0-DWG\431C\CD\FinalDrawingFor\CDs\Final\A422-Exp. Jt. Roof 08feb2004

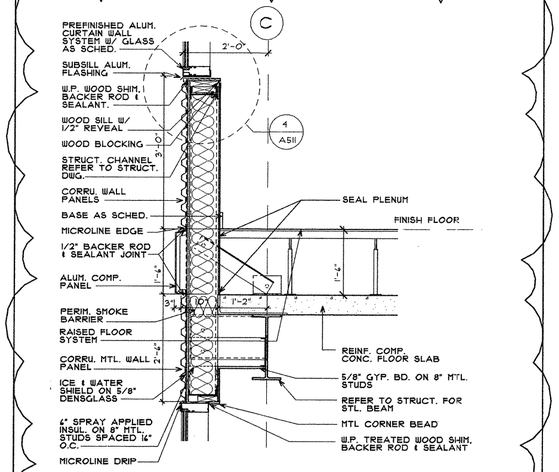

3 SECTION DETAIL
SCALE: 3/4" = 1'-0"

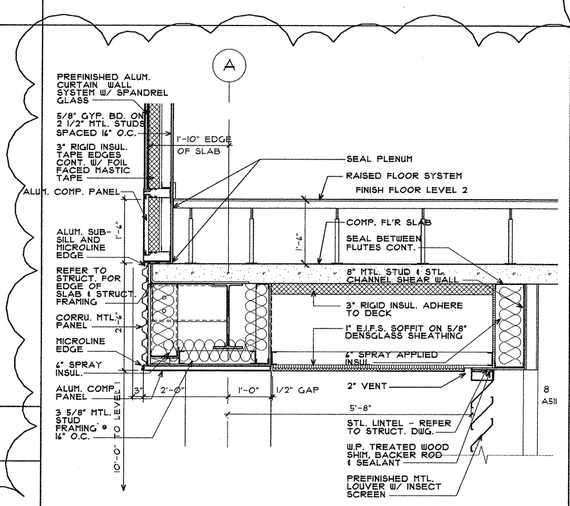

6 SECTION DETAIL
SCALE: 3/4" = 1'-0"

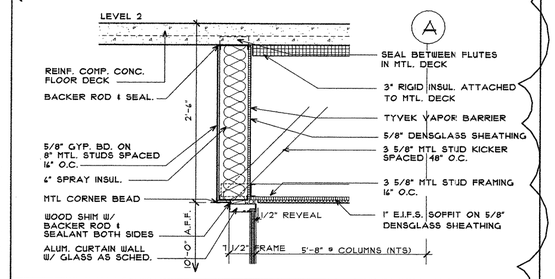

7 SECTION DETAIL
SCALE: 3/4" = 1'-0"

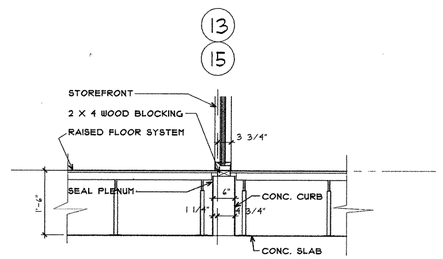

8 SECTION DETAIL
SCALE: 3/4" = 1'-0"

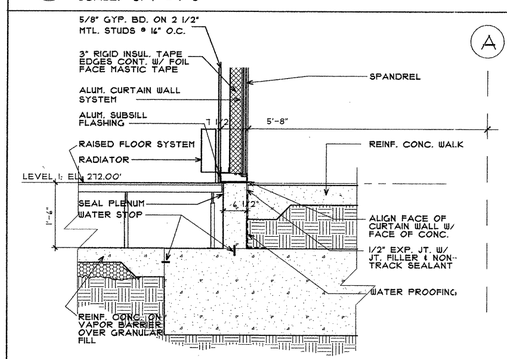

11 SECTION DETAIL
SCALE: 3/4" = 1'-0"

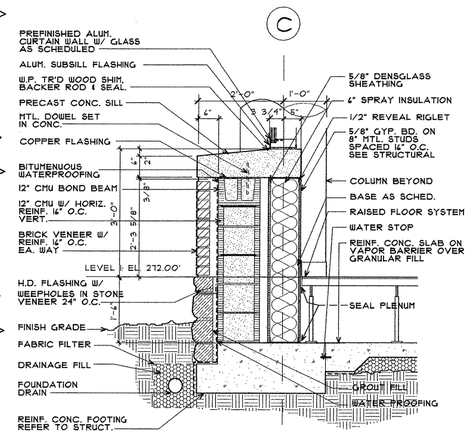

9 SECTION DETAIL
SCALE: 3/4" = 1'-0"

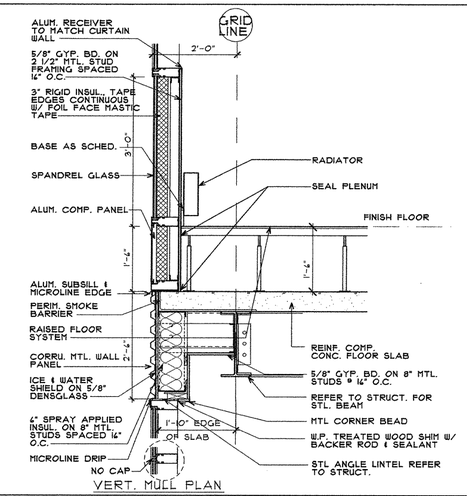

10 SECTION DETAIL
SCALE: 3/4" = 1'-0"

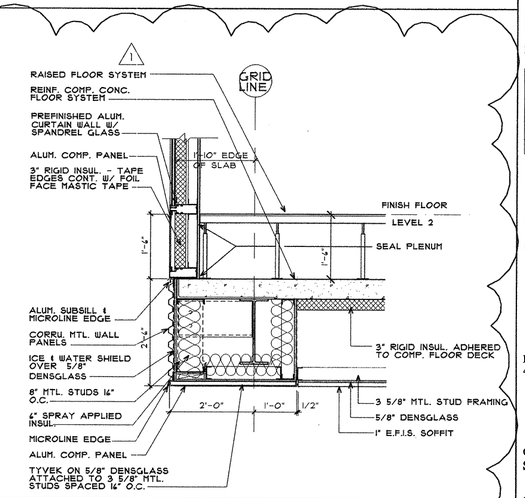

13 SECTION DETAIL
SCALE: 3/4" = 1'-0"

POLK
STANLEY
YEARY
ARCHITECTS, LTD.

700 SOUTH SCHILLER
LITTLE ROCK, AR 72201
501 378-0878
FAX 372-7629

21 W. MOUNTAIN, SUITE 227
FAYETTEVILLE, AR 72701
479-444-0473

CONSULTANTS:

OWNER'S PROJECT ADVISOR:
MOSES TUCKER REAL ESTATE, INC.

CIVIL ENGINEER:
McCLELLAND ENGINEERS

LANDSCAPE ARCHITECT:
LARSON BURNS SMITH

STRUCTURAL ENGINEER:
CROMWELL ENGINEERS INC.

MECH., ELEC., PLUMB. ENGINEER:
CROMWELL ENGINEERS INC.

SUSTAINABLE CONSULTANT:
BNIM / ELEMENTS

GLOBAL VILLAGE CONSULTANT
CAMBRIDGE SEVEN ASSOCIATES

INTERIOR DESIGNER:
POLK STANLEY YEARY

GENERAL CONTRACTOR:
CDI

GENERAL NOTES:

NOTES:

ISSUE DATE:
100% GMP
PACKAGE #6
FEBRUARY 2, 2004

REVISIONS:

#	DATE	DESCRIPTION
1	01 JULY 04	PACKAGE #1

HEIFER INTERNATIONAL CENTER OFFICE BUILDING

LITTLE ROCK, ARKANSAS

PSY PROJECT NUMBER:
431C

CONTENTS: L
SECTION DETAILS

SHEET NUMBER:

A430

P:\CD-DWG\430\Cad\Plotting\Dwg\PolkCDs\Pack\A430-SectionDetails Wednesday, June 30, 2004 1:48 PM

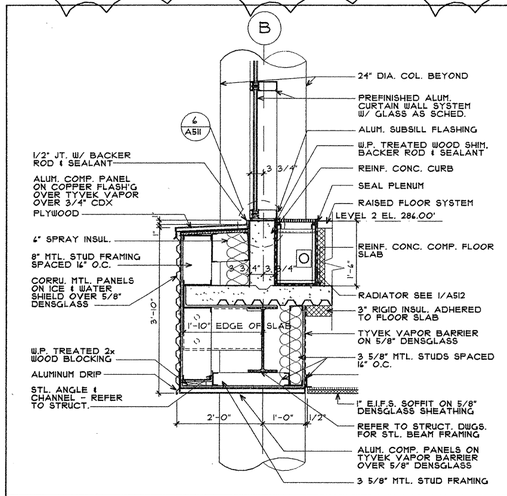

1 SECTION DETAIL
SCALE: 3/4" = 1'-0"

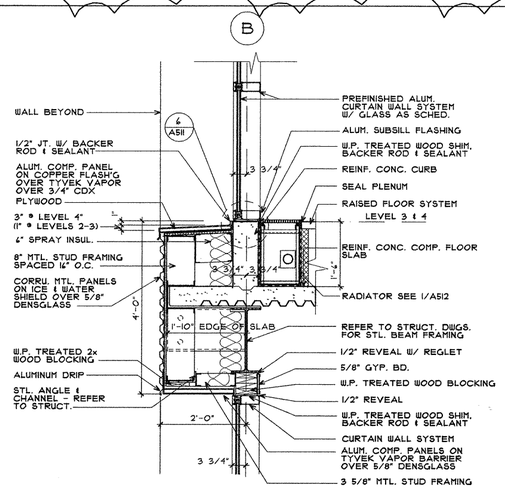

2 SECTION DETAIL
SCALE: 3/4" = 1'-0"

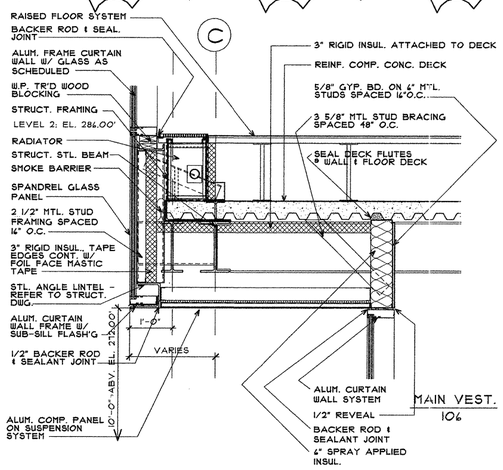

9 SECTION DETAIL
SCALE: 3/4" = 1'-0"

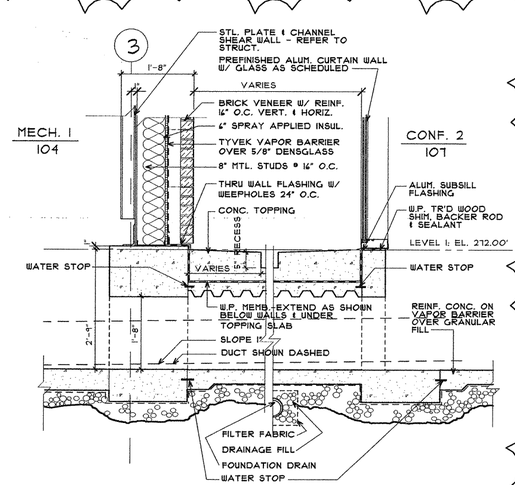

10 SECTION DETAIL
SCALE: 3/4" = 1'-0"

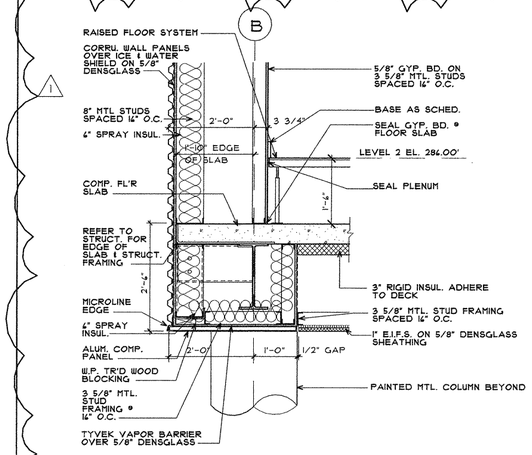

12 SECTION DETAIL
SCALE: 3/4" = 1'-0"

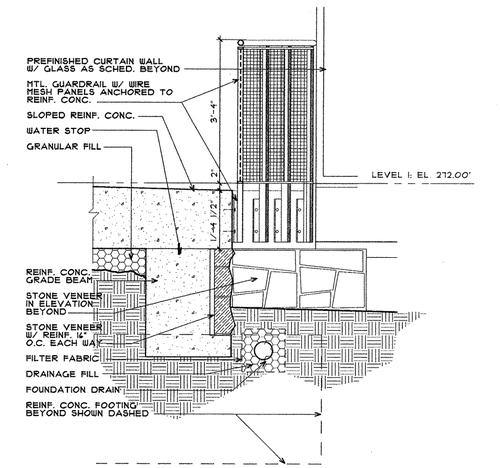

13 SECTION DETAIL
SCALE: 3/4" = 1'-0"

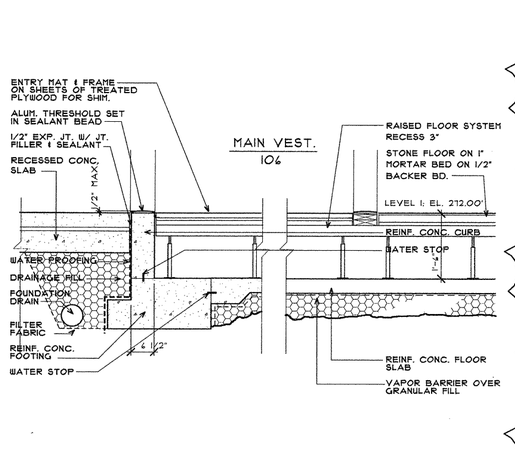

14 SECTION DETAIL
SCALE: 3/4" = 1'-0"

POLK
STANLEY
YEARY
ARCHITECTS, LTD.

700 SOUTH SCHILLER
LITTLE ROCK, AR 72201
501 378-0878
FAX 372-7629

21 W. MOUNTAIN, SUITE 227
FAYETTEVILLE, AR 72701
479-444-0473

CONSULTANTS:

OWNER'S PROJECT ADVISOR:
MOSES TUCKER REAL ESTATE, INC.

CIVIL ENGINEER:
McCLELLAND ENGINEERS

LANDSCAPE ARCHITECT:
LARSON BURNS SMITH

STRUCTURAL ENGINEER:
CROMWELL ENGINEERS INC.

MECH., ELEC., PLUMB. ENGINEER:
CROMWELL ENGINEERS INC.

SUSTAINABLE CONSULTANT:
BNIM / ELEMENTS

GLOBAL VILLAGE CONSULTANT
CAMBRIDGE SEVEN ASSOCIATES

INTERIOR DESIGNER:
POLK STANLEY YEARY

GENERAL CONTRACTOR:
CDI

GENERAL NOTES:

NOTES:

ISSUE DATE:
100% GMP
PACKAGE #6
FEBRUARY 2, 2004

REVISIONS:

#	DATE	DESCRIPTION
1	01JUL04	PACKAGE 7

HEIFER INTERNATIONAL CENTER OFFICE BUILDING

LITTLE ROCK, ARKANSAS

PSY PROJECT NUMBER:
431C

CONTENTS:
SECTION DETAILS

SHEET NUMBER:
A431

P:\0-DWG\1-WC\CD\Permit Drawings\Permit CD's\Full\A431-Section Details Wednesday, June 30, 2004 2:21 PM

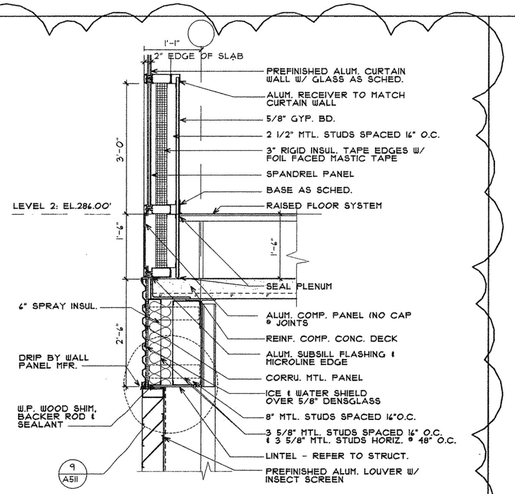

1 WALL SECTION DETAIL
SCALE: 3/4" = 1'-0"

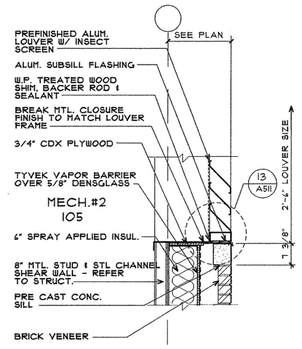

6 WALL SECTION DETAIL
SCALE: 3/4" = 1'-0"

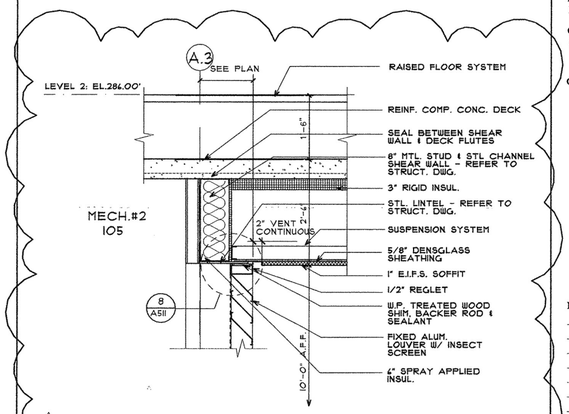

8 WALL SECTION DETAIL
SCALE: 3/4" = 1'-0"

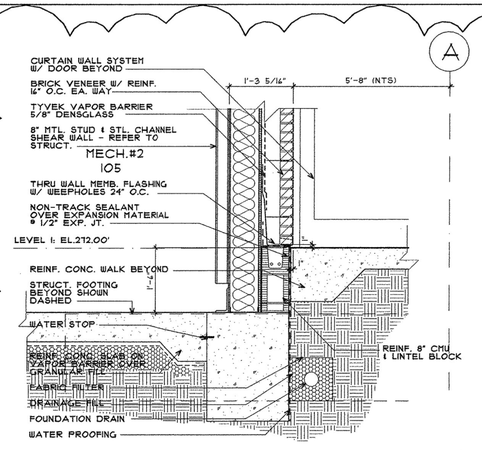

11 WALL SECTION DETAIL
SCALE: 3/4" = 1'-0"

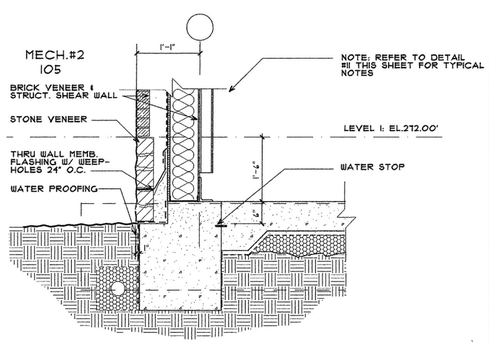

12 WALL SECTION DETAIL
SCALE: 3/4" = 1'-0"

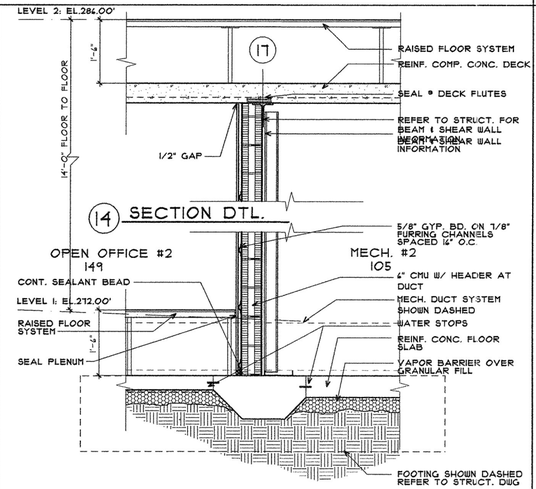

13 & 14 WALL SECTION DETAIL
SCALE: 3/4" = 1'-0"

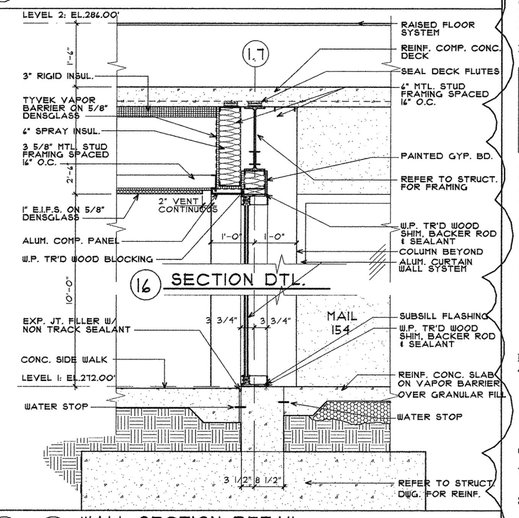

15 & 16 WALL SECTION DETAIL
SCALE: 3/4" = 1'-0"

POLK
STANLEY
YEARY
ARCHITECTS, LTD.

700 SOUTH SCHILLER
LITTLE ROCK, AR 72201
501 378-0878
FAX 372-7629

21 W. MOUNTAIN, SUITE 227
FAYETTEVILLE, AR 72701
479-444-0473

CONSULTANTS:

OWNER'S PROJECT ADVISOR:
MOSES TUCKER REAL ESTATE, INC.

CIVIL ENGINEER:
McCLELLAND ENGINEERS

LANDSCAPE ARCHITECT:
LARSON BURNS SMITH

STRUCTURAL ENGINEER:
CROMWELL ENGINEERS INC.

MECH., ELEC., PLUMB. ENGINEER:
CROMWELL ENGINEERS INC.

SUSTAINABLE CONSULTANT:
BNIM / ELEMENTS

GLOBAL VILLAGE CONSULTANT
CAMBRIDGE SEVEN ASSOCIATES

INTERIOR DESIGNER:
POLK STANLEY YEARY

GENERAL CONTRACTOR:
CDI

GENERAL NOTES:

NOTES:

ISSUE DATE:
CONSTRUCTION DOCUMENTS
PACKAGE #5
DECEMBER 15, 2003

REVISIONS:

#	DATE	DESCRIPTION
1	01/31/04	PACKAGE 1

HEIFER INTERNATIONAL CENTER OFFICE BUILDING

LITTLE ROCK, ARKANSAS

PSY PROJECT NUMBER:
431C

CONTENTS:
WALL SECTION DETAILS

SHEET NUMBER:
A432

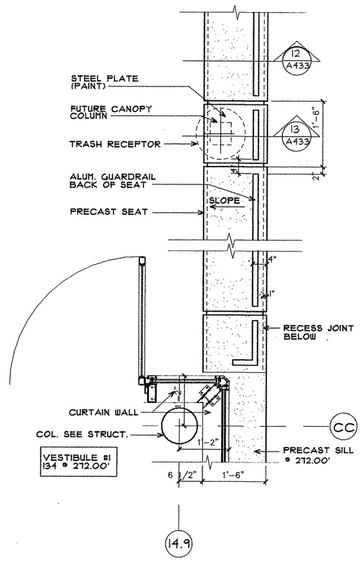

8 PLAN @ NORTH LANDGRIDGE
SCALE: 3/4" = 1'-0"

NORTH

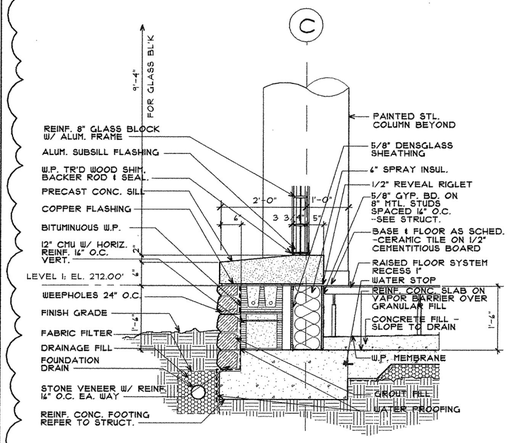

11 FOUNDATION DETAIL @ MEN 110
SCALE: 3/4" = 1'-0"

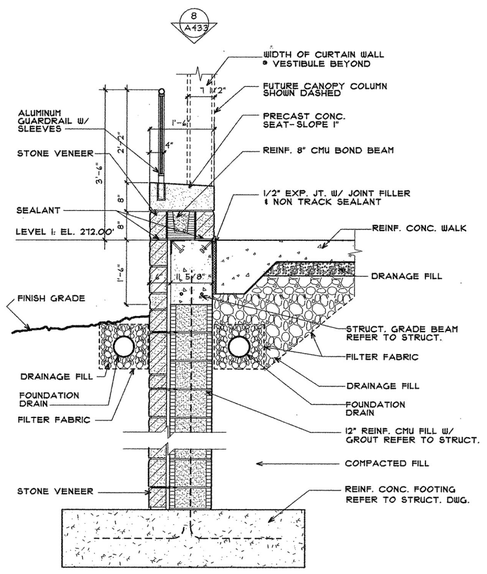

12 SECTION "A" @ NORTH LAND BRIDGE
SCALE: 3/4" = 1'-0"

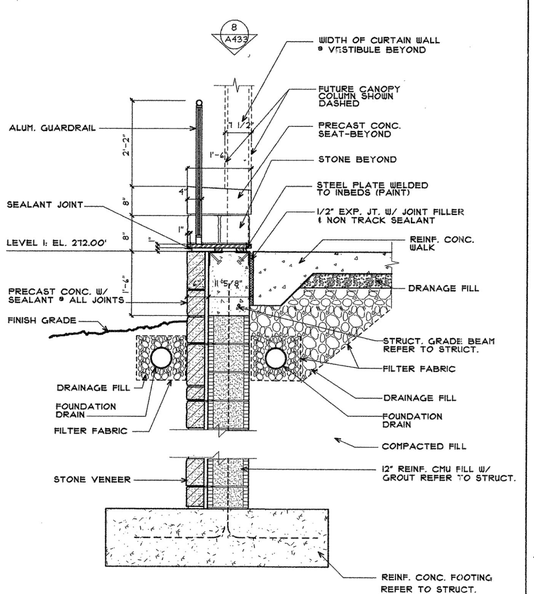

13 SECTION "B" @ NORTH LAND BRIDGE
SCALE: 3/4" = 1'-0"

POLK
STANLEY
YEARY
ARCHITECTS, LTD.

700 SOUTH SCHILLER
LITTLE ROCK, AR 72201
501 378-0878
FAX 372-7629

21 W. MOUNTAIN, SUITE 227
FAYETTEVILLE, AR 72701
479-444-0473

CONSULTANTS:

OWNER'S PROJECT ADVISOR:
MOSES TUCKER REAL ESTATE, INC.

CIVIL ENGINEER:
McCLELLAND ENGINEERS

LANDSCAPE ARCHITECT:
LARSON BURNS SMITH

STRUCTURAL ENGINEER:
CROMWELL ENGINEERS INC.

MECH., ELEC., PLUMB. ENGINEER:
CROMWELL ENGINEERS INC.

SUSTAINABLE CONSULTANT:
BNIM / ELEMENTS

GLOBAL VILLAGE CONSULTANT
CAMBRIDGE SEVEN ASSOCIATES

INTERIOR DESIGNER:
POLK STANLEY YEARY

GENERAL CONTRACTOR:
CDI

GENERAL NOTES:

NOTES:

ISSUE DATE:
CONSTRUCTION DOCUMENTS
PACKAGE #5
DECEMBER 15, 2003

REVISIONS:

#	DATE	DESCRIPTION
1	01JUL04	PACKAGE 1

HEIFER INTERNATIONAL CENTER OFFICE BUILDING

LITTLE ROCK, ARKANSAS

PSY PROJECT NUMBER:
431C

CONTENTS:
SECTIONS & PLAN @ NORTH LAND BRIDGE

SHEET NUMBER:
A433

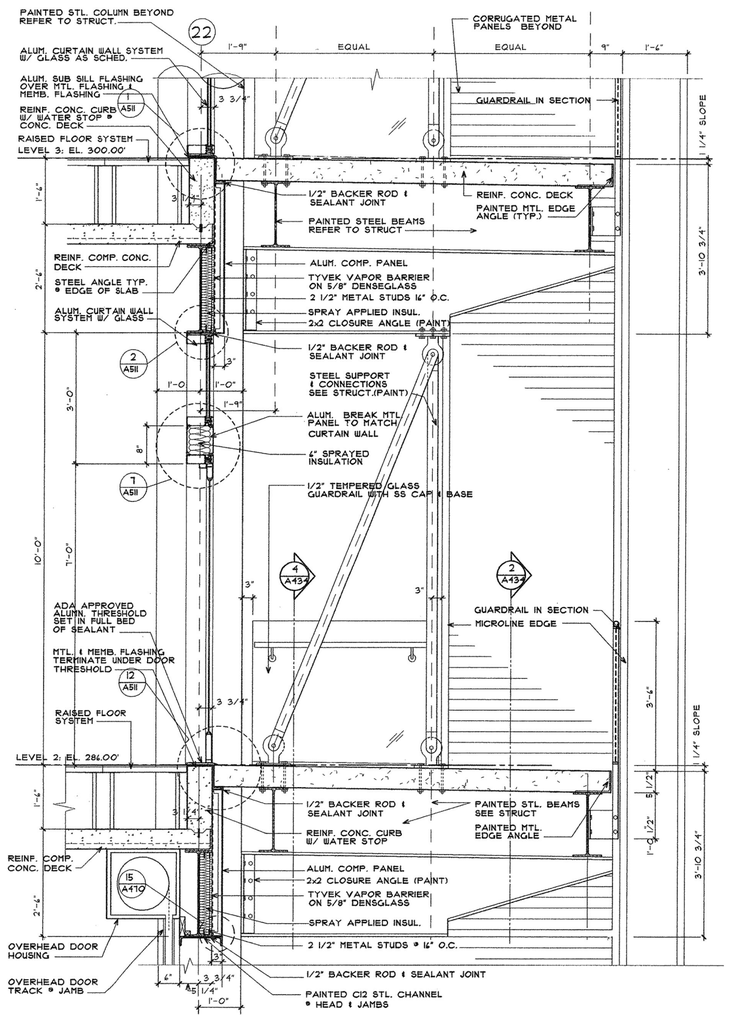

6 WALL SECTION DETAIL
SCALE: 3/4" = 1'-0"

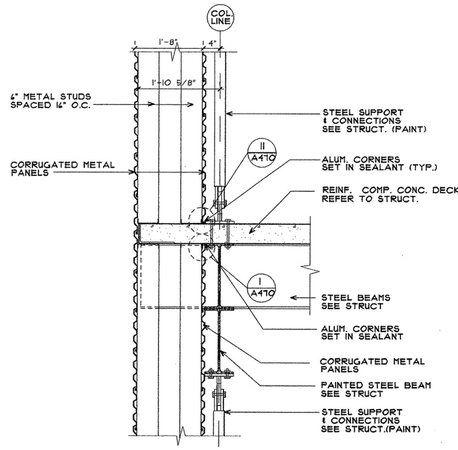

2 WALL SECTION DETAIL
SCALE: 3/4" = 1'-0"

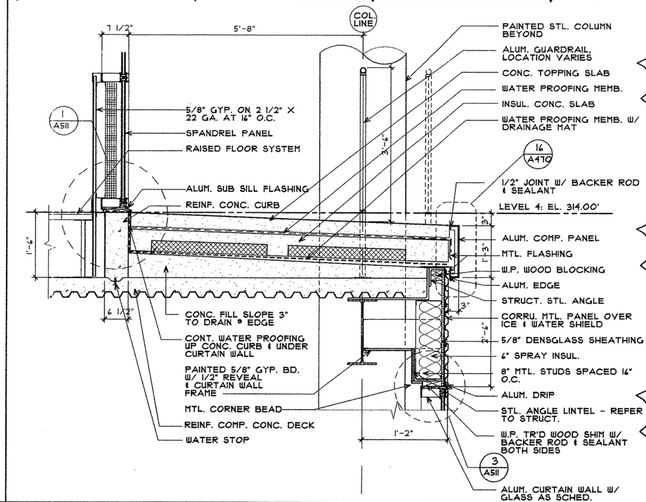

3 WALL SECTION DETAIL
SCALE: 3/4" = 1'-0"

4 WALL SECTION DETAIL
SCALE: 3/4" = 1'-0"

8 WALL SECTION DETAIL
SCALE: 3/4" = 1'-0"

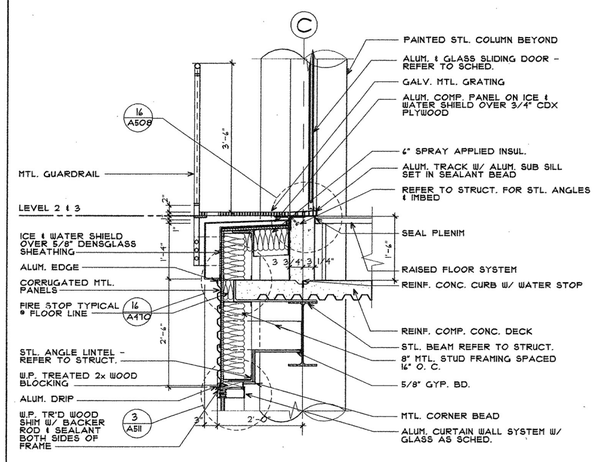

9 WALL SECTION DETAIL
SCALE: 3/4" = 1'-0"

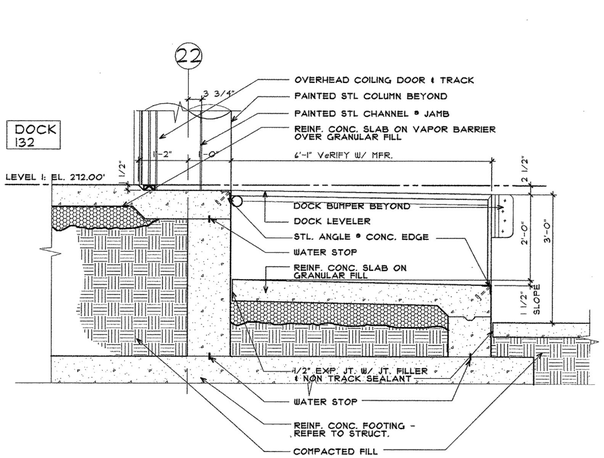

11 WALL SECTION DETAIL
SCALE: 3/4" = 1'-0"

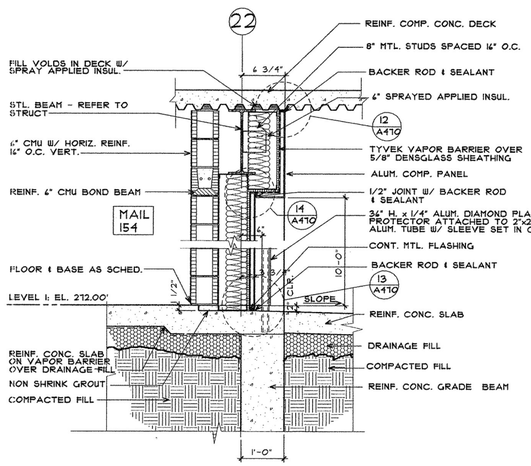

12 WALL SECTION DETAIL
SCALE: 3/4" = 1'-0"

POLK STANLEY YEARY
ARCHITECTS, LTD.

700 SOUTH SCHILLER
LITTLE ROCK, AR 72201
501 378-0878
FAX 372-7629

21 W. MOUNTAIN, SUITE 227
FAYETTEVILLE, AR 72701
479-444-0473

CONSULTANTS:

OWNER'S PROJECT ADVISOR:
MOSES TUCKER REAL ESTATE, INC.

CIVIL ENGINEER:
McCLELLAND ENGINEERS

LANDSCAPE ARCHITECT:
LARSON BURNS SMITH

STRUCTURAL ENGINEER:
CROMWELL ENGINEERS INC.

MECH., ELEC., PLUMB. ENGINEER:
CROMWELL ENGINEERS INC.

SUSTAINABLE CONSULTANT:
BNIM / ELEMENTS

GLOBAL VILLAGE CONSULTANT
CAMBRIDGE SEVEN ASSOCIATES

INTERIOR DESIGNER:
POLK STANLEY YEARY

GENERAL CONTRACTOR:
CDI

GENERAL NOTES:

NOTES:

ISSUE DATE:
100% GMP
PACKAGE #6
FEBRUARY 2, 2004

REVISIONS:

#	DATE	DESCRIPTION
1	01 JULY 04	PACKAGE 01

HEIFER INTERNATIONAL CENTER OFFICE BUILDING

LITTLE ROCK, ARKANSAS

PSY PROJECT NUMBER:
431C

CONTENTS:
WALL SECTION DETAILS

SHEET NUMBER:
A434

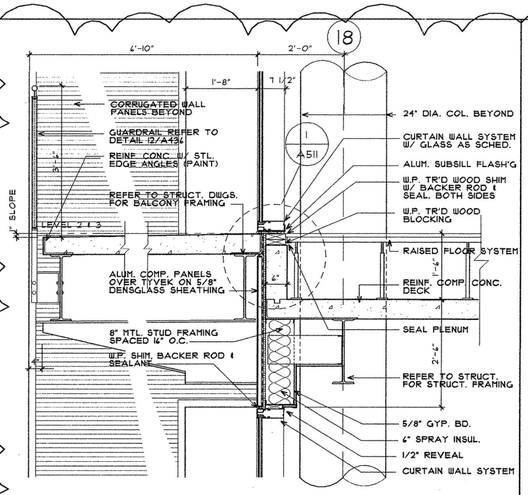

1 SECTION @ BALCONY
SCALE: 3/4" = 1'-0"

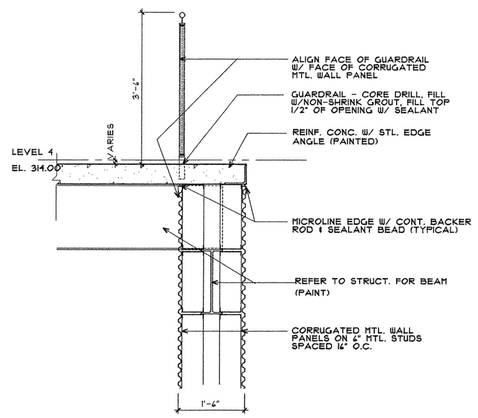

2 SECTION @ BALCONY
SCALE: 3/4" = 1'-0"

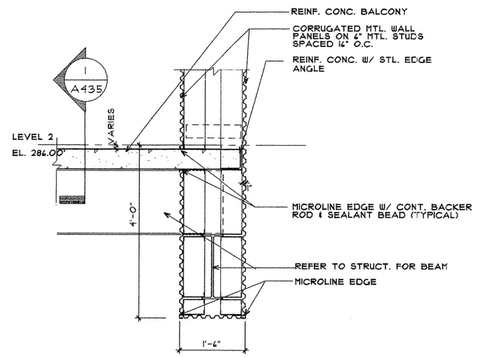

3 SECTION @ BALCONY
SCALE: 3/4" = 1'-0"

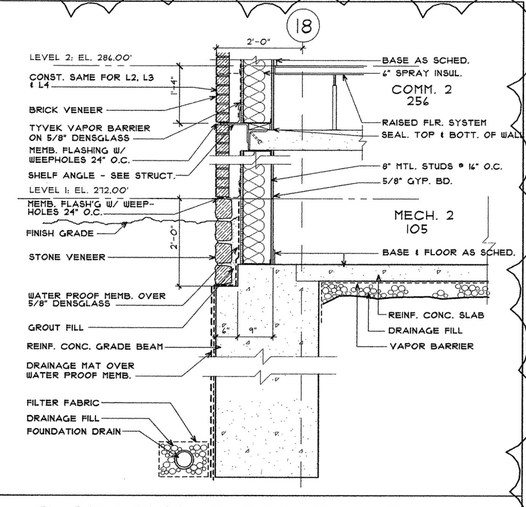

4 SECTION @ FOUNDATION
SCALE: 3/4" = 1'-0"

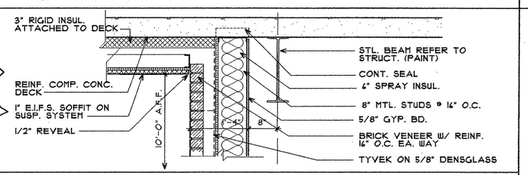

6 SECTION @ SOFFIT
SCALE: 3/4" = 1'-0"

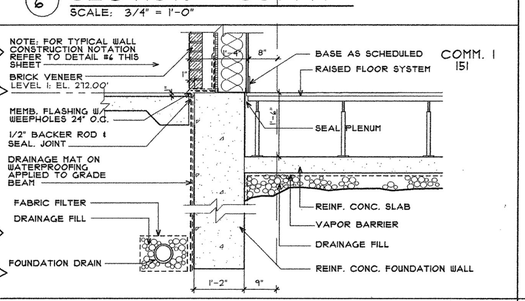

7 SECTION @ WALK
SCALE: 3/4" = 1'-0"

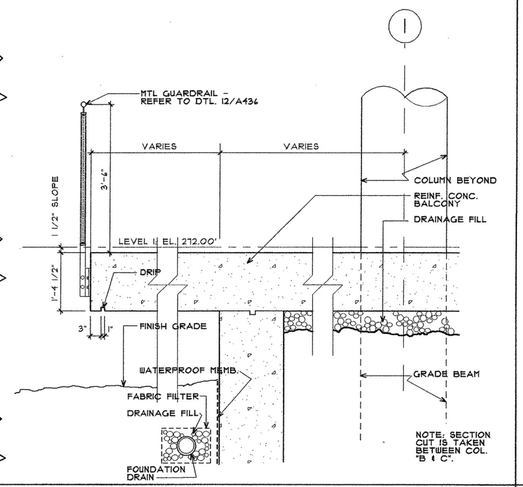

11 SECTION @ WEST DECK
SCALE: 3/4" = 1'-0"

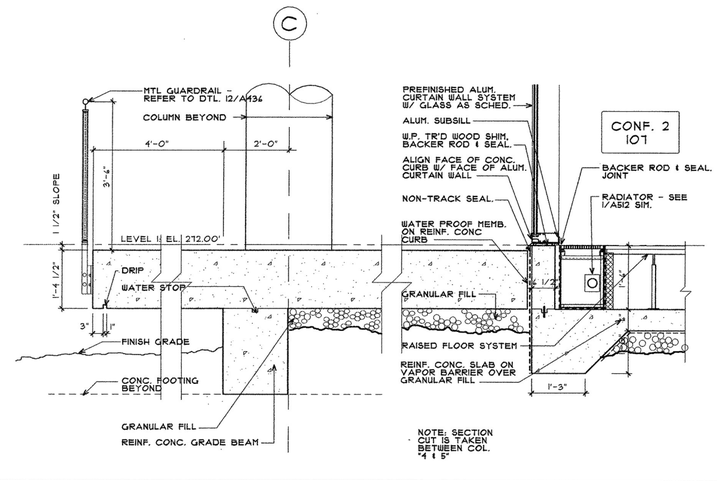

12 & 13 SECT. @ SOUTH FOUNDATION
SCALE: 3/4" = 1'-0"

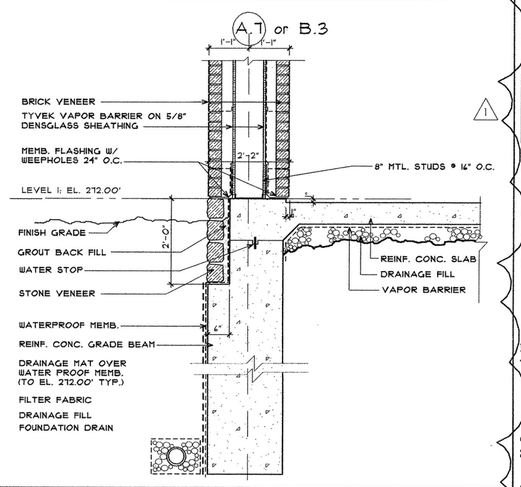

14 SECTION @ FOUNDATION
SCALE: 3/4" = 1'-0"

POLK STANLEY YEARY
ARCHITECTS, LTD.

700 SOUTH SCHILLER
LITTLE ROCK, AR 72201
501 378-0878
FAX 372-7629

21 W. MOUNTAIN, SUITE 227
FAYETTEVILLE, AR 72701
479-444-0473

CONSULTANTS:

OWNER'S PROJECT ADVISOR:
MOSES TUCKER REAL ESTATE, INC.

CIVIL ENGINEER:
McCLELLAND ENGINEERS

LANDSCAPE ARCHITECT:
LARSON BURNS SMITH

STRUCTURAL ENGINEER:
CROMWELL ENGINEERS INC.

MECH., ELEC., PLUMB. ENGINEER:
CROMWELL ENGINEERS INC.

SUSTAINABLE CONSULTANT:
BNIM / ELEMENTS

GLOBAL VILLAGE CONSULTANT
CAMBRIDGE SEVEN ASSOCIATES

INTERIOR DESIGNER:
POLK STANLEY YEARY

GENERAL CONTRACTOR:
CDI

GENERAL NOTES:

NOTES:

ISSUE DATE:
100% GMP
PACKAGE #6
FEBRUARY 2, 2004

REVISIONS:

#	DATE	DESCRIPTION
1	04JUL04	PACKAGE 07

HEIFER INTERNATIONAL CENTER OFFICE BUILDING
LITTLE ROCK, ARKANSAS

PSY PROJECT NUMBER:
431C

CONTENTS:
SECTION DETAILS

SHEET NUMBER:
A435

R:\CDI\HEIFER\431C\Cd\Final\Drawings\CD15\Arch\A435 Section Details.DGS 7/1/2004

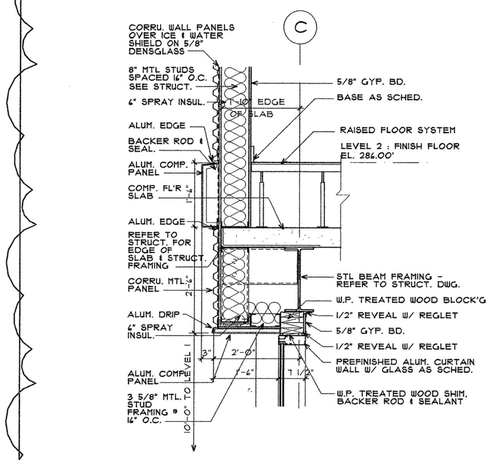

6 SECTION @ FLOORLINE
SCALE: 3/4" = 1'-0"

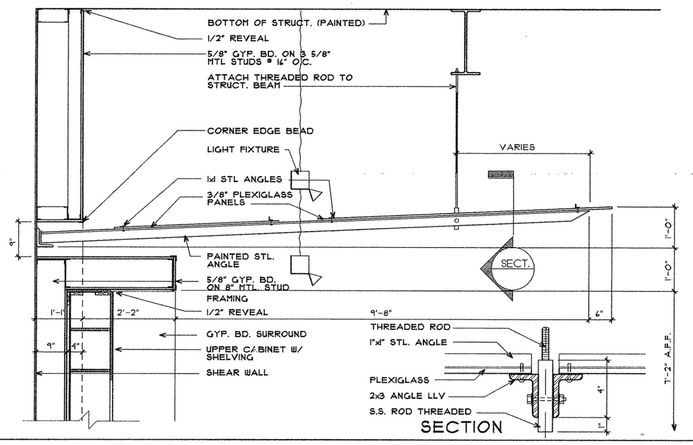

7 SECTION @ LIGHT TRELLIS
SCALE: 3/4" = 1'-0"

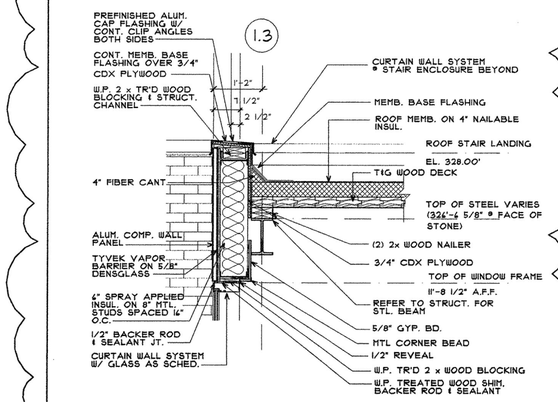

5 SECTION @ PARAPET
SCALE: 3/4" = 1'-0"

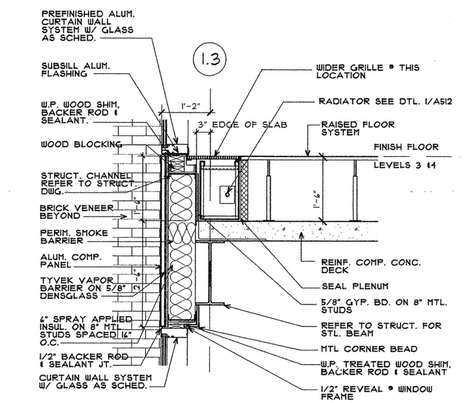

10 SECTION @ FLOORLINE
SCALE: 3/4" = 1'-0"

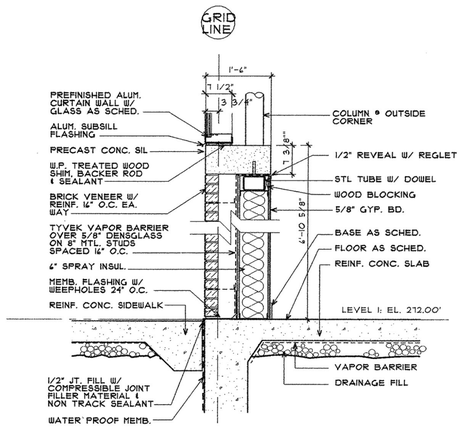

11 SECT. @ NORTH WALL - MAIL
SCALE: 3/4" = 1'-0"

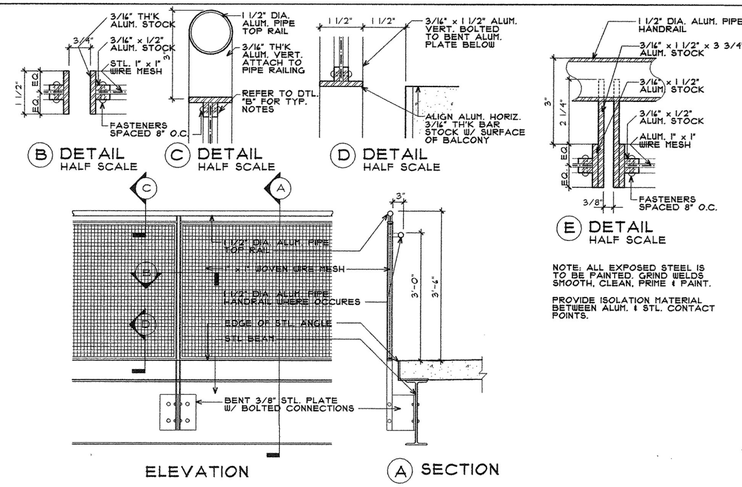

12 ALUM. GUARDRAIL/HANDRAIL DETAIL
SCALE: 3/4" = 1'-0"

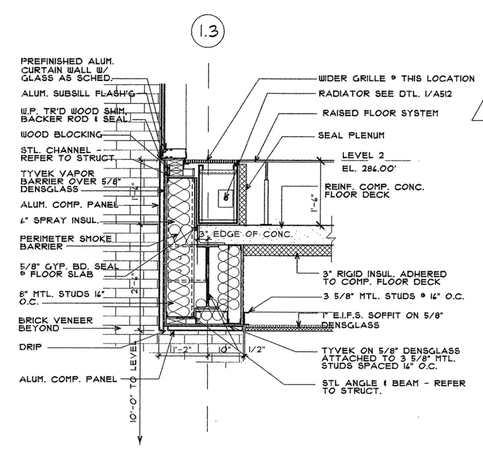

15 SECTION @ SOFFIT
SCALE: 3/4" = 1'-0"

POLK STANLEY YEARY
ARCHITECTS, LTD.
700 SOUTH SCHILLER
LITTLE ROCK, AR 72201
501 378-0878
FAX 372-7629
21 W. MOUNTAIN, SUITE 227
FAYETTEVILLE, AR 72701
479-444-0473

CONSULTANTS:

OWNER'S PROJECT ADVISOR:
MOSES TUCKER REAL ESTATE, INC.

CIVIL ENGINEER:
McCLELLAND ENGINEERS

LANDSCAPE ARCHITECT:
LARSON BURNS SMITH

STRUCTURAL ENGINEER:
CROMWELL ENGINEERS INC.

MECH., ELEC., PLUMB. ENGINEER:
CROMWELL ENGINEERS INC.

SUSTAINABLE CONSULTANT:
BNIM / ELEMENTS

GLOBAL VILLAGE CONSULTANT
CAMBRIDGE SEVEN ASSOCIATES

INTERIOR DESIGNER:
POLK STANLEY YEARY

GENERAL CONTRACTOR:
CDI

GENERAL NOTES:

NOTES:

ISSUE DATE:
100% GMP
PACKAGE #6
FEBRUARY 2, 2004

REVISIONS:

#	DATE	DESCRIPTION
1	01JUL04	PACKAGE 7

HEIFER INTERNATIONAL CENTER OFFICE BUILDING

LITTLE ROCK, ARKANSAS

PSY PROJECT NUMBER:
431C

CONTENTS:
SECTION DETAILS

SHEET NUMBER:
A436

POLK STANLEY YEARY ARCHITECTS, LTD. CORPORATE SEAL CA136 LITTLE ROCK, ARKANSAS

P:\CAD-DWGS\431C\CA\RevitDrawings\A436-SectionDetails 1/2/2004

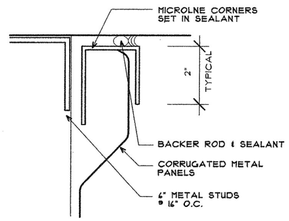

1 DTL. @ CORRUGATED METAL PANELS
SCALE: 6" = 1'-0"

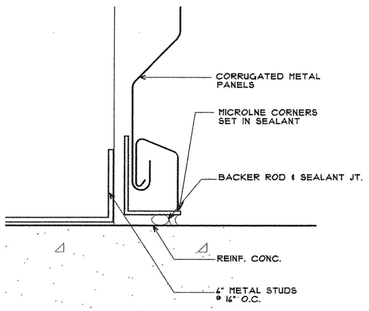

11 DETAIL @ CORRUGATED METAL PANELS
SCALE: 6" = 1'-0"

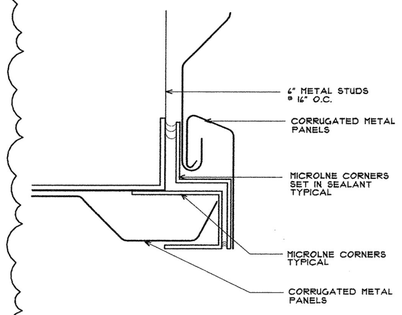

21 CORRUGATED METAL PANEL DTL. @ CORNER
SCALE: 6" = 1'-0"

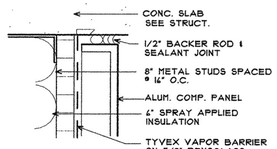

12 DETAIL @ ALUM. COMPOSITE PANEL
SCALE: 6" = 1'-0"

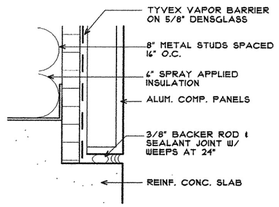

13 DETAIL @ ALUM. COMPOSITE PANEL
SCALE: 6" = 1'-0"

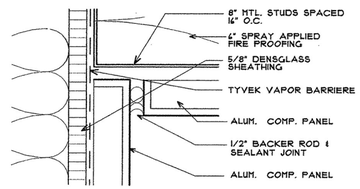

14 DTL. @ ALUM. COMPOSITE PANEL CORNER
SCALE: 6" = 1'-0"

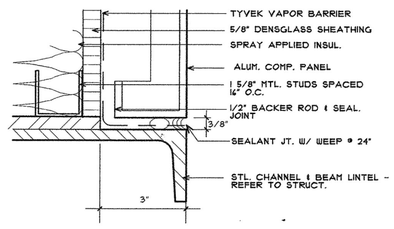

15 DTL. @ ALUM. COMPOSITE PANEL CORNER
SCALE: 6" = 1'-0"

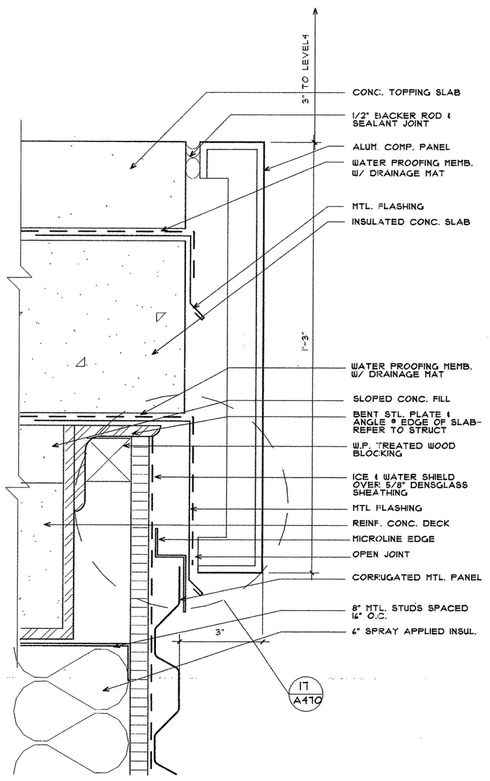

16 DTL. @ CORRUGATED METAL & ALUM. COMPOSITE PANELS 17
SCALE: 6" = 1'-0"

POLK
STANLEY
YEARY
ARCHITECTS, LTD.

700 SOUTH SCHILLER
LITTLE ROCK, AR 72201
501 378-0878
FAX 372-7629

21 W. MOUNTAIN, SUITE 227
FAYETTEVILLE, AR 72701
479-444-0473

CONSULTANTS:

OWNER'S PROJECT ADVISOR:
MOSES TUCKER REAL ESTATE, INC.

CIVIL ENGINEER:
McCLELLAND ENGINEERS

LANDSCAPE ARCHITECT:
LARSON BURNS SMITH

STRUCTURAL ENGINEER:
CROMWELL ENGINEERS INC.

MECH., ELEC., PLUMB. ENGINEER:
CROMWELL ENGINEERS INC.

SUSTAINABLE CONSULTANT:
BNIM / ELEMENTS

GLOBAL VILLAGE CONSULTANT
CAMBRIDGE SEVEN ASSOCIATES

INTERIOR DESIGNER:
POLK STANLEY YEARY

GENERAL CONTRACTOR:
CDI

GENERAL NOTES:

NOTES:

ISSUE DATE:
100% GMP
PACKAGE #6
FEBRUARY 2, 2004

REVISIONS:

#	DATE	DESCRIPTION
1	01JUL04	PACKAGE 01

HEIFER INTERNATIONAL CENTER OFFICE BUILDING

LITTLE ROCK, ARKANSAS

PSY PROJECT NUMBER:
431C

CONTENTS:
DETAILS @ CORRUGATED METAL & ALUMN. COMPOSITE PANELS

SHEET NUMBER:

A470

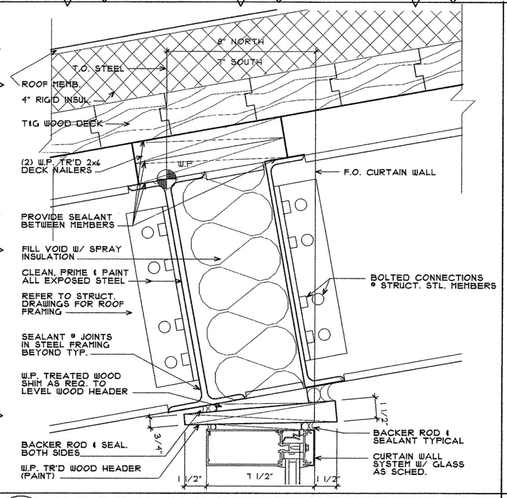

1 SECT.@ ROOF/CURTAIN WALL
SCALE: 3" = 1'-0"

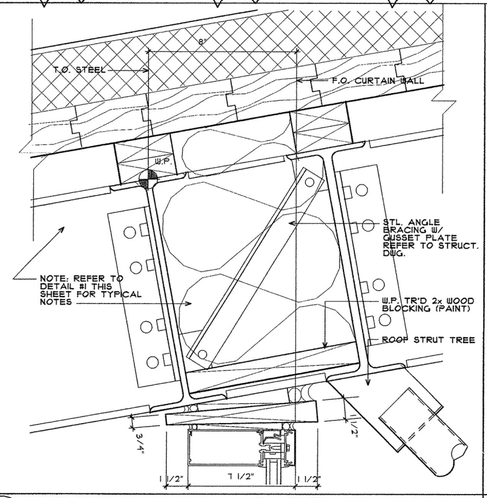

2 SECT.@ ROOF/CURTAIN WALL
SCALE: 3" = 1'-0"

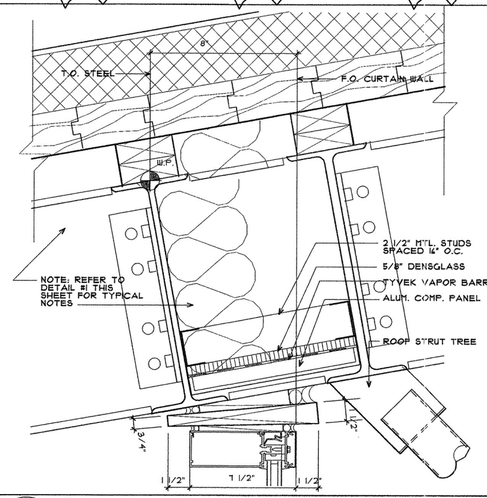

3 SECT.@ ROOF/CURTAIN WALL
SCALE: 3" = 1'-0"

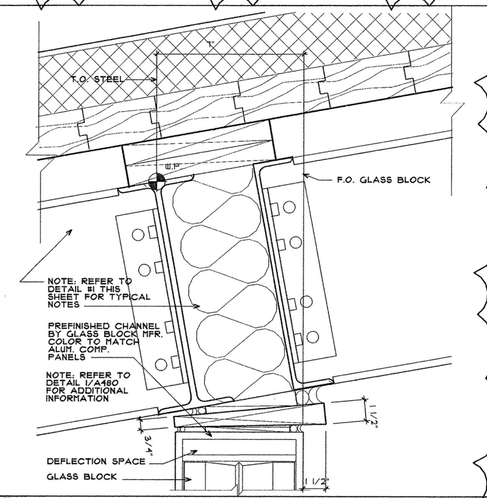

4 SECT.@ ROOF/GLASS BLOCK
SCALE: 3" = 1'-0"

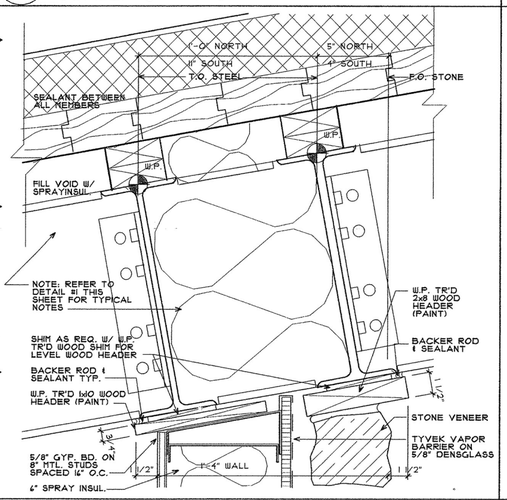

5 SECT.@ ROOF/STONE
SCALE: 3" = 1'-0"

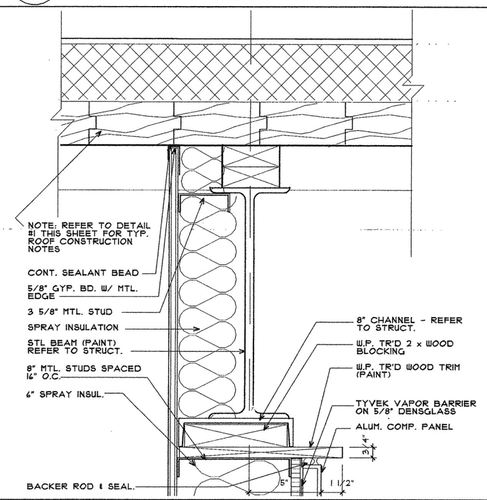

7 SECT.@ ROOF/ALUM. COMP.
SCALE: 3" = 1'-0"

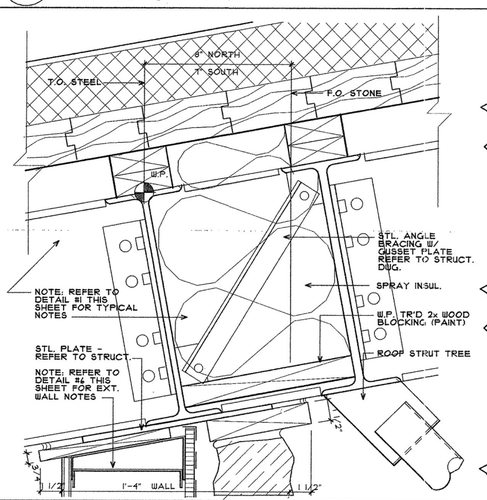

8 SECT.@ ROOF/STONE
SCALE: 3" = 1'-0"

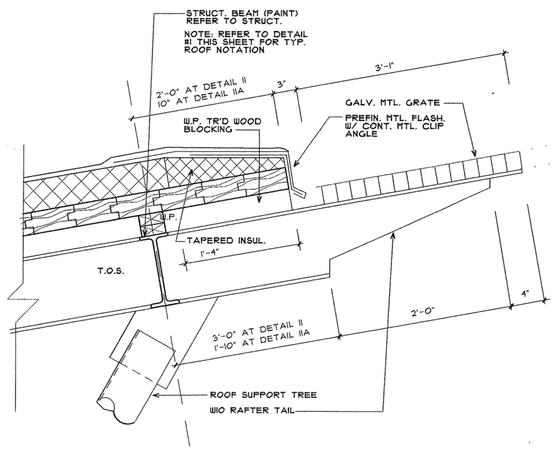

11 SECT.@ ROOF/RAFTER TAIL & SUNSCREEN
SCALE: 1 1/2" = 1'-0"

P:\2-DWG\431C\Cd\Final Drawings For CD's\Final\A480-CitizsRoofDetails.DgS 7/6/2004

POLK STANLEY YEARY
ARCHITECTS, LTD.

700 SOUTH SCHILLER
LITTLE ROCK, AR 72201
501 378-0878
FAX 372-7629

21 W. MOUNTAIN, SUITE 227
FAYETTEVILLE, AR 72701
479-444-0473

CONSULTANTS:

OWNER'S PROJECT ADVISOR:
MOSES TUCKER REAL ESTATE, INC.

CIVIL ENGINEER:
McCLELLAND ENGINEERS

LANDSCAPE ARCHITECT:
LARSON BURNS SMITH

STRUCTURAL ENGINEER:
CROMWELL ENGINEERS INC.

MECH., ELEC., PLUMB. ENGINEER:
CROMWELL ENGINEERS INC.

SUSTAINABLE CONSULTANT:
BNIM / ELEMENTS

GLOBAL VILLAGE CONSULTANT
CAMBRIDGE SEVEN ASSOCIATES

INTERIOR DESIGNER:
POLK STANLEY YEARY

GENERAL CONTRACTOR:
CDI

GENERAL NOTES:

NOTES:

ISSUE DATE:
100% GMP
PACKAGE #6
FEBRUARY 2, 2004

REVISIONS:

#	DATE	DESCRIPTION
1	06JUL04	PACKAGE 7

1

HEIFER INTERNATIONAL CENTER OFFICE BUILDING

LITTLE ROCK, ARKANSAS

PSY PROJECT NUMBER:
431C

CONTENTS:
WALL CONNECTIONS TO ROOF DETAILS

SHEET NUMBER:

A480

PARTITION TYPES:

A: GYP. BD.

(USE WATER RESISTANT GYP. BD. IN RESTROOMS, SHOWERS, PLUMING CHASES FOR RESTROOMS, JANITOR CLOSETS.)

A1: 3 5/8" X 22 GA. MTL. STUDS AT 16" O.C. WITH 5/8" GYP. BD. BOTH SIDES

- A. FROM TOP OF RAISED FLOOR TO DECK OR STRUCTURE ABOVE (SEE DETAIL 1 THIS SHEET).
- B. FROM TOP OF RAISED FLOOR TO 10'-0". (SEE DETAIL 2 THIS SHEET).
- C. FROM TOP OF RAISED FLOOR TO DECK (SEE DETAIL 3 THIS SHEET).
- D. FROM TOP OF RAISED FLOOR TO DECK OR STRUCTURE ABOVE.
- E. FROM TOP OF SLAB TO DECK ABOVE.

A2: 6" X 22 GA. MTL. STUDS ON 16" O.C. WITH 5/8" GYP. BD. BOTH SIDES

- A. FROM TOP OF RAISED FLOOR TO DECK OR STRUCTURE ABOVE (SEE DETAIL 1 THIS SHEET).
- B. FROM TOP OF STRUCTURAL FLOOR TO DECK ON STRUCTURE ABOVE (SEE DETAIL 1 THIS SHEET). PROVIDE 5" SPRAY INSULATION FOR SOUND CONTROL.

A3: 2 HOUR PER ULU411 3 5/8" X 20 GA. MTL. STUDS WITH 2 LAYERS 5/8" FIRE RATED GYP. BD. BOTH SIDES. CONTINUOUS FIRE SEALANT BOTH SIDES OF WALL TOP & BOTTOM.

- A. FROM TOP OF SLAB TO DECK OR STRUCTURE ABOVE (SEE DETAIL 1 THIS SHEET).

A4: 1 HOUR PER UL. U465:
3 5/8" X 22 GA. MTL. STUDS AT 16" O.C. (1) LAYER 5.8" FIRE RATED GYP. BD. BOTH SIDES.

- A. FROM TOP OF SLAB TO DECK OR STRUCTURE ABOVE (SEE DETAIL 1 THIS SHEET).
- B. FROM TOP OF SLAB TO DECK OR STRUCTURE ABOVE (SEE DETAIL 3 THIS SHEET)..
- C. FROM TOP OF SLAB TO DECK (OR WINDOW) ABOVE.

A5: 2 HOUR SHAFT WALL ASSY. PER UL. U438:
2 1/2" X 20 GA. MTL. STUDS AT 24" O.C. WITH 1" THICK SHAFT LINER BOARD & (2) LAYERS 5/8" FIRE RATED GYP. BD. OUTSIDE FACE. CONTINUOUS FIRE SEALANT BOTH SIDES OF WALL TOP & BOTTOM.

A6: 1 HOUR SHAFT WALL ASSY. PER UL: U464:
2 1/2" X 20 GA. MTL. STUDS AT 24" O.C. WITH 1" THICK SHAFT LINER BOARD & (1) LAYER 5/8" FIRE RATED BD. OUTSIDE FACE. CONT. FIRE SEALANT BOTH SIDES OF WALL TOP & BOTTOM.

A7: 3 5/8" X 22 GA. MTL. STUDS WITH ONE LAYER 5/8" GYP. BD. ONE SIDE
A. TO DECK

A8: 1 HOUR
6" X 22 GA. MTL. STUDS AT 16" O.C. (1) LAYER 5/8" FIRERATED GYP. BD. BOTH SIDES
A. FROM TOP OF STRUCTURE FLOOR TO DECK OR STRUCTURE ABOVE. (SEE DETAIL 1 THIS SHEET). PROVIDE SPRAY INSULATION FOR SOUND INSULATION.

B: CMU-SEE STRUCTURAL FOR REINFORCING & ATTACHMENT TO STRUCT.

B1: 8" CMU TO DECK

B2: 8" CMU TO DECK, 1 HOUR PER UL NO. U904

B3: 8" CMU TO DECK, 2 HOUR PER UL NO. U905

B4: 12" CMU TO DECK, FILL CELLS WITH GROUT

B7: 12" CMU TO DECK, 1 HOUR PER UL NO. U905 FILL CELLS WITH GROUT

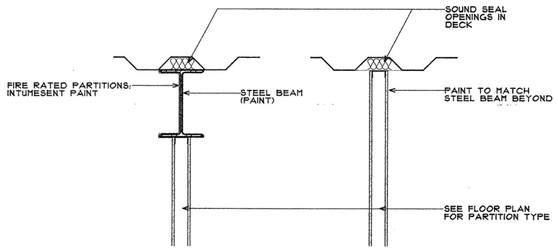

1 TOP OF WALL DETAIL AT FULL HEIGHT PARTITION
SCALE: 3/4" = 1'-0"

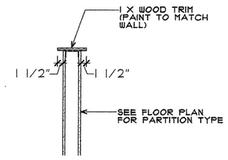

2 TOP OF WALL AT PARTIAL HEIGHT PARTITION
SCALE: 3/4" = 1'-0"

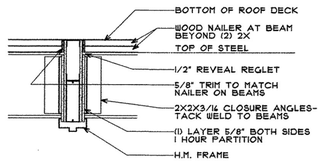

3 TOP OF WALL
SCALE: 3/4" = 1'-0"

POLK
STANLEY
YEARY
ARCHITECTS, LTD.

700 SOUTH SCHILLER
LITTLE ROCK, AR 72201
501 378-0878
FAX 372-7629

21 W. MOUNTAIN, SUITE 227
FAYETTEVILLE, AR 72701
479-444-0473

CONSULTANTS:

OWNER'S PROJECT ADVISOR:
MOSES TUCKER REAL ESTATE, INC.

CIVIL ENGINEER:
McCLELLAND ENGINEERS

LANDSCAPE ARCHITECT:
LARSON BURNS SMITH

STRUCTURAL ENGINEER:
CROMWELL ENGINEERS INC.

MECH., ELEC., PLUMB. ENGINEER:
CROMWELL ENGINEERS INC.

SUSTAINABLE CONSULTANT:
BNIM / ELEMENTS

GLOBAL VILLAGE CONSULTANT
CAMBRIDGE SEVEN ASSOCIATES

INTERIOR DESIGNER:
POLK STANLEY YEARY

GENERAL CONTRACTOR:
CDI

GENERAL NOTES:

NOTES:

ISSUE DATE:
100% GMP
PACKAGE #6
FEBRUARY 2, 2004

REVISIONS:

#	DATE	DESCRIPTION
1	01JUL04	PACKAGE 1

HEIFER INTERNATIONAL CENTER OFFICE BUILDING

LITTLE ROCK, ARKANSAS

PSY PROJECT NUMBER:
431C

CONTENTS:
PARTITION SCHEDULE

SHEET NUMBER:
A500

P:\JOBS\VENOM\Drawings\ArchDwg\Final\A500-Partition Sched

DOOR AND FRAME SCHEDULE

FLOOR	DOOR NUMBER	ROOM NUMBER	ROOM NAME	DOOR TYPE	DOOR WIDTH	DOOR HEIGHT	DOOR THICK	DOOR MAT'L	FRAME TYPE	FRAME MAT'L	FRAME DETAIL HEAD	FRAME DETAIL JAMB	FRAME DETAIL THRESH	HARDWARE	LABEL	REMARKS
FIRST FLOOR	101	101	STAIR 1	A1	3'-0"	7'-0"	1 3/4"	METAL	HM1	H.M.	7/A504	8/A504	9/A504	2		PANIC HARDWARE
	102	102	STAIR 2	E	3'-0"	7'-0"	1 3/4"	WOOD	HM1	H.M.	7/A504	8/A504	9/A504	5	1 1/2 HR.	
	102A	102	STAIR 2	C	3'-0"	7'-0"	1 3/4"	ALUM.	--	ALUM.	5/A501	6/A501	9SIM/A504	1		PANIC HARDWARE
	103	103	STAIR 3	E	3'-0"	7'-0"	1 3/4"	WOOD	HM1	H.M.	10/A504	11/A504		5	1 1/2 HR.	
	104	104	MECHANICAL 1	B	PR. 3'-0"	7'-0"	1 3/4"	METAL	HM2	H.M.	12/A504	13/A504	9SIM/A504	3		
	105	105	MECHANICAL 2	B	3'-0"	7'-0"	1 3/4"	METAL	HM1	H.M.	3/A504	4/A504		9		
	106	106	MAIN VESTIBULE	C	PR. 3'-0"	7'-0"	1 3/4"	ALUM.	--	ALUM	11/A511	5/A501	7/A501	1		PANIC CHECK CODE
	107	107	CONFERENCE 2	C (P)	PR. 3'-0"	7'-0"	1 3/4"	WOOD	--	ALUM	8/A501	9/A501		16		
	108	108	ENCLAVE	F	3'-0"	7'-0"	1 3/4"	WOOD	--	ALUM.	14/A504	15/A504		11		
	109	109	ELEVATOR LOBBY	C	3'-6"	7'-0"	1 3/4"	ALUM.	--	ALUM	11/A511	10/A501	7/A501	1		PANIC HARDWARE
	109A	109	ELEVATOR LOBBY	C (C)	PR. 3'-0"	7'-0"	1 3/4"	ALUM.	--	ALUM	12/A501	11/A501		13		
	110	110	MEN	D	3'-0"	7'-0"	1 3/4"	WOOD	HM1	H.M.	3/A501	4/A501		17		
	111	111	WOMEN	D	3'-0"	7'-0"	1 3/4"	WOOD	HM1	H.M.	3/A501	4/A501		17		
	112	--	NOT USED	---	---	---	---	---	---	---	---	---		---		
	113	113														
	114	114	OFFICE 1	F	3'-0"	7'-0"	1 3/4"	WOOD	--	ALUM	5/A504	6/A504		19		
	115	115	OFFICE 2	F	3'-0"	7'-0"	1 3/4"	WOOD	--	ALUM	5/A504	6/A504		19		
	116	116	OFFICE 3	F	3'-0"	7'-0"	1 3/4"	WOOD	--	ALUM	5/A504	6/A504		19		
	117	117	OFFICE 4	F	3'-0"	7'-0"	1 3/4"	WOOD	--	ALUM	5/A504	6/A504		19		
	118	118	OFFICE 5	F	3'-0"	7'-0"	1 3/4"	WOOD	--	ALUM	5/A504	6/A504		19		
	119	119	OFFICE 6	F	3'-0"	7'-0"	1 3/4"	WOOD	--	ALUM.	5/A504	6/A504		19		
	120	120	OFFICE 7	F	3'-0"	7'-0"	1 3/4"	WOOD	--	ALUM.	5/A504	6/A504		19		
	121	121	OFFICE 8	F	3'-0"	7'-0"	1 3/4"	WOOD	--	ALUM.	5/A504	6/A504		19		
	122	122	OFFICE 9	F	3'-0"	7'-0"	1 3/4"	WOOD	--	ALUM.	5/A504	6/A504		19		
	123	123	OFFICE 10	F	3'-0"	7'-0"	1 3/4"	WOOD	--	ALUM.	5/A504	6/A504		19		
	124	124	OFFICE 11	F	3'-0"	7'-0"	1 3/4"	WOOD	--	ALUM.	5/A504	6/A504		19		
	125	125	OFFICE 12	F	3'-0"	7'-0"	1 3/4"	WOOD	--	ALUM.	5/A504	6/A504		19		
	126	126	OFFICE 13	F	3'-0"	7'-0"	1 3/4"	WOOD	--	ALUM.	5/A504	6/A504		19		
	127	127	OFFICE 14	F	3'-0"	7'-0"	1 3/4"	WOOD	--	ALUM.	5/A504	6/A504		19		
	128	128	OFFICE 15	F	3'-0"	7'-0"	1 3/4"	WOOD	--	ALUM.	5/A504	6/A504		19		
	129	129	OFFICE 16	F	3'-0"	7'-0"	1 3/4"	WOOD	--	ALUM.	5/A504	6/A504		19		
	130	130	OFFICE 17	F	3'-0"	7'-0"	1 3/4"	WOOD	--	ALUM.	5/A504	6/A504		19		
	131	131	CONFERENCE 4	F	3'-0"	7'-0"	1 3/4"	WOOD	--	ALUM.	5/A504	6/A504		19		
	132	132	DOCK	B	PR. 4'-0"	8'-0"	1 3/4"	METAL	HM2	H.M.	13/A504	14/A504		8	3/4 HR.	
	132A	132	DOCK	A1	3'-0"	7'-0"	1 3/4"	METAL	HM1	H.M.	1/A501	2/A501	13/A501	4		
	132B	132	DOCK	K	12'-0"	10'-0"	--	METAL	--	--	14/A501	15/A501	13/A501	7		
	133	133	OPEN OFFICES 3	F	PR. 3'-0"	7'-0"	1 3/4"	WOOD	--	ALUM.	5/A504	5/A508		14		
	134	134	VESTIBULE 1	C	PR. 3'-0"	7'-0"	1 3/4"	ALUM	--	ALUM.	7/A511	5/A501	7/A501	1		PANIC HARDWARE
	134A	131	FIRE PUMP	B	3'-0"	7'-0"	1 3/4"	METAL	HM3	H.M.						
	134	134	EMERGENCY ELECT. ROOM	B	4'-0"	7'-0"	1 3/4"	METAL	HM3	H.M.						
	137	137	FIRE PUMP	B	4'-0"	7'-0"	1 3/4"	METAL	HM3	H.M.						
	138	138	ELECTRIC ROOM	D	3'-0"	7'-0"	1 3/4"	WOOD	HM1	H.M.	3/A501	4/A501		11		UNDERCUT DOOR 3/4"
	139	139	ELEV. CONTROL PANEL	B	PR. 3'-0"	7'-0"	1 3/4"	METAL	HM3	H.M.	3/A504	4/A504		12		
	142	142	SHOWER	D	3'-0"	7'-0"	1 3/4"	WOOD	HM1	H.M.	3/A501	4/A501		11		
	143	143	RECYCLE	B	PR. 4'-0"	8'-0"	1 3/4"	METAL	HM2	H.M.	1/A504	2/A504		8	3/4 HR.	
	144	144	LOBBY	C	PR. 3'-0"	7'-0"	1 3/4"	ALUM.	--	ALUM.	12/A501	1/A508		1		
	148	148	OPEN OFFICE 1	C	PR. 3'-0"	7'-0"	1 3/4"	ALUM	--	ALUM.	7/A511	6/A501	7SIM/A501	1		PANIC HARDWARE
	148A	148	OPEN OFFICE 1	F	PR. 3'-0"	7'-0"	1 3/4"	WOOD	--	ALUM.	5/A504	5/A508		13		
	150		NOT USED													
	150A	150	GIFT SHOP	J	12'-0"	7'-8"	---	ALUM.	---	---	3/A508	4/A508		1		
	150B		NOT USED													
	151	151	COMM 1	D	3'-0"	7'-0"	1 3/4"	WOOD	HM1	H.M.	14/A504	15/A504		11		UNDERCUT DOOR 3/4"
	152	152	VESTIBULE 2	D	3'-0"	7'-0"	1 3/4"	WOOD	HM1	H.M.	3/A501	4/A501		17		
	153	153	VESTIBULE 3	D	3'-0"	7'-0"	1 3/4"	WOOD	HM1	H.M.	3/A501	4/A501		17		
	154	154	MAIL	C	3'-2"	7'-0"	1 3/4"	ALUM.	--	ALUM.	8/A508	7/A508	13/A501	1		
	154A	154	MAIL	A1	PR. 3'-0"	7'-0"	1 3/4"	METAL	HM2	H.M.	3/A504	4/A504		20		
	154B	154	MAIL	A1	3'-0"	7'-0"	1 3/4"	METAL	HM1	H.M.	1/A501	2/A501	13/A501	4		
	155	109	ELEVATOR LOBBY	C	3'-6"	7'-0"	1 3/4"	ALUM.	---	ALUM.	8/A511	5/A501	7/A501	1		PANIC HARDWARE
	155A	--	NOT USED	---	---	---	---	---	---	---	---	---		---		
	156	156	FILES	D	3'-0"	7'-0"	1 3/4"	WOOD	HM1	H.M.	3/A501	4/A501		9	1 1/2 HR	
	156A	156	FILES	D	3'-0"	7'-0"	1 3/4"	WOOD	HM1	H.M.	3/A501	4/A501		9	1 1/2 HR	

DOOR AND FRAME SCHEDULE

FLOOR	DOOR NUMBER	ROOM NUMBER	ROOM NAME	DOOR TYPE	DOOR WIDTH	DOOR HEIGHT	DOOR THICK	DOOR MAT'L	FRAME TYPE	FRAME MAT'L	FRAME DETAIL HEAD	FRAME DETAIL JAMB	FRAME DETAIL THRESH	HARDWARE	LABEL	REMARKS
SECOND FLOOR	201	201	STAIR 1	E	3'-0"	7'-0"	1 3/4"	WOOD	HM1	H.M.	1/A504	8/A504		5	1 1/2 HR.	
	202	202	STAIR 2	E	3'-0"	7'-0"	1 3/4"	WOOD	HM1	H.M.	1/A504	8/A504		5	1 1/2 HR.	
	203	203	STAIR 3	E	3'-0"	7'-0"	1 3/4"	WOOD	HM1	H.M.	10/A504	11/A504		5	1 1/2 HR.	
	204	204	MECHANICAL 1	D	4'-0"	7'-0"	1 3/4"	WOOD	--	H.M.	9/A508	10/A508		11		
	205	205	MECHANICAL 2	D	4'-0"	7'-0"	1 3/4"	WOOD	--	H.M.	9SIM/A508	11/A508		11		
	206	206	CONFERENCE 1	P	PR. 3'-0"	7'-0"	1 3/4"	WOOD	--	ALUM.	12/A501	1/A508		16		
	207	207	CONFERENCE 2	C	3'-0"	7'-0"	1 3/4"	ALUM	--	ALUM.	1/A511	5/A501	12/A511	1		
	207A	207	CONFERENCE 2	G	1'-8 1/4" x 12'-2 1/4"		---	VINYL	--	---	12/A508	2/A508				VERIFY SIZE, SIDE STACKING
	207B	207	CONFERENCE 2	H	PR. 3'-0"	7'-0"	1 3/4"	WOOD	--	ALUM.	14/A504	15/504		16		TRANSOM TO 10'-0" A.F.F. - SEE 7/A701
	208	208	CONFERENCE 3	C	3'-0"	7'-0"	1 3/4"	ALUM.	--	ALUM.	7/A511	5/A501	12/A511	1		
	208A	208	CONFERENCE 3	C	3'-0"	7'-0"	1 3/4"	WOOD	--	ALUM.	14/A504	15/A504		21		
	210	210	MEN	D	3'-0"	7'-0"	1 3/4"	WOOD	HM1	H.M.	3/A501	4/A501		17		
	211	211	WOMEN	D	3'-0"	7'-0"	1 3/4"	WOOD	HM1	H.M.	3/A501	4/A501		17		
	212	212	VESTIBULE 1	C	PR. 3'-0"	7'-0"	1 3/4"	ALUM.	--	ALUM.	1/A511	5/A501	12/A511	1		
	213	213	JANITOR	D	3'-0"	7'-0"	1 3/4"	WOOD	HM1	H.M.	3/A501	4/A501		11		
	214	214	OFFICE 1	F	3'-0"	7'-0"	1 3/4"	WOOD	--	ALUM.	5/A504	6/A504		19		
	215	215	OFFICE 2	F	3'-0"	7'-0"	1 3/4"	WOOD	--	ALUM.	5/A504	6/A504		19		
	216	216	OFFICE 3	F	3'-0"	7'-0"	1 3/4"	WOOD	--	ALUM.	5/A504	6/A504		19		
	217	217	OFFICE 4	F	3'-0"	7'-0"	1 3/4"	WOOD	--	ALUM.	5/A504	6/A504		19		
	218	218	OFFICE 5	F	3'-0"	7'-0"	1 3/4"	WOOD	--	ALUM.	5/A504	6/A504		19		
	219	219	OFFICE 6	F	3'-0"	7'-0"	1 3/4"	WOOD	--	ALUM.	5/A504	6/A504		19		
	220	220	OFFICE 7	F	3'-0"	7'-0"	1 3/4"	WOOD	--	ALUM.	5/A504	6/A504		19		
	221	221	OFFICE 8	F	3'-0"	7'-0"	1 3/4"	WOOD	--	ALUM	5/A504	6/A504		19		
	222	222	OFFICE 9	F	3'-0"	7'-0"	1 3/4"	WOOD	--	ALUM	5/A504	6/A504		19		
	223	223	OFFICE 10	F	3'-0"	7'-0"	1 3/4"	WOOD	--	ALUM.	5/A504	6/A504		19		
	224	224	OFFICE 11	F	3'-0"	7'-0"	1 3/4"	WOOD	--	ALUM.	5/A504	6/A504		19		
	225	225	OFFICE 12	F	3'-0"	7'-0"	1 3/4"	WOOD	--	ALUM.	5/A504	6/A504		19		
	226	226	OFFICE 13	F	3'-0"	7'-0"	1 3/4"	WOOD	--	ALUM.	5/A504	6/A504		19		
	227	227	OFFICE 14	F	3'-0"	7'-0"	1 3/4"	WOOD	--	ALUM.	5/A504	6/A504		19		
	228	228	OFFICE 15	F	3'-0"	7'-0"	1 3/4"	WOOD	--	ALUM.	5/A504	6/A504		19		
	229	229	OFFICE 16	F	3'-0"	7'-0"	1 3/4"	WOOD	--	ALUM	5/A504	6/A504		19		
	230	230	OFFICE 17	F	3'-0"	7'-0"	1 3/4"	WOOD	--	ALUM	5/A504	6/A504		19		
	231	231	OFFICE 18	F	3'-0"	7'-0"	1 3/4"	WOOD	--	ALUM.	5/A504	6/A504		19		
	232	232	OFFICE 19	F	3'-0"	7'-0"	1 3/4"	WOOD	--	ALUM.	5/A504	6/A504		19		
	233	233	OFFICE 20	F	3'-0"	7'-0"	1 3/4"	WOOD	--	ALUM.	5/A504	6/A504		19		
	234	234	OFFICE 21	F	3'-0"	7'-0"	1 3/4"	WOOD	--	ALUM.	5/A504	6/A504		19		
	235	235	OFFICE 22	F	3'-0"	7'-0"	1 3/4"	WOOD	--	ALUM.	5/A504	6/A504		19		
	235A	235	OFFICE 22	C	3'-0"	7'-0"	1 3/4"	ALUM.	--	ALUM.	7/A511	5/A501	14/A508	1		
	238	238	ELECTRICAL	D	3'-0"	7'-0"	1 3/4"	WOOD	HM1	H.M.	3/A501	4/A501		11		UNDERCUT DOOR 3/4"
	248	248	OPEN OFFICE 1	C	3'-0"	7'-0"	1 3/4"	ALUM.	--	ALUM.	7/A511	5/A501		1		
	248A	248	OPEN OFFICE 1	C	PR 3'-0"	7'-0"	1 3/4"	ALUM.	--	ALUM.	7/A511	5/A501				
	249	249	OPEN OFFICE 2	C	3'-0"	7'-0"	1 3/4"	ALUM.	--	ALUM.	7/A511	5/A501				
	249A	249	OPEN OFFICE 2	C	PR 3'-0"	7'-0"	1 3/4"	ALUM.	--	ALUM.	7/A511	5/A501				
	248B	248	OPEN OFFICE 1	C	3'-6"	7'-0"	1 3/4"	ALUM.	---	ALUM.	7/A511	5/A501				
	250	250	BREAK	N	PR. 3'-0"	7'-0"	1 3/4"	ALUM.	---	ALUM.	15/A508	---	16/A508	1		
	251	251	SERVER ROOM	D	3'-0"	7'-0"	1 3/4"	WOOD	HM1	H.M.	3/A501	4/A501		11		
	253	253	CONFERENCE 5	C	3'-0"	7'-0"	1 3/4"	WOOD	--	ALUM.	14/A504	15/A504		21		
	253A	253	CONFERENCE 5	C	3'-0"	7'-0"	1 3/4"	ALUM.	---	ALUM.	7/A511	5/A501	12/A511	1		
	254	254	CONFERENCE 6	G	1'-8 1/4" x 12'-2 1/4"		---	VINYL	---	---	12/A508	2/A508				VERIFY SIZE, SIDE STACKING
	254A	254	CONFERENCE 6	C	3'-0"	7'-0"	1 3/4"	ALUM.	---	ALUM.	7/A511	5/A501	12/A511	1		
	254B	254	CONFERENCE 6	H	PR. 3'-0"	7'-0"	1-3/4"	WOOD	---	ALUM.	14/A504	15/A504		16		TRANSOM TO 10'-0" A.F.F. - SEE 7/A701
	255	255	COMM 1	D	3'-0"	7'-0"	1 3/4"	WOOD	HM1	H.M.	3/A501	4/A501		11		UNDERCUT DOOR 3/4"
	256	256	COMM 2	D	3'-0"	7'-0"	1 3/4"	WOOD	HM1	H.M.	3/A501	4/A501		11		UNDERCUT DOOR 3/4"
	257	257	WORK ROOM	E	3'-0"	7'-0"	1 3/4"	WOOD	HM1	H.M.	3/A501	4/A501		11		
	258	258	VESTIBULE 2	D	3'-0"	7'-0"	1 3/4"	WOOD	HM1	H.M.	3/A501	4/A501		17		
	259	259	VESTIBULE 3	D	3'-0"	7'-0"	1 3/4"	WOOD	HM1	H.M.	3/A501	4/A501		17		
	260	260	ELEVATOR CONTR. PNL.	D	PR. 2'-0"	7'-0"	1 3/4"	WOOD	HM1	H.M.						

GENERAL NOTES:

1. "A" LABEL DOORS = 3 HOUR FIRE RATED WITHIN A 4 HOUR FIRE RATED WALL OR PARTITION.
2. "B" LABEL DOORS = 1 1/2 HOUR FIRE RATED WITHIN A 2 HOUR FIRE RATED WALL OR PARTITION.
3. "C" LABEL DOORS = 3/4 HOUR FIRE RATED WITHIN A 1 HOUR FIRE RATED WALL OR PARTITION.

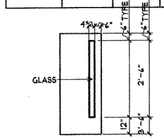

A) 1 3/4" HOLLOW METAL FLUSH PANEL DOOR WITH 1/4" CLEAR TEMP. GLASS

AI) SAME AS DOOR TYPE "A" EXCEPT AS NOTED

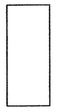

B) 1 3/4" HOLLOW METAL FLUSH PANEL DOOR.

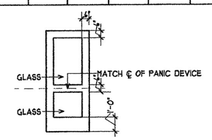

C) 1 3/4" MEDIUM STILE ALUMINUM DOOR WITH 1/4" CLEAR TEMPERED GLASS.

D) 1 3/4" SOLID CORE STAIN GRADE MAPLE FLUSH PANEL WOOD DOOR.

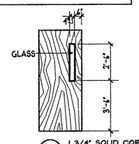

E) 1 3/4" SOLID CORE STAIN GRADE MAPLE FLUSH PANEL WOOD DOOR WITH 1/4" CLEAR TEMP. GLASS

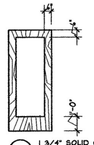

F) 1 3/4" SOLID CORE STAIN GRADE MAPLE WOOD DOOR WITH 1/4" CLEAR TEMPERED GLASS.

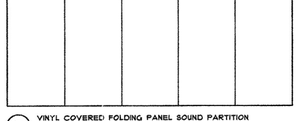

G) VINYL COVERED FOLDING PANEL SOUND PARTITION

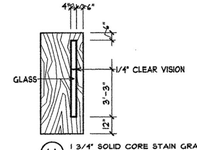

H) 1 3/4" SOLID CORE STAIN GRADE MAPLE WOOD DOOR WITH 1/4" OBSURE TEMP. GLASS

HI) SAME AS H WITH CLEAR GLASS

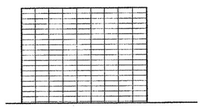

J) ALUMINUM OVERHEAD COILING GRILLE MANUALLY OPERATED

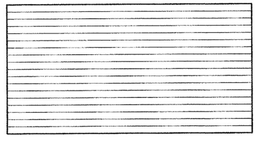

K) INSULATED STEEL OVERHEAD COILING ELECTRICALLY OPERATED DOOR W/ SMOOTH SLATS

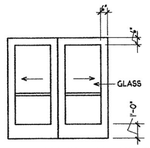

N) 1 3/4" MEDIUM STILE ALUMINUM BI-PARTING DOOR WITH 1/4" CLEAR TEMPERED GLASS

DOOR TYPES

SCALE: 1/4" = 1' - 0"

POLK
STANLEY
YEARY
ARCHITECTS, LTD.

700 SOUTH SCHILLER
LITTLE ROCK, AR 72201
501 378-0878
FAX 372-7629

21 W. MOUNTAIN, SUITE 227
FAYETTEVILLE, AR 72701
479-444-0473

CONSULTANTS:

OWNER'S PROJECT ADVISOR:
MOSES TUCKER REAL ESTATE, INC.

CIVIL ENGINEER:
McCLELLAND ENGINEERS

LANDSCAPE ARCHITECT:
LARSON BURNS SMITH

STRUCTURAL ENGINEER:
CROMWELL ENGINEERS INC.

MECH., ELEC., PLUMB. ENGINEER:
CROMWELL ENGINEERS INC.

SUSTAINABLE CONSULTANT:
BNIM / ELEMENTS

GLOBAL VILLAGE CONSULTANT
CAMBRIDGE SEVEN ASSOCIATES

INTERIOR DESIGNER:
POLK STANLEY YEARY

GENERAL CONTRACTOR:
CDI CONTRACTORS, INC.

GENERAL NOTES:

NOTES:

ISSUE DATE:
100% G.M.P.
PACKAGE #6
FEBRUARY 2, 2004

REVISIONS:

#	DATE	DESCRIPTION
1	01JULY04	PACKAGE 7

HEIFER INTERNATIONAL CENTER OFFICE BUILDING

LITTLE ROCK, ARKANSAS

PSY PROJECT NUMBER:
431C

CONTENTS:
DOOR AND FRAME SCHEDULE

SHEET NUMBER:

A501

R:\2003\431C\CAD\Arch\sheets\A501-Door&Frame.dwg, 6/29/2004 4:29:49 PM

DOOR AND FRAME SCHEDULE

FLOOR	DOOR NUMBER	ROOM NUMBER	ROOM NAME	DOOR TYPE	DOOR WIDTH	DOOR HEIGHT	DOOR THICK	DOOR MAT'L	FRAME TYPE	FRAME MAT'L	FRAME DETAIL HEAD	FRAME DETAIL JAMB	FRAME DETAIL THRESH.	HARDWARE	LABEL	REMARKS
THIRD FLOOR	301	301	STAIR 1	E	3'-0"	7'-0"	1 3/4"	WOOD	HM1	H.M.	1/A504	8/A504		5	1 1/2 HR.	
	302	302	STAIR 2	E	3'-0"	7'-0"	1 3/4"	WOOD	HM1	H.M.	1/A504	8/A504		5	1 1/2 HR.	
	303	303	STAIR 3	E	3'-0"	7'-0"	1 3/4"	WOOD	HM1	H.M.	10/A504	11/A504		5	1 1/2 HR.	
	304	304	MECHANICAL 1	D	4'-0"	7'-0"	1 3/4"	WOOD	--	H.M.	9/A508	10/A508		11		
	305	305	MECHANICAL 2	D	4'-0"	7'-0"	1 3/4"	WOOD	--	H.M.	9/A508	11/A508		11		
	306	306	CONFERENCE 1	F	PR.3'-0"	7'-0"	1 3/4"	WOOD	--	ALUM.	12/A507	1/A508		16		
	307	307	CONFERENCE 2	C	3'-0"	7'-0"	1 3/4"	ALUM.	--	ALUM	8/A511	5/A507	12/A511	1		
	307A	307	CONFERENCE 2	G	38'-0" +/-	12'-4" +/-	--	VINYL	--	--	12/A508	2/A508				VERIFY SIZE, SIDE STACKING
	307B	307	CONFERENCE 2	H	PR. 3'-0"	7'-0"	1 3/4"	WOOD	--	ALUM	14/A504	15/A504		14		TRANSOM TO 10'-0" A.F.F. - SEE 7/A701
	308	308	CONFERENCE 3	C	3'-0"	7'-0"	1 3/4"	ALUM.	--	ALUM	8/A511	5/A507	12/A511	1		
	308A	308	CONFERENCE 3	C	3'-0"	7'-0"	1 3/4"	WOOD	--	ALUM	14/A504	15/A504		21		
	310	310	MEN	D	3'-0"	7'-0"	1 3/4"	WOOD	HM1	H.M.	3/A507	4/A507		17		
	311	311	WOMEN	D	3'-0"	7'-0"	1 3/4"	WOOD	HM1	H.M.	3/A507	4/A507		17		
	312	312	VEST. 1	C	PR. 3'-0"	7'-0"	1 3/4"	ALUM.	--	ALUM	7/A511	5/A507	12/A511	1		
	313	313	JANITOR	D	3'-0"	7'-0"	1 3/4"	WOOD	HM1	H.M.	3/A507	4/A507		11		
	314	314	OFFICE 1	F	3'-0"	7'-0"	1 3/4"	WOOD	--	ALUM	5/A504	6/A504		19		
	315	315	OFFICE 2	F	3'-0"	7'-0"	1 3/4"	WOOD	--	ALUM	5/A504	6/A504		19		
	316	316	OFFICE 3	F	3'-0"	7'-0"	1 3/4"	WOOD	--	ALUM	5/A504	6/A504		19		
	317	317	OFFICE 4	F	3'-0"	7'-0"	1 3/4"	WOOD	--	ALUM	5/A504	6/A504		19		
	318	318	OFFICE 5	F	3'-0"	7'-0"	1 3/4"	WOOD	--	ALUM	5/A504	6/A504		19		
	319	319	OFFICE 6	F	3'-0"	7'-0"	1 3/4"	WOOD	--	ALUM	5/A504	6/A504		MX		
	320	320	OFFICE 7	F	3'-0"	7'-0"	1 3/4"	WOOD	--	ALUM	5/A504	6/A504		19		
	321	321	OFFICE 8	F	3'-0"	7'-0"	1 3/4"	WOOD	--	ALUM.	5/A504	6/A504		19		
	322	322	OFFICE 9	F	3'-0"	7'-0"	1 3/4"	WOOD	--	ALUM.	5/A504	6/A504		19		
	323	323	OFFICE 10	F	3'-0"	7'-0"	1 3/4"	WOOD	--	ALUM.	5/A504	6/A504		19		
	324	324	OFFICE 11	F	3'-0"	7'-0"	1 3/4"	WOOD	--	ALUM.	5/A504	6/A504		19		
	325	325	OFFICE 12	F	3'-0"	7'-0"	1 3/4"	WOOD	--	ALUM.	5/A504	6/A504		19		
	326	326	OFFICE 13	F	3'-0"	7'-0"	1 3/4"	WOOD	--	ALUM.	5/A504	6/A504		19		
	327	327	OFFICE 14	F	3'-0"	7'-0"	1 3/4"	WOOD	--	ALUM.	5/A504	6/A504		19		
	328	328	OFFICE 15	F	3'-0"	7'-0"	1 3/4"	WOOD	--	ALUM.	5/A504	6/A504		19		
	329	329	OFFICE 16	F	3'-0"	7'-0"	1 3/4"	WOOD	--	ALUM.	5/A504	6/A504		19		
	330	330	OFFICE 17	F	3'-0"	7'-0"	1 3/4"	WOOD	--	ALUM	5/A504	6/A504		19		
	331	331	OFFICE 18	F	3'-0"	7'-0"	1 3/4"	WOOD	--	ALUM.	5/A504	6/A504		19		
	332	332	OFFICE 19	F	3'-0"	7'-0"	1 3/4"	WOOD	--	ALUM.	5/A504	6/A504		19		
	333	333	OFFICE 20	F	3'-0"	7'-0"	1 3/4"	WOOD	--	ALUM.	5/A504	6/A504		19		
	334	334	OFFICE 21	F	3'-0"	7'-0"	1 3/4"	WOOD	--	ALUM.	5/A504	6/A504		19		
	335	335	OFFICE 22	F	3'-0"	7'-0"	1 3/4"	WOOD	--	ALUM.	5/A504	6/A504		19		
	335A	335	OFFICE 22	C	3'-0"	7'-0"	1 3/4"	ALUM.	--	ALUM	7/A511	5/A507	14/A508	1		
	338	338	ELECTRICAL	D	3'-0"	7'-0"	1 3/4"	WOOD	HM1	H.M.	3/A507	4/A507		11		UNDERCUT DOOR 3/4"
	348	348	OPEN OFFICE 1	C	3'-0"	7'-0"	1 3/4"	ALUM.	--	ALUM.	7/A511	5/A507	14/A508	1		
	350	350	BREAK	N	PR. 3'-0"	7'-0"	1 3/4"	ALUM.	--	ALUM.	15/A508	--	14/A508	1		
	351	351	SERVER ROOM	D	3'-0"	7'-0"	1 3/4"	WOOD	HM1	H.M.	3/A507	4/A507		11		
	353	353	CONFERENCE 5	H	3'-0"	7'-0"	1 3/4"	WOOD	--	ALUM.	14/A504	15/A504		21		
	353A	353	CONFERENCE 5	G	38'-0" +/-	12'-4" +/-	--	VINYL	--	--	12/A508	2/A508				VERIFY SIZE, SIDE STACKING
	353B	353	CONFERENCE 5	C	3'-0"	7'-0"	1 3/4"	ALUM	--	ALUM	7/A511	5/A507	12/A511	1		
	354	354	CONFERENCE 6	C	3'-0"	7'-0"	1 3/4"	ALUM.	--	ALUM.	7/A511	5/A507	12/A511	1		
	354A	354	CONFERENCE 6	H	PR. 3'-0"	7'-0"	1 3/4"	WOOD	--	ALUM.	14/A504	15/A504		14		TRANSOM TO 10'-0" A.F.F. - SEE 7/A701
	355	355	COMM 1	D	3'-0"	7'-0"	1 3/4"	WOOD	HM1	H.M.	3/A507	4/A507		11		UNDERCUT DOOR 3/4"
	356	356	COMM 2	D	3'-0"	7'-0"	1 3/4"	WOOD	--	ALUM.	14/A504	15/A504		11		UNDERCUT DOOR 3/4"
	357	357	WORK ROOM	E	3'-0"	7'-0"	1 3/4"	WOOD	HM1	H.M.	3/A507	4/A507		11		
	358	358	VEST. 2	D	3'-0"	7'-0"	1 3/4"	WOOD	HM1	H.M.	3/A507	4/A507		17		
	359	359	VEST. 3	D	3'-0"	7'-0"	1 3/4"	WOOD	HM1	H.M.	3/A507	4/A507		17		

FLOOR	DOOR NUMBER	ROOM NUMBER	ROOM NAME	DOOR TYPE	DOOR WIDTH	DOOR HEIGHT	DOOR THICK	DOOR MAT'L	FRAME TYPE	FRAME MAT'L	FRAME DETAIL HEAD	FRAME DETAIL JAMB	FRAME DETAIL SILL	HARDWARE	LABEL	REMARKS
ROOF LEVEL	501	501	STAIR 1	C	3'-0"	2'-8"	1 3/4"	ALUM	--	ALUM	5/A507	5/A507	14 SIM/A507	6		
	502	502	STAIR 2	C	3'-0"	5'-4"	1 3/4"	ALUM	--	ALUM	5/A507	5/A507	14/A507	6		
	503	503	STAIR 3	C	3'-0"	7'-0"	1 3/4"	ALUM	--	ALUM	5/A507	5/A507	3/A601e	6		

DOOR AND FRAME SCHEDULE

FLOOR	DOOR NUMBER	ROOM NUMBER	ROOM NAME	DOOR TYPE	DOOR WIDTH	DOOR HEIGHT	DOOR THICK	DOOR MAT'L	FRAME TYPE	FRAME MAT'L	FRAME DETAIL HEAD	FRAME DETAIL JAMB	FRAME DETAIL THRESH.	HARDWARE	LABEL	REMARKS
FOURTH FLOOR	401	401	STAIR 1	E	3'-0"	7'-0"	1 3/4"	WOOD	HM1	H.M.	1/A504	8/A504		5	1 1/2" HR.	
	402	402	STAIR 2	E	3'-0"	7'-0"	1 3/4"	WOOD	HM1	H.M.	1/A504	8/A504		5	1 1/2" HR.	
	403	403	STAIR 3	E	3'-0"	7'-0"	1 3/4"	WOOD	HM1	H.M.	10/A504	11/A504		5	1 1/2" HR.	
	404	404	MECHANICAL 1	D	4'-0"	7'-0"	1 3/4"	WOOD	--	H.M.	1/A509	2/A509		11		
	405	405	MECHANICAL 2	D	4'-0"	7'-0"	1 3/4"	WOOD	--	H.M.	1/A509	3/A509		11		
	406	406	CONFERENCE 1	F	PR. 3'-0"	7'-0"	1 3/4"	WOOD	--	ALUM	12/A507	1/A508		16		
	406A	406	CONFERENCE 1	C	PR. 3'-0"	7'-0"	1 3/4"	ALUM.	--	ALUM	8/A511	5/A507	12/A511	1		
	407	407	CONFERENCE 2	C	3'-0"	7'-0"	1 3/4"	ALUM.	--	ALUM	8/A511	5/A507	12/A511	1		
	407A	407	CONFERENCE 2	H	PR. 3'-0"	7'-0"	1 3/4"	WOOD	--	ALUM	14/A504	15/A504		14		TRANSOM TO 10'-0" A.F.F. - SEE 7/A701
	409	409	ELEV. LOBBY	C	3'-0"	7'-0"	1 3/4"	ALUM.	--	ALUM	8/A511	4/A509	12/A511	1		
	410	410	MEN	D	3'-0"	7'-0"	1 3/4"	WOOD	HM1	H.M.	3/A507	4/A507		17		
	411	411	WOMEN	D	3'-0"	7'-0"	1 3/4"	WOOD	HM1	H.M.	3/A507	4/A507		17		
	412	412	VESTIBULE 1	C	PR. 3'-0"	7'-0"	1 3/4"	ALUM.	--	ALUM	7/A511	5/A507	12/A511	1		
	413	413	JANITOR	D	3'-0"	7'-0"	1 3/4"	WOOD	HM1	H.M.	3/A507	4/A507		11		
	414	414	OFFICE 1	F	3'-0"	7'-0"	1 3/4"	WOOD	--	ALUM	5/A504	6/A504		19		
	415	415	OFFICE 2	F	3'-0"	7'-0"	1 3/4"	WOOD	--	ALUM	5/A504	6/A504		19		
	416	416	OFFICE 3	F	3'-0"	7'-0"	1 3/4"	WOOD	--	ALUM	5/A504	6/A504		19		
	417	417	OFFICE 4	F	3'-0"	7'-0"	1 3/4"	WOOD	--	ALUM	5/A504	6/A504		19		
	418	418	OFFICE 5	F	3'-0"	7'-0"	1 3/4"	WOOD	--	ALUM	5/A504	6/A504		19		
	419	419	OFFICE 6	F	3'-0"	7'-0"	1 3/4"	WOOD	--	ALUM	5/A504	6/A504		19		
	420	420	OFFICE 7	F	3'-0"	7'-0"	1 3/4"	WOOD	--	ALUM	5/A504	6/A504		19		
	421	421	OFFICE 8	F	3'-0"	7'-0"	1 3/4"	WOOD	--	ALUM.	5/A504	6/A504		19		
	422	422	OFFICE 9	F	3'-0"	7'-0"	1 3/4"	WOOD	--	ALUM	5/A504	6/A504		19		
	423	423	OFFICE 10	F	3'-0"	7'-0"	1 3/4"	WOOD	--	ALUM	5/A504	6/A504		19		
	424	424	OFFICE 11	F	3'-0"	7'-0"	1 3/4"	WOOD	--	ALUM	5/A504	6/A504		19		
	425	425	OFFICE 12	F	3'-0"	7'-0"	1 3/4"	WOOD	--	ALUM	5/A504	6/A504		19		
	426	426	OFFICE 13	F	3'-0"	7'-0"	1 3/4"	WOOD	--	ALUM.	5/A504	6/A504		19		
	427	427	OFFICE 14	F	3'-0"	7'-0"	1 3/4"	WOOD	--	ALUM.	5/A504	6/A504		19		
	428	428	OFFICE 15	F	3'-0"	7'-0"	1 3/4"	WOOD	--	ALUM.	5/A504	6/A504		19		
	429	429	OFFICE 16	F	3'-0"	7'-0"	1 3/4"	WOOD	--	ALUM	5/A504	6/A504		19		
	430	430	OFFICE 17	F	3'-0"	7'-0"	1 3/4"	WOOD	--	ALUM.	5/A504	6/A504		19		
	431	431	OFFICE 18	F	3'-0"	7'-0"	1 3/4"	WOOD	--	ALUM.	5/A504	6/A504		19		
	432	432	OFFICE 19	F	3'-0"	7'-0"	1 3/4"	WOOD	--	ALUM.	5/A504	6/A504		19		
	433	433	OFFICE 20	F	3'-0"	7'-0"	1 3/4"	WOOD	--	ALUM.	5/A504	6/A504		19		
	434	434	OFFICE 21	F	3'-0"	7'-0"	1 3/4"	WOOD	--	ALUM.	5/A504	6/A504		19		
	434A	434	OFFICE 21	C	3'-0"	7'-0"	1 3/4"	ALUM.	--	ALUM.	7/A511	5/A507	14/A508	1		
	436	436	RESTROOM	D	3'-0"	7'-0"	1 3/4"	WOOD	--	ALUM	14/A504	15/A504		22		
	437	437	RECEPTION	F	PR.3'-0"	7'-0"	1 3/4"	WOOD	--	ALUM	--	--		14		
	438	438	ELECTRICAL	D	3'-0"	7'-0"	1 3/4"	WOOD	HM1	H.M.	3/A507	4/A507		11		UNDERCUT DOOR 3/4"
	448	448	OPEN OFFICE 1	C	3'-0"	7'-0"	1 3/4"	ALUM	--	ALUM	8/A511	5/A507	14/A508	1		
	449	449	CONFERENCE 4	E	3'-0"	7'-0"	1 3/4"	WOOD	HM1	H.M.	5/A509	4/A507		5	3/4 HR.	
	449A	449	CONFERENCE 4	E	3'-0"	7'-0"	1 3/4"	WOOD	HM1	H.M.	5/A509	4/A507		5	3/4 HR.	
	449B	449	CONFERENCE 4	E	3'-0"	7'-0"	1 3/4"	WOOD	HM1	H.M.	5/A509	4/A507		5	3/4 HR.	
	449C	449	CONFERENCE 4	G	27'-0" +/-	11'-8" +/-	--	VINYL	--	--	12/A508	2/A508				VERIFY SIZE, CENTER STACK
	449D	449	CONFERENCE 4	E	3'-0"	7'-0"	1 3/4"	WOOD	HM1	H.M.	5/A509	4/A507		5	3/4 HR.	
	449E	449	CONFERENCE 4	E	3'-0"	7'-0"	1 3/4"	WOOD	HM1	H.M.	5/A509	4/A507		5	3/4 HR.	
	449F	449	CONFERENCE 4	G	2'1"-0"	12'-0"	--	VINYL	--	--	12/A508	2/A508				VERIFY SIZE, CENTER STACK
	449G	449	CONFERENCE 4	E	3'-0"	7'-0"	1 3/4"	WOOD	HM1	H.M.	5/A509	4/A507		5	3/4 HR.	
	449H	449	CONFERENCE 4	C	3'-0"	7'-0"	1 3/4"	ALUM.	--	ALUM.	8/A511	5/A507	12/A511	1		
	450	450	BREAK	C	3'-0"	7'-0"	1 3/4"	ALUM.	--	ALUM.	8/A511	5/A507	12/A511	1		
	454	454	CONFERENCE 3	H	PR. 3'-0"	7'-0"	1 3/4"	WOOD	--	ALUM.	14/A504	15/A504		14		TRANSOM TO 10'-0" A.F.F. - SEE 7/A701
	454A	454A	CONFERENCE 3	C	3'-0"	7'-0"	1 3/4"	ALUM.	--	ALUM.	8/A511	5/A507	12/A511	1		
	455	455	COMM 1	D	3'-0"	7'-0"	1 3/4"	WOOD	HM1	H.M.	3/A507	4/A507		11		UNDERCUT DOOR 3/4"
	456	456	COMM 2	D	3'-0"	7'-0"	1 3/4"	WOOD	--	ALUM.	14/A504	15/A504		11		UNDERCUT DOOR 3/4"
	457	457	WORK ROOM	E	3'-0"	7'-0"	1 3/4"	WOOD	HM1	H.M.	3/A507	4/A507		11		
	458	458	VEST. 2	D	3'-0"	7'-0"	1 3/4"	WOOD	HM1	H.M.	3/A507	4/A507		17		
	459	459	VEST. 3	D	3'-0"	7'-0"	1 3/4"	WOOD	HM1	H.M.	3/A507	4/A507		17		
	460	460	LIBRARY	F	3'-0"	7'-0"	1 3/4"	WOOD	--	ALUM.	14/A504	15/A504		9		
	460A	460	LIBRARY	F	3'-0"	7'-0"	1 3/4"	WOOD	HM1	H.M.	5/A509	4/A507		9		
	460B	460	LIBRARY	F	3'-0"	7'-0"	1 3/4"	WOOD	HM1	H.M.	5/A509	4/A507		9		
	461	461	BREAK ROOM	E	3'-0"	7'-0"	1 3/4"	WOOD	HM1	H.M.	3/A507	4/A507		11	3/4 HR.	
	461A	461	BREAK ROOM	E	3'-0"	7'-0"	1 3/4"	WOOD	HM1	H.M.	3/A507	4/A507		21		
	461B	461	BREAK ROOM	J	11'-6"	4'-10"	1"		ALUM.	--	ALUM.	3/A508	4/A508	1		
	462	462	STORAGE	D	4'-0"	7'-0"	1 3/4"	WOOD	HM3	H.M.	3/A507	4/A507		8	3/4 HR.	
	462A	462	STORAGE	D	PR. 3'-0"	7'-0"	1 3/4"	WOOD	HM2	H.M.	3/A507	4/A507		12		
	468	468	STORAGE	D	3'-0"	7'-0"	1 3/4"	WOOD	--	ALUM.	14/A504	15/A504		11		
	502	502	STAIR 2	C	3'-0"	7'-0"	1 3/4"	ALUM.	--	ALUM.	5/A507	6/A507				IT"x36" ADJUSTABLE STYLE SADDLE AT THRESH.
	503	503	STAIR 3	C	3'-0"	7'-0"	1 3/4"	ALUM.	--	ALUM.	5/A507	6/A507				IT"x36" ADJUSTABLE STYLE SADDLE AT THRESH.

GENERAL NOTES:

1. "A" LABEL DOORS = 3 HOUR FIRE RATED WITHIN A 4 HOUR FIRE RATED WALL OR PARTITION.
2. "B" LABEL DOORS = 1 1/2 HOUR FIRE RATED WITHIN A 2 HOUR FIRE RATED WALL OR PARTITION.
3. "C" LABEL DOORS = 3/4 HOUR FIRE RATED WITHIN A 1 HOUR FIRE RATED WALL OR PARTITION.

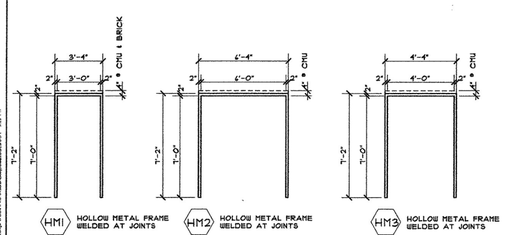

HOLLOW METAL DOOR FRAME TYPES

SCALE: 1/4" = 1' - 0"

POLK STANLEY YEARY ARCHITECTS, LTD.

700 SOUTH SCHILLER
LITTLE ROCK, AR 72201
501 378-0878
FAX 372-7629

21 W. MOUNTAIN, SUITE 227
FAYETTEVILLE, AR 72701
479-444-0473

CONSULTANTS:

OWNER'S PROJECT ADVISOR:
MOSES TUCKER REAL ESTATE, INC.

CIVIL ENGINEER:
McCLELLAND ENGINEERS

LANDSCAPE ARCHITECT:
LARSON BURNS SMITH

STRUCTURAL ENGINEER:
CROMWELL ENGINEERS INC.

MECH., ELEC., PLUMB. ENGINEER:
CROMWELL ENGINEERS INC.

SUSTAINABLE CONSULTANT:
BNIM / ELEMENTS

GLOBAL VILLAGE CONSULTANT
CAMBRIDGE SEVEN ASSOCIATES

INTERIOR DESIGNER:
POLK STANLEY YEARY

GENERAL CONTRACTOR:
CDI CONTRACTORS, INC.

GENERAL NOTES:

NOTES:

ISSUE DATE:
100% G.M.P.
PACKAGE #6
FEBRUARY 2, 2004

REVISIONS:

#	DATE	DESCRIPTION
1	01JULY04	PACKAGE 7

HEIFER INTERNATIONAL CENTER OFFICE BUILDING

LITTLE ROCK, ARKANSAS

PSY PROJECT NUMBER:
431C

CONTENTS:
DOOR AND FRAME SCHEDULE

SHEET NUMBER:
A502

INTERIOR FINISH SCHEDULE

ROOM NUMBER	ROOM NAME	FLOOR: CARPET TILE (A, B, C, & D)	FLOOR: WALK-OFF MAT	FLOOR: CORK TILE	FLOOR: RUBBER	FLOOR: CONCRETE-SEAL	FLOOR: BAMBOO	FLOOR: PORCELAIN TILE	FLOOR: STONE	BASE: 4" RUBBER	BASE: PORCELAIN	BASE: WOOD STAIN	BASE: NONE	WALLS: DO NOT PAINT-STRCL WALL	WALLS: PAINT-GYPSUM BOARD	WALLS: PORCELAIN TILE	WALLS: WOOD PANEL	WALLS: DO NOT PAINT-MASONRY	WALLS: GLASSBLOCK	WALLS: WALLCOVERING	WALLS: ALUM. & GLASS	WALLS: STONE	CLG: PAINT-STRUCTURAL CLG.	CLG: PAINT-GYPSUM BOARD	CLG: WOOD SLATS	CLG: PAINT-STEEL BEAMS ONLY	CLG: NO FINISH
		1	2	3	4	5	6	7	8	1	2	3	4	1	2	3	4	5	6	7	8	9	1	2	3	4	5
	FIRST FLOOR																										
101	STAIR 1					5							4									8	9	1				
102	STAIR 2					5							4									8	9	1				
103	STAIR 3					5							4									8		1				
104	MECHANICAL 1					5							4														5
105	MECHANICAL 2					5							4														5
106	MAIN VEST.		2				6				3			2								1					
107	CONFERENCE 2	1-C						1														8	9	2				
108	ENCLAVE	1-A						1				2										1						
109	ELEVATOR LOBBY						6		8		4			4								8	9	1	3			
110	MEN						7		2			2	3		6										2			
111	WOMEN						7		2			2	3		6										2			
112	BREAK AREA			3										4								9	1					
113	NOT USED																										
114	OFFICE 1	1-A						1				2										8		1				
115	OFFICE 2	1-A						1				2										8		1				
116	OFFICE 3	1-A						1				2										8		1				
117	OFFICE 4	1-A						1				2										8		1				
118	OFFICE 5	1-A						1				2										8		1				
119	OFFICE 6	1-A						1				2										8		1				
120	OFFICE 7	1-A						1				2										8		1				
121	OFFICE 8	1-A						1				2										8		1				
122	OFFICE 9	1-A						1				2										8		1				
123	OFFICE 10	1-A						1				2										8		1				
124	OFFICE 11	1-A						1				2										8		1				
125	OFFICE 12	1-A						1				2										8		1				
126	OFFICE 13	1-A						1				2										8		1				
127	OFFICE 14	1-A						1				2										8		1				
128	OFFICE 15	1-A						1				2										8		1				
129	OFFICE 16	1-A						1				2										8		1				
130	OFFICE 17	1-A						1				2										8		1				
131	CONF 4	1-A						1				2										8		1				
132	DOCK					5												5										4
133	OPEN OFFICES 3	1-A						1			1	2										8		1				
134	VESTIBULE 1		2				6			4	1											8	9	1				
135	NOT USED																										
136	NOT USED																										
137	NOT USED																										
138	ELEC					5			1			2																5
139	ELEV. CONTROL					5							5									1						5
140	NOT USED																										
141	NOT USED																										
142	JANITOR						7		2		1	2																3
143	RECYCLE					5							5									1						5
144	LOBBY						6		8		4			4								8	9	1				
145	NOT USED																										
146	NOT USED																										
147	NOT USED																										
148	OPEN OFFICES 1	1-A						1				2										8		1				
149	OPEN OFFICES 2	1-A						1				2										8		1				
150	GIFT SHOP	1-A						1				2												1				
151	COMM 1					5			1			2												1				
152	VEST 2						7		2			2														2		
153	VEST 3						7		2			2														2		
154	MAIL					5				4		2		5														4
155	NOT USED																										
156	FILES	1-A						1				2												1				
	SECOND FLOOR																										
201	STAIR 1					5							4									8	9	1				
202	STAIR 2					5							4									8	9	1				
203	STAIR 3					5							4									8		1				
204	MECHANICAL 1					5							4	1													5
205	MECHANICAL 2					5							4	1													5
206	CONFERENCE 1	1-B																									
207	CONFERENCE 2	1-C						1						2								8	9	1				
208	CONFERENCE 3	1-C						1						2								8	9	1				
209	ELEVATOR LOBBY						6				4				4							8	9	1	3			
210	MEN						7			2		2	3		6					2								
211	WOMEN						7			2		2	3		6					2								
212	VESTIBULE 1						6			4												8	9	1	3			
213	JANITOR						7			2		1	2															5
214	OFFICE 1	1-A						1				2										8		1				
215	OFFICE 2	1-A						1				2										8		1				
216	OFFICE 3	1-A						1				2										8		1				
217	OFFICE 4	1-A						1				2										8		1				
218	OFFICE 5	1-A						1				2										8		1				
219	OFFICE 6	1-A						1				2										8		1				
220	OFFICE 7	1-A						1				2										8		1				
221	OFFICE 8	1-A						1				2										8		1				
222	OFFICE 9	1-A						1				2										8		1				
223	OFFICE 10	1-A						1				2										8		1				
224	OFFICE 11	1-A						1				2										8		1				
225	OFFICE 12	1-A						1				2										8		1				
226	OFFICE 13	1-A						1				2										8		1				
227	OFFICE 14	1-A						1				2										8		1				
228	OFFICE 15	1-A						1				2										8		1				
229	OFFICE 16	1-A						1				2										8		1				
230	OFFICE 17	1-A						1				2										8		1				
231	OFFICE 18	1-A						1				2										8		1				
232	OFFICE 19	1-A						1				2										8		1				
233	OFFICE 20	1-A						1				2										8		1				
234	OFFICE 21	1-A						1				2										8		1				
235	OFFICE 22	1-A						1				2										8		1				
236	NOT USED																										
237	NOT USED																										
238	ELEC.						5				1				2													5
239	NOT USED																										
240	NOT USED																										
241	NOT USED																										
242	NOT USED																										
243	NOT USED																										
244	CORRIDOR 1						6				3		2	4								8		1	3			
245	CORRIDOR 2	1-A						1				4										8	9	1				
246	CORRIDOR 3	1-A						1				4										8	9	1				
247	BRIDGE						6														3							
248	OPEN OFFICES 1	1-A						1			1	2										8		1				
249	OPEN OFFICES 2	1-A						1			1	2										8		1				
250	BREAK				3							4											9	1				
251	SERVER ROOM						5				1				2									1				
252	CORRIDOR 4	1-A						1				2											9	1				
253	CONFERENCE 5	1-D										4										8	9	1				
254	CONFERENCE 6	1-D										4										8	9	1				
255	COMM 1						5				1				2									1				5
256	COMM 2						5				1				2									1				5
257	WORK ROOM	1-A						1							2									1				
258	VEST. 2								7		2		1	2										1	2			
259	VEST. 3								7		2			2										1	2			
260	ELEVATOR CONTRL. PNL.																										
	THIRD FLOOR																										
301	STAIR 1						5						4									8	9	1				
302	STAIR 2						5						4									8	9	1				
303	STAIR 3						5						4									8		1				
304	MECHANICAL 1						5						4	1													5
305	MECHANICAL 2						5						4	1													5
306	CONFERENCE 1	1-B																									
307	CONFERENCE 2	1-C						1						2								8	9	1				
308	CONFERENCE 3	1-C						1						2								8	9	1				
309	ELEVATOR LOBBY						6				4				4							8	9	1	3			
310	MEN						7			2		2	3		6					2								
311	WOMEN						7			2		2	3		6					2								
312	VESTIBULE 1						6			4												8	9	1	3			
313	JANITOR						7			2		1	2															5
314	OFFICE 1	1-A						1				2										8		1				
315	OFFICE 2	1-A						1				2										8		1				
316	OFFICE 3	1-A						1				2										8		1				
317	OFFICE 4	1-A						1				2										8		1				
318	OFFICE 5	1-A						1				2										8		1				
319	OFFICE 6	1-A						1				2										8		1				
320	OFFICE 7	1-A						1				2										8		1				
321	OFFICE 8	1-A						1				2										8		1				
322	OFFICE 9	1-A						1				2										8		1				
323	OFFICE 10	1-A						1				2										8		1				
324	OFFICE 11	1-A						1				2										8		1				
325	OFFICE 12	1-A						1				2										8		1				
326	OFFICE 13	1-A						1				2										8		1				
327	OFFICE 14	1-A						1				2										8		1				
328	OFFICE 15	1-A						1				2										8		1				
329	OFFICE 16	1-A						1				2										8		1				
330	OFFICE 17	1-A						1				2										8		1				
331	OFFICE 18	1-A						1				2										8		1				
332	OFFICE 19	1-A						1				2										8		1				
333	OFFICE 20	1-A						1				2										8		1				
334	OFFICE 21	1-A						1				2										8		1				
335	OFFICE 22	1-A						1				2										8		1				
336	NOT USED																										
337	NOT USED																										
338	ELECTRICAL 1						5				1				2													5
339	NOT USED																										
340	NOT USED																										
341	NOT USED																										
342	NOT USED																										
343	NOT USED																										
344	CORRIDOR 1						6				3		2	4								8		1	3			
345	CORRIDOR 2	1-A						1				4										8	9	1				
346	CORRIDOR 3	1-A						1				4										8	9	1				
347	BRIDGE						6														3							
348	OPEN OFFICES 1	1-A						1			1	2										8		1				
349	OPEN OFFICES 2	1-A						1			1	2										8		1				
350	BREAK				3							4											9	1				
351	SERVER ROOM						5				1				2									1				
352	CORRIDOR 4	1-A						1				2											9	1				
353	CONFERENCE 5	1-D										4										8	9	1				
354	CONFERENCE 4	1-D										4										8	9	1				
355	COMM 1						5				1				2									1				5
356	COMM 2						5				1				2									1				5
357	WORKROOM	1-A						1				2												1				
358	VESTIBULE 2								7		2		1	2										1	2			
359	VESTIBULE 3								7		2			2										1	2			
	FOURTH FLOOR																										
401	STAIR 1						5						4									8	9	1				
402	STAIR 2						5						4									8	9	1				
403	STAIR 3						5						4									8		1				
404	MECHANICAL 1						5						4					5						1				6
405	MECHANICAL 2						5						4					5						1				6
406	CONFERENCE 1	1-B																									
407	CONFERENCE 2	1-C						1						1								8	9	1				
408	NOT USED																										
409	ELEVATOR LOBBY						6				4				4							8	9	1	3			
410	MEN						7			2		2	3		6					2								
411	WOMEN						7			2		2	3		6					2								
412	VESTIBULE 1						6			4												8	9	1	3			
413	JANITOR						7			2			2															5
414	OFFICE 1	1-A						1				2										8		1				
415	OFFICE 2	1-A						1				2										8		1				
416	OFFICE 3	1-A						1				2										8		1				
417	OFFICE 4	1-A						1				2										8		1				
418	OFFICE 5	1-A						1				2										8		1				
419	OFFICE 6	1-A						1				2										8		1				
420	OFFICE 7	1-A						1				2										8		1				
421	OFFICE 8	1-A						1				2										8		1				
422	OFFICE 9	1-A						1				2										8		1				
423	OFFICE 10	1-A						1				2										8		1				
424	OFFICE 11	1-A						1				2										8		1				
425	OFFICE 12	1-A						1				2										8		1				
426	OFFICE 13	1-A						1				2										8		1				
427	OFFICE 14	1-A						1				2										8		1				
428	OFFICE 15	1-A						1				2										8		1				
429	OFFICE 16	1-A						1				2										8		1				
430	OFFICE 17	1-A						1				2										8		1				
431	OFFICE 18	1-A						1				2										8		1				
432	OFFICE 19	1-A						1				2										8		1				
433	OFFICE 20	1-A						1				2										8		1				
434	OFFICE 21	1-A						1				2										8		1				
435	OFFICE 22	1-A						1				2										8		1				
436	RESTROOM																			7			2					
437	RECEPTION	1-A						1				2										8		1				
438	ELECTRICAL 1						5				1				2													5
439	NOT USED																										
440	NOT USED																										
441	NOT USED																										
442	NOT USED																										
443	NOT USED																										
444	CORRIDOR 1						6					3		2								8		1				6
445	CORRIDOR 2	1-A						1						2								8	9	1				6
446	CORRIDOR 3	1-A						1						2								8	9	1				6
447	BRIDGE						6								4													
448	OPEN OFFICES 1	1-A						1						2								8		1				6
449	CONFERENCE 4	1-A						1						2								8		1				6
450	BREAK			3																			9	1				6
451	NOT USED																										
452	NOT USED																										
453	NOT USED																										
454	CONFERENCE 3	1-D										1			2							8	9	1				6
455	COMM 1						5				1				2									1				5
456	COMM 2						5				1				2									1				5
457	WORKROOM	1-A						1				2												1				6
458	VESTIBULE 2									7		2		2										1	2			
459	VESTIBULE 3									7		2		2										1	2			
460	LIBRARY	1-A						1				2										8		1				6
461	BREAK ROOM			3																				1				
462	STORAGE						5					1			2									1				
	FIFTH FLOOR																										
501	STAIR 1						5															8		1				
502	STAIR 2						5															8		1				
503	STAIR 3						5															8		1				

GENERAL NOTES (ALL LEVELS):

1. DO NOT PROVIDE WALL BASE FOR STONE OR WOOD PANELING
2. SEE SPECIFICATIONS FOR ALTERNATES.

POLK STANLEY YEARY
ARCHITECTS, LTD.

700 SOUTH SCHILLER
LITTLE ROCK, AR 72201
501 378-0878
FAX 372-7629

21 W. MOUNTAIN, SUITE 227
FAYETTEVILLE, AR 72701
479-444-0473

CONSULTANTS:

OWNER'S PROJECT ADVISOR:
MOSES TUCKER REAL ESTATE, INC.

CIVIL ENGINEER:
McCLELLAND ENGINEERS

LANDSCAPE ARCHITECT:
LARSON BURNS SMITH

STRUCTURAL ENGINEER:
CROMWELL ENGINEERS INC.

MECH., ELEC., PLUMB. ENGINEER:
CROMWELL ENGINEERS INC.

SUSTAINABLE CONSULTANT:
BNIM / ELEMENTS

GLOBAL VILLAGE CONSULTANT
CAMBRIDGE SEVEN ASSOCIATES

INTERIOR DESIGNER:
POLK STANLEY YEARY

GENERAL CONTRACTOR:
CDI CONTRACTORS, INC.

GENERAL NOTES:

NOTES:

ISSUE DATE:
100% G.M.P.
PACKAGE #6
FEBRUARY 2, 2004

REVISIONS:

#	DATE	DESCRIPTION
1	01JUN04	PACKAGE 7

HEIFER INTERNATIONAL CENTER OFFICE BUILDING

LITTLE ROCK, ARKANSAS

PSY PROJECT NUMBER:
431C

POLK STANLEY YEARY ARCHITECTS, LTD. CORPORATE SEAL REGISTERED ARKANSAS

CONTENTS:
INTERIOR FINISH SCHEDULE

SHEET NUMBER:
A503

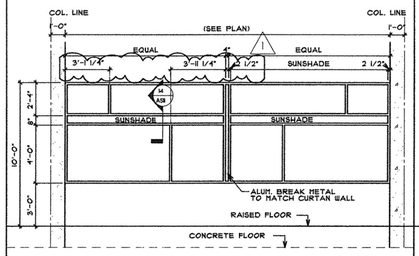

A1 EXTERIOR ALUMINUM FRAME WITH GLASS.
GLAZING: TYPE GL-1 UNLESS NOTED OTHERWISE

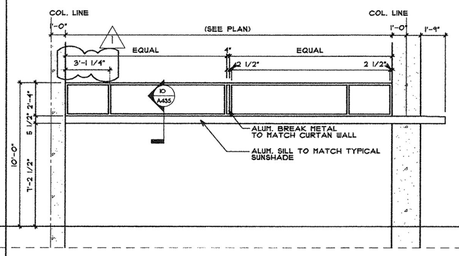

A2 EXTERIOR ALUMINUM FRAME WITH GLASS.
GLAZING: TYPE GL-1 UNLESS NOTED OTHERWISE

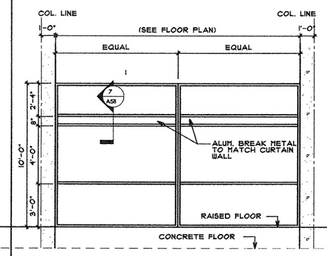

A3 EXTERIOR ALUMINUM FRAME WITH GLASS.
GLAZING: TYPE GL-1 UNLESS NOTED OTHERWISE

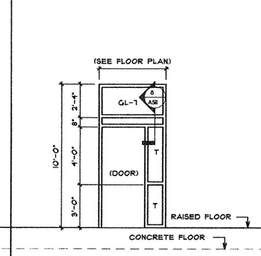

A4 EXTERIOR ALUMINUM FRAME WITH GLASS.

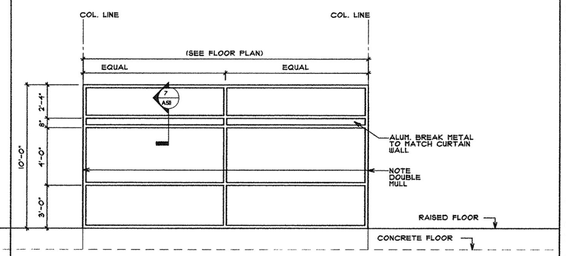

A5 EXTERIOR ALUMINUM FRAME WITH GLASS.
GLAZING: TYPE GL-1 UNLESS NOTED OTHERWISE

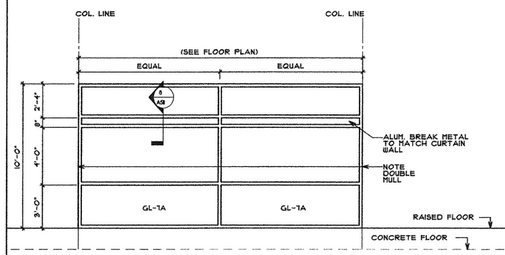

A5.1 EXTERIOR ALUMINUM FRAME WITH GLASS.
GLAZING: TYPE GL-1 UNLESS NOTED OTHERWISE

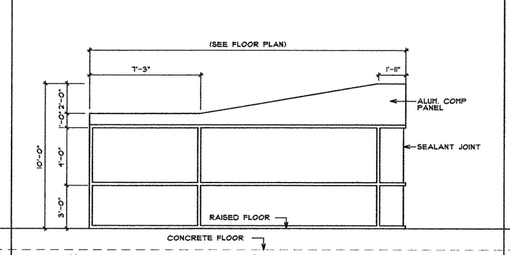

A6 EXTERIOR ALUMINUM FRAME WITH GLASS.
GLAZING: TYPE GL-1 UNLESS NOTED OTHERWISE

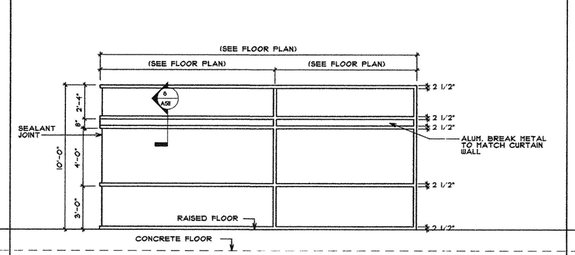

A7 EXTERIOR ALUMINUM FRAME WITH GLASS.
GLAZING: TYPE GL-1 UNLESS NOTED OTHERWISE

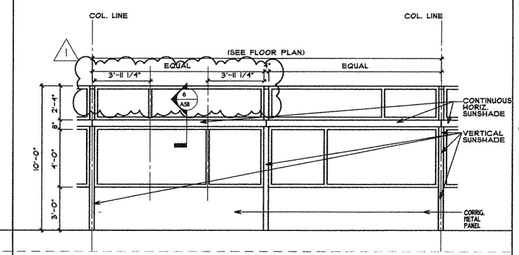

A8 EXTERIOR ALUMINUM FRAME WITH GLASS.
GLAZING: TYPE GL-1 UNLESS NOTED OTHERWISE

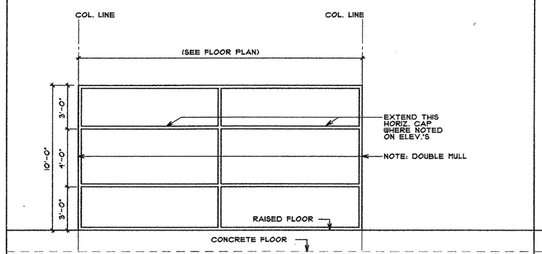

A9 EXTERIOR ALUMINUM FRAME WITH GLASS.
GLAZING: TYPE GL-1 UNLESS NOTED OTHERWISE

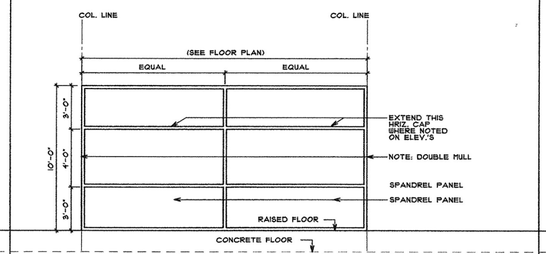

A9.1 EXTERIOR ALUMINUM FRAME WITH GLASS.
GLAZING: TYPE GL-1 UNLESS NOTED OTHERWISE

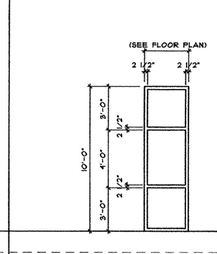

A10 EXTERIOR ALUMINUM FRAME WITH GLASS.
GLAZING: TYPE GL-1 UNLESS NOTED OTHERWISE

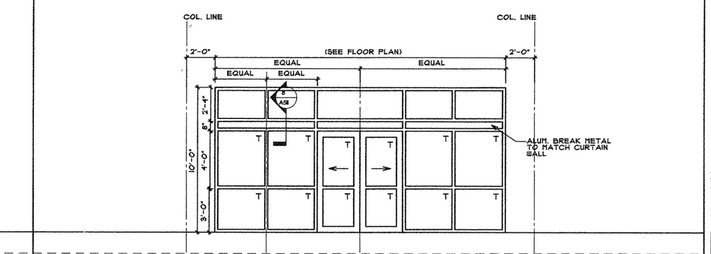

A11 EXTERIOR ALUMINUM FRAME WITH GLASS.
GLAZING: TYPE GL-1 UNLESS NOTED OTHERWISE

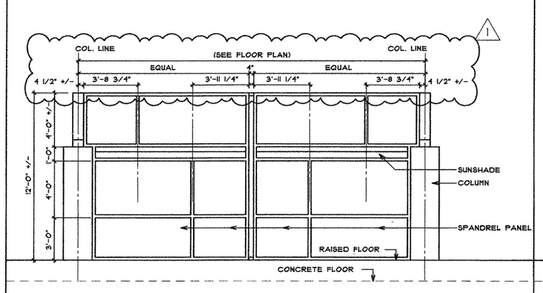

A12 EXTERIOR ALUMINUM FRAME WITH GLASS.
GLAZING: TYPE GL-1 UNLESS NOTED OTHERWISE

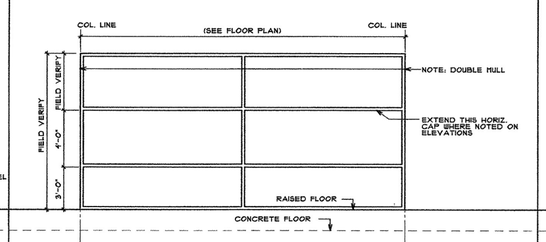

A13 EXTERIOR ALUMINUM FRAME WITH GLASS.
GLAZING: TYPE GL-1 UNLESS NOTED OTHERWISE

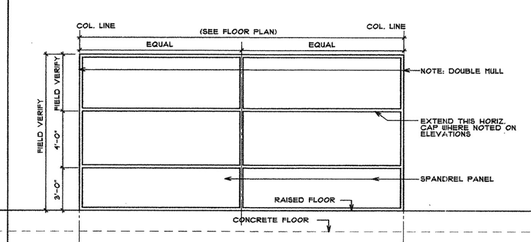

A13.1 EXTERIOR ALUMINUM FRAME WITH GLASS.
GLAZING: TYPE GL-1 UNLESS NOTED OTHERWISE

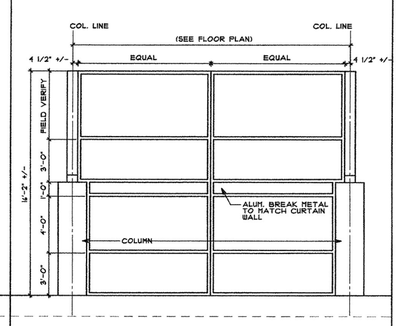

A14 EXTERIOR ALUMINUM FRAME WITH GLASS.
(FIRST FLOOR - SOUTH FACING, SOUTH ENTRANCE)
(FOURTH FLOOR - SOUTH FACING, SOUTH ENTRANCE)

GL-1 : 1" INSULATED
GL-1A: 1" INSULATED SPANDREL PANEL
T: TEMPERED

GLASS SCHEDUALE

POLK
STANLEY
YEARY
ARCHITECTS, LTD.

700 SOUTH SCHILLER
LITTLE ROCK, AR 72201
501 378-0878
FAX 372-7629

21 W. MOUNTAIN, SUITE 227
FAYETTEVILLE, AR 72701
479-444-0473

CONSULTANTS:

OWNER'S PROJECT ADVISOR:
MOSES TUCKER REAL ESTATE, INC.

CIVIL ENGINEER:
McCLELLAND ENGINEERS

LANDSCAPE ARCHITECT:
LARSON BURNS SMITH

STRUCTURAL ENGINEER:
CROMWELL ENGINEERS INC.

MECH., ELEC., PLUMB. ENGINEER:
CROMWELL ENGINEERS INC.

SUSTAINABLE CONSULTANT:
BNIM / ELEMENTS

GLOBAL VILLAGE CONSULTANT
CAMBRIDGE SEVEN ASSOCIATES

INTERIOR DESIGNER:
POLK STANLEY YEARY

GENERAL CONTRACTOR:
CDI CONTRACTORS, INC.

GENERAL NOTES:

NOTES:

ISSUE DATE:
CORE/SHELL
PACKAGE #5
DECEMBER 15, 2003

REVISIONS:

#	DATE	DESCRIPTION
1	04JUL04	PACKAGE #1

HEIFER INTERNATIONAL CENTER OFFICE BUILDING

LITTLE ROCK, ARKANSAS

PSY PROJECT NUMBER:
431C

CONTENTS:
WINDOW SCHEDULE
SCALE 1/4" = 1'-0"

SHEET NUMBER:
A504a

P:\10-DSGN\10CAD\ArchDrawings\CDs\Arch\A504a-Window Schedule.dwg Friday, June 18, 2004 2:41 PM

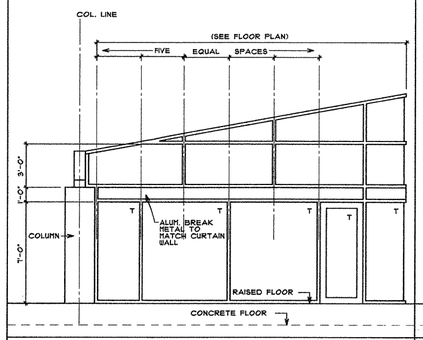

A15 EXTERIOR ALUMINUM FRAME WITH GLASS.
GLAZING: TYPE GL-1 UNLESS NOTED OTHERWISE

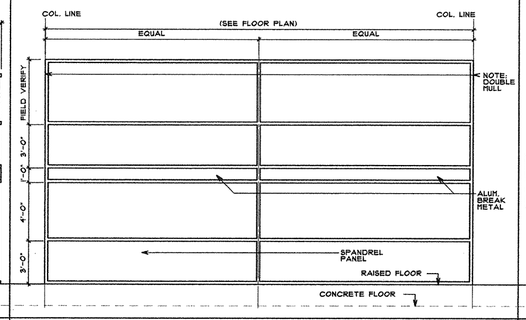

A16 EXTERIOR ALUMINUM FRAME WITH GLASS.
GLAZING: TYPE GL-1 UNLESS NOTED OTHERWISE

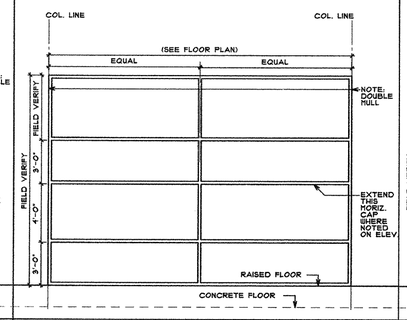

A17 EXTERIOR ALUMINUM FRAME WITH GLASS.
GLAZING: TYPE GL-1 UNLESS NOTED OTHERWISE

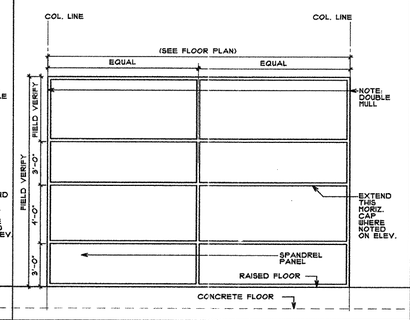

A17. EXTERIOR ALUMINUM FRAME WITH GLASS.
GLAZING: TYPE GL-1 UNLESS NOTED OTHERWISE

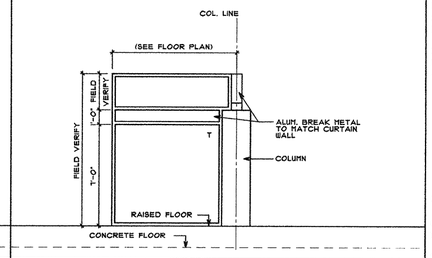

A18 EXTERIOR ALUMINUM FRAME WITH GLASS.
GLAZING: TYPE GL-1 UNLESS NOTED OTHERWISE

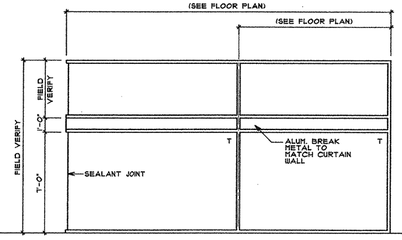

A19 EXTERIOR ALUMINUM FRAME WITH GLASS.
GLAZING: TYPE GL-1 UNLESS NOTED OTHERWISE

GL-1 : 1" INSULATED
GL-1A: 1" INSULATED SPANDREL PANEL
T: TEMPERED

GLASS SCHEDULE

POLK
STANLEY
YEARY
ARCHITECTS, LTD.

700 SOUTH SCHILLER
LITTLE ROCK, AR 72201
501 378-0878
FAX 372-7629

21 W. MOUNTAIN, SUITE 227
FAYETTEVILLE, AR 72701
479-444-0473

CONSULTANTS:

OWNER'S PROJECT ADVISOR:
MOSES TUCKER REAL ESTATE, INC.

CIVIL ENGINEER:
McCLELLAND ENGINEERS

LANDSCAPE ARCHITECT:
LARSON BURNS SMITH

STRUCTURAL ENGINEER:
CROMWELL ENGINEERS INC.

MECH., ELEC., PLUMB. ENGINEER:
CROMWELL ENGINEERS INC.

SUSTAINABLE CONSULTANT:
BNIM / ELEMENTS

GLOBAL VILLAGE CONSULTANT
CAMBRIDGE SEVEN ASSOCIATES

INTERIOR DESIGNER:
POLK STANLEY YEARY

GENERAL CONTRACTOR:
CDI CONTRACTORS, INC.

GENERAL NOTES:

NOTES:

ISSUE DATE:
CORE/SHELL
PACKAGE #5
DECEMBER 15, 2003

REVISIONS:

#	DATE	DESCRIPTION

HEIFER INTERNATIONAL CENTER OFFICE BUILDING

LITTLE ROCK, ARKANSAS

PSY PROJECT NUMBER:
431C

CONTENTS:
WINDOW SCHEDULE
SCALE 1/4" = 1'-0"

SHEET NUMBER:
A504b

P:\C-DOCS\431C\CAD\Drawings\Arch\A504b-Window Sched.dgn Thursday, July 01, 2004 10:33 am

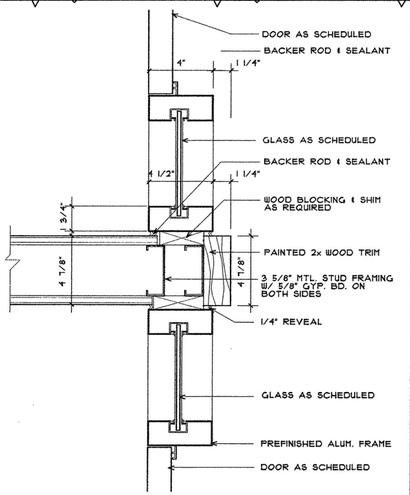

1 ALUM. STOREFRONT - DOOR DTL.
SCALE: 3" = 1' - 0"

2 NOT USED
SCALE: 3" = 1' - 0"

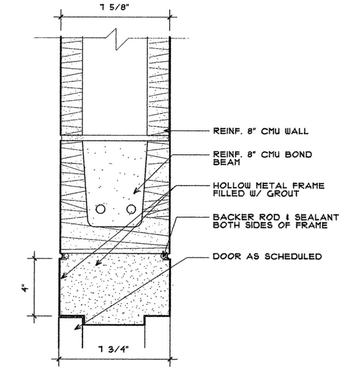

3 H.M. DOOR FRAME - HEAD DTL.
SCALE: 3" = 1' - 0"

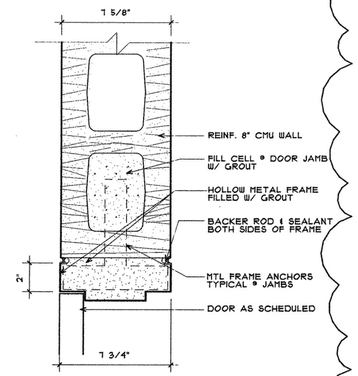

4 H.M. DOOR FRAME - JAMB DTL.
SCALE: 3" = 1' - 0"

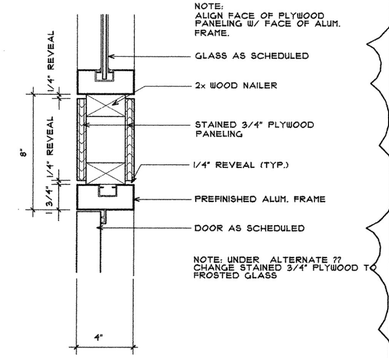

5 ALUM. STOREFRONT - MULL DTL.
SCALE: 3" = 1' - 0"

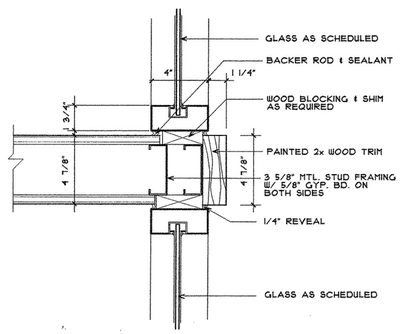

6 ALUM. STOREFRONT - MULL DTL.
SCALE: 3" = 1' - 0"

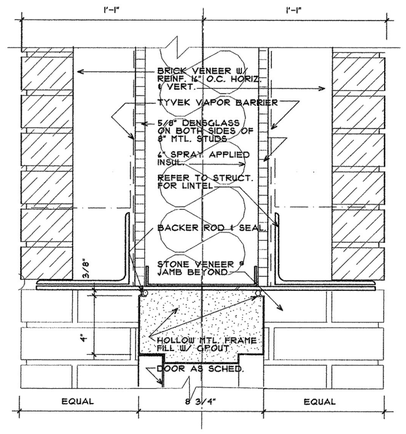

7 H.M. DOOR FRAME - HEAD DTL.
SCALE: 3" = 1' - 0"

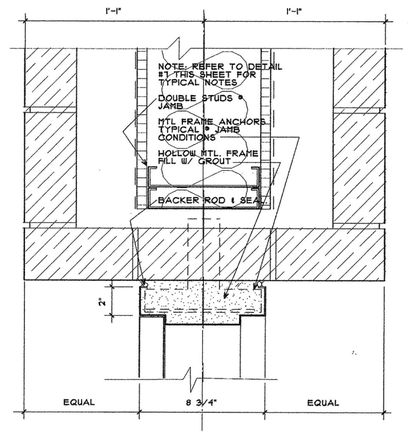

8 H.M. DOOR FRAME - JAMB DTL.
SCALE: 3" = 1' - 0"

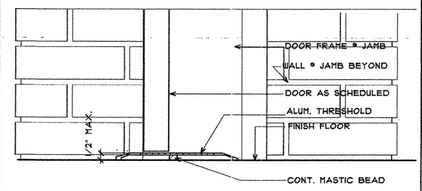

9 ALUM. THRESHOLD DETAIL
SCALE: 3" = 1' - 0"

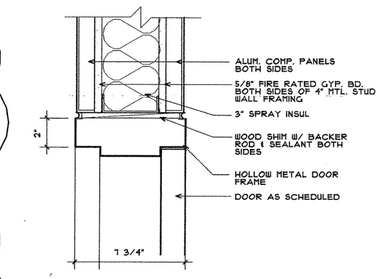

10 H.M. DOOR FRAME - HEAD DTL.
SCALE: 3" = 1' - 0"

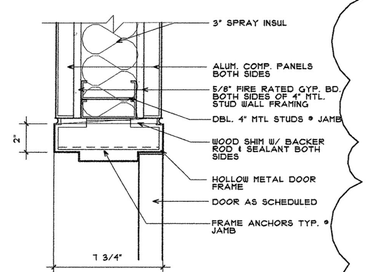

11 H.M. DOOR FRAME - JAMB DTL.
SCALE: 3" = 1' - 0"

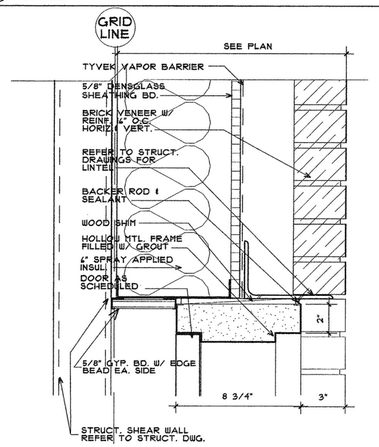

12 H.M. DOOR FRAME - HEAD DTL.
SCALE: 3" = 1' - 0"

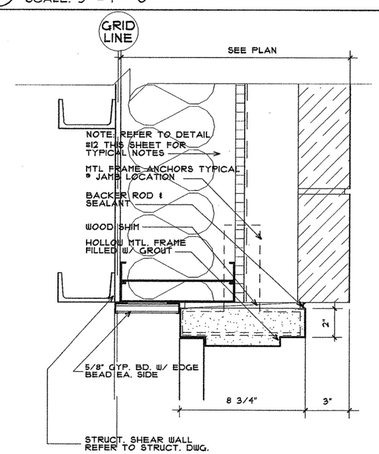

13 H.M. DOOR FRAME - JAMB DTL.
SCALE: 3" = 1' - 0"

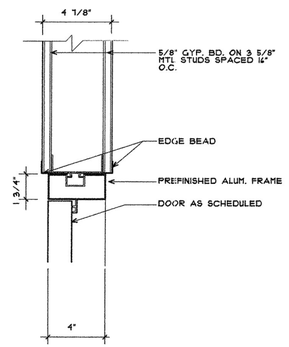

14 ALUM. STOREFRONT - HEAD DTL.
SCALE: 3" = 1' - 0"

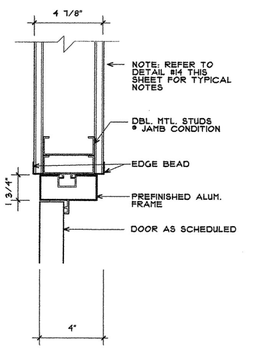

15 ALUM. STOREFRONT - JAMB DTL.
SCALE: 3" = 1' - 0"

POLK
STANLEY
YEARY
ARCHITECTS, LTD.

700 SOUTH SCHILLER
LITTLE ROCK, AR 72201
501 378-0878
FAX 372-7629

21 W. MOUNTAIN, SUITE 227
FAYETTEVILLE, AR 72701
479-444-0473

CONSULTANTS:

OWNER'S PROJECT ADVISOR:
MOSES TUCKER REAL ESTATE, INC.

CIVIL ENGINEER:
McCLELLAND ENGINEERS

LANDSCAPE ARCHITECT:
LARSON BURNS SMITH

STRUCTURAL ENGINEER:
CROMWELL ENGINEERS INC.

MECH., ELEC., PLUMB. ENGINEER:
CROMWELL ENGINEERS INC.

SUSTAINABLE CONSULTANT:
BNIM / ELEMENTS

GLOBAL VILLAGE CONSULTANT
CAMBRIDGE SEVEN ASSOCIATES

INTERIOR DESIGNER:
POLK STANLEY YEARY

GENERAL CONTRACTOR:
CDI

GENERAL NOTES:

NOTES:

ISSUE DATE:
100% G.M.P.
PACKAGE #6
FEBRUARY 2, 2004

REVISIONS:

#	DATE	DESCRIPTION
1	JULY 04	PACKAGE #7

HEIFER INTERNATIONAL CENTER OFFICE BUILDING

LITTLE ROCK, ARKANSAS

PSY PROJECT NUMBER:
431C

REGISTERED ARCHITECT
ROBERT CURZON POLK
No. 1397
ARKANSAS
POLK STANLEY YEARY ARCHITECTS, LTD. CORPORATE SEAL

CONTENTS:
DOOR DETAILS

SHEET NUMBER:

A506

P:\LR-DWG\431C\Cad Files\Drawings\For Dsn\For Arch\A506-HollowMetalDoorFrameDetails Thursday, July 01, 2004

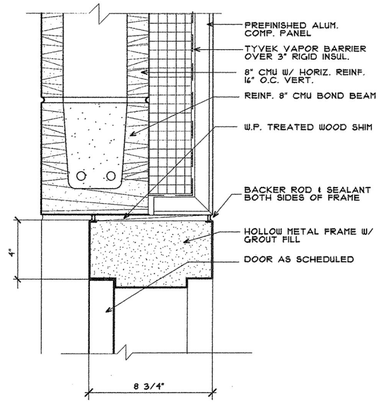

1 H.M. DOOR FRAME - HEAD DTL.
SCALE: 3" = 1' - 0"

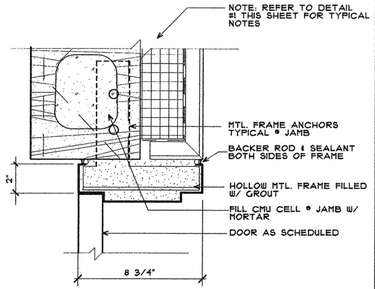

2 H.M. DOOR FRAME -JAMB DTL.
SCALE: 3" = 1' - 0"

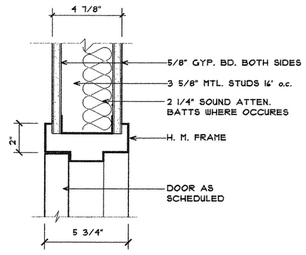

3 H.M. DOOR FRAME - HEAD DTL.
SCALE: 3" = 1' - 0"

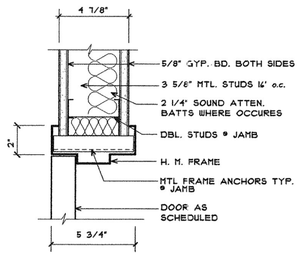

4 H.M. DOOR FRAME - JAMB DTL.
SCALE: 3" = 1' - 0"

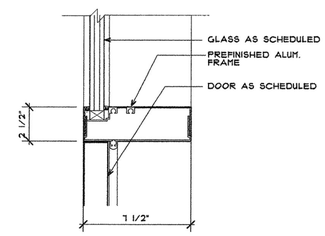

5 ALUM. CURTAINWALL - MULL DTL.
SCALE: 3" = 1' - 0"

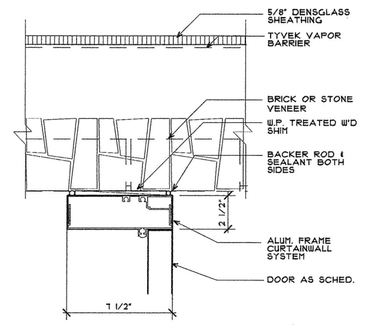

6 ALUM. CURTAINWALL - JAMB DTL.
SCALE: 3" = 1' - 0"

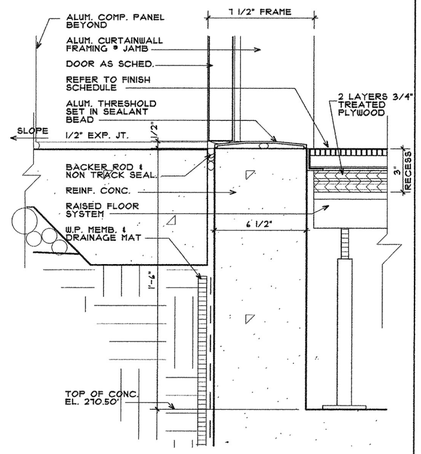

7 ALUM. THRESHOLD DTL.
SCALE: 3" = 1' - 0"

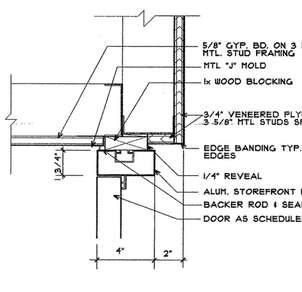

8 ALUM. STOREFRONT - HEAD DTL.
SCALE: 3" = 1' - 0"

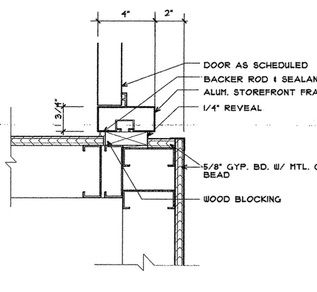

9 ALUM. STOREFRONT - JAMB DTL.
SCALE: 3" = 1' - 0"

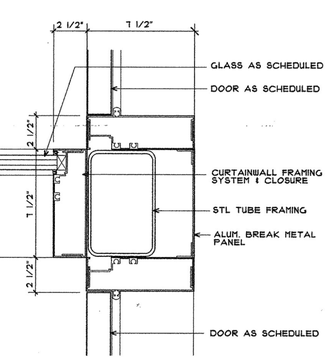

10 ALUM. CURTAINWALL - MULL DTL.
SCALE: 3" = 1' - 0"

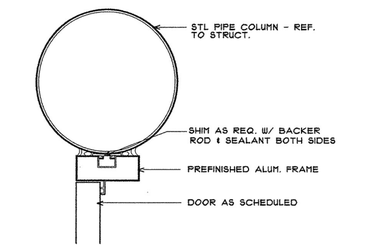

11 ALUM. STOREFRONT - JAMB DTL.
SCALE: 3" = 1' - 0"

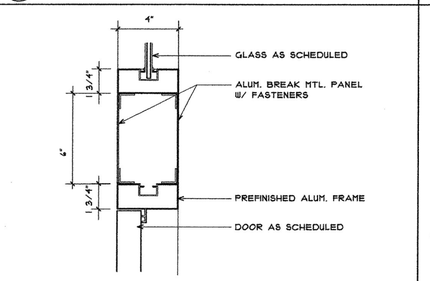

12 ALUM. STOREFRONT - MULL DTL.
SCALE: 3" = 1' - 0"

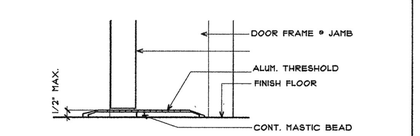

13 ALUM. THRESHOLD DETAIL
SCALE: 3" = 1' - 0"

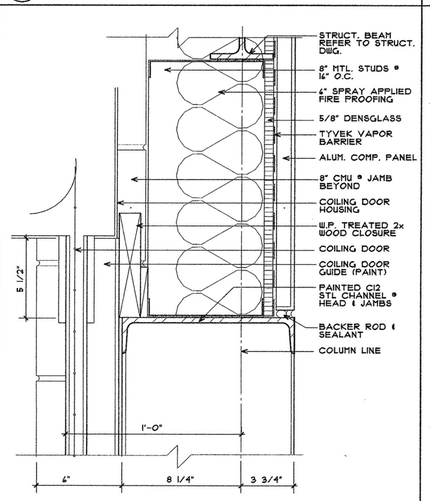

14 COILING DOOR - HEAD DTL.
SCALE: 3" = 1' - 0"

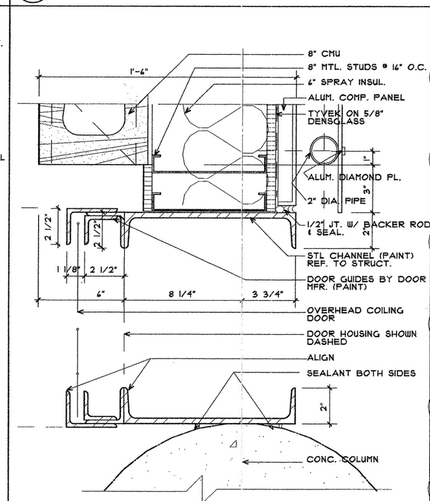

15 COILING DOOR -JAMB DTL.
SCALE: 3" = 1' - 0"

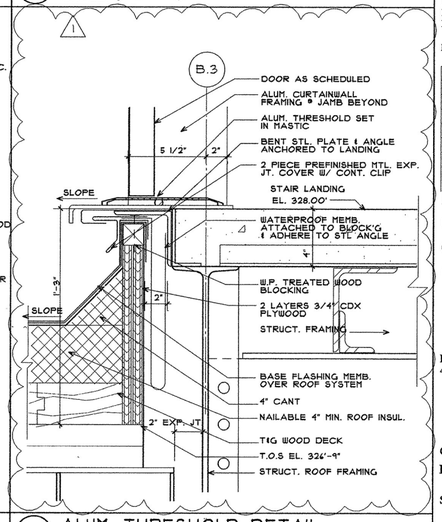

16 ALUM. THRESHOLD DETAIL
SCALE: 3" = 1' - 0"

POLK
STANLEY
YEARY
ARCHITECTS, LTD.

700 SOUTH SCHILLER
LITTLE ROCK, AR 72201
501 378-0878
FAX 372-7629

21 W. MOUNTAIN, SUITE 227
FAYETTEVILLE, AR 72701
479-444-0473

CONSULTANTS:

OWNER'S PROJECT ADVISOR:
MOSES TUCKER REAL ESTATE, INC.

CIVIL ENGINEER:
McCLELLAND ENGINEERS

LANDSCAPE ARCHITECT:
LARSON BURNS SMITH

STRUCTURAL ENGINEER:
CROMWELL ENGINEERS INC.

MECH., ELEC., PLUMB. ENGINEER:
CROMWELL ENGINEERS INC.

SUSTAINABLE CONSULTANT:
BNIM / ELEMENTS

GLOBAL VILLAGE CONSULTANT
CAMBRIDGE SEVEN ASSOCIATES

INTERIOR DESIGNER:
POLK STANLEY YEARY

GENERAL CONTRACTOR:
CDI

GENERAL NOTES:

NOTES:

ISSUE DATE:
100% G.M.P.
PACKAGE #6
FEBRUARY 2, 2004

REVISIONS:

#	DATE	DESCRIPTION
1	JULY 04	PACKAGE #7

HEIFER INTERNATIONAL CENTER OFFICE BUILDING

LITTLE ROCK, ARKANSAS

PSY PROJECT NUMBER:
431C

CONTENTS:
DOOR DETAILS

SHEET NUMBER:

A507

P:\10-DWG\431C\CA\Final Drawings For DA's\Final\A507-HollowMetalDoorFrameDetailsThursday, July 01, 2004 9:35 AM

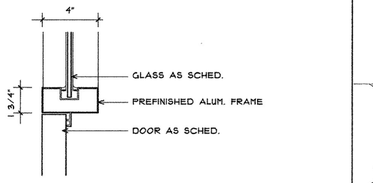

1 ALUM. STOREFRONT - MULL DTL.
SCALE: 3" = 1' - 0"

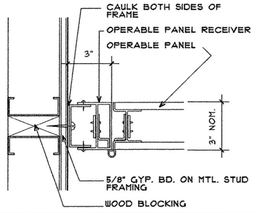

2 OPERABLE PART. - JAMB DTL.
SCALE: 3" = 1' - 0"

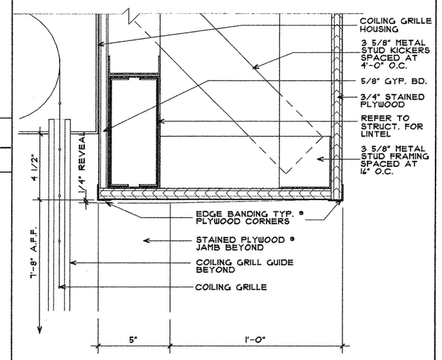

3 CEILING GRILLE - HEAD DTL.
SCALE: 3" = 1' - 0"

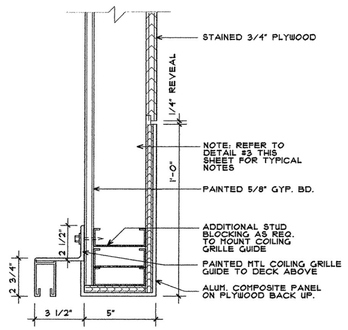

4 CEILING GRILLE - JAMB DTL.
SCALE: 3" = 1' - 0"

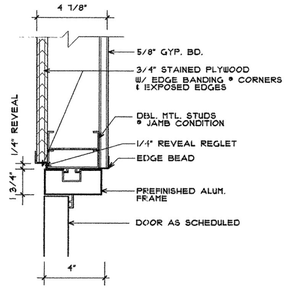

5 ALUM. STOREFRONT - JAMB DTL.
SCALE: 3" = 1' - 0"

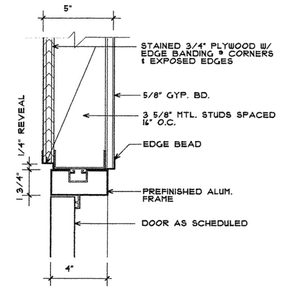

6 ALUM. STOREFRONT - HEAD DTL.
SCALE: 3" = 1' - 0"

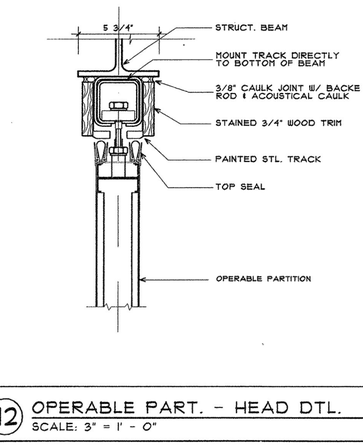

7 ALUM. CURTAINWALL - JAMB DTL.
SCALE: 3" = 1' - 0"

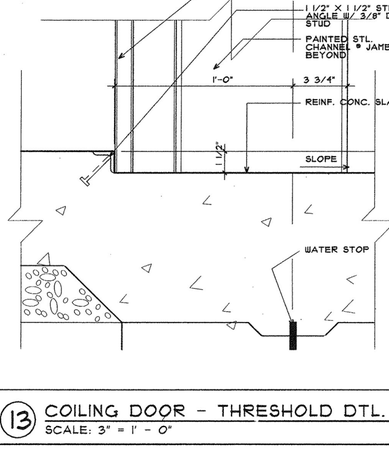

8 ALUM. CURTAINWALL - HEAD DTL.
SCALE: 3" = 1' - 0"

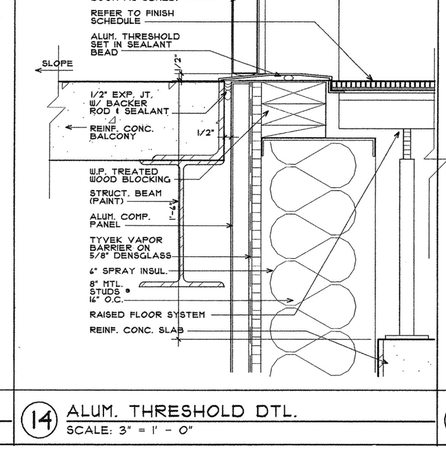

9 WOOD DOOR FRAME - HEAD DTL.
SCALE: 3" = 1' - 0"

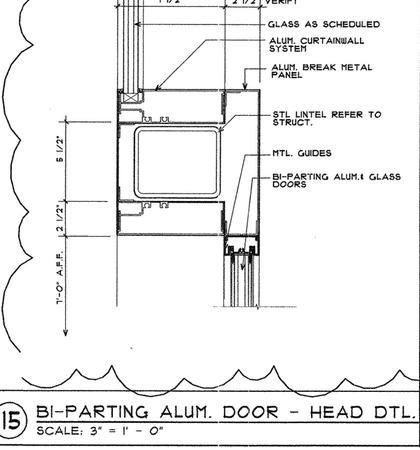

10 WOOD DOOR FRAME - JAMB DTL.
SCALE: 3" = 1' - 0"

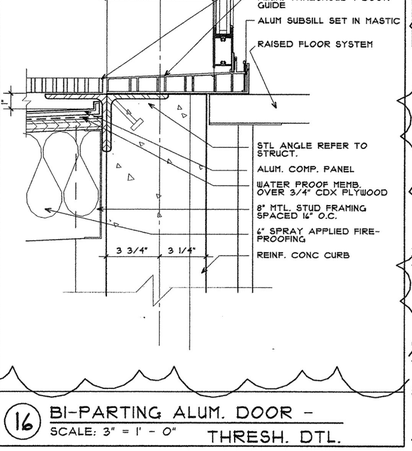

11 WOOD DOOR FRAME - JAMB DTL.
SCALE: 3" = 1' - 0"

12 OPERABLE PART. - HEAD DTL.
SCALE: 3" = 1' - 0"

SCALE: 3" = 1' - 0"

14 ALUM. THRESHOLD DTL.
SCALE: 3" = 1' - 0"

15 BI-PARTING ALUM. DOOR - HEAD DTL.
SCALE: 3" = 1' - 0"

16 BI-PARTING ALUM. DOOR - THRESH. DTL.
SCALE: 3" = 1' - 0"

POLK
STANLEY
YEARY
ARCHITECTS, LTD.

700 SOUTH SCHILLER
LITTLE ROCK, AR 72201
501 378-0878
FAX 372-7629

21 W. MOUNTAIN, SUITE 227
FAYETTEVILLE, AR 72701
479-444-0473

CONSULTANTS:

OWNER'S PROJECT ADVISOR:
MOSES TUCKER REAL ESTATE, INC.

CIVIL ENGINEER:
McCLELLAND ENGINEERS

LANDSCAPE ARCHITECT:
LARSON BURNS SMITH

STRUCTURAL ENGINEER:
CROMWELL ENGINEERS INC.

MECH., ELEC., PLUMB. ENGINEER:
CROMWELL ENGINEERS INC.

SUSTAINABLE CONSULTANT:
BNIM / ELEMENTS

GLOBAL VILLAGE CONSULTANT
CAMBRIDGE SEVEIN ASSOCIATES

INTERIOR DESIGNER:
POLK STANLEY YEARY

GENERAL CONTRACTOR:
CDI

GENERAL NOTES:

NOTES:

ISSUE DATE:
100% GMP
PACKAGE #6
FEBRUARY 2, 2004

REVISIONS:

#	DATE	DESCRIPTION
1	JULY 04	PACKAGE #7

HEIFER INTERNATIONAL CENTER OFFICE BUILDING

LITTLE ROCK, ARKANSAS

PSY PROJECT NUMBER:
431C

CONTENTS:
DOOR DETAILS

SHEET NUMBER:
A508

P:\D-DWG\431C\Cd\Final Drawings For CDs\Final\A508-DoorDetails 7/1/2004

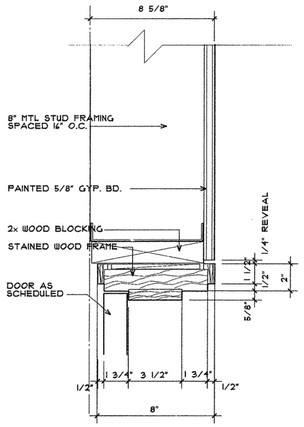

1 WOOD DOOR FRAME - HEAD DTL.
SCALE: 3" = 1' - 0"

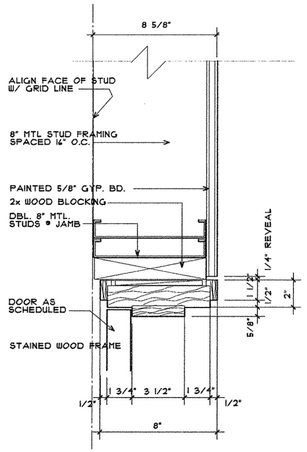

2 WOOD DOOR FRAME - JAMB DTL.
SCALE: 3" = 1' - 0"

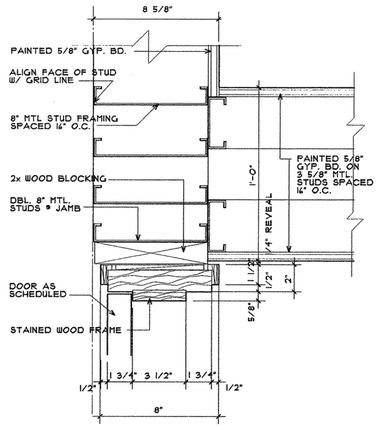

3 WOOD DOOR FRAME - JAMB DTL.
SCALE: 3" = 1' - 0"

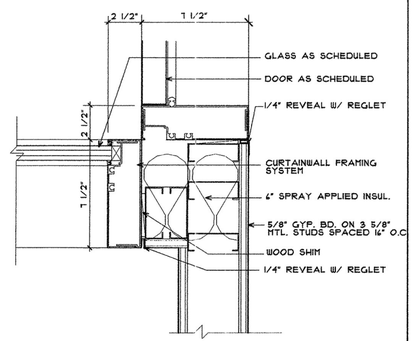

4 ALUM. CURTAINWALL - MULL DTL.
SCALE: 3" = 1' - 0"

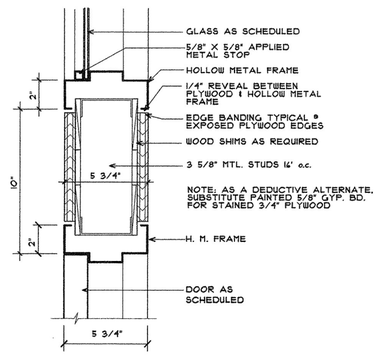

5 H.M. DOOR FRAME - HEAD DTL.
SCALE: 3" = 1' - 0"

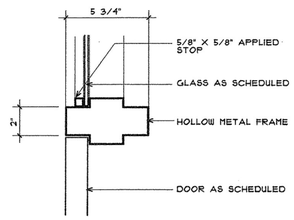

6 HOLLOW METAL FRAME - MULL DTL.
SCALE: 3" = 1' - 0"

P:\D-DWG\431C\CA\FinalDrawingsFor CDs\Final\A5041-DoorDetails 7/1/2004

POLK
STANLEY
YEARY

ARCHITECTS, LTD.

700 SOUTH SCHILLER
LITTLE ROCK, AR 72201
501 378-0878
FAX 372-7629

21 W. MOUNTAIN, SUITE 227
FAYETTEVILLE, AR 72701
479-444-0473

CONSULTANTS:

OWNER'S PROJECT ADVISOR:
MOSES TUCKER REAL ESTATE, INC.

CIVIL ENGINEER:
McCLELLAND ENGINEERS

LANDSCAPE ARCHITECT:
LARSON BURNS SMITH

STRUCTURAL ENGINEER:
CROMWELL ENGINEERS INC.

MECH., ELEC., PLUMB. ENGINEER:
CROMWELL ENGINEERS INC.

SUSTAINABLE CONSULTANT:
BNIM / ELEMENTS

GLOBAL VILLAGE CONSULTANT
CAMBRIDGE SEVEN ASSOCIATES

INTERIOR DESIGNER:
POLK STANLEY YEARY

GENERAL CONTRACTOR:
CDI

GENERAL NOTES:

NOTES:

ISSUE DATE:

100% ROLL UP
PACKAGE #7
JULY 1, 2004

REVISIONS:

#	DATE	DESCRIPTION
1	JULY 04	PACKAGE #7

HEIFER INTERNATIONAL CENTER OFFICE BUILDING

LITTLE ROCK, ARKANSAS

PSY PROJECT NUMBER:
431C

CONTENTS:
DOOR DETAILS

SHEET NUMBER:
A509
1

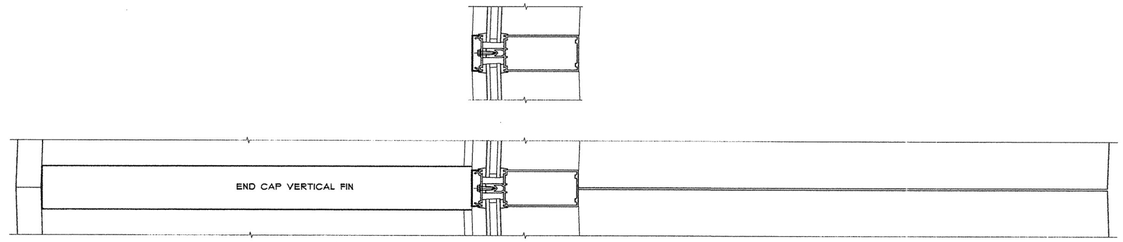

SECTION A-A (TOP VIEW)

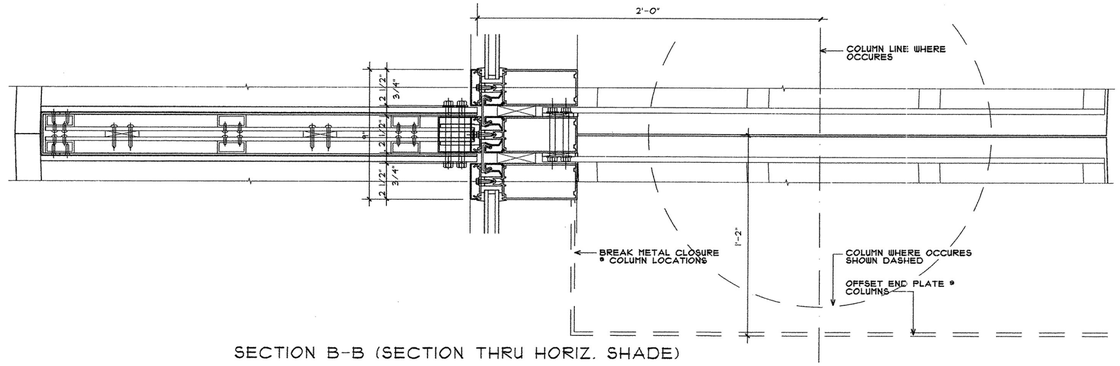

SECTION B-B (SECTION THRU HORIZ. SHADE)

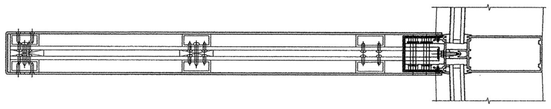

SECTION C-C (SECTION THRU VERT. SHADE)

1 SUN SHADE PLAN
SCALE: 3" = 1' - 0"

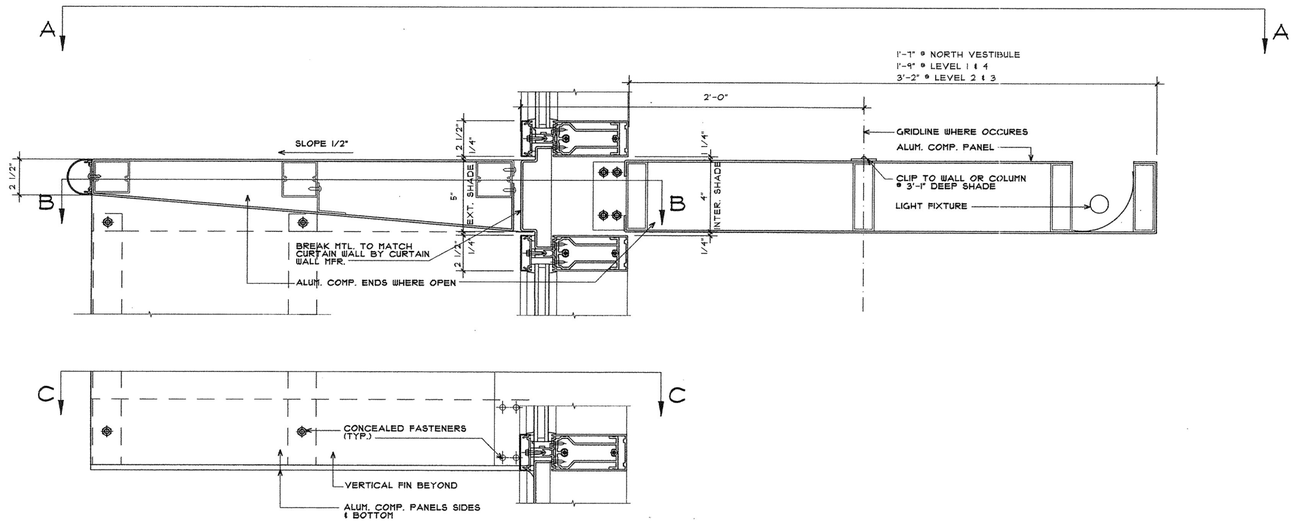

2 SUN SHADE SECTIONS
SCALE: 3" = 1' - 0"

POLK
STANLEY
YEARY
ARCHITECTS, LTD.

700 SOUTH SCHILLER
LITTLE ROCK, AR 72201
501 378-0878
FAX 372-7629

21 W. MOUNTAIN, SUITE 227
FAYETTEVILLE, AR 72701
479-444-0473

CONSULTANTS:

OWNER'S PROJECT ADVISOR:
MOSES TUCKER REAL ESTATE, INC.

CIVIL ENGINEER:
McCLELLAND ENGINEERS

LANDSCAPE ARCHITECT:
LARSON BURNS SMITH

STRUCTURAL ENGINEER:
CROMWELL ENGINEERS INC.

MECH., ELEC., PLUMB. ENGINEER:
CROMWELL ENGINEERS INC.

SUSTAINABLE CONSULTANT:
BNIM / ELEMENTS

GLOBAL VILLAGE CONSULTANT
CAMBRIDGE SEVEN ASSOCIATES

INTERIOR DESIGNER:
POLK STANLEY YEARY

GENERAL CONTRACTOR:
CDI

GENERAL NOTES:

NOTES:

ISSUE DATE:
100% G.M.P.
PACKAGE #6
FEBRUARY 2, 2004

REVISIONS:

#	DATE	DESCRIPTION

HEIFER INTERNATIONAL CENTER OFFICE BUILDING
LITTLE ROCK, ARKANSAS

PSY PROJECT NUMBER:
431C

CONTENTS:
SUN SHADE DETAILS

SHEET NUMBER:
A510

P:\0-DWG\431C\CA\FinalSubmittal\Arch\Plot\Bldg2\sd02d2696.dwg, 7/1/2004 10:37 AM

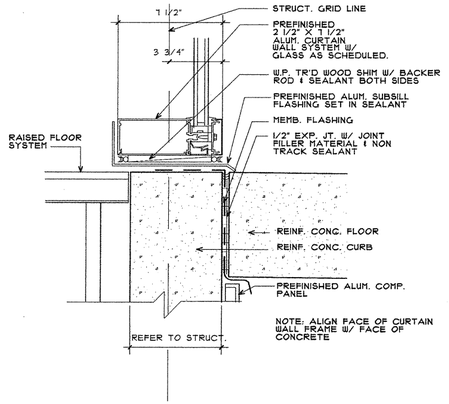

1 DETAIL @ ALUM. CURTAIN WALL SILL
SCALE: 3" = 1'-0"

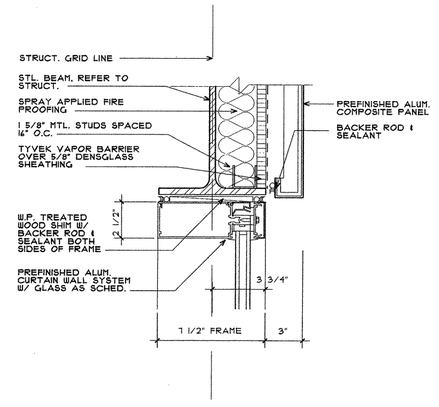

2 DETAIL @ ALUM. CURTAIN WALL HEAD
SCALE: 3" = 1'-0"

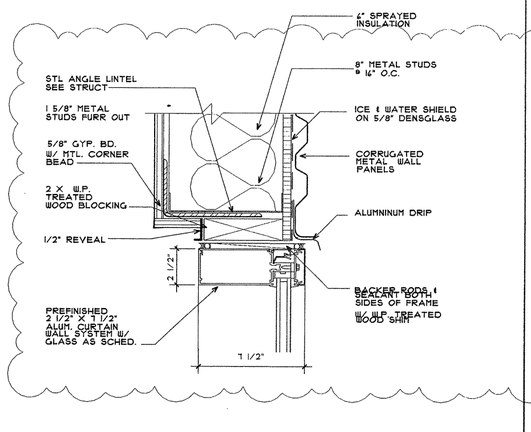

3 DETAIL @ ALUM. CURTAIN WALL HEAD
SCALE: 3" = 1'-0"

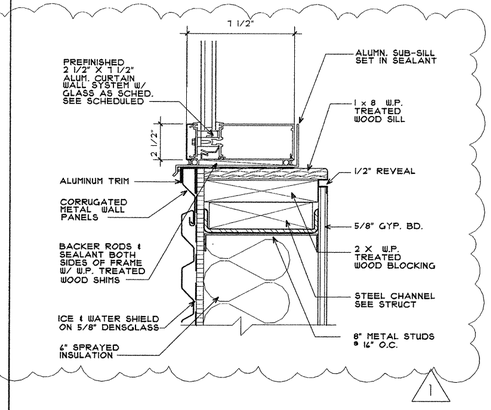

4 DETAIL @ ALUM. CURTAIN WALL SILL
SCALE: 3" = 1'-0"

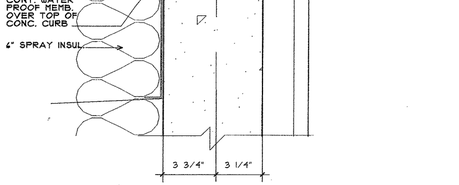

6 DETAIL @ ALUM. CURTAIN WALL SILL
SCALE: 3" = 1'-0"

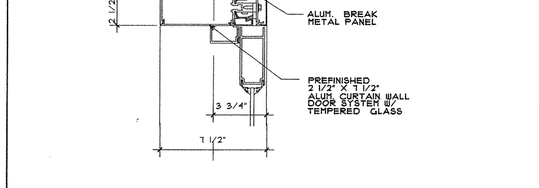

7 DTL. @ ALUM. CURTAIN WALL SILL & DOOR HEAD
SCALE: 3" = 1'-0"

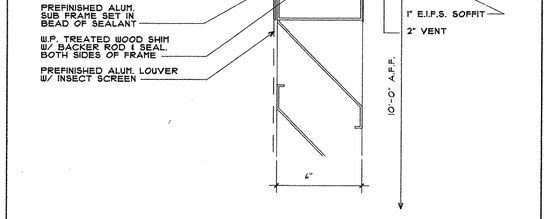

8 DETAIL @ ALUM. LOUVER HEAD
SCALE: 3" = 1'-0"

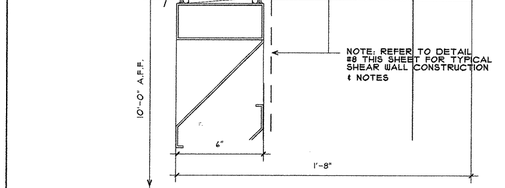

9 DETAIL @ ALUM. LOUVER HEAD
SCALE: 3" = 1'-0"

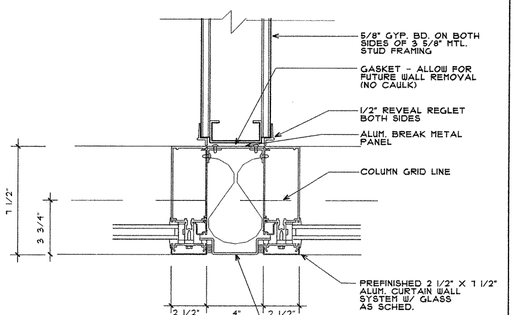

10 DTL. @ ALUM. CURTAIN WALL
SCALE: 3" = 1'-0"

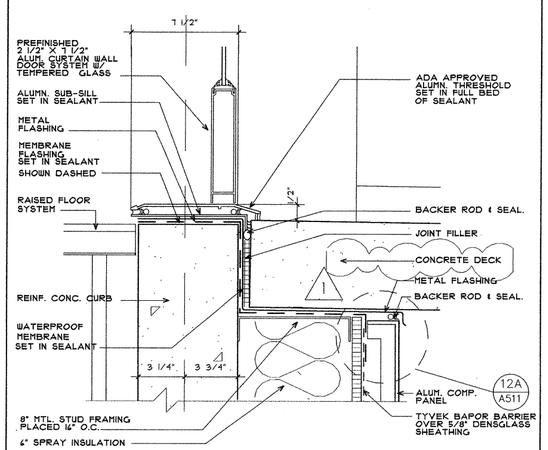

11 DETAIL @ ALUM. CURTAIN WALL DOOR SILL 12A
SCALE: 3" = 1'-0"

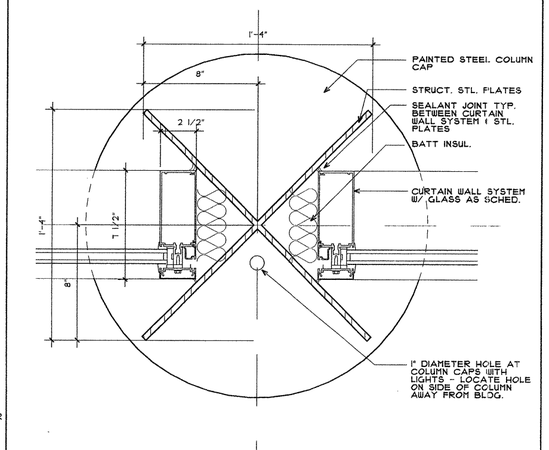

12 DETAIL @ ROOF TREE BASE
SCALE: 3" = 1'-0"

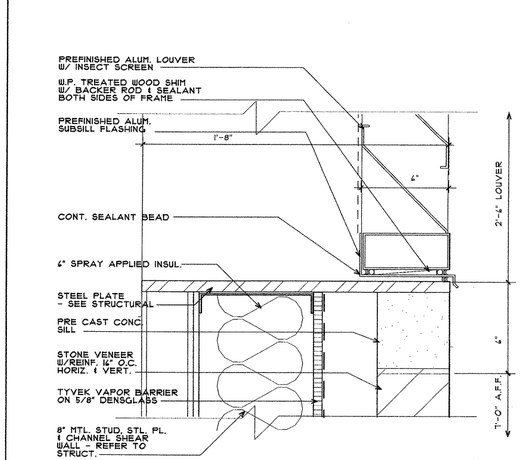

13 DETAIL @ ALUM. LOUVER SILL
SCALE: 3" = 1'-0"

POLK
STANLEY
YEARY
ARCHITECTS, LTD.

700 SOUTH SCHILLER
LITTLE ROCK, AR 72201
501 378-0878
FAX 372-7629

21 W. MOUNTAIN, SUITE 227
FAYETTEVILLE, AR 72701
479-444-0473

CONSULTANTS:

OWNER'S PROJECT ADVISOR:
MOSES TUCKER REAL ESTATE, INC.

CIVIL ENGINEER:
McCLELLAND ENGINEERS

LANDSCAPE ARCHITECT:
LARSON BURNS SMITH

STRUCTURAL ENGINEER:
CROMWELL ENGINEERS INC.

MECH., ELEC., PLUMB. ENGINEER:
CROMWELL ENGINEERS INC.

SUSTAINABLE CONSULTANT:
BNIM / ELEMENTS

GLOBAL VILLAGE CONSULTANT
CAMBRIDGE SEVEN ASSOCIATES

INTERIOR DESIGNER:
POLK STANLEY YEARY

GENERAL CONTRACTOR:
CDI

GENERAL NOTES:

NOTES:

ISSUE DATE:
CONSTRUCTION DOCUMENTS
PACKAGE #5
DECEMBER 15, 2003

REVISIONS:

#	DATE	DESCRIPTION
1	01/01/04	PACKAGE 7

HEIFER INTERNATIONAL CENTER OFFICE BUILDING

LITTLE ROCK, ARKANSAS

PSY PROJECT NUMBER:
431C

CONTENTS:
DETAILS @ ALUM. CURTAIN WALL

SHEET NUMBER:
A511

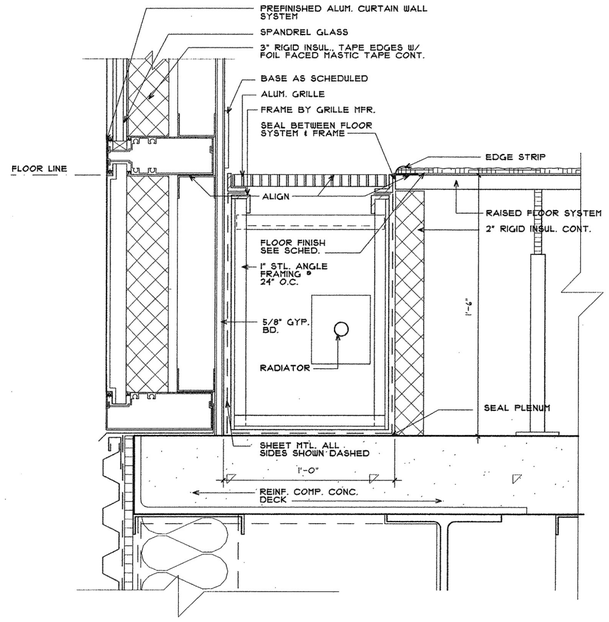

1 DETAIL @ RECESSED RADIATOR
SCALE: 3" = 1'-0"

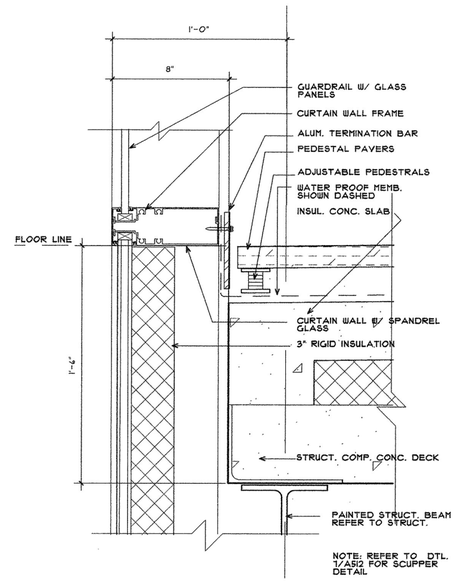

2 4th. FLOOR BALCONY DETAIL
SCALE: 3" = 1'-0"

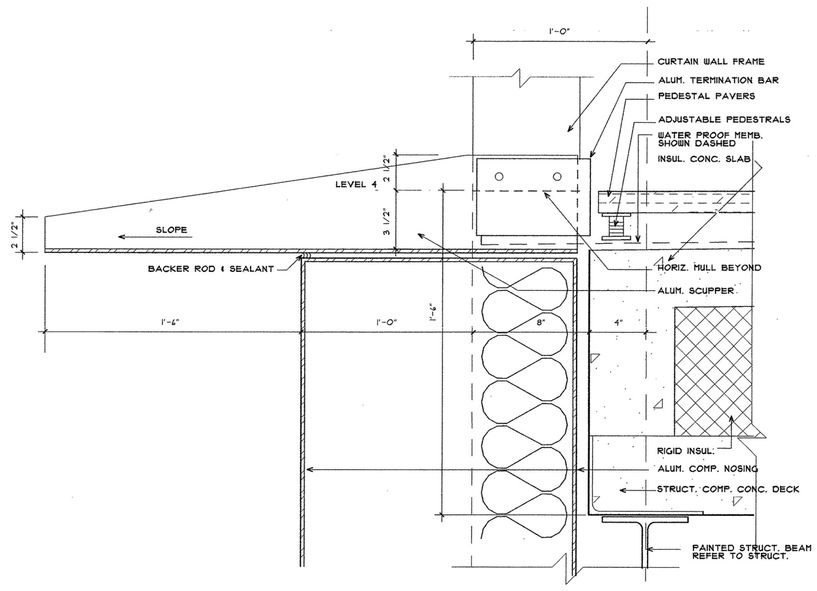

7 BALCONY SCUPPER DETAIL
SCALE: 3" = 1'-0"

POLK
STANLEY
YEARY
ARCHITECTS, LTD.

700 SOUTH SCHILLER
LITTLE ROCK, AR 72201
501 378-0878
FAX 372-7629

21 W. MOUNTAIN, SUITE 227
FAYETTEVILLE, AR 72701
479-444-0473

CONSULTANTS:

OWNER'S PROJECT ADVISOR:
MOSES TUCKER REAL ESTATE, INC.

CIVIL ENGINEER:
McCLELLAND ENGINEERS

LANDSCAPE ARCHITECT:
LARSON BURNS SMITH

STRUCTURAL ENGINEER:
CROMWELL ENGINEERS INC.

MECH., ELEC., PLUMB. ENGINEER:
CROMWELL ENGINEERS INC.

SUSTAINABLE CONSULTANT:
BNIM / ELEMENTS

GLOBAL VILLAGE CONSULTANT
CAMBRIDGE SEVEN ASSOCIATES

INTERIOR DESIGNER:
POLK STANLEY YEARY

GENERAL CONTRACTOR:
CDI

GENERAL NOTES:

NOTES:

ISSUE DATE:
100% ROLL-UP
PACKAGE #7
JULY 1, 2004

REVISIONS:

#	DATE	DESCRIPTION
1	01JUL04	PACKAGE 7

HEIFER INTERNATIONAL CENTER OFFICE BUILDING

LITTLE ROCK, ARKANSAS

PSY PROJECT NUMBER:
431C

CONTENTS:
DETAILS @ ALUM. CURTAIN WALL

SHEET NUMBER:
A512
1

P:\D--DWG\431C\Cd\FinalDrawingsForCDs\Final\A512-Details@AlumCurtainwall 7/1/2004

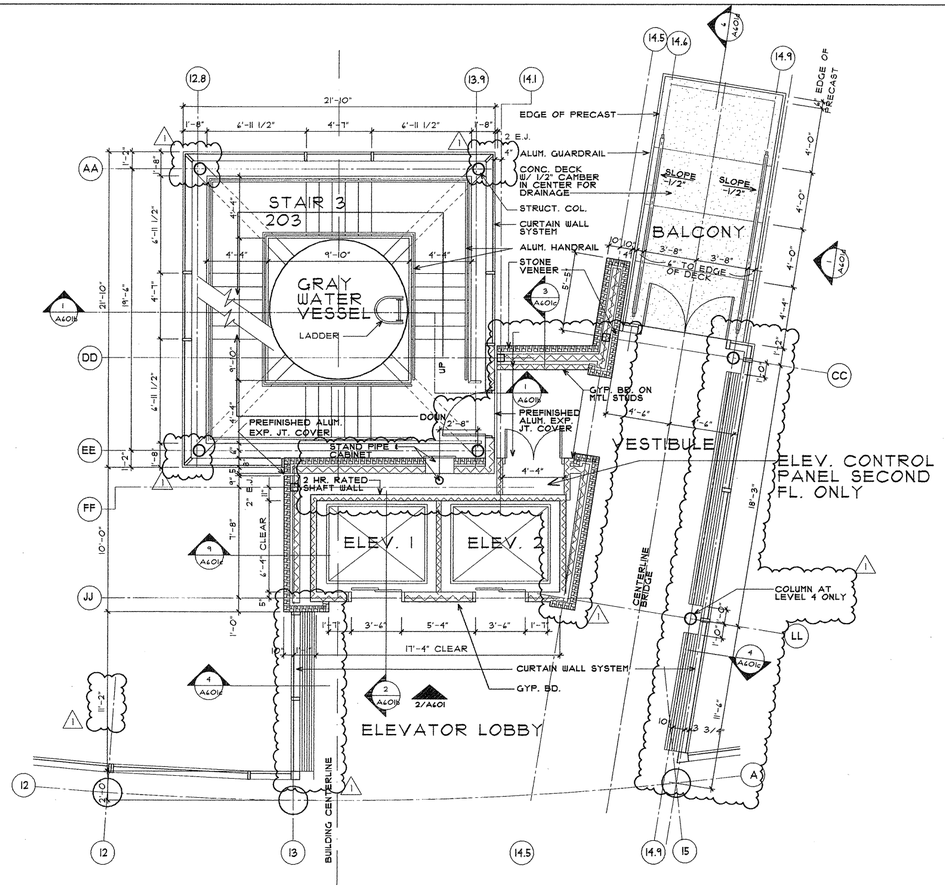

1 LEVELS 2, 3 & 4 - CORE
SCALE: 1/4" = 1'-0"

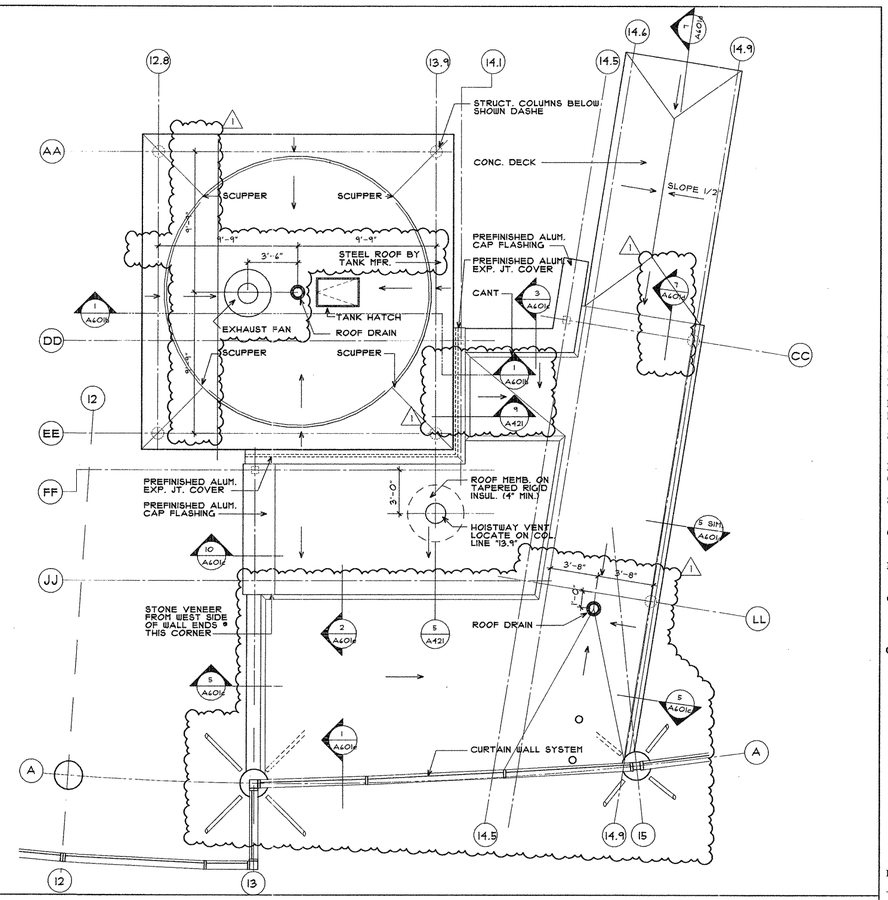

2 ROOF PLAN - CORE
SCALE: 1/4" = 1'-0"

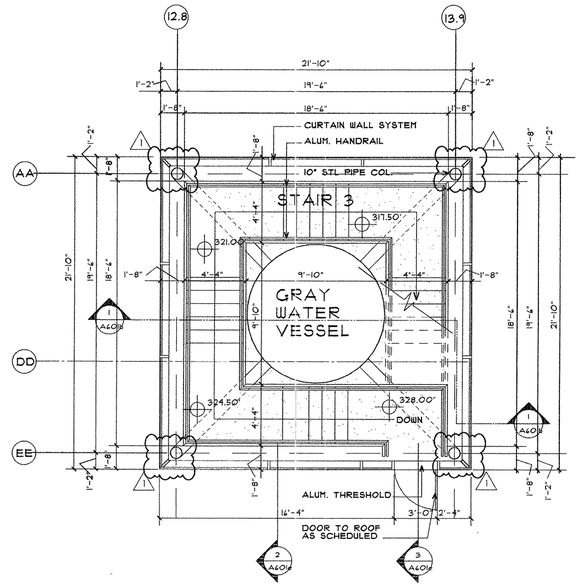

8 ROOF LEVEL
SCALE: 1/4" = 1'-0"

POLK STANLEY YEARY
ARCHITECTS, LTD.

700 SOUTH SCHILLER
LITTLE ROCK, AR 72201
501 378-0878
FAX 372-7629

21 W. MOUNTAIN, SUITE 227
FAYETTEVILLE, AR 72701
479-444-0473

CONSULTANTS:

OWNER'S PROJECT ADVISOR:
MOSES TUCKER REAL ESTATE, INC.

CIVIL ENGINEER:
McCLELLAND ENGINEERS

LANDSCAPE ARCHITECT:
LARSON BURNS SMITH

STRUCTURAL ENGINEER:
CROMWELL ENGINEERS INC.

MECH., ELEC., PLUMB. ENGINEER:
CROMWELL ENGINEERS INC.

SUSTAINABLE CONSULTANT:
BNIM / ELEMENTS

GLOBAL VILLAGE CONSULTANT
CAMBRIDGE SEVEN ASSOCIATES

INTERIOR DESIGNER:
POLK STANLEY YEARY

GENERAL CONTRACTOR:
CDI

GENERAL NOTES:

NOTES:

ISSUE DATE:
100% GMP
PACKAGE #6
FEBRUARY 2, 2004

REVISIONS:

#	DATE	DESCRIPTION
1	01/01/04	PACKAGE #1

HEIFER INTERNATIONAL CENTER OFFICE BUILDING

LITTLE ROCK, ARKANSAS

PSY PROJECT NUMBER:
431C

CONTENTS:
ENLARGED PLANS - ELEVATOR CORE

SHEET NUMBER:

A601a

P:\D-DWG\431C\Cs\Final\Drawings For CDs\Final\A601a-EnlargedCore.dgn 2/2/04

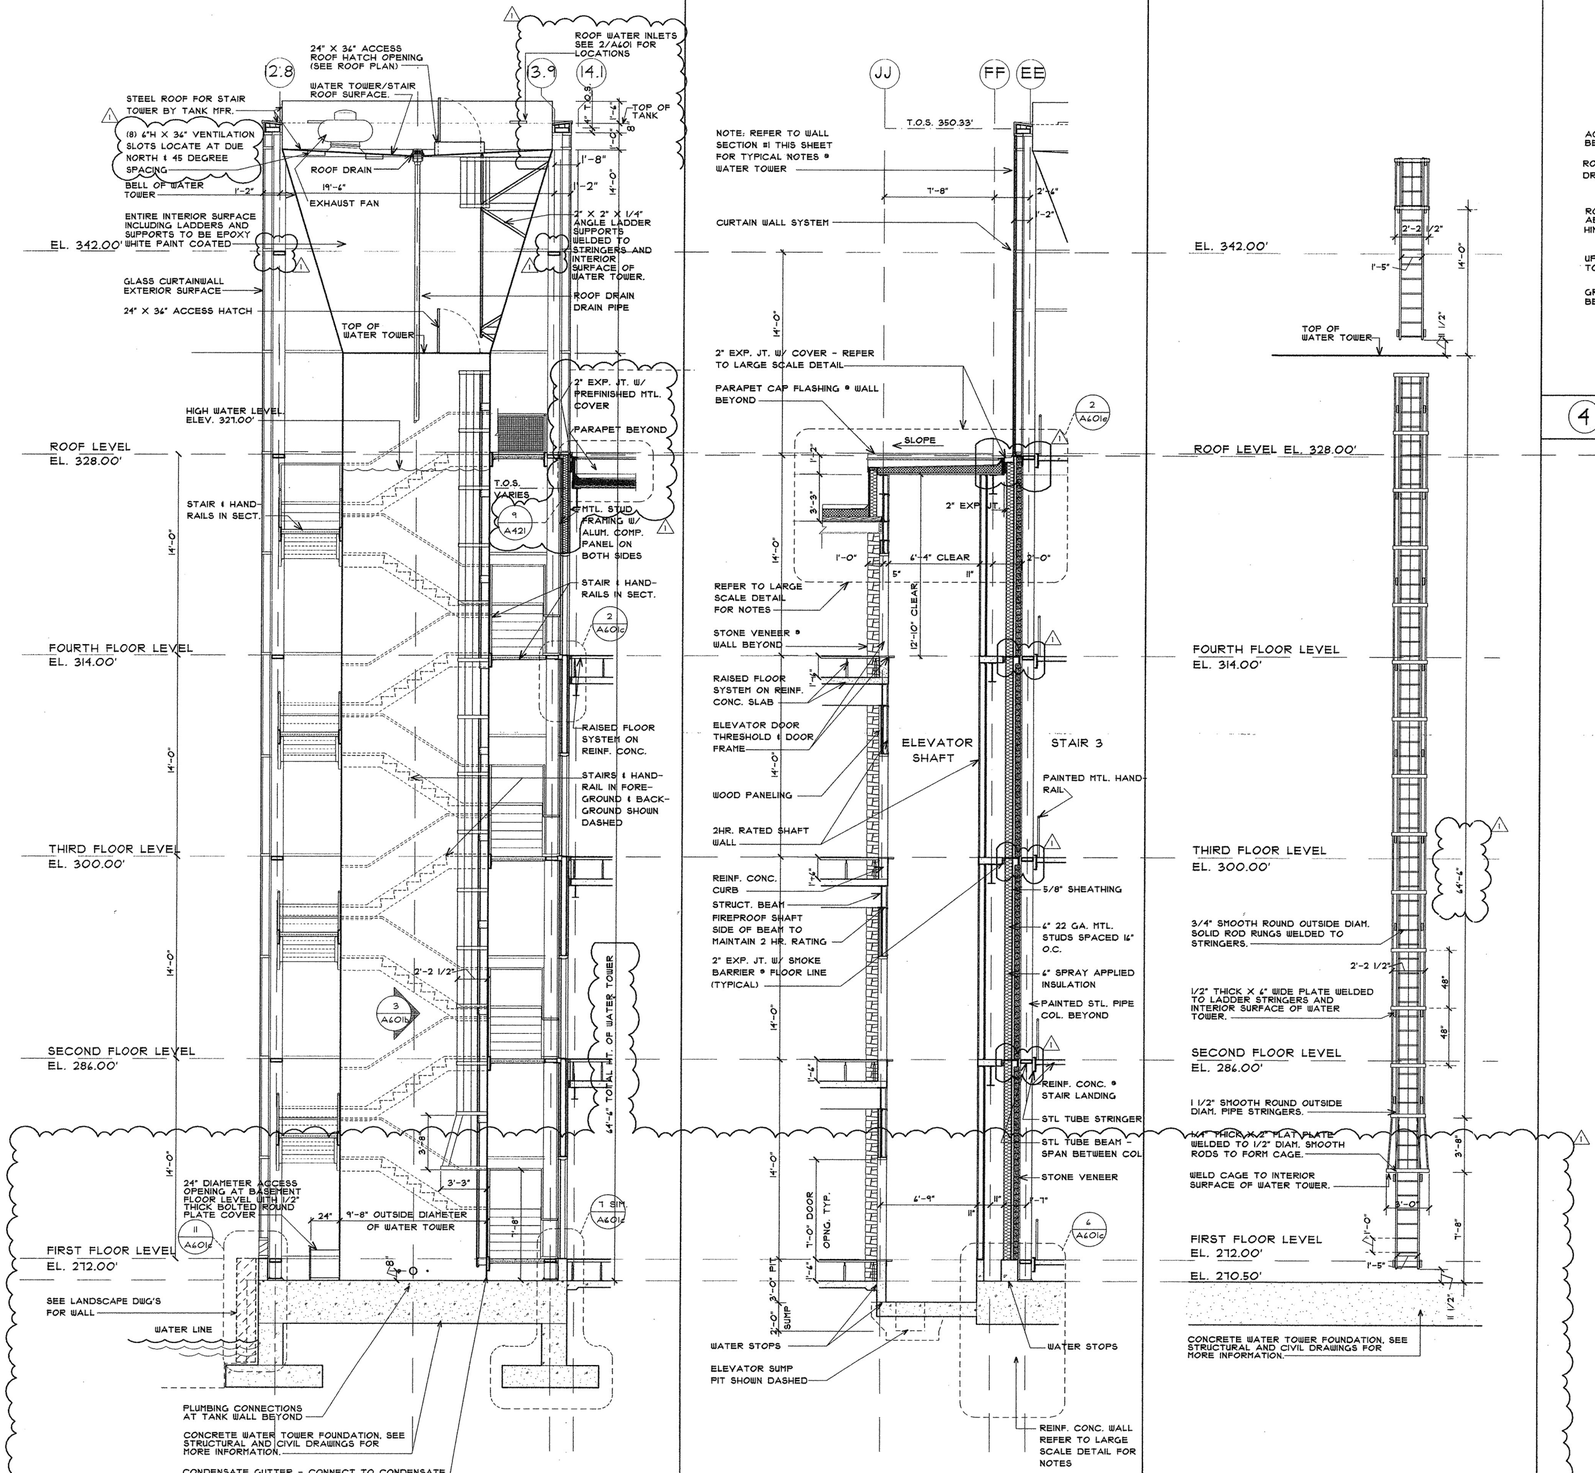

1 SECTION THRU WATER TOWER AT STAIR 3
SCALE: 1/4" = 1'-0"

2 SECTION @ ELEV. #1
SCALE: 1/4" = 1'-0"

3 ELEV. - LADDERS @ WATER TOWER
SCALE: 1/4" = 1'-0"

4 WATER TOWER PLAN
SCALE: 1/4" = 1'-0"

POLK STANLEY YEARY
ARCHITECTS, LTD.

700 SOUTH SCHILLER
LITTLE ROCK, AR 72201
501 378-0878
FAX 372-7629

21 W. MOUNTAIN, SUITE 227
FAYETTEVILLE, AR 72701
479-444-0473

CONSULTANTS:

OWNER'S PROJECT ADVISOR:
MOSES TUCKER REAL ESTATE, INC.

CIVIL ENGINEER:
McCLELLAND ENGINEERS

LANDSCAPE ARCHITECT:
LARSON BURNS SMITH

STRUCTURAL ENGINEER:
CROMWELL ENGINEERS INC.

MECH., ELEC., PLUMB. ENGINEER:
CROMWELL ENGINEERS INC.

SUSTAINABLE CONSULTANT:
BNIM / ELEMENTS

GLOBAL VILLAGE CONSULTANT
CAMBRIDGE SEVEN ASSOCIATES

INTERIOR DESIGNER:
POLK STANLEY YEARY

GENERAL CONTRACTOR:
CDI

GENERAL NOTES:

1. REFER TO STRUCTURAL FOR EXTERIOR WALL STUD GAUGE.

NOTES:

ISSUE DATE:
100% G.M.P.
PACKAGE #6
FEBRUARY 2, 2004

REVISIONS:

#	DATE	DESCRIPTION
1	01JUL04	PACKAGE #1

HEIFER INTERNATIONAL CENTER OFFICE BUILDING

LITTLE ROCK, ARKANSAS

PSY PROJECT NUMBER:
431C

CONTENTS:
STAIR 3 SECTION

SHEET NUMBER:
A601b

P:\JOBS\431C\CAD\FinalDrawingsForCDs\Final\A601b-Stair3Section Thursday, July 01, 2004 1:28 PM

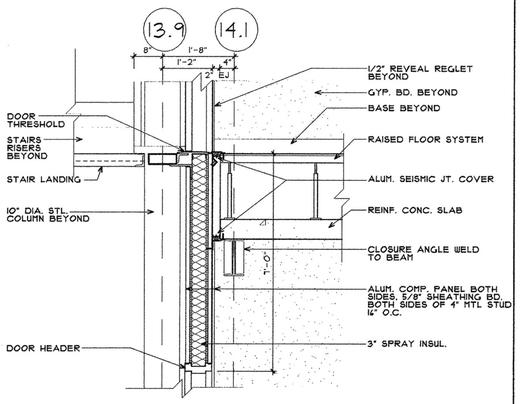

2 SECTION DETAIL
SCALE: 3/4" = 1'-0"

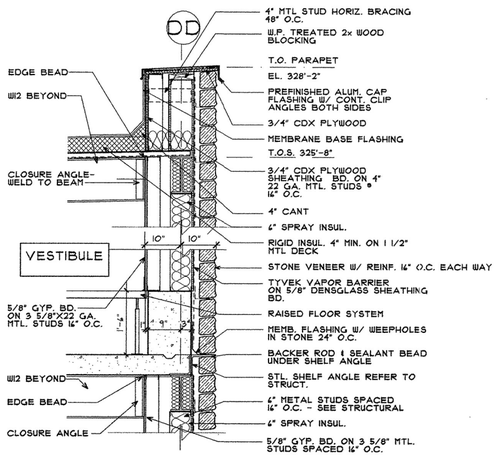

3 SECTION DETAIL
SCALE: 3/4" = 1'-0"

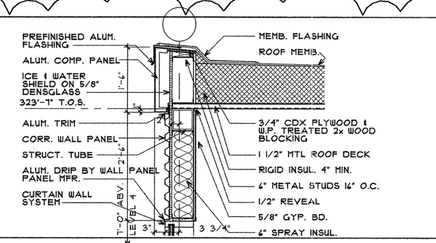

5 SECTION DETAIL
SCALE: 3/4" = 1'-0"

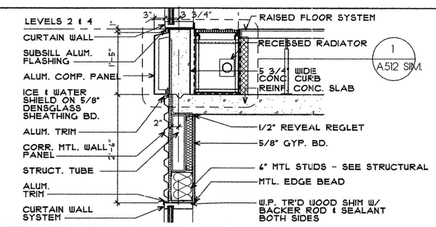

4 SECTION DETAIL
SCALE: 3/4" = 1'-0"

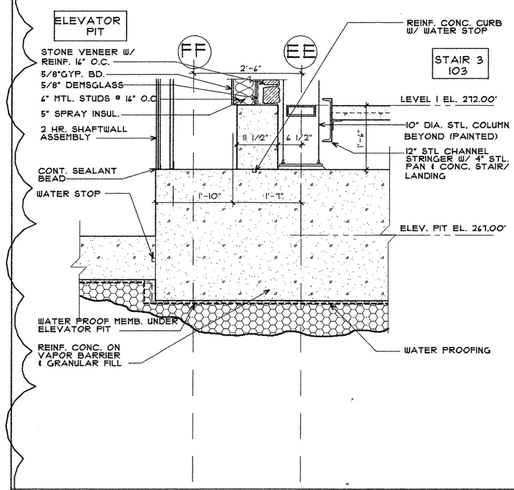

6 SECTION DETAIL
SCALE: 3/4" = 1'-0"

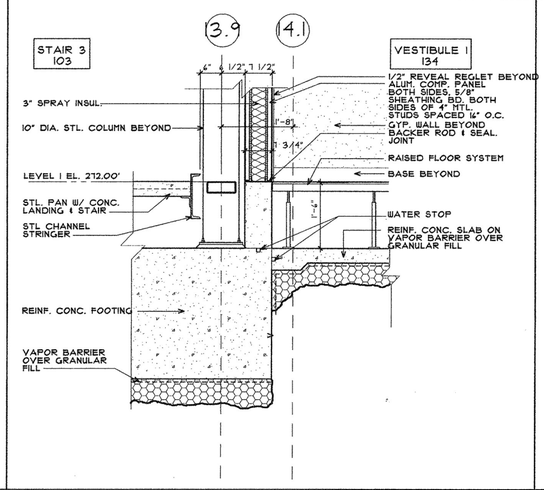

7 SECTION DETAIL
SCALE: 3/4" = 1'-0"

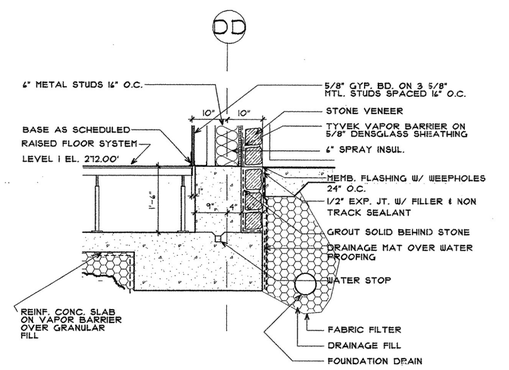

8 SECTION DETAIL
SCALE: 3/4" = 1'-0"

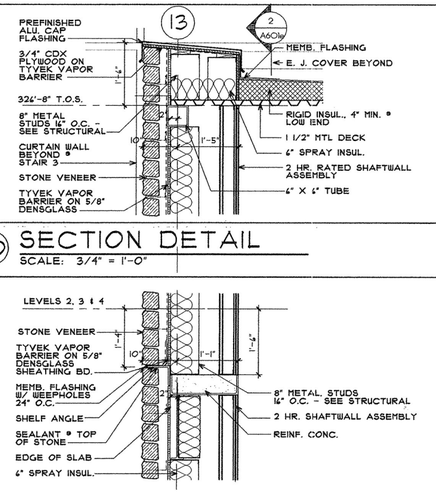

10 SECTION DETAIL
SCALE: 3/4" = 1'-0"

9 SECTION DETAIL
SCALE: 3/4" = 1'-0"

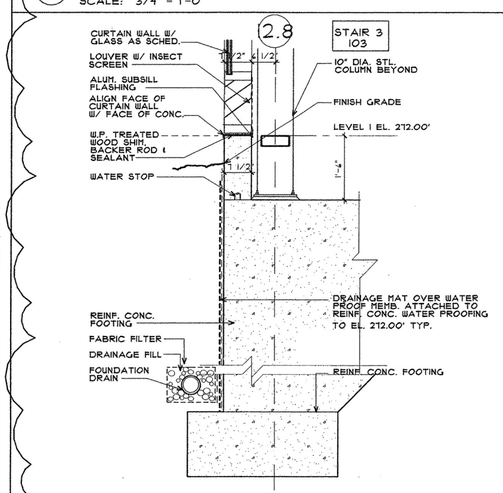

11 SECTION DETAIL
SCALE: 3/4" = 1'-0"

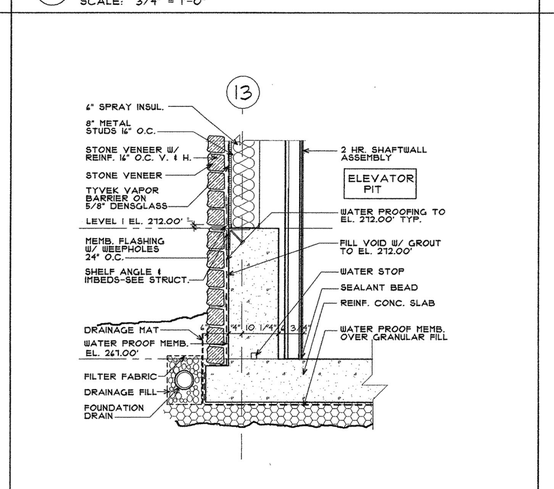

12 SECTION DETAIL
SCALE: 3/4" = 1'-0"

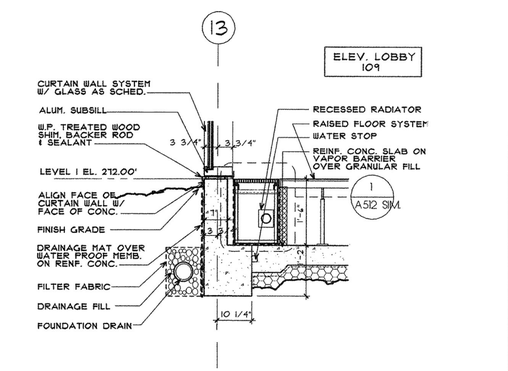

13 SECTION DETAIL
SCALE: 3/4" = 1'-0"

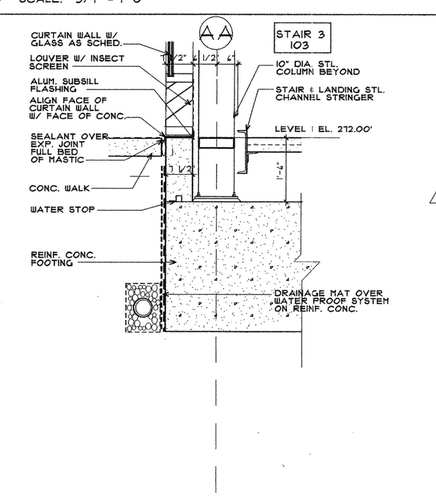

14 SECTION DETAIL
SCALE: 3/4" = 1'-0"

POLK
STANLEY
YEARY
ARCHITECTS, LTD.

700 SOUTH SCHILLER
LITTLE ROCK, AR 72201
501 378-0878
FAX 372-7629

21 W. MOUNTAIN, SUITE 227
FAYETTEVILLE, AR 72701
479-444-0473

CONSULTANTS:

OWNER'S PROJECT ADVISOR:
MOSES TUCKER REAL ESTATE, INC.

CIVIL ENGINEER:
McCLELLAND ENGINEERS

LANDSCAPE ARCHITECT:
LARSON BURNS SMITH

STRUCTURAL ENGINEER:
CROMWELL ENGINEERS INC.

MECH., ELEC., PLUMB. ENGINEER:
CROMWELL ENGINEERS INC.

SUSTAINABLE CONSULTANT:
BNIM / ELEMENTS

GLOBAL VILLAGE CONSULTANT
CAMBRIDGE SEVEN ASSOCIATES

INTERIOR DESIGNER:
POLK STANLEY YEARY

GENERAL CONTRACTOR:
CDI

GENERAL NOTES:

1. REFER TO STRUCTURAL FOR EXTERIOR WALL STUD GAUGE.

NOTES:

ISSUE DATE:
100% GMP
PACKAGE #6
FEBRUARY 2, 2004

REVISIONS:

#	DATE	DESCRIPTION
1		PACKAGE #7

HEIFER INTERNATIONAL CENTER OFFICE BUILDING

LITTLE ROCK, ARKANSAS

PSY PROJECT NUMBER:
431C

CONTENTS:
ELEVATOR & STAIR CORE DETAILS

SHEET NUMBER:

A601c

P:\0-Dgn\Arch\Cds\Print\Dwg\Pdf\Cds\Print\Dwg\Pdf\A601c-Elev&Stairs.dwg Thursday, July 01, 2004 2:38 PM

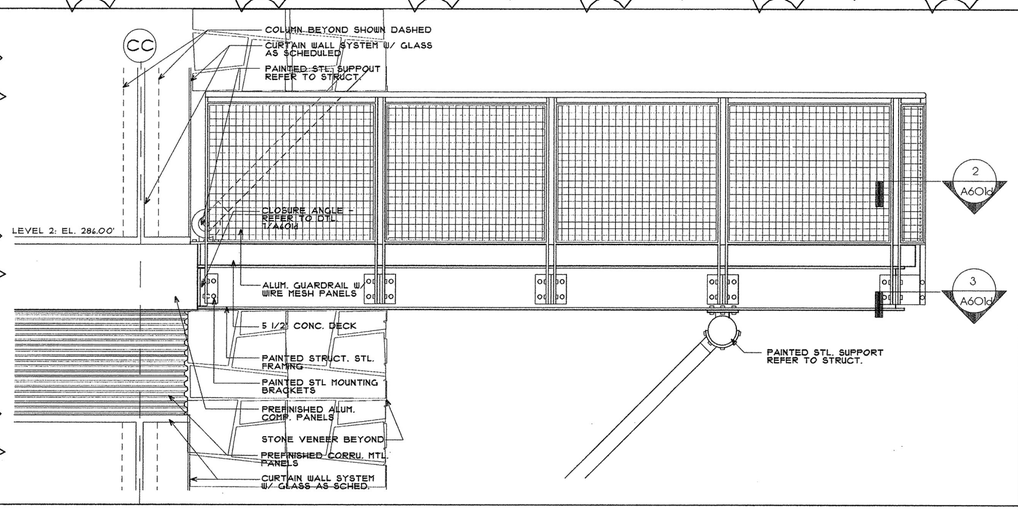

1 BALCONY 251 ELEVATION
SCALE: 3/4" = 1'-0"

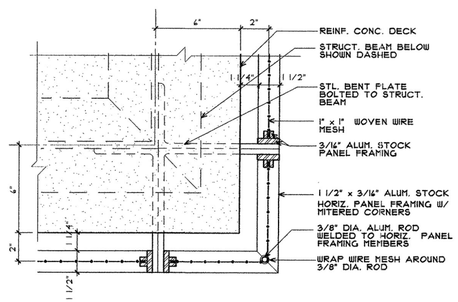

PLAN

2 GUARDRAIL DETAIL
SCALE: 3" = 1'-0"

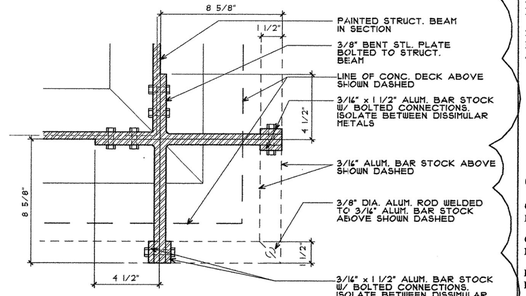

PLAN

3 GUARDRAIL DETAIL
SCALE: 3" = 1'-0"

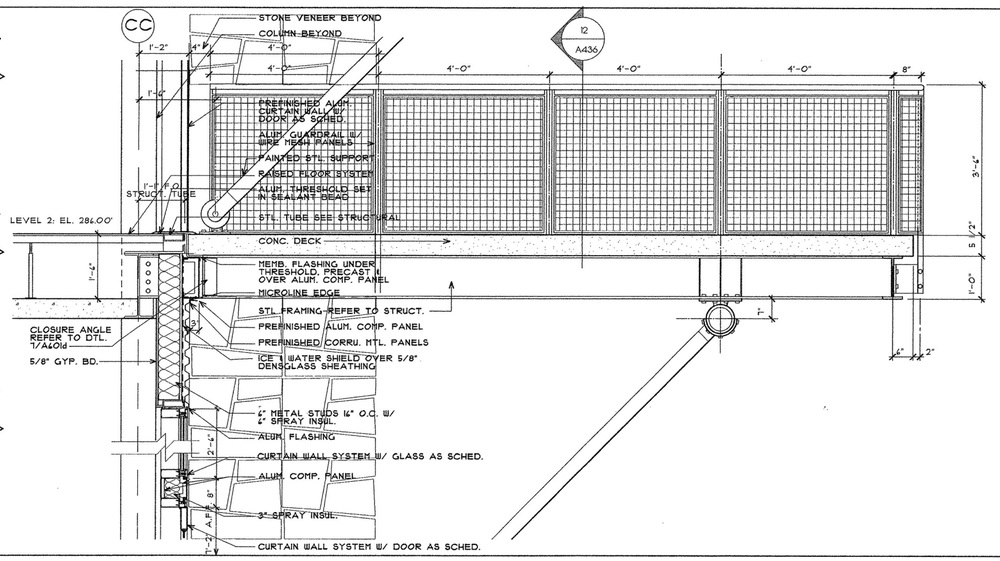

6 BALCONY 251 SECTION
SCALE: 3/4" = 1'-0"

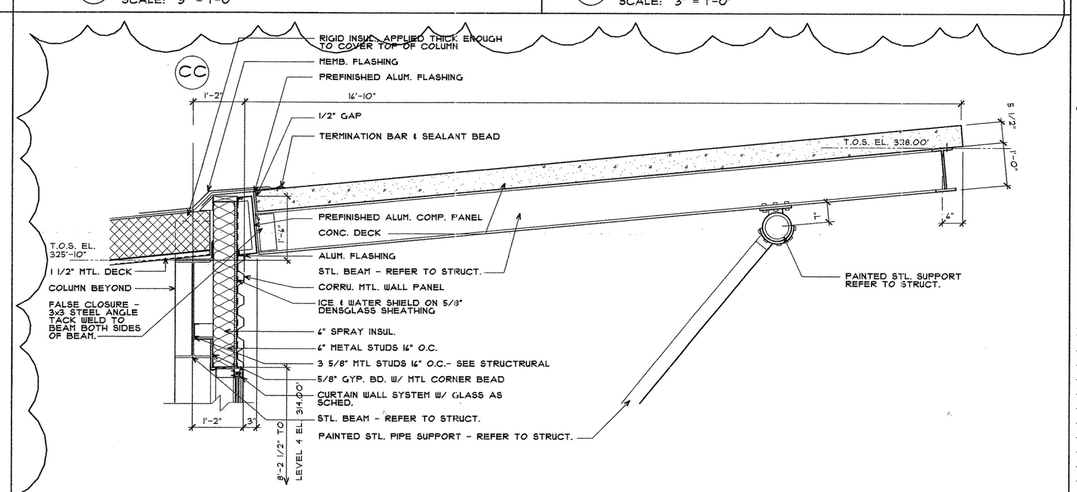

7 SECTION DETAIL
SCALE: 3/4" = 1'-0"

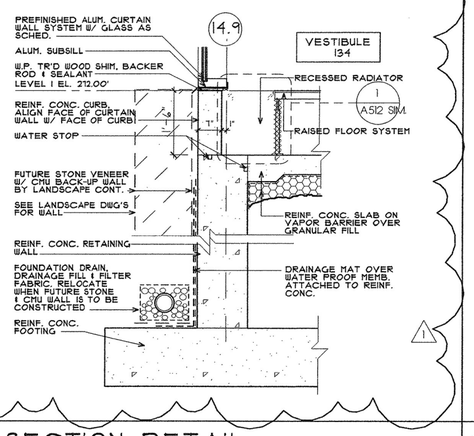

11 SECTION DETAIL
SCALE: 3/4" = 1'-0"

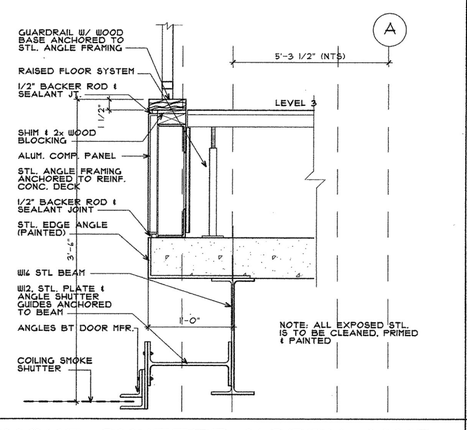

12 SMOKE SHUTTER-NORTH JAMB
SCALE: 3/4" = 1'-0" SCALE: 1 1/2" = 1'-0"

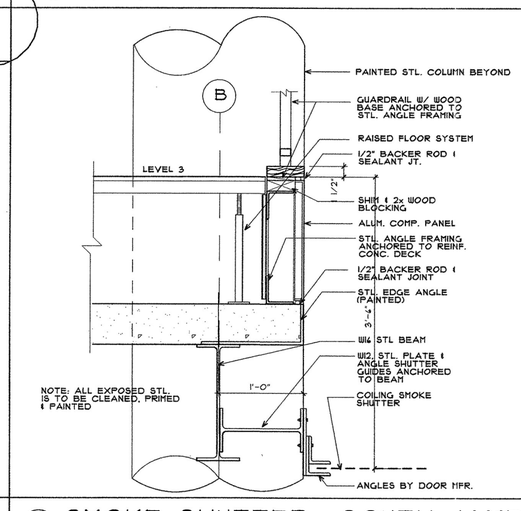

14 SMOKE SHUTTER -SOUTH JAMB
SCALE: 3/4" = 1'-0"

POLK
STANLEY
YEARY
ARCHITECTS, LTD.

700 SOUTH SCHILLER
LITTLE ROCK, AR 72201
501 378-0878
FAX 372-7629

21 W. MOUNTAIN, SUITE 227
FAYETTEVILLE, AR 72701
479-444-0473

CONSULTANTS:

OWNER'S PROJECT ADVISOR:
MOSES TUCKER REAL ESTATE, INC.

CIVIL ENGINEER:
McCLELLAND ENGINEERS

LANDSCAPE ARCHITECT:
LARSON BURNS SMITH

STRUCTURAL ENGINEER:
CROMWELL ENGINEERS INC.

MECH., ELEC., PLUMB. ENGINEER:
CROMWELL ENGINEERS INC.

SUSTAINABLE CONSULTANT:
BNIM / ELEMENTS

GLOBAL VILLAGE CONSULTANT
CAMBRIDGE SEVEN ASSOCIATES

INTERIOR DESIGNER:
POLK STANLEY YEARY

GENERAL CONTRACTOR:
CDI

GENERAL NOTES:

1. REFER TO STRUCTURAL FOR EXTERIOR WALL STUD GAUGE.

NOTES:

ISSUE DATE:
100% GMP
PACKAGE #6
FEBRUARY 2, 2004

REVISIONS:

#	DATE	DESCRIPTION
1	04JUL04	PACKAGE 07

HEIFER INTERNATIONAL CENTER OFFICE BUILDING

LITTLE ROCK, ARKANSAS

PSY PROJECT NUMBER:
431C

CONTENTS:
SECTION DETAILS

SHEET NUMBER:
A601d

P:\0-DWG\ARCH\CAD Files\Drawings\CAD\Files\A601d-Details.dwg Thursday, July 01, 2004 4:41 PM

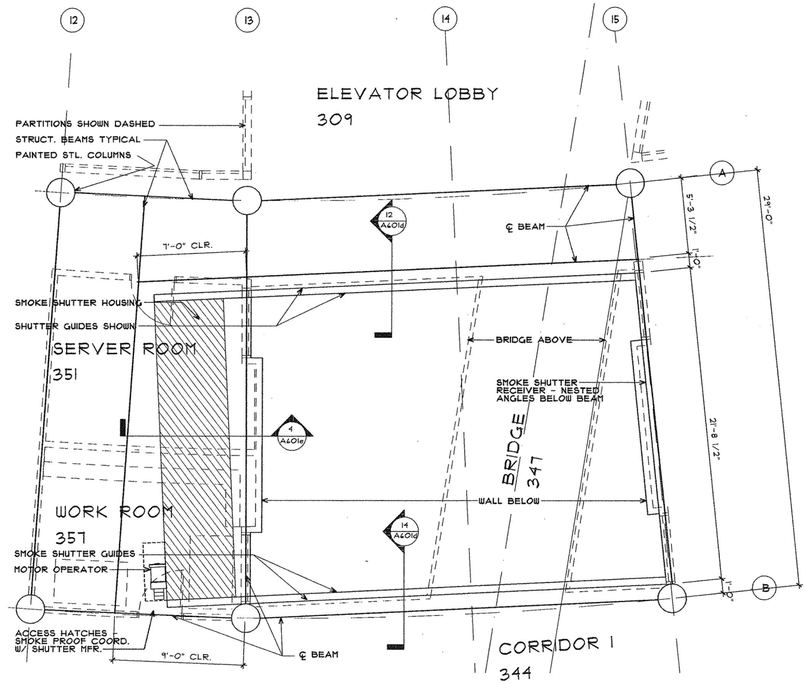

1 ELEVATOR LOBBY SMOKE SHUTTER PLAN
SCALE: 1/4" = 1'-0"

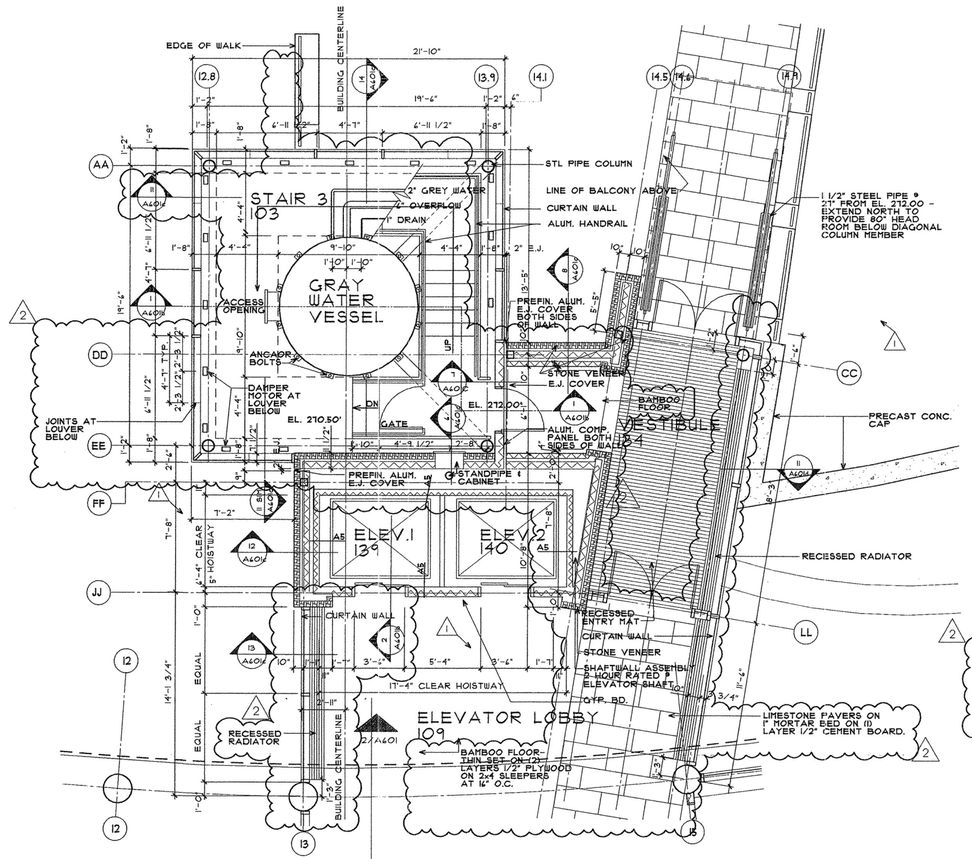

4 LEVEL 1 - CORE
SCALE: 1/4" = 1'-0"

STAIR ELEVATIONS TABLE
T.O.S. DIAGONAL BEAMS IN (PARENTHESIS)

ROOF LEVEL	328.00' (327.6T')
THIRD LANDING	324.50' (324.1T')
SECOND LANDING	321.00' (320.6T')
FIRST LANDING	317.50' (317.1T')
FOURTH FLOOR LEVEL	314.00' (313.6T')
THIRD LANDING	310.50' (310.1T')
SECOND LANDING	307.00' (306.6T')
FIRST LANDING	303.50' (303.1T')
THIRD FLOOR LEVEL	300.00' (299.6T')
THIRD LANDING	296.50' (296.1T')
SECOND LANDING	293.00' (292.6T')
FIRST LANDING	289.50' (289.1T')
SECOND FLOOR LEVEL	286.00' (285.6T')
THIRD LANDING	282.50' (282.1T')
SECOND LANDING	279.00' (278.6T')
FIRST LANDING	275.50' (275.1T')
FIRST FLOOR LEVEL	272.00' (271.6T')

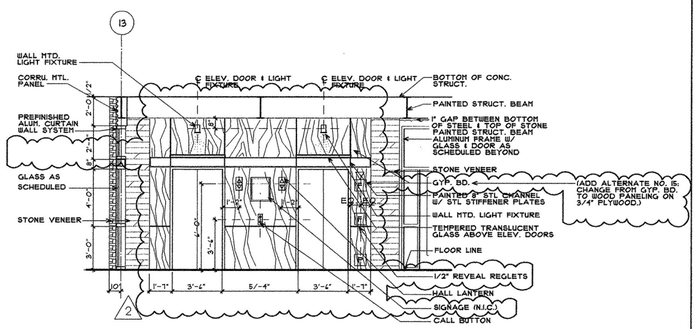

2 ELEV. LOBBY INTERIOR ELEVATION
SCALE: 1/4" = 1'-0"

POLK
STANLEY
YEARY
ARCHITECTS, LTD.

700 SOUTH SCHILLER
LITTLE ROCK, AR 72201
501 378-0878
FAX 372-7629

21 W. MOUNTAIN, SUITE 227
FAYETTEVILLE, AR 72701
479-444-0473

CONSULTANTS:

OWNER'S PROJECT ADVISOR:
MOSES TUCKER REAL ESTATE, INC.

CIVIL ENGINEER:
McCLELLAND ENGINEERS

LANDSCAPE ARCHITECT:
LARSON BURNS SMITH

STRUCTURAL ENGINEER:
CROMWELL ENGINEERS INC.

MECH., ELEC., PLUMB. ENGINEER:
CROMWELL ENGINEERS INC.

SUSTAINABLE CONSULTANT:
BNIM / ELEMENTS

GLOBAL VILLAGE CONSULTANT
CAMBRIDGE SEVEN ASSOCIATES

INTERIOR DESIGNER:
POLK STANLEY YEARY

GENERAL CONTRACTOR:
CDI

GENERAL NOTES:

NOTES:

ISSUE DATE:
100% GMP
PACKAGE #6
FEBRUARY 2, 2004

REVISIONS:

#	DATE	DESCRIPTION
1	2/02/04	100% G.M.P.
2	01JUL04	PACKAGE #1

HEIFER
INTERNATIONAL
CENTER
OFFICE BUILDING
LITTLE ROCK, ARKANSAS

PSY PROJECT NUMBER:
431C

POLK STANLEY FOWLKES CURZON PORTER ARCHITECTS INCORPORATED C-138 ARKANSAS REGISTERED

CONTENTS:
ENLARGED PLANS -
ELEVATOR CORE & LOBBY

SHEET NUMBER:
A601

P:\D-DWG\431C\CA\FinalD\stangFor\CDs\Final\A401-CORE.DJS 1/1/2004 11:51 AM

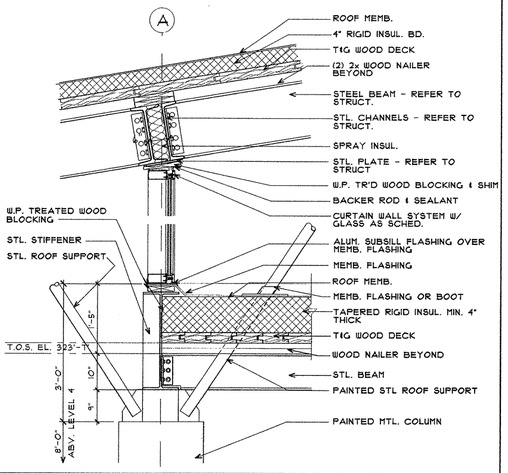

1 SECTION DETAIL
SCALE: 3/4" = 1'-0"

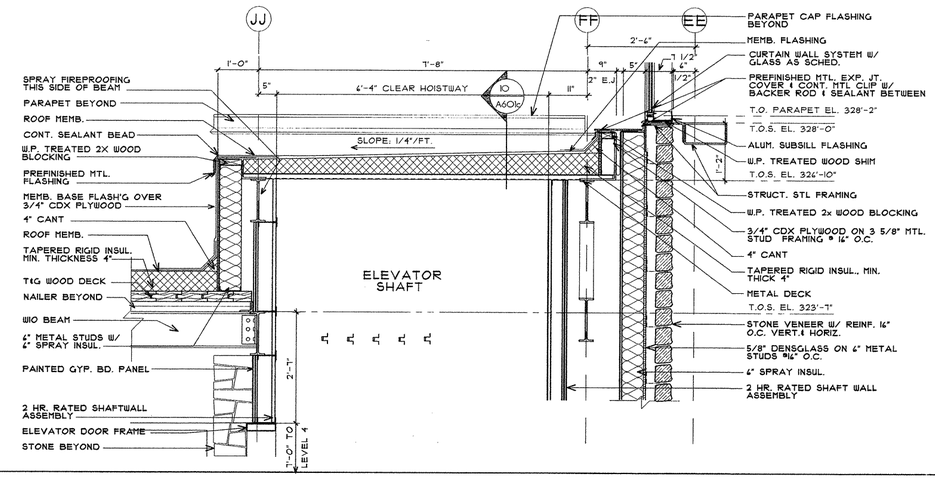

2 SECTION DETAIL
SCALE: 3/4" = 1'-0"

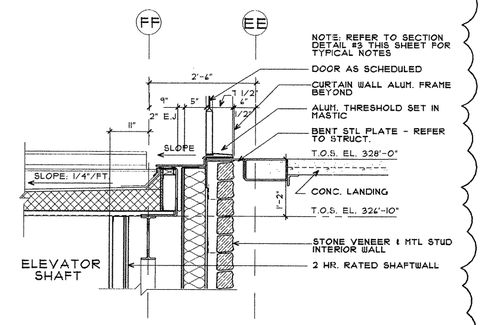

3 SECTION DETAIL
SCALE: 3/4" = 1'-0"

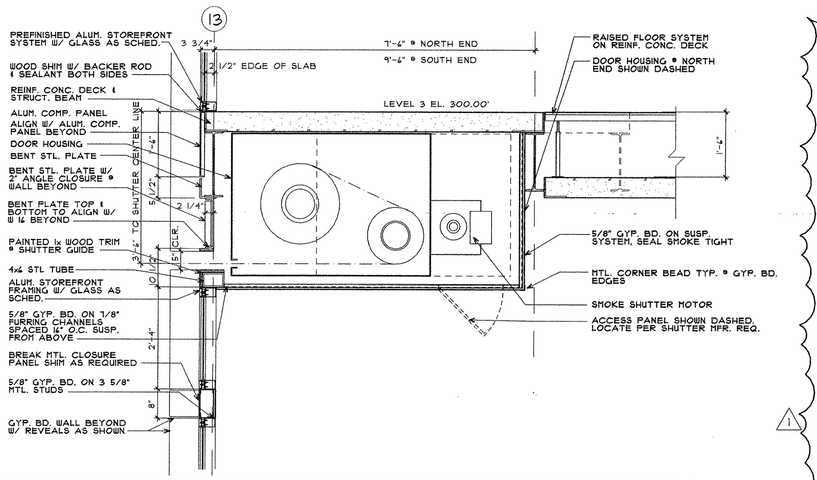

4 SMOKE SHUTTER SECTION
SCALE: 3/4" = 1'-0"

POLK
STANLEY
YEARY
ARCHITECTS, LTD.

700 SOUTH SCHILLER
LITTLE ROCK, AR 72201
501 378-0878
FAX 372-7629

21 W. MOUNTAIN, SUITE 227
FAYETTEVILLE, AR 72701
479-444-0473

CONSULTANTS:

OWNER'S PROJECT ADVISOR:
MOSES TUCKER REAL ESTATE, INC.

CIVIL ENGINEER:
McCLELLAND ENGINEERS

LANDSCAPE ARCHITECT:
LARSON BURNS SMITH

STRUCTURAL ENGINEER:
CROMWELL ENGINEERS INC.

MECH., ELEC., PLUMB. ENGINEER:
CROMWELL ENGINEERS INC.

SUSTAINABLE CONSULTANT:
BNIM / ELEMENTS

GLOBAL VILLAGE CONSULTANT
CAMBRIDGE SEVEN ASSOCIATES

INTERIOR DESIGNER:
POLK STANLEY YEARY

GENERAL CONTRACTOR:
CDI

GENERAL NOTES:

1. REFER TO STRUCTURAL FOR EXTERIOR WALL STUD GAUGE.

NOTES:

ISSUE DATE:
100% GMP
PACKAGE #6
FEBRUARY 2, 2004

REVISIONS:

#	DATE	DESCRIPTION
1	01JUL04	100% GMP ADDENDUM

HEIFER INTERNATIONAL CENTER OFFICE BUILDING

LITTLE ROCK, ARKANSAS

PSY PROJECT NUMBER:
431C

CONTENTS: .
SECTION DETAILS

SHEET NUMBER:

A601e

P:\10-0100\V10\CAD\PlotDrawings\PrCD's\Final\A601e1-Y.dwg, Thursday, July 01, 2004 1:14 PM

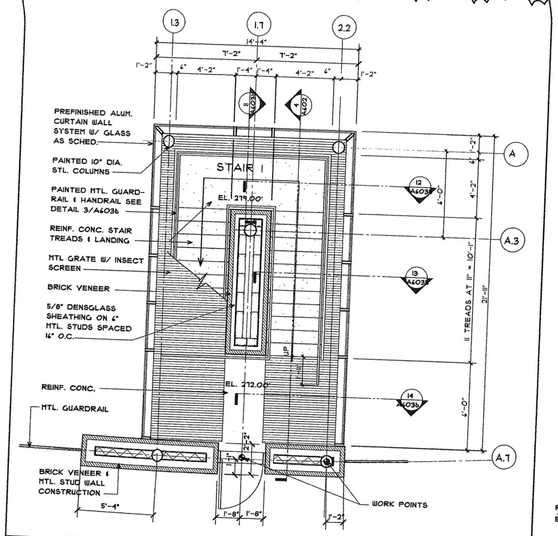

1 STAIR 1 AT 1st. FLOOR LEVEL
SCALE: 1/4" = 1'-0"

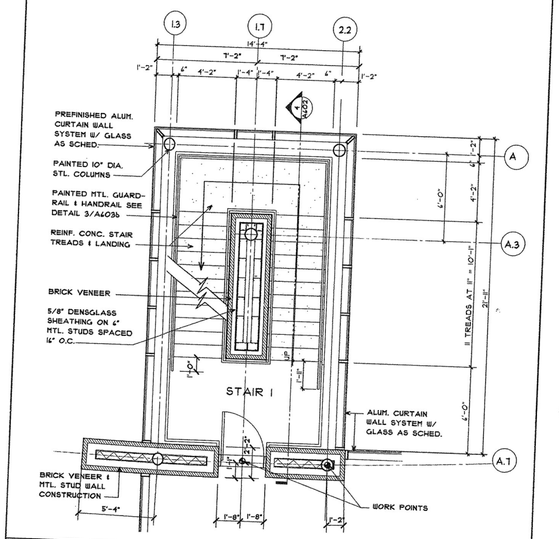

2 STAIR 1 AT 2nd., 3rd., & 4th. FLOOR LEVEL
SCALE: 1/4" = 1'-0"

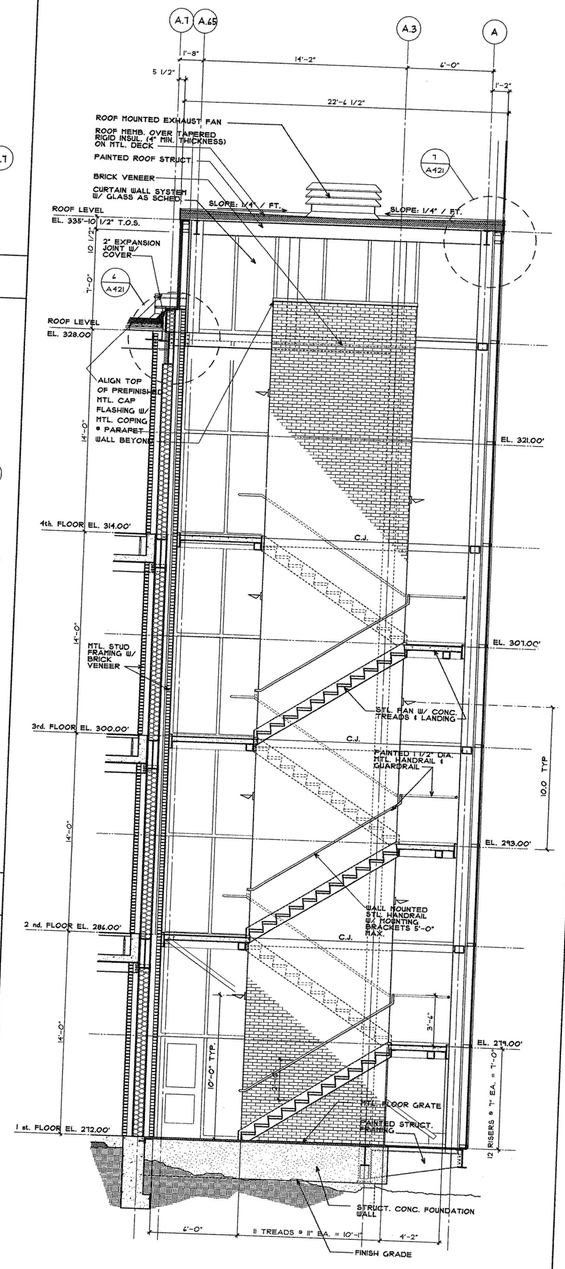

4 STAIR 1 - SECTION
SCALE: 1/4" = 1'-0"

POLK
STANLEY
YEARY
ARCHITECTS, LTD.

700 SOUTH SCHILLER
LITTLE ROCK, AR 72201
501 378-0878
FAX 372-7629

21 W. MOUNTAIN, SUITE 227
FAYETTEVILLE, AR 72701
479-444-0473

CONSULTANTS:

OWNER'S PROJECT ADVISOR:
MOSES TUCKER REAL ESTATE, INC.

CIVIL ENGINEER:
McCLELLAND ENGINEERS

LANDSCAPE ARCHITECT:
LARSON BURNS SMITH

STRUCTURAL ENGINEER:
CROMWELL ENGINEERS INC.

MECH., ELEC., PLUMB. ENGINEER:
CROMWELL ENGINEERS INC.

SUSTAINABLE CONSULTANT:
BNIM / ELEMENTS

GLOBAL VILLAGE CONSULTANT
CAMBRIDGE SEVEN ASSOCIATES

INTERIOR DESIGNER:
POLK STANLEY YEARY

GENERAL CONTRACTOR:
CDI

GENERAL NOTES:

NOTES:

ISSUE DATE:
CORE/SHELL
PACKAGE #5
DECEMBER 15, 2003

REVISIONS:

#	DATE	DESCRIPTION
1	01 JULY 04	PACKAGE #1

HEIFER INTERNATIONAL CENTER OFFICE BUILDING

LITTLE ROCK, ARKANSAS

PSY PROJECT NUMBER:
431C

POLK STANLEY ROWLAND CURZON PORTER ARCHITECTS CORPORATION REGISTERED LITTLE ROCK ARKANSAS

CONTENTS:
ENLARGED PLANS, SECTION-STAIR 1

SHEET NUMBER:

P:\D-DRGS\43C\Cad\Proj\Drawings*=CDs\Proj-A403-EnlargedStairPlans
Thursday, July 01, 2004 1:01 PM

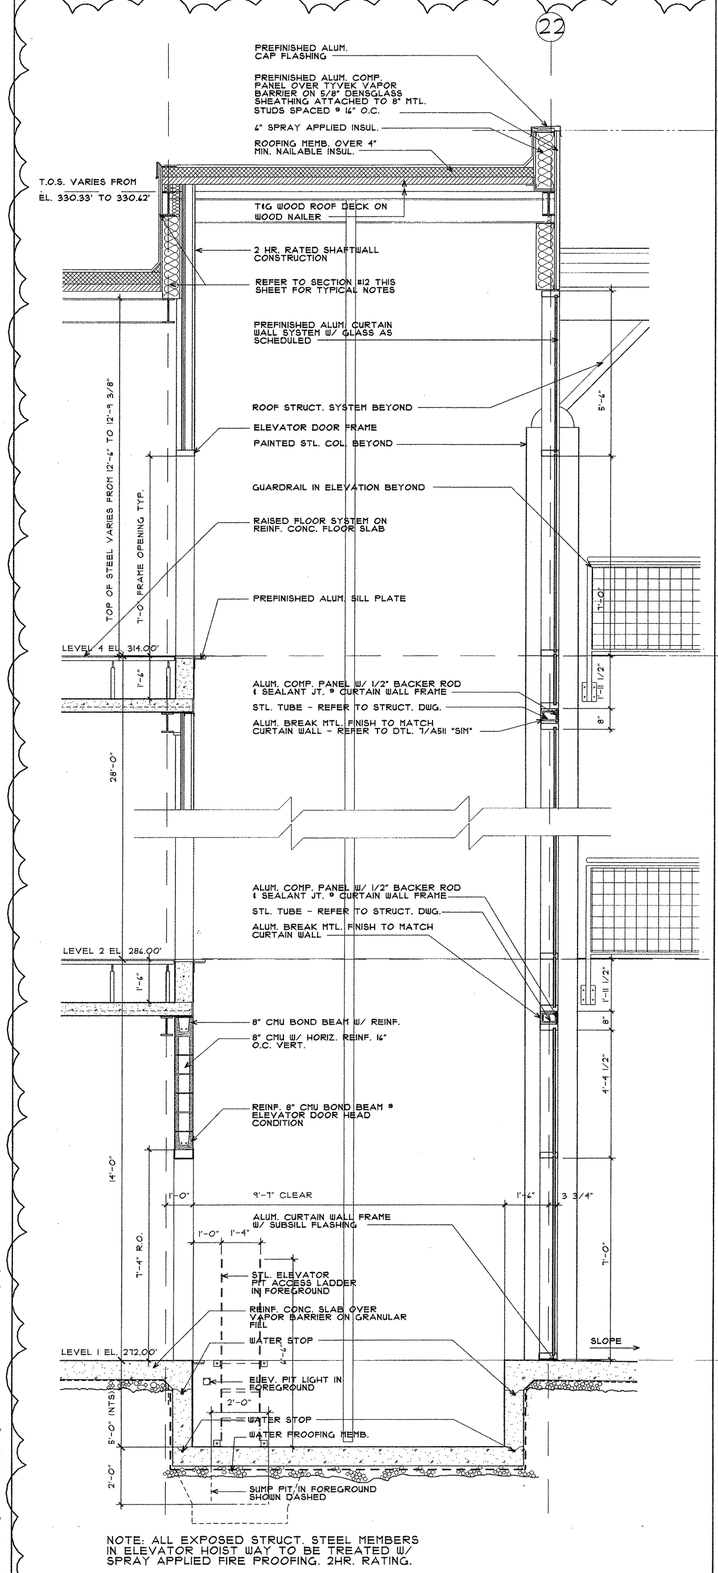

11 FREIGHT ELEVATOR SECTION
SCALE: 1/2" = 1'-0"

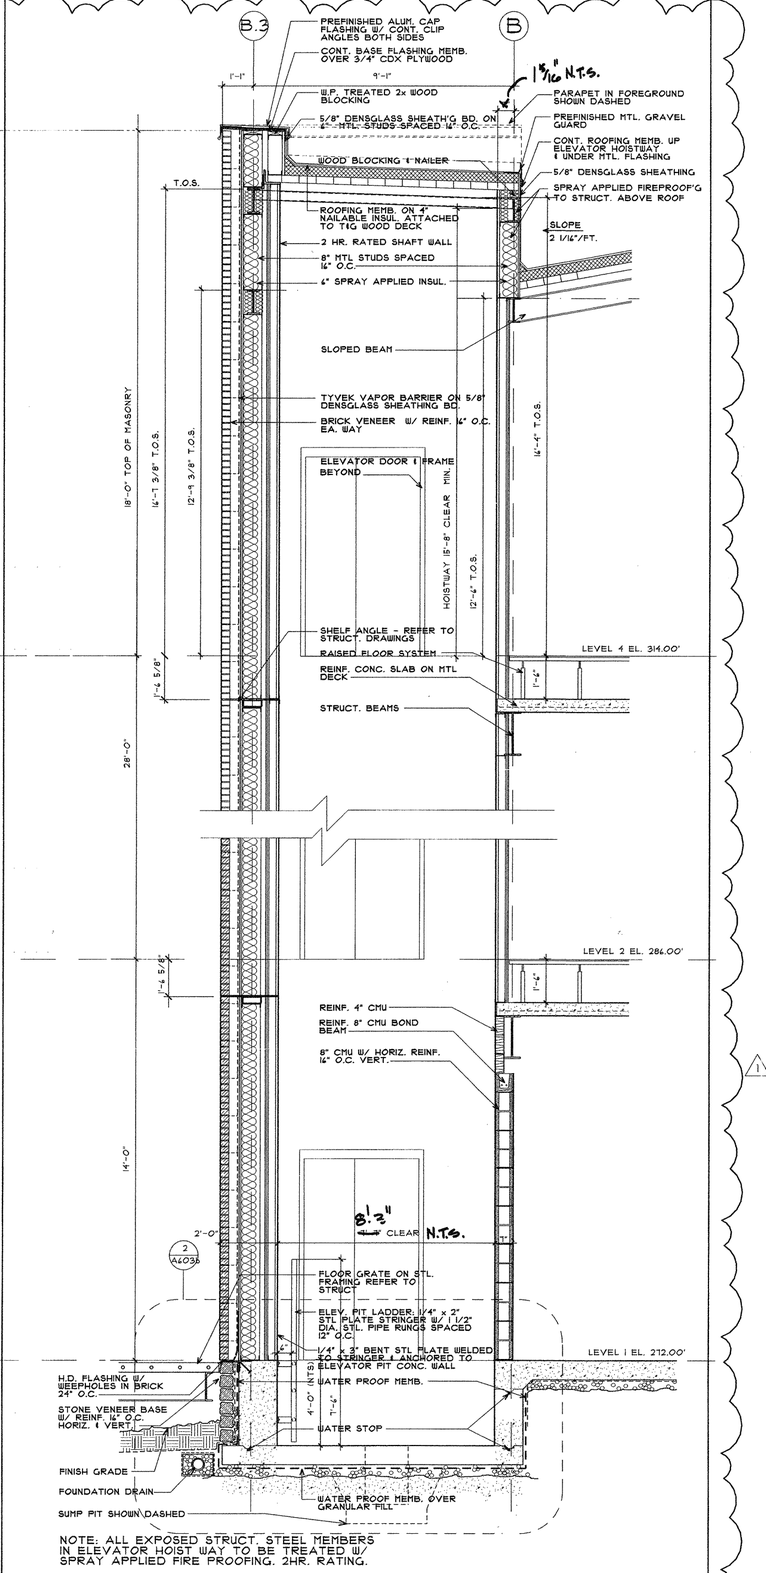

12 FREIGHT ELEVATOR SECTION
SCALE: 1/2" = 1'-0"

P:\D-Dist\1stDC\Cpt\Revit\new\P_mcDuff-mkt\A403a-FreightElevatorSections Thursday, July 01, 2004 1:41 PM

POLK
STANLEY
YEARY
ARCHITECTS, LTD.

700 SOUTH SCHILLER
LITTLE ROCK, AR 72201
501 378-0878
FAX 372-7629

21 W. MOUNTAIN, SUITE 227
FAYETTEVILLE, AR 72701
479-444-0473

CONSULTANTS:

OWNER'S PROJECT ADVISOR:
MOSES TUCKER REAL ESTATE, INC.

CIVIL ENGINEER:
McCLELLAND ENGINEERS

LANDSCAPE ARCHITECT:
LARSON BURNS SMITH

STRUCTURAL ENGINEER:
CROMWELL ENGINEERS INC.

MECH., ELEC., PLUMB. ENGINEER:
CROMWELL ENGINEERS INC.

SUSTAINABLE CONSULTANT:
BNIM / ELEMENTS

GLOBAL VILLAGE CONSULTANT
CAMBRIDGE SEVEN ASSOCIATES

INTERIOR DESIGNER:
POLK STANLEY YEARY

GENERAL CONTRACTOR:
CDI

GENERAL NOTES:

1. REFER TO STRUCTURAL FOR EXTERIOR WALL STUD GAUGE.

NOTES:

ISSUE DATE:
100% G.M.P.
PACKAGE #6
FEBRUARY 2, 2004

REVISIONS:

#	DATE	DESCRIPTION
1	01JUL04	PACKAGE 7

HEIFER INTERNATIONAL CENTER OFFICE BUILDING

LITTLE ROCK, ARKANSAS

PSY PROJECT NUMBER:
431C

CONTENTS:
FREIGHT ELEVATOR SECTION

SHEET NUMBER:
A603a

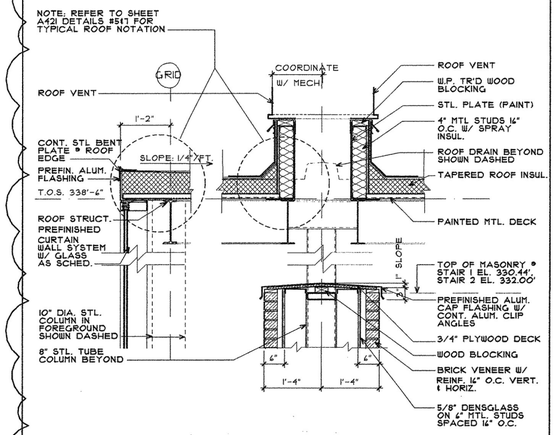

1 ROOF SECTION
SCALE: 3/4" = 1'-0"

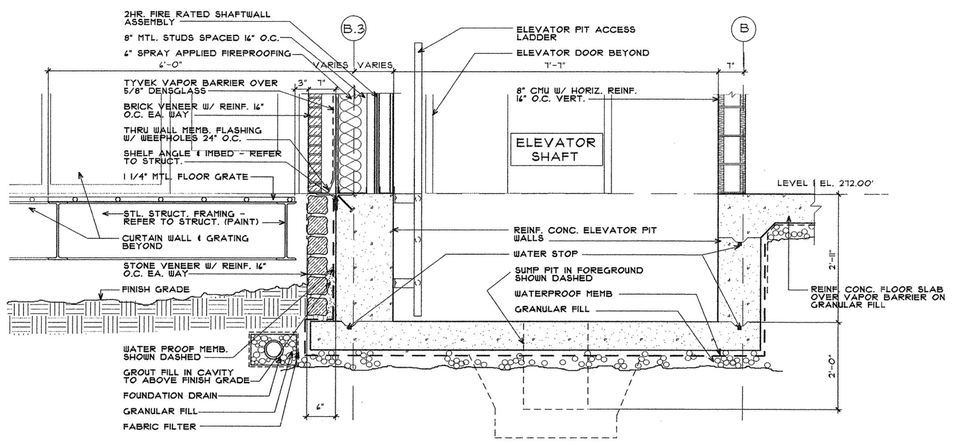

2 SECTION @ FREIGHT ELEVATOR SHAFT
SCALE: 3/4" = 1'-0"

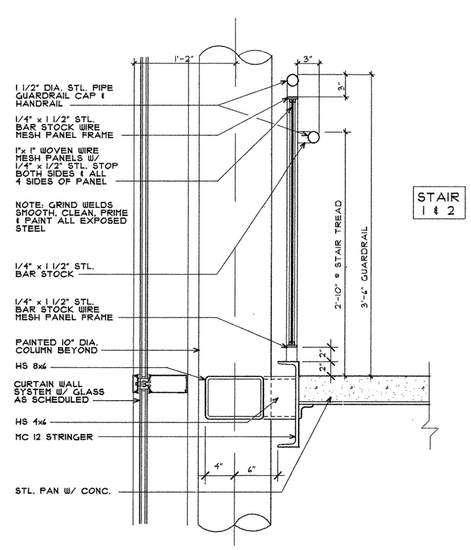

3 SECT. @ LANDING/FLR. LEVEL
SCALE: 1 1/2" = 1'-0" STAIRS 1&2

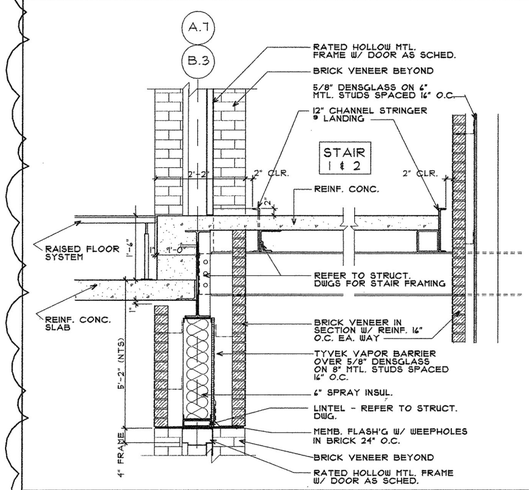

6 SECTION @ LANDING & DOOR
SCALE: 3/4" = 1'-0"

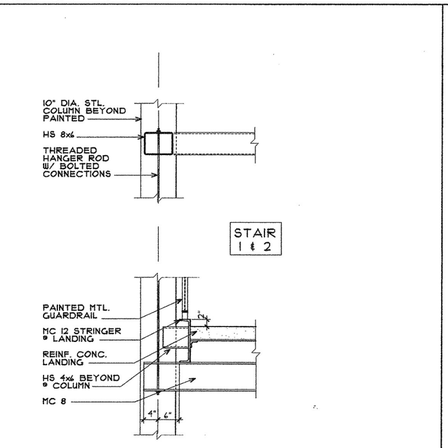

SECTION "A"

7 SECT. @ LANDING STAIRS 1&2
SCALE: 3/4" = 1'-0"

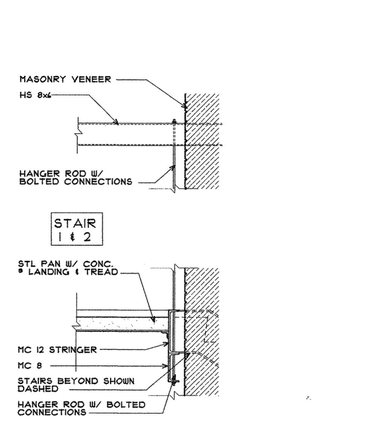

SECTION "B"

8 SECT. @ LANDING STAIRS 1&2
SCALE: 3/4" = 1'-0"

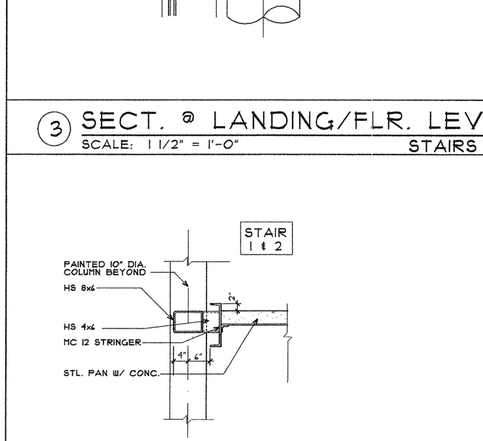

SECTION "C"

9 SECT. @ LANDING/FLR. LEVEL
SCALE: 3/4" = 1'-0" STAIRS 1&2

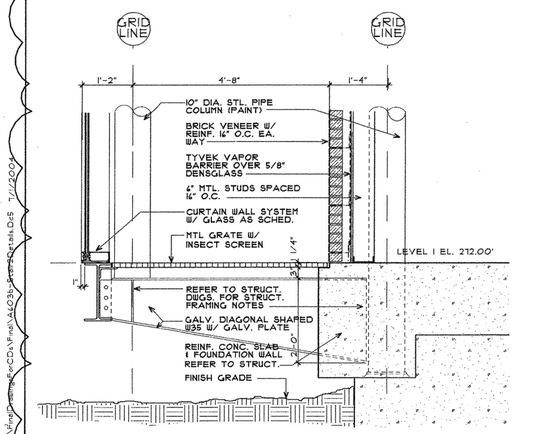

11 SECTION @ LEVEL 1 LANDING
SCALE: 3/4" = 1'-0"

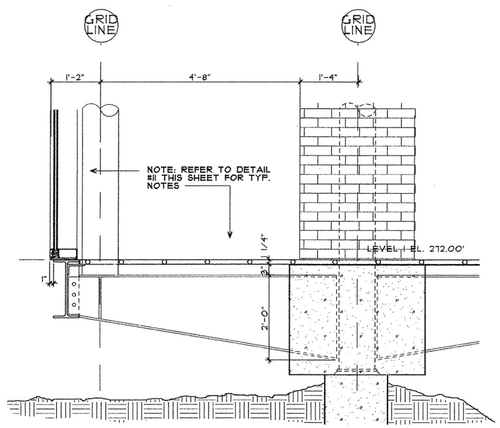

12 SECTION @ LEVEL 1 LANDING
SCALE: 3/4" = 1'-0"

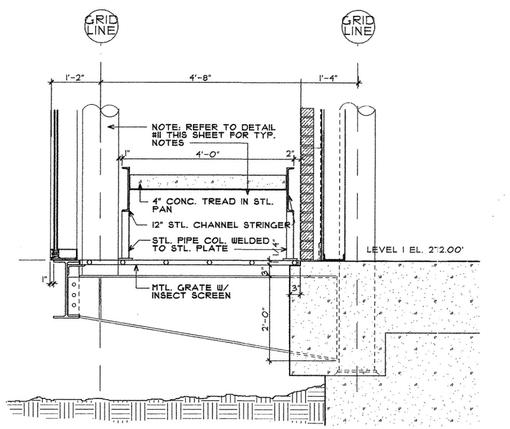

13 SECTION THRU TREAD @ STAIR
SCALE: 3/4" = 1'-0"

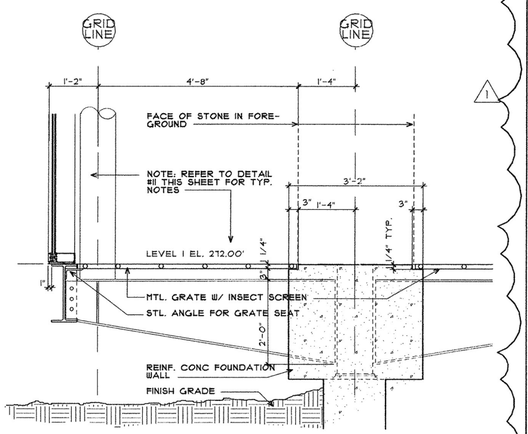

14 SECTION @ LEVEL 1 LANDING
SCALE: 3/4" = 1'-0"

POLK STANLEY YEARY
ARCHITECTS, LTD.

700 SOUTH SCHILLER
LITTLE ROCK, AR 72201
501 378-0878
FAX 372-7629

21 W. MOUNTAIN, SUITE 227
FAYETTEVILLE, AR 72701
479-444-0473

CONSULTANTS:

OWNER'S PROJECT ADVISOR:
MOSES TUCKER REAL ESTATE, INC.

CIVIL ENGINEER:
McCLELLAND ENGINEERS

LANDSCAPE ARCHITECT:
LARSON BURNS SMITH

STRUCTURAL ENGINEER:
CROMWELL ENGINEERS INC.

MECH., ELEC., PLUMB. ENGINEER:
CROMWELL ENGINEERS INC.

SUSTAINABLE CONSULTANT:
BNIM / ELEMENTS

GLOBAL VILLAGE CONSULTANT
CAMBRIDGE SEVEN ASSOCIATES

INTERIOR DESIGNER:
POLK STANLEY YEARY

GENERAL CONTRACTOR:
CDI

GENERAL NOTES:

NOTES:

ISSUE DATE:
100% GMP
PACKAGE #6
FEBRUARY 2, 2004

REVISIONS:

#	DATE	DESCRIPTION
1	04.01.04	PACKAGE 7

HEIFER INTERNATIONAL CENTER OFFICE BUILDING
LITTLE ROCK, ARKANSAS

PSY PROJECT NUMBER:
431C

CONTENTS:
STAIR 2 DETAILS

SHEET NUMBER:
A603b

P:\S-DILO\431C\CAD\Arch\Sheets\CDAP Arch\A603b.dwg, 1/4/2004 7:49:05 PM, Adobe PDF

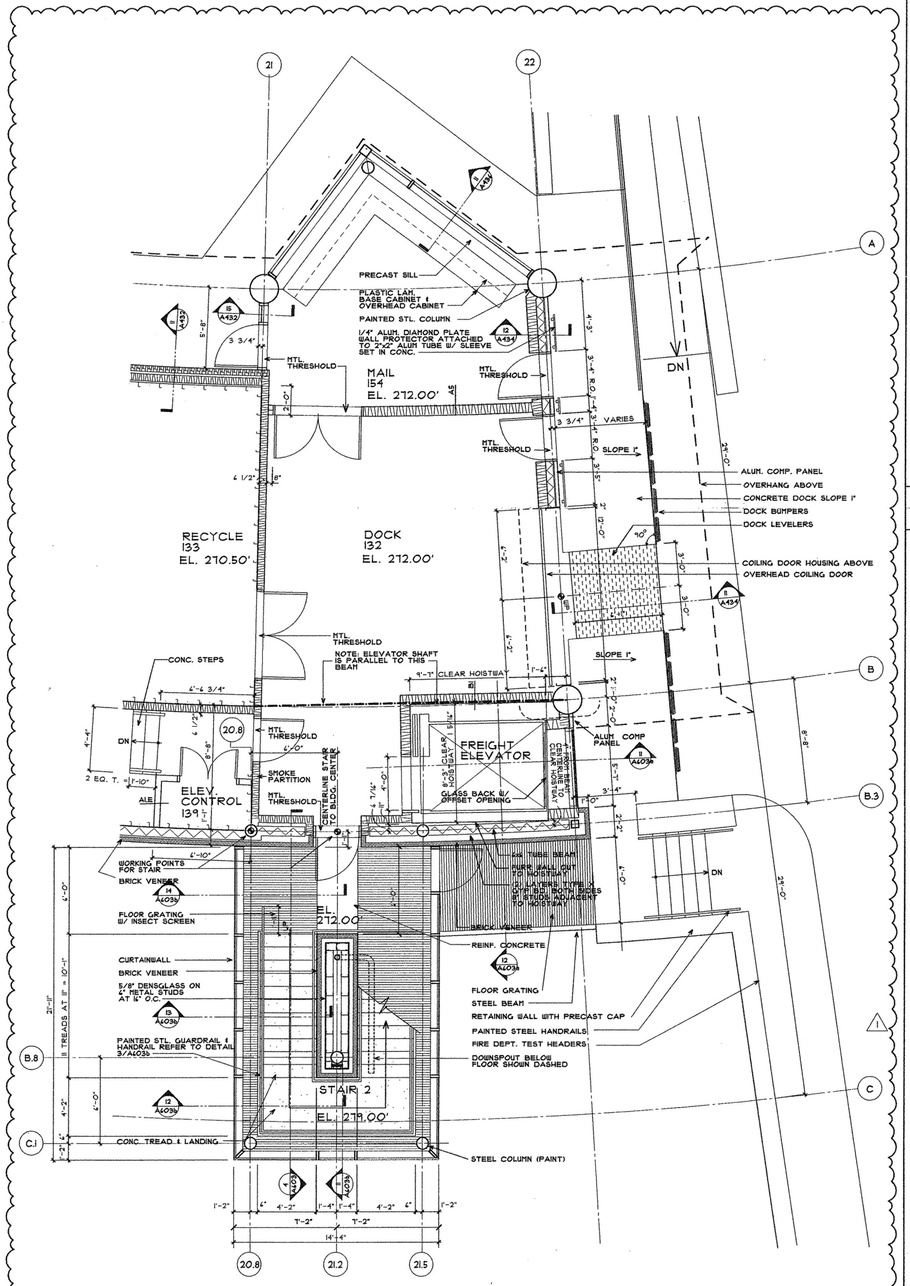

1 STAIR 2 AT 1st. FLOOR LEVEL
SCALE: 1/4" = 1'-0"

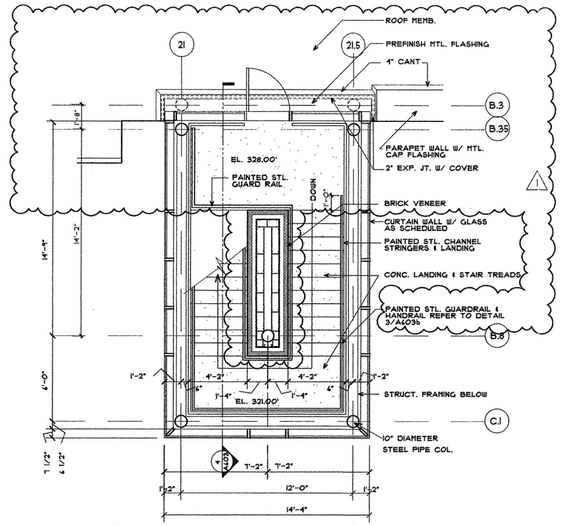

3 STAIR 2 AT ROOF LEVEL
SCALE: 1/4" = 1'-0"

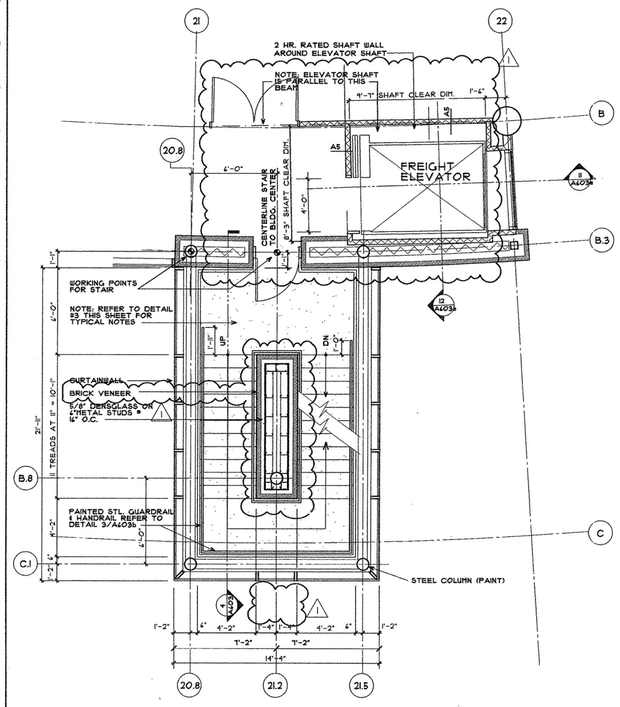

2 STAIR 2 AT 2nd. 3rd. & 4th. FLOOR LEVEL
SCALE: 1/4" = 1'-0"

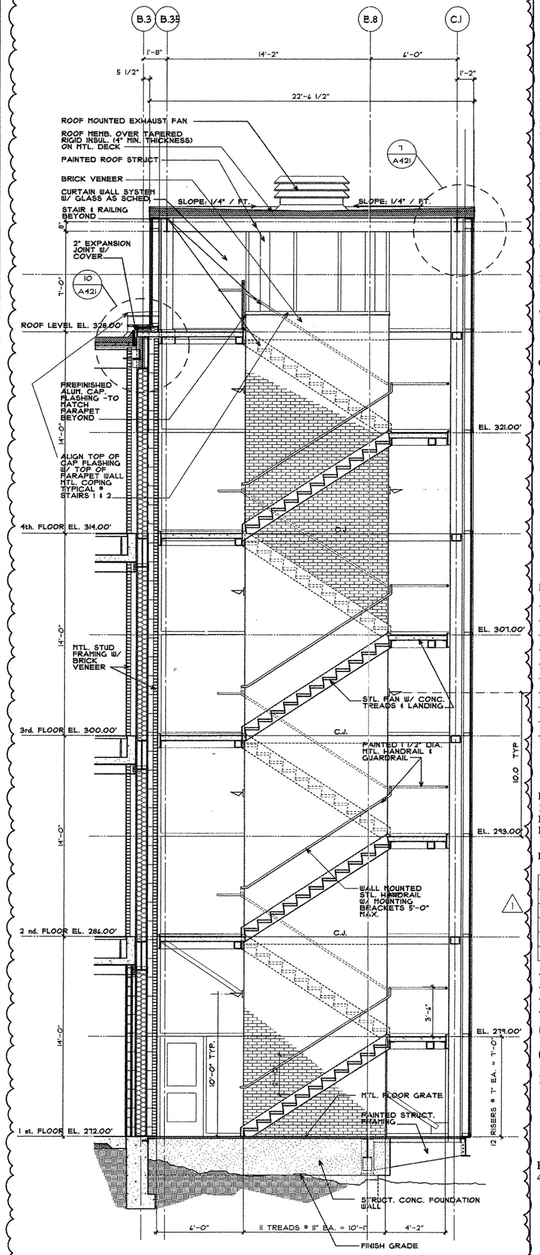

4 STAIR 2 - SECTION
SCALE: 1/4" = 1'-0"

POLK
STANLEY
YEARY
ARCHITECTS, LTD.

700 SOUTH SCHILLER
LITTLE ROCK, AR 72201
501 378-0878
FAX 372-7629

21 W. MOUNTAIN, SUITE 227
FAYETTEVILLE, AR 72701
479-444-0473

CONSULTANTS:

OWNER'S PROJECT ADVISOR:
MOSES TUCKER REAL ESTATE, INC.

CIVIL ENGINEER:
McCLELLAND ENGINEERS

LANDSCAPE ARCHITECT:
LARSON BURNS SMITH

STRUCTURAL ENGINEER:
CROMWELL ENGINEERS INC.

MECH., ELEC., PLUMB. ENGINEER:
CROMWELL ENGINEERS INC.

SUSTAINABLE CONSULTANT:
BNIM / ELEMENTS

GLOBAL VILLAGE CONSULTANT
CAMBRIDGE SEVEN ASSOCIATES

INTERIOR DESIGNER:
POLK STANLEY YEARY

GENERAL CONTRACTOR:
CDI

GENERAL NOTES:

NOTES:

ISSUE DATE:
100% G.M.P.
PACKAGE #6
FEBRUARY 2, 2004

REVISIONS:

#	DATE	DESCRIPTION
1	01 JULY 04	PACKAGE #7

HEIFER INTERNATIONAL CENTER OFFICE BUILDING

LITTLE ROCK, ARKANSAS

PSY PROJECT NUMBER:
431C

CONTENTS:
ENLARGED PLANS-
STAIR 2 & FREIGHT ELEV.

SHEET NUMBER:
A603

P:\D-DEGW\BIC\CAD\ad0\drawings\ac20\b\Arch\A603-Enlarged Stair 2.dwg Friday, July 02, 2004 1:21 AM

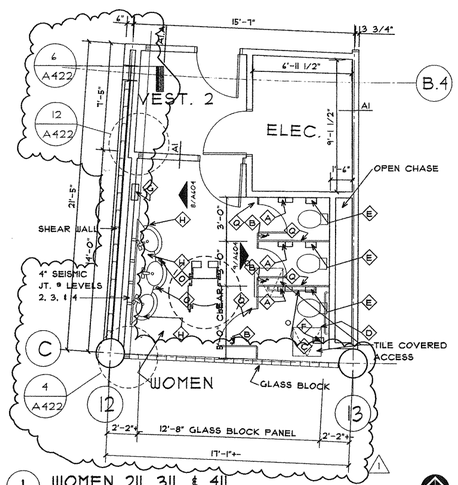

1 WOMEN 211, 311, & 411
SCALE: 1/4" = 1'-0"

NORTH

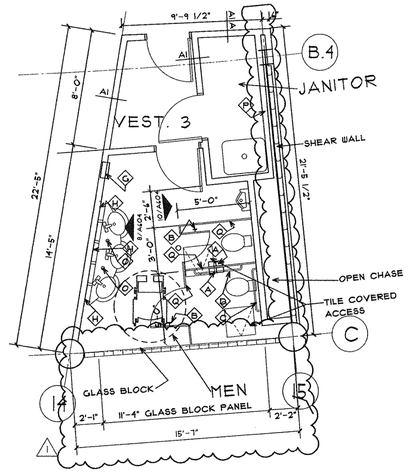

2 MEN 310, & 410
SCALE: 1/4" = 1'-0"

NORTH

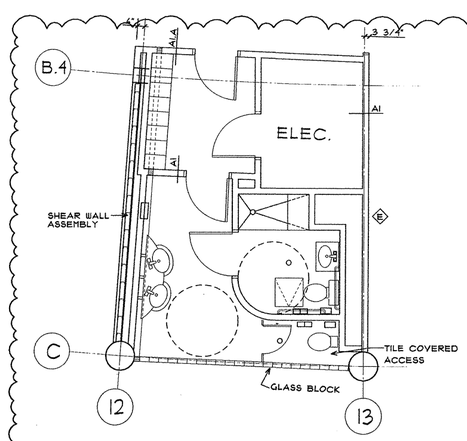

3 WOMEN 111
SCALE: 1/4" = 1'-0"

NORTH

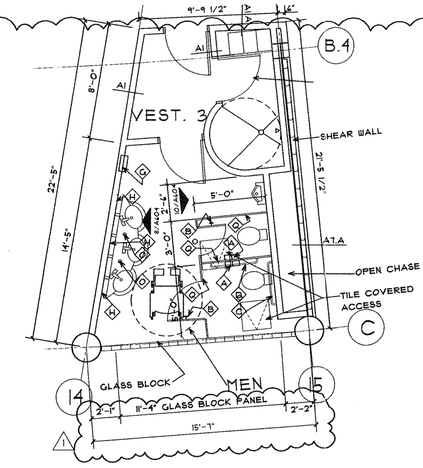

4 MEN 110, & 210
SCALE: 1/4" = 1'-0"

NORTH

TOILET ACCESSORIES SCHEDULE

MARK	SIZE	MANUFACTURER	MODEL NUMBER AND FINISH	DESCRIPTION / REMARKS
A	DOUBLE ROLL	BOBRICK	B-684 STAINLESS STEEL	SURFACE MOUNTED DOUBLE ROLL TOILET TISSUE HOLDER. MOUNT 20" TO CENTER ABOVE FINISH FLOOR.
B	2" X 2"	BOBRICK	B-670 STAINLESS STEEL	SURFACE MOUNTED UTILITY HOOK. MOUNT AT 48" ABOVE FINISH FLOOR
C	1 1/4" DIAMETER	BOBRICK	B-5806 X 48 STAINLESS STEEL	SURFACE MOUNTED GRAB BAR WITH CONCEALED FASTENERS. MOUNT 35" ABOVE FINISH FLOOR
D	1 1/4" DIAMETER	BOBRICK	B-5806 X 36 STAINLESS STEEL	SURFACE MOUNTED GRAB BAR WITH CONCEALED FASTENERS. MOUNT 35" ABOVE FINISH FLOOR
E	8" X 11" W/SHELF	BOBRICK	B-211 & B210-12 STAINLESS STEEL	SURFACE MOUNTED SANITARY NAPKIN DISPOSAL CABINET. MOUNT 24" ABOVE FINISH FLOOR
F	14 1/2" X 5 3/4"	BOBRICK	B-287 STAINLESS STEEL	SURFACE MOUNTED FOLDING UTILITY SHELF. MOUNT 36" ABOVE FINISH FLOOR
G	15 1/8" X 54"	BOBRICK	B-3941 STAINLESS STEEL	RECESSED MOUNTED PAPER TOWEL DISP. AND WASTE RECEPT. MOUNT BOT. OF CAB. ABOVE FLOOR BASE
H	108" X 48"	BOBRICK	B-290-4836 STAIN. STL.FRAMED	SURFACE MOUNTED TEMPERED GLASS MIRROR. MOUNT BOTTOM OF MIRROR.
I	30" X 48"	BOBRICK	B-290-4830 STAIN. STL. FRAMED	SURFACE MOUNTED TEMPERED GLASS MIRROR. MOUNT BOTTOM OF MIRROR.
J	NOT USED	NOT USED	NOT USED	NOT USED
K	42" X 72"	BOBRICK	B-204-2 VINYL	VINYL SHOWER CURTAIN. MOUNTED ON SHOWER CURTAIN ROD.
L	42"	BOBRICK	B-4101 STAINLESS STEEL	SURFACE MOUNTED SHOWER CURTAIN ROD. MOUNTED AT 73" ABOVE FINISH FLOOR.
M	1" DIAMETER	BOBRICK	B-204-1 STAINLESS STEEL	SHOWER CURTAIN ROD HOOKS. MOUNTED AT TOP OF CURTAIN.
N	2 3/4" DIAMETER	BOBRICK	B-211 STAINLESS STEEL	HEAVY DUTY ROBE HOOK WITH CONCEALED FASTENERS. MOUNTED AT 60" ABOVE FINISH FLOOR.
O	3 1/4" DIAMETER	BOBRICK	B-8221A STAINLESS STEEL	LAVATORY MOUNTED LIQUID SOAP DISPENSER . MOUNTED THRU LAV HOLE.
P	48" LONG	BOBRICK	B-224 X 48 STAINLESS STEEL	SURFACE MOUNTED UTILITY SHELF MOP/BROOM (6) HOLDERS. MOUNTED 60" ABOVE FINISH FLOOR.
Q	1010 SERIES	BOBRICK	1011 STAINLESS STEEL	FLOOR ANCHORED TOILET COMPARTMENTS. TOP OF PANEL TO BE 5'-10" ABOVE FINISH FLOOR.
R	5' LONG	IDEAL PRODUCTS	1 1/4" RED OAK TOP WITH 14" HIGH BLACK T-LEGS	RED OAK WOOD TOP WITH METAL BLACK POWDERCOATED T-LEGS, NOT ANCHORED TO FLOOR.
S	1000 SERIES	IDEAL PRODUCTS	PLAST. LAM. WHITE INTERIOR	LOCKERS - 12" W. X 18" D. X 84" H. ON 4" BASE WITH KEY LOCKING DEVICES.

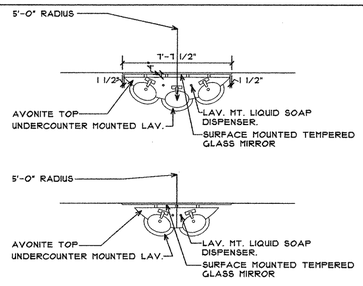

4 PLAN @ LAV. 110, 111, 210, 211, 310, 311, 410, & 411
SCALE: 1/4" = 1'-0"

5 NOT USED
SCALE: 1/4" = 1'-0"

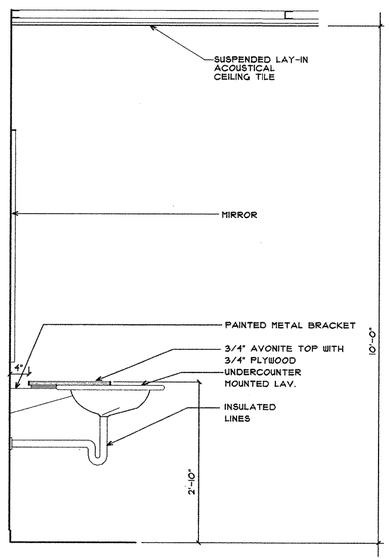

6 SECTION THRU LAVATORY CABINET
SCALE: 1" = 1' - 0"

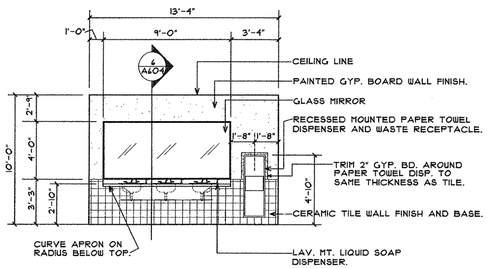

8 TLT. WALL ELEV. - 110, 111, 210, 211, 310, 311, 410, & 411
SCALE: 1/4" = 1'-0"

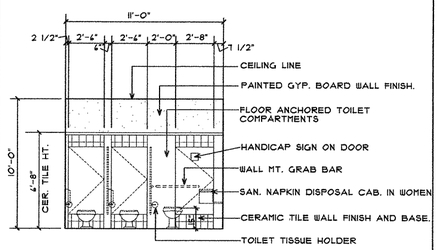

9 TLT. WALL ELEV. - 111, 211, 311, & 411
SCALE: 1/4" = 1'-0"

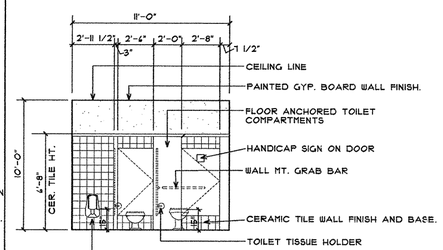

10 TLT. WALL ELEV. - 110, 210, 310, & 410
SCALE: 1/4 = 1'-0"

POLK STANLEY YEARY
ARCHITECTS, LTD.

700 SOUTH SCHILLER
LITTLE ROCK, AR 72201
501 378-0878
FAX 372-7629

21 W. MOUNTAIN, SUITE 227
FAYETTEVILLE, AR 72701
479-444-0473

CONSULTANTS:

OWNER'S PROJECT ADVISOR:
MOSES TUCKER REAL ESTATE, INC.

CIVIL ENGINEER:
McCLELLAND ENGINEERS

LANDSCAPE ARCHITECT:
LARSON BURNS SMITH

STRUCTURAL ENGINEER:
CROMWELL ENGINEERS INC.

MECH., ELEC., PLUMB. ENGINEER:
CROMWELL ENGINEERS INC.

SUSTAINABLE CONSULTANT:
BNIM / ELEMENTS

GLOBAL VILLAGE CONSULTANT
CAMBRIDGE SEVEN ASSOCIATES

INTERIOR DESIGNER:
POLK STANLEY YEARY

GENERAL CONTRACTOR:
CDI

GENERAL NOTES:

NOTES:

ISSUE DATE:
100% G.M.P.
PACKAGE #6
FEBRUARY 2, 2004

REVISIONS:

#	DATE	DESCRIPTION
1	01JUL04	PACKAGE #7

HEIFER INTERNATIONAL CENTER OFFICE BUILDING

LITTLE ROCK, ARKANSAS

PSY PROJECT NUMBER:
431C

REGISTERED ARCHITECT
ROBERT RAY POLK
C-1138
ARKANSAS

CONTENTS:
ENLARGED TOILET PLANS

SHEET NUMBER:
A604

P:\10-0200\CAD\Drawings\Arch\A604-EnlargedToiletPlans Thursday, July 01, 2004 1:44 PM

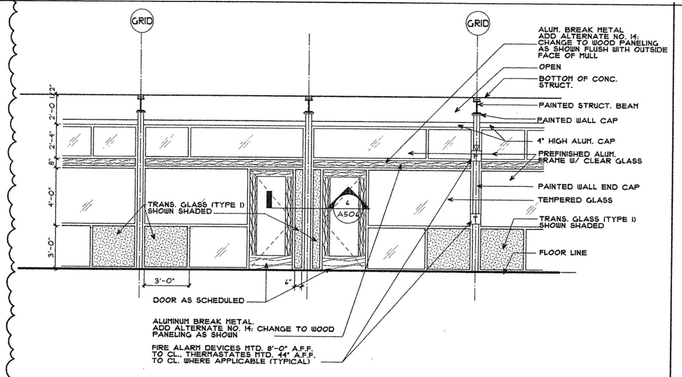

1 OFFICE - INTERIOR ELEVATION
SCALE: 1/4" = 1'-0"

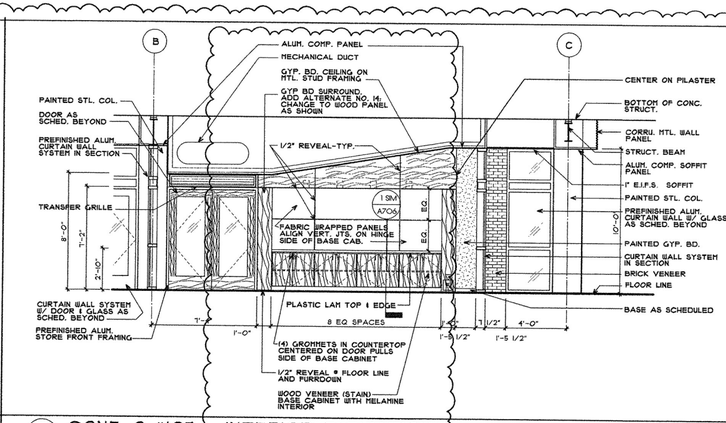

2 CONF. 2 #107 - INTERIOR ELEVATION
SCALE: 1/4" = 1'-0"

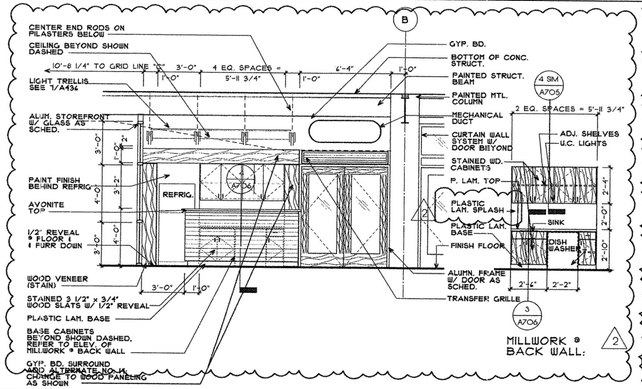

3 BREAK AREA 113
SCALE: 1/4" = 1'-0"

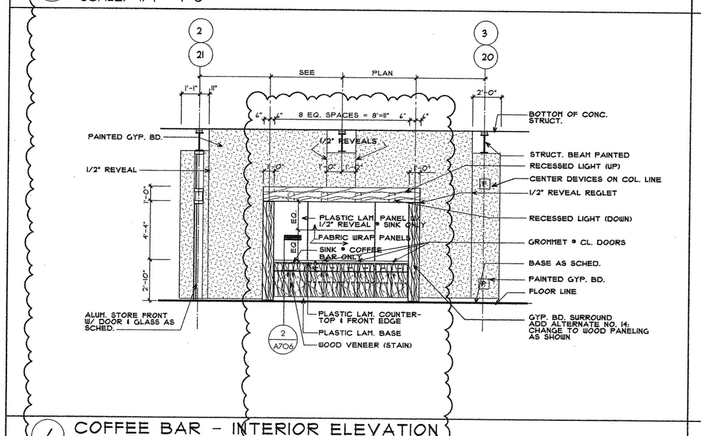

6 COFFEE BAR - INTERIOR ELEVATION
SCALE: 1/4" = 1'-0"

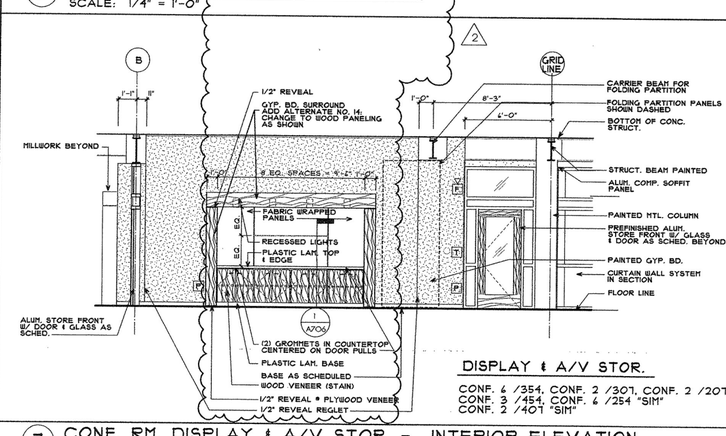

7 CONF. RM. DISPLAY & A/V STOR. - INTERIOR ELEVATION
SCALE: 1/4" = 1'-0"

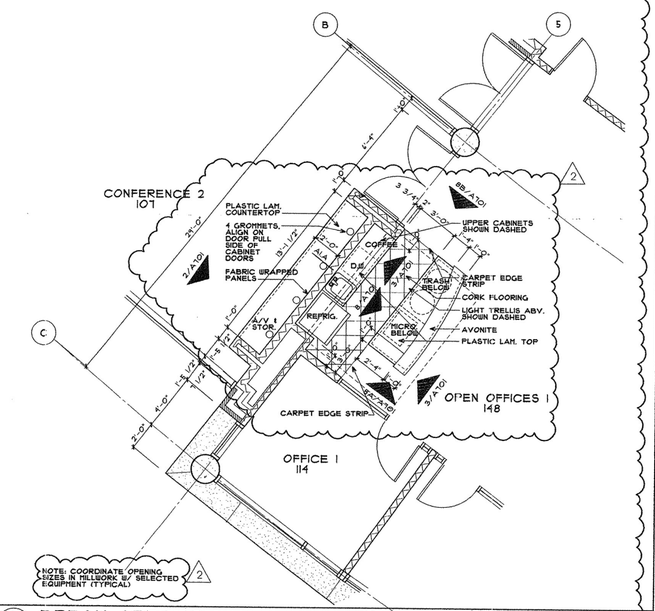

9 BREAK AREA 113
SCALE: 1/4" = 1'-0"

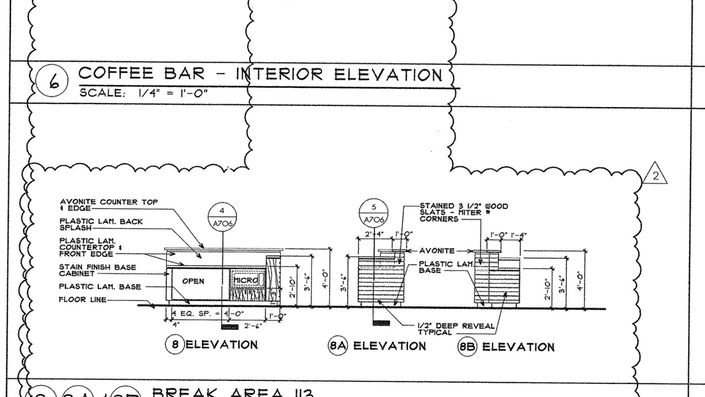

8, 8A, & 8B BREAK AREA 113
SCALE: 1/4" = 1'-0"

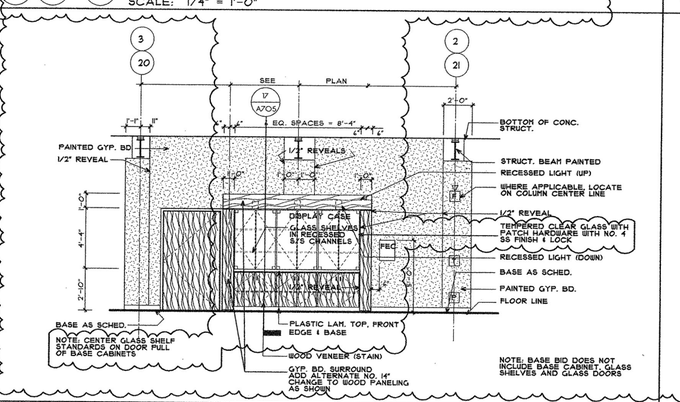

11 DISPLAY CASE - INTERIOR ELEVATION
SCALE: 1/4" = 1'-0"

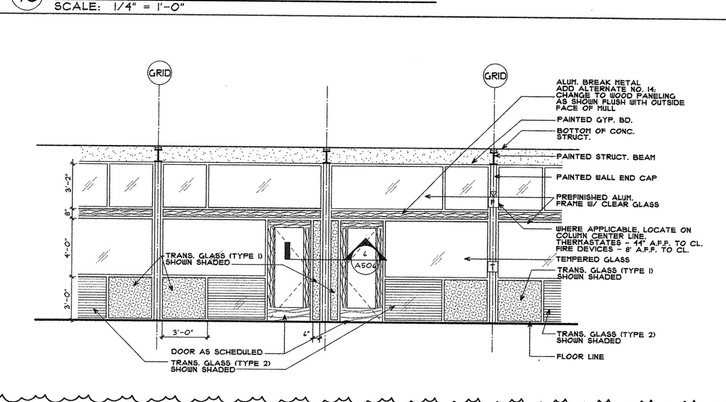

12 OFFICE - INTERIOR ELEVATION
SCALE: 1/4" = 1'-0"

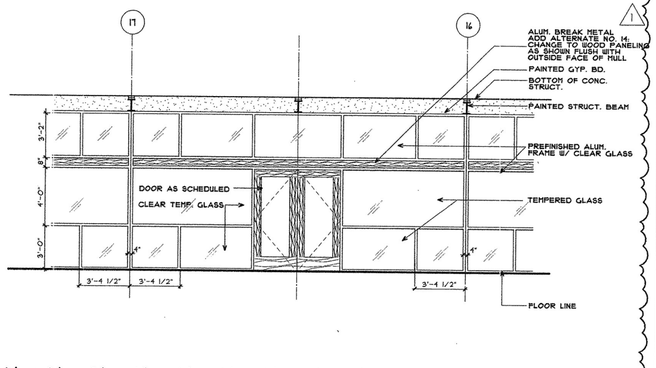

13 CORRIDOR 1 #444 - INTERIOR ELEVATION
SCALE: 1/4" = 1'-0"

POLK
STANLEY
YEARY
ARCHITECTS, LTD.

700 SOUTH SCHILLER
LITTLE ROCK, AR 72201
501 378-0878
FAX 372-7629

21 W. MOUNTAIN, SUITE 227
FAYETTEVILLE, AR 72701
479-444-0473

CONSULTANTS:

OWNER'S PROJECT ADVISOR:
MOSES TUCKER REAL ESTATE, INC.

CIVIL ENGINEER:
McCLELLAND ENGINEERS

LANDSCAPE ARCHITECT:
LARSON BURNS SMITH

STRUCTURAL ENGINEER:
CROMWELL ENGINEERS INC.

MECH., ELEC., PLUMB. ENGINEER:
CROMWELL ENGINEERS INC.

SUSTAINABLE CONSULTANT:
BNIM / ELEMENTS

GLOBAL VILLAGE CONSULTANT
CAMBRIDGE SEVEN ASSOCIATES

INTERIOR DESIGNER:
POLK STANLEY YEARY

GENERAL CONTRACTOR:
CDI

GENERAL NOTES:

1. WOOD REVEALS SHALL BE 1/4"x4"/4" WITH EDGEBAND AND 1/4" WIDE x 1/2" SPACER. CORNERS SHALL BE 1/4"x4"/4" QUIRK WITH EDGEBAND.

NOTES:

ISSUE DATE:
100% GMP
PACKAGE #6
FEBRUARY 2, 2004

REVISIONS:

#	DATE	DESCRIPTION
1	01JUL04	PACKAGE 7
2	30JUL04	A.S.I. 11

HEIFER
INTERNATIONAL
CENTER
OFFICE BUILDING
LITTLE ROCK, ARKANSAS

PSY PROJECT NUMBER:
431C

CONTENTS:
INTERIOR ELEVATIONS

SHEET NUMBER:
A701

P:\D-DISC-1\SYC\Cad\Revit\Archive\CDs\Hrdsh\CD-Interior Elevations Monday, August 01, 2004 4:12 PM

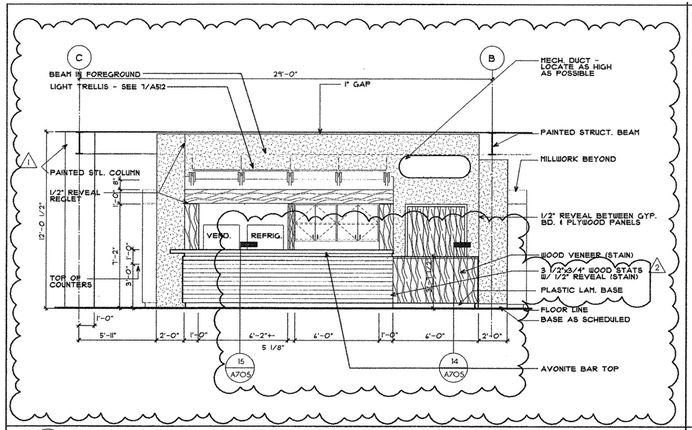

1 BREAK AREA - INTERIOR ELEVATION
SCALE: 1/4" = 1'-0"

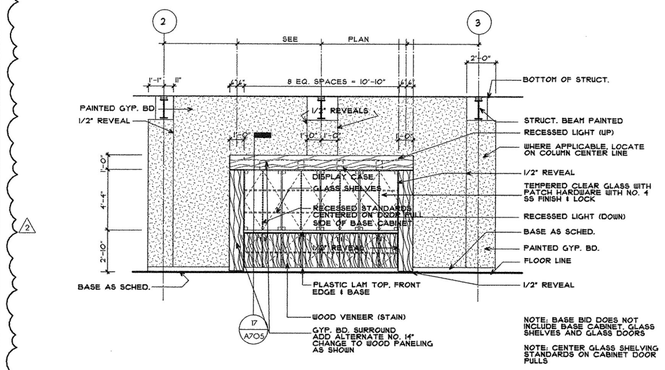

2 DISPLAY CASE - INTERIOR ELEVATION
SCALE: 1/4" = 1'-0"

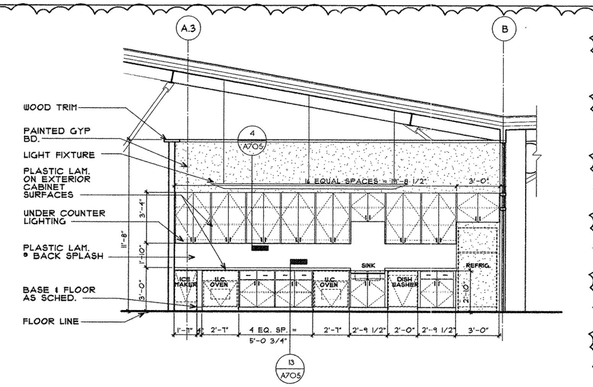

3 BREAK ROOM 461 - INTERIOR ELEVATION
SCALE: 1/4" = 1'-0"

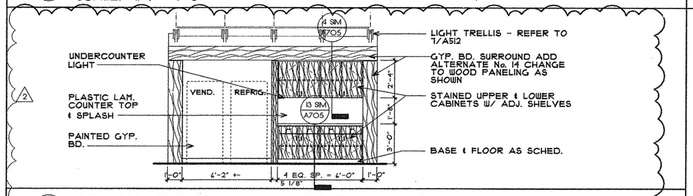

6 BREAK AREA - INTERIOR ELEVATION
SCALE: 1/4" = 1'-0"

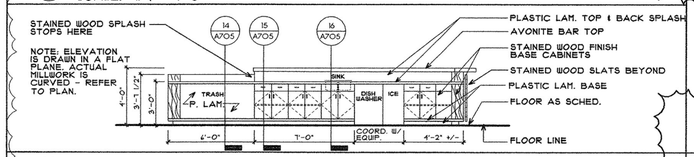

7 BREAK AREA - INTERIOR ELEVATION
SCALE: 1/4" = 1'-0"

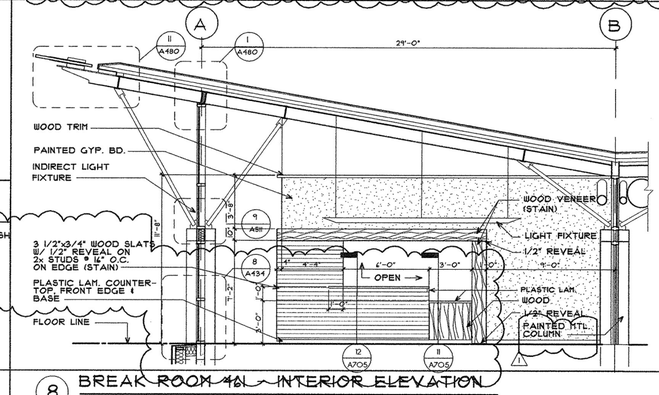

8 BREAK ROOM 461 - INTERIOR ELEVATION
SCALE: 1/4" = 1'-0"

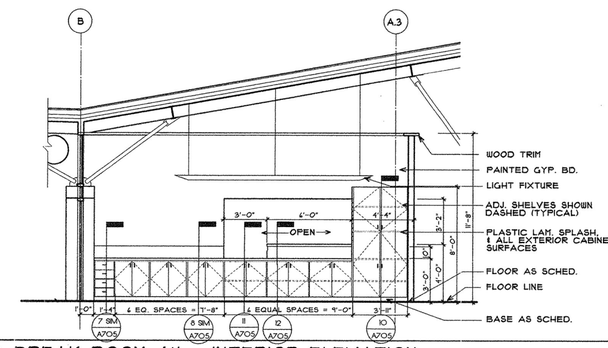

9 BREAK ROOM 461 - INTERIOR ELEVATION
SCALE: 1/4" = 1'-0"

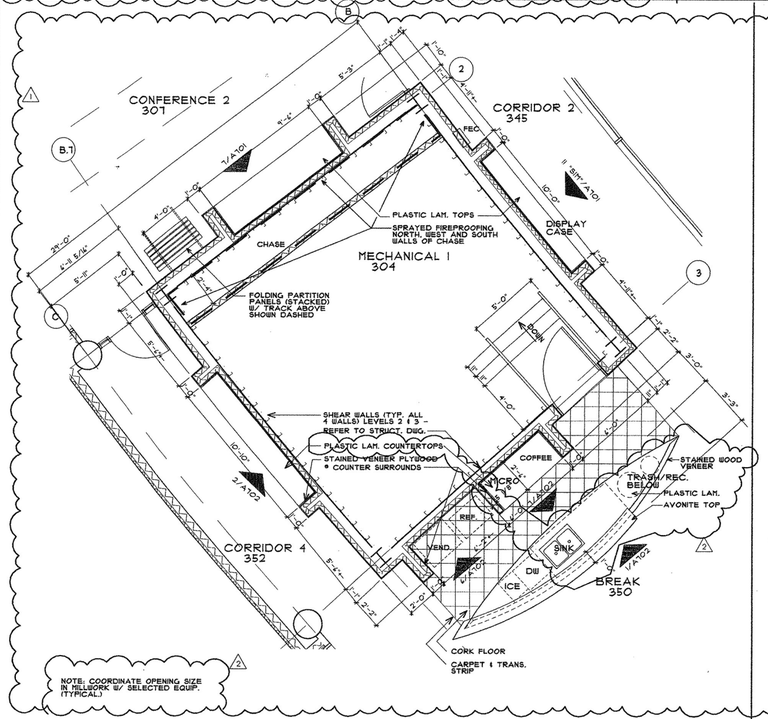

11 MECH. 1 / ROOMS 204 & 304, 404 "SIM." - PLAN
SCALE: 1/4" = 1'-0"

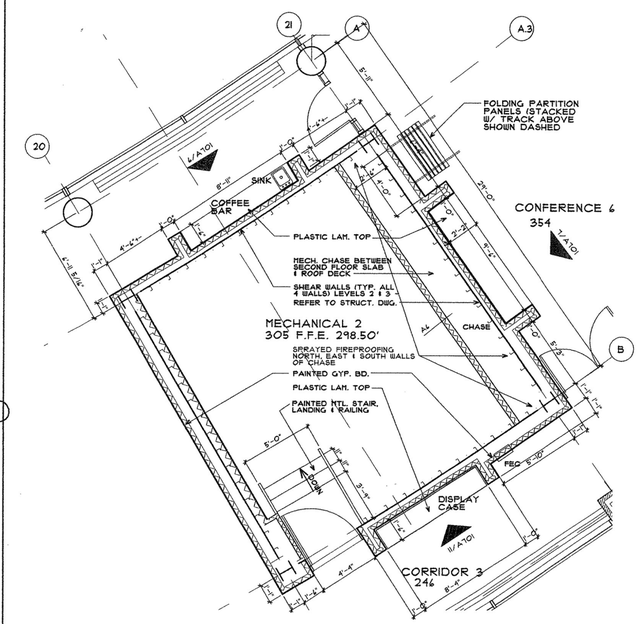

12 MECH. 2 / ROOMS 205 & 305, 405 "SIM." - PLAN
SCALE: 1/4" = 1'-0"

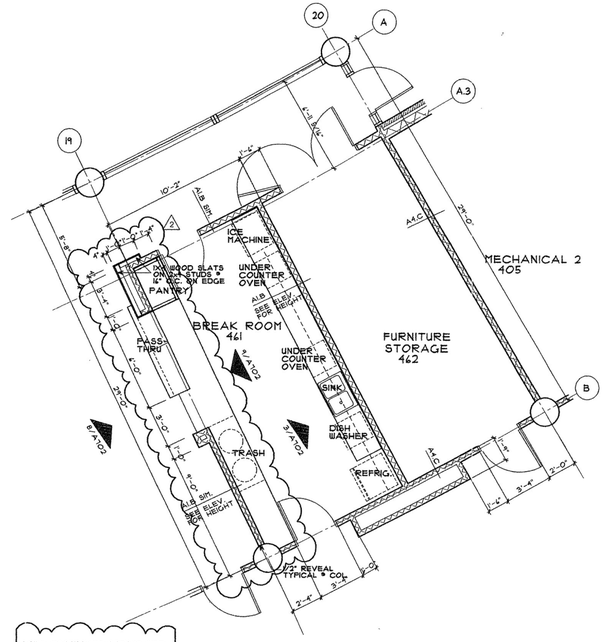

13 BREAK ROOM 461 - PLAN
SCALE: 1/4" = 1'-0"

POLK
STANLEY
YEARY
ARCHITECTS, LTD.

700 SOUTH SCHILLER
LITTLE ROCK, AR 72201
501 378-0878
FAX 372-7629

21 W. MOUNTAIN, SUITE 227
FAYETTEVILLE, AR 72701
479-444-0473

CONSULTANTS:

OWNER'S PROJECT ADVISOR:
MOSES TUCKER REAL ESTATE, INC.

CIVIL ENGINEER:
McCLELLAND ENGINEERS

LANDSCAPE ARCHITECT:
LARSON BURNS SMITH

STRUCTURAL ENGINEER:
CROMWELL ENGINEERS INC.

MECH., ELEC., PLUMB. ENGINEER:
CROMWELL ENGINEERS INC.

SUSTAINABLE CONSULTANT:
BNIM / ELEMENTS

GLOBAL VILLAGE CONSULTANT
CAMBRIDGE SEVEN ASSOCIATES

INTERIOR DESIGNER:
POLK STANLEY YEARY

GENERAL CONTRACTOR:
CDI

GENERAL NOTES:

1. WOOD REVEALS SHALL BE 1/4"x1/4" WITH EDGEBAND AND 1/4" WIDE x 1/2" SPACER. CORNERS SHALL BE 1/4"x1/4" QUIRK WITH EDGEBAND.

NOTES:

ISSUE DATE:
100% GMP
PACKAGE #6
FEBRUARY 2, 2004

REVISIONS:

#	DATE	DESCRIPTION
1	01JUL04	PACKAGE 1
2	30JUL04	A.S.I. II

HEIFER
INTERNATIONAL
CENTER
OFFICE BUILDING
LITTLE ROCK, ARKANSAS

PSY PROJECT NUMBER:
431C

CONTENTS:
INTERIOR ELEVATIONS

SHEET NUMBER:
A702

P:\0-DWG\V8\C\CA\Pltd\Drawings\Pc-CDs\Final\A102-Interior Elevations Monday, August 09, 2004 10:50 AM

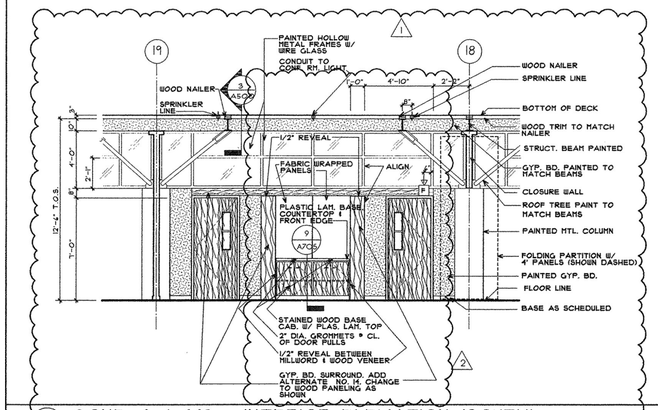

1 CONF. 4 / 449 - INTERIOR ELEVATION (SOUTH)
SCALE: 1/4" = 1'-0"

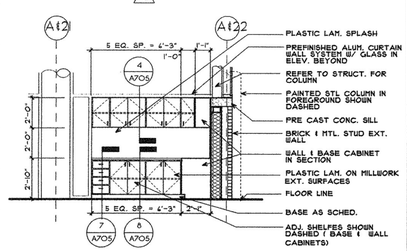

2 MAIL ROOM 154
SCALE: 1/4" = 1'-0"

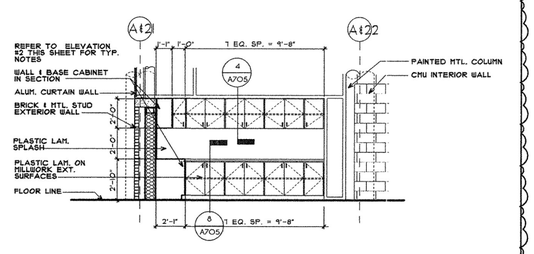

3 MAIL ROOM 154
SCALE: 1/4" = 1'-0"

4 INTERIOR ELEVATION
SCALE: 1/4" = 1'-0"

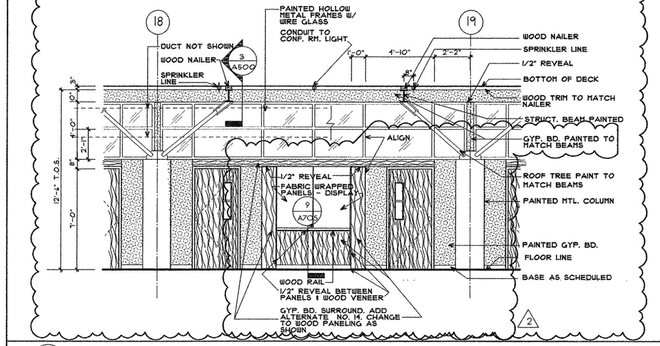

6 CORR. 3 / 446 - INT. ELEVATION (NORTH @ CONF. 4 / 449)
SCALE: 1/4" = 1'-0"

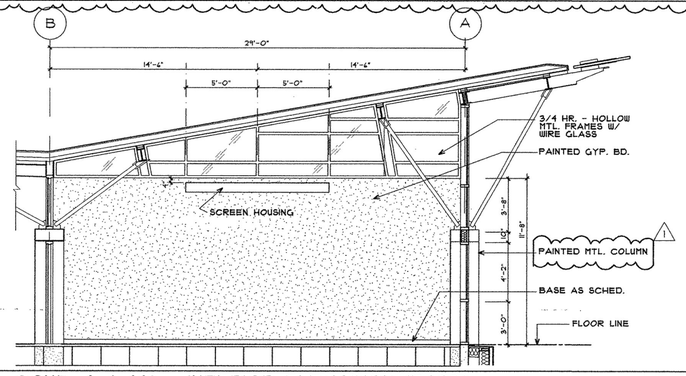

7 CONF. 4 / 449 - INTERIOR ELEVATION (EAST)
SCALE: 1/4" = 1'-0"

8 INTERIOR ELEVATION
SCALE: 1/4" = 1'-0"

POLK
STANLEY
YEARY
ARCHITECTS, LTD.

700 SOUTH SCHILLER
LITTLE ROCK, AR 72201
501 378-0878
FAX 372-7629

21 W. MOUNTAIN, SUITE 227
FAYETTEVILLE, AR 72701
479-444-0473

CONSULTANTS:

OWNER'S PROJECT ADVISOR:
MOSES TUCKER REAL ESTATE, INC.

CIVIL ENGINEER:
McCLELLAND ENGINEERS

LANDSCAPE ARCHITECT:
LARSON BURNS SMITH

STRUCTURAL ENGINEER:
CROMWELL ENGINEERS INC.

MECH., ELEC., PLUMB. ENGINEER:
CROMWELL ENGINEERS INC.

SUSTAINABLE CONSULTANT:
BNIM / ELEMENTS

GLOBAL VILLAGE CONSULTANT
CAMBRIDGE SEVEN ASSOCIATES

INTERIOR DESIGNER:
POLK STANLEY YEARY

GENERAL CONTRACTOR:
CDI

GENERAL NOTES:

1. WOOD REVEALS SHALL BE 1/4"x1/4" WITH EDGEBAND AND 1/4" WIDE x 1/2" SPACER. CORNERS SHALL BE 1/4"x1/4" QUIRK WITH EDGEBAND.

NOTES:

ISSUE DATE:
100% GMP
PACKAGE #6
FEBRUARY 2, 2004

REVISIONS:

#	DATE	DESCRIPTION
1	01 JUL 04	PACKAGE #1
2	30 JUL 04	A.S.I. 1

HEIFER INTERNATIONAL CENTER OFFICE BUILDING
LITTLE ROCK, ARKANSAS

PSY PROJECT NUMBER:
431C

CONTENTS:
INTERIOR ELEVATIONS

SHEET NUMBER:
A703

P:\JOBS\431C\CAD\Revit\Drawings\Arch\A103-Interior Elevations Monday, August 09, 2004 3:47 PM

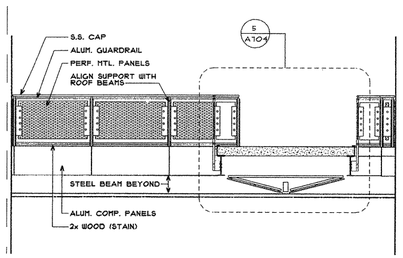

1 GUARDRAIL ELEVATION @ BRIDGE
SCALE: 1/4" = 1'-0"

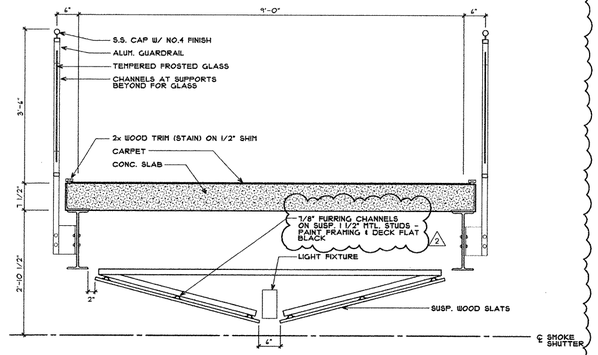

5 BRIDGE SECTION
SCALE: 3/4" = 1'-0"

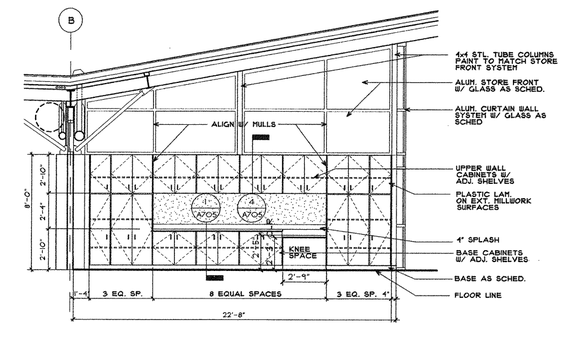

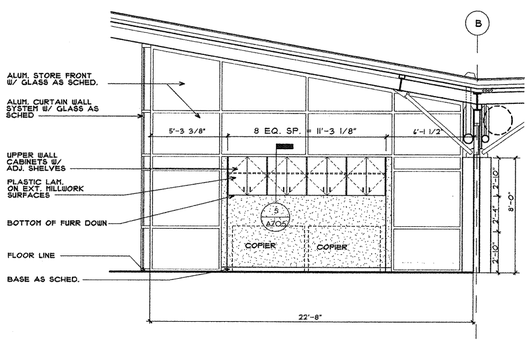

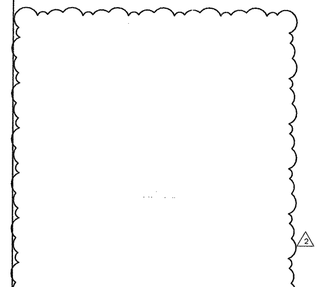

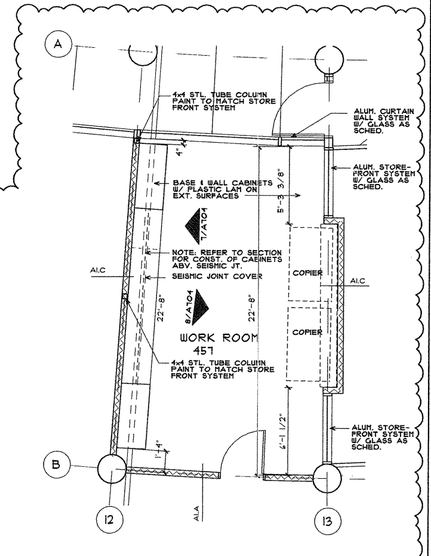

10 WORK ROOM 457- PLAN
SCALE: 1/4" = 1'-0"

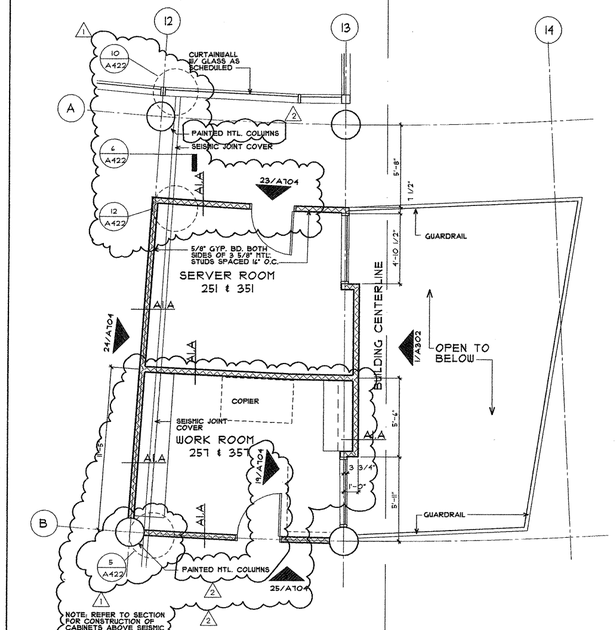

21 WORK RM. 257, 357 & SERVER RM. 251, 351 - PLAN
SCALE: 1/4" = 1'-0"

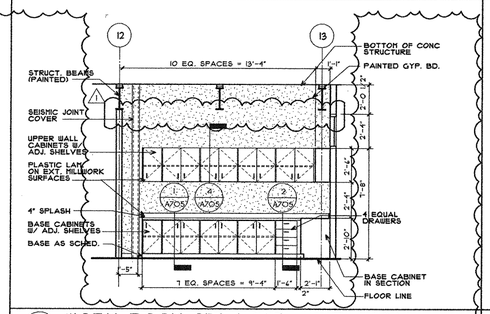

18 WORK ROOM 257 & 357 - INT. ELEV.
SCALE: 1/4" = 1'-0"

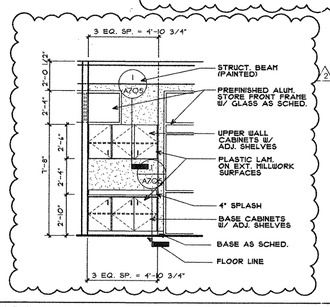

19 WORK ROOM 257 & 357 - INT. ELEV.
SCALE: 1/4" = 1'-0"

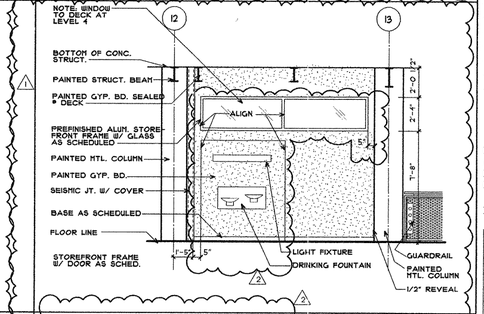

20 DRINKING FOUNTAIN
SCALE: 1/4" = 1'-0"

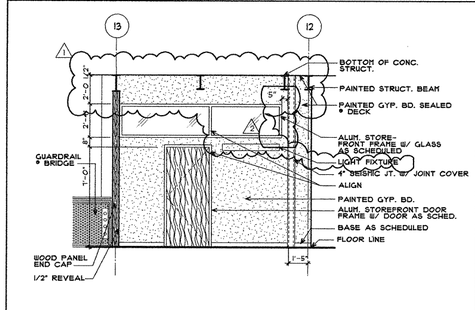

23 SERVER ROOM 251 & 351 - INT. ELEV.
SCALE: 1/4" = 1'-0"

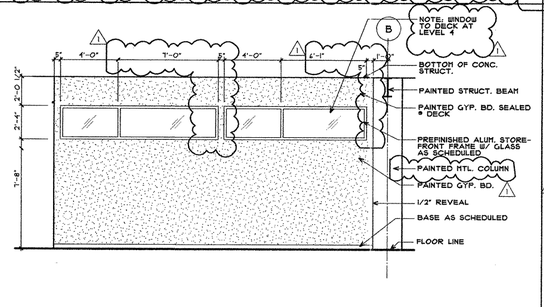

24 SERVER ROOM & WORK ROOM
SCALE: 1/4" = 1'-0"

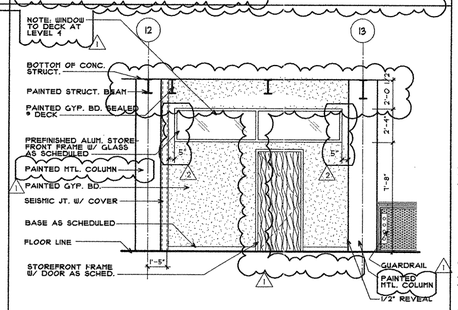

25 WORK ROOM 257 & 357
SCALE: 1/4" = 1'-0"

POLK
STANLEY
YEARY
ARCHITECTS, LTD.

700 SOUTH SCHILLER
LITTLE ROCK, AR 72201
501 378-0878
FAX 372-7629

21 W. MOUNTAIN, SUITE 227
FAYETTEVILLE, AR 72701
479-444-0473

CONSULTANTS:

OWNER'S PROJECT ADVISOR:
MOSES TUCKER REAL ESTATE, INC.

CIVIL ENGINEER:
McCLELLAND ENGINEERS

LANDSCAPE ARCHITECT:
LARSON BURNS SMITH

STRUCTURAL ENGINEER:
CROMWELL ENGINEERS INC.

MECH., ELEC., PLUMB. ENGINEER:
CROMWELL ENGINEERS INC.

SUSTAINABLE CONSULTANT:
BNIM / ELEMENTS

GLOBAL VILLAGE CONSULTANT
CAMBRIDGE SEVEN ASSOCIATES

INTERIOR DESIGNER:
POLK STANLEY YEARY

GENERAL CONTRACTOR:
CDI

GENERAL NOTES:

NOTES:

ISSUE DATE:
100% GMP
PACKAGE #6
FEBRUARY 2, 2004

REVISIONS:

#	DATE	DESCRIPTION
1	02JUL04	PACKAGE 07
2	30JUL04	A.S.I. 11

HEIFER INTERNATIONAL CENTER OFFICE BUILDING

LITTLE ROCK, ARKANSAS

PSY PROJECT NUMBER:
431C

CONTENTS:
INTERIOR ELEVATIONS

SHEET NUMBER:
A704

P:\JD-DOC\431C\CA\Print\Drawings\[CDI-FullSet-A104-Layout Elevations
Monday, August 09, 2004 3:26 PM

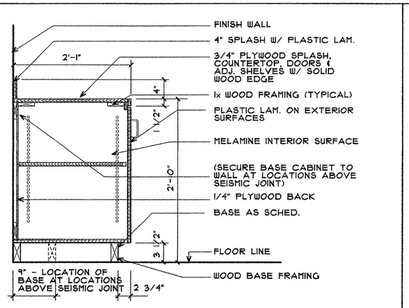

1 BASE CABINET SECTION

SCALE: 1" = 1' - 0"

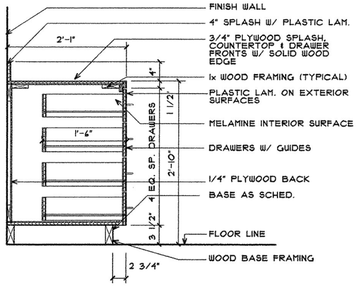

2 BASE CABINET SECTION

SCALE: 1" = 1' - 0"

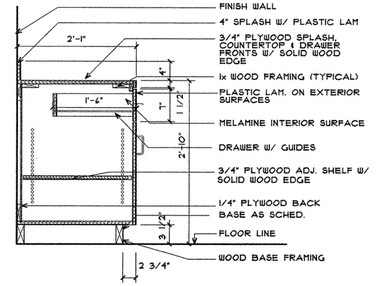

3 BASE CABINET SECTION

SCALE: 1" = 1' - 0"

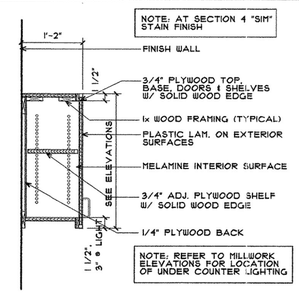

4 WALL CABINET SECTION

SCALE: 1" = 1' - 0"

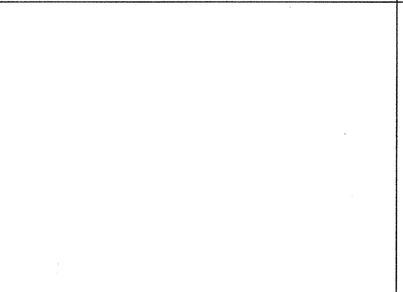

5 (NOT USED)

SCALE: 1" = 1' - 0"

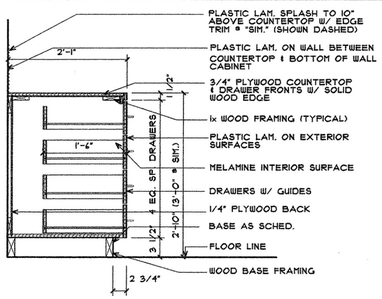

6 BASE CABINET SECTION

SCALE: 1" = 1' - 0"

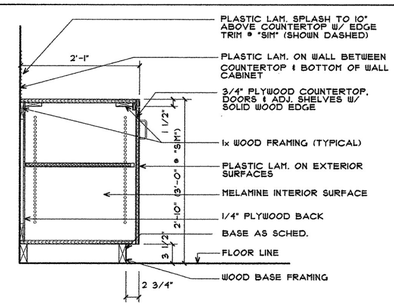

7 BASE CABINET SECTION

SCALE: 1" = 1' - 0"

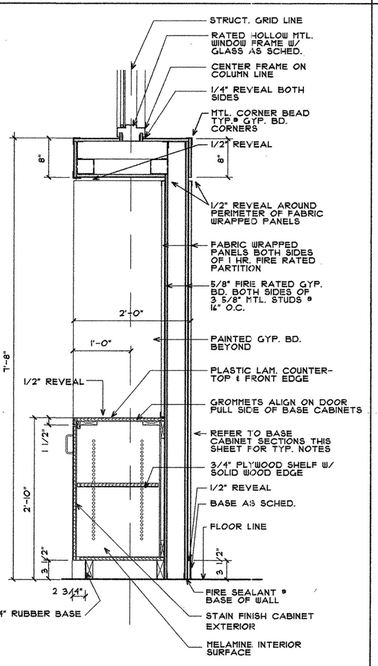

9 CORR. DISPLAY - SECTION

SCALE: 1" = 1' - 0"

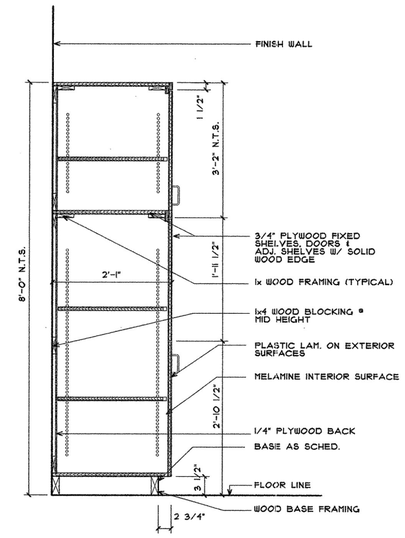

10 STORAGE CABINET - SECTION

SCALE: 1" = 1' - 0"

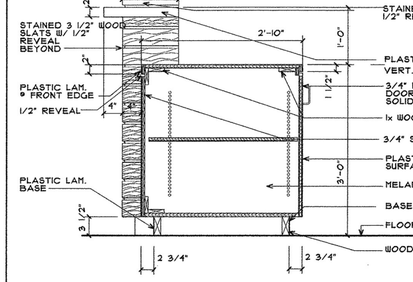

11 BASE CABINET SECTION

SCALE: 1" = 1' - 0"

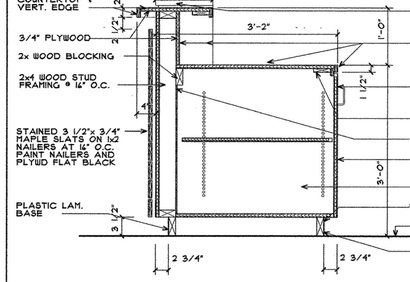

12 BASE CABINET SECTION

SCALE: 1" = 1' - 0"

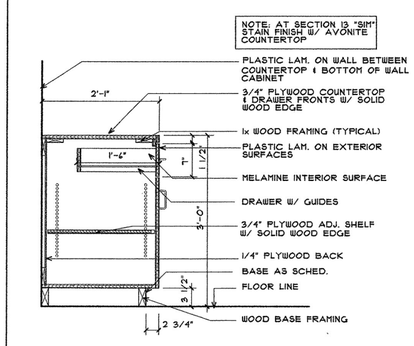

13 BASE CABINET SECTION

SCALE: 1" = 1' - 0"

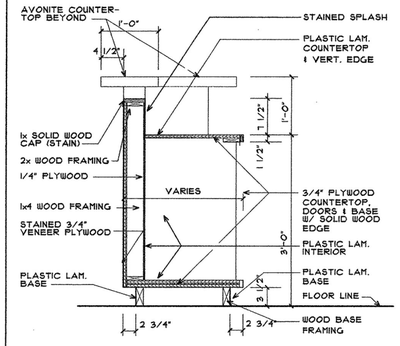

14 BASE CABINET SECTION

SCALE: 1" = 1' - 0"

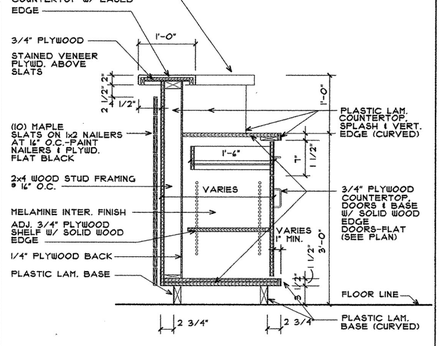

15 BASE CABINET SECTION

SCALE: 1" = 1' - 0"

16 (NOT USED)

SCALE: 1" = 1' - 0"

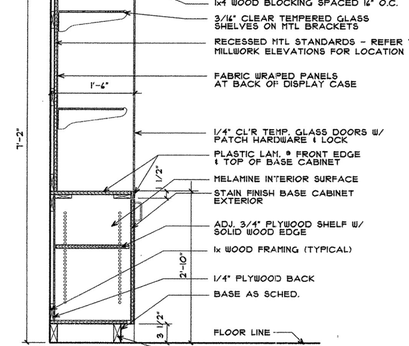

17 DISPLAY CASE - SECTION

SCALE: 1" = 1' - 0"

POLK STANLEY YEARY
ARCHITECTS, LTD.

700 SOUTH SCHILLER
LITTLE ROCK, AR 72201
501 378-0878
FAX 372-7629

21 W. MOUNTAIN, SUITE 227
FAYETTEVILLE, AR 72701
479-444-0473

CONSULTANTS:

OWNER'S PROJECT ADVISOR:
MOSES TUCKER REAL ESTATE, INC.

CIVIL ENGINEER:
McCLELLAND ENGINEERS

LANDSCAPE ARCHITECT:
LARSON BURNS SMITH

STRUCTURAL ENGINEER:
CROMWELL ENGINEERS INC.

MECH., ELEC., PLUMB. ENGINEER:
CROMWELL ENGINEERS INC.

SUSTAINABLE CONSULTANT:
BNIM / ELEMENTS

GLOBAL VILLAGE CONSULTANT
CAMBRIDGE SEVEN ASSOCIATES

INTERIOR DESIGNER:
POLK STANLEY YEARY

GENERAL CONTRACTOR:
CDI

GENERAL NOTES:

NOTES:

ISSUE DATE:
100% GMP
PACKAGE #6
FEBRUARY 2, 2004

REVISIONS:

#	DATE	DESCRIPTION
1	30JUL04	ASI 11

HEIFER INTERNATIONAL CENTER OFFICE BUILDING

LITTLE ROCK, ARKANSAS

PSY PROJECT NUMBER:
431C

CONTENTS:

MILLWORK SECTIONS

SHEET NUMBER:

A705 1

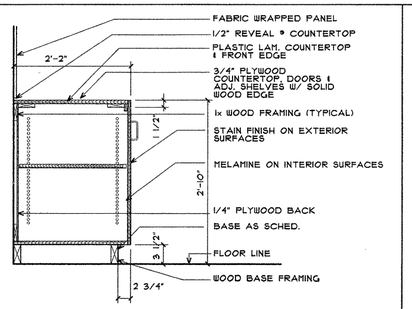

1 BASE CABINET SECTION

SCALE: 1" = 1' - 0"

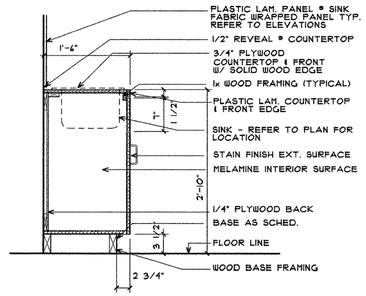

2 BASE CABINET SECTION

SCALE: 1" = 1' - 0"

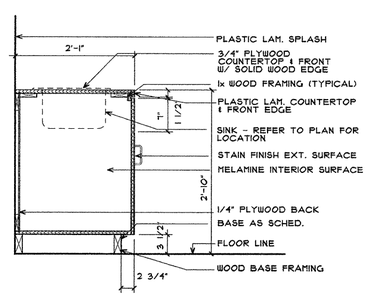

3 BASE CABINET SECTION

SCALE: 1" = 1' - 0"

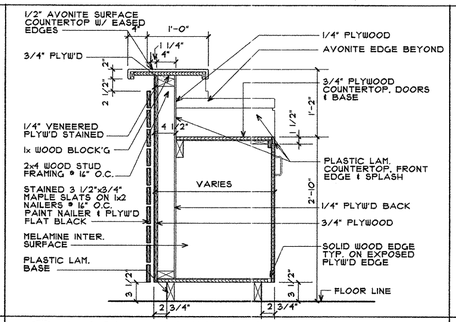

4 BASE CABINET SECTION

SCALE: 1" = 1' - 0"

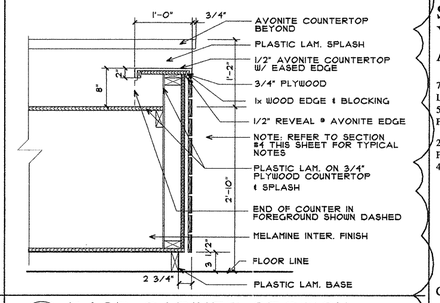

5 BASE CABINET SECTION

SCALE: 1" = 1' - 0"

1

POLK STANLEY YEARY ARCHITECTS, LTD.

700 SOUTH SCHILLER
LITTLE ROCK, AR 72201
501 378-0878
FAX 372-7629

21 W. MOUNTAIN, SUITE 227
FAYETTEVILLE, AR 72701
479-444-0473

CONSULTANTS:

OWNER'S PROJECT ADVISOR:
MOSES TUCKER REAL ESTATE, INC.

CIVIL ENGINEER:
McCLELLAND ENGINEERS

LANDSCAPE ARCHITECT:
LARSON BURNS SMITH

STRUCTURAL ENGINEER:
CROMWELL ENGINEERS INC.

MECH., ELEC., PLUMB. ENGINEER:
CROMWELL ENGINEERS INC.

SUSTAINABLE CONSULTANT:
BNIM / ELEMENTS

GLOBAL VILLAGE CONSULTANT
CAMBRIDGE SEVEN ASSOCIATES

INTERIOR DESIGNER:
POLK STANLEY YEARY

GENERAL CONTRACTOR:
CDI

GENERAL NOTES:

NOTES:

ISSUE DATE:
100% GMP
PACKAGE #6
FEBRUARY 2, 2004

REVISIONS:

#	DATE	DESCRIPTION
1	30JUL04	ASI 11

HEIFER INTERNATIONAL CENTER OFFICE BUILDING

LITTLE ROCK, ARKANSAS

PSY PROJECT NUMBER:
431C

CONTENTS:

MILLWORK SECTIONS

SHEET NUMBER:

A706