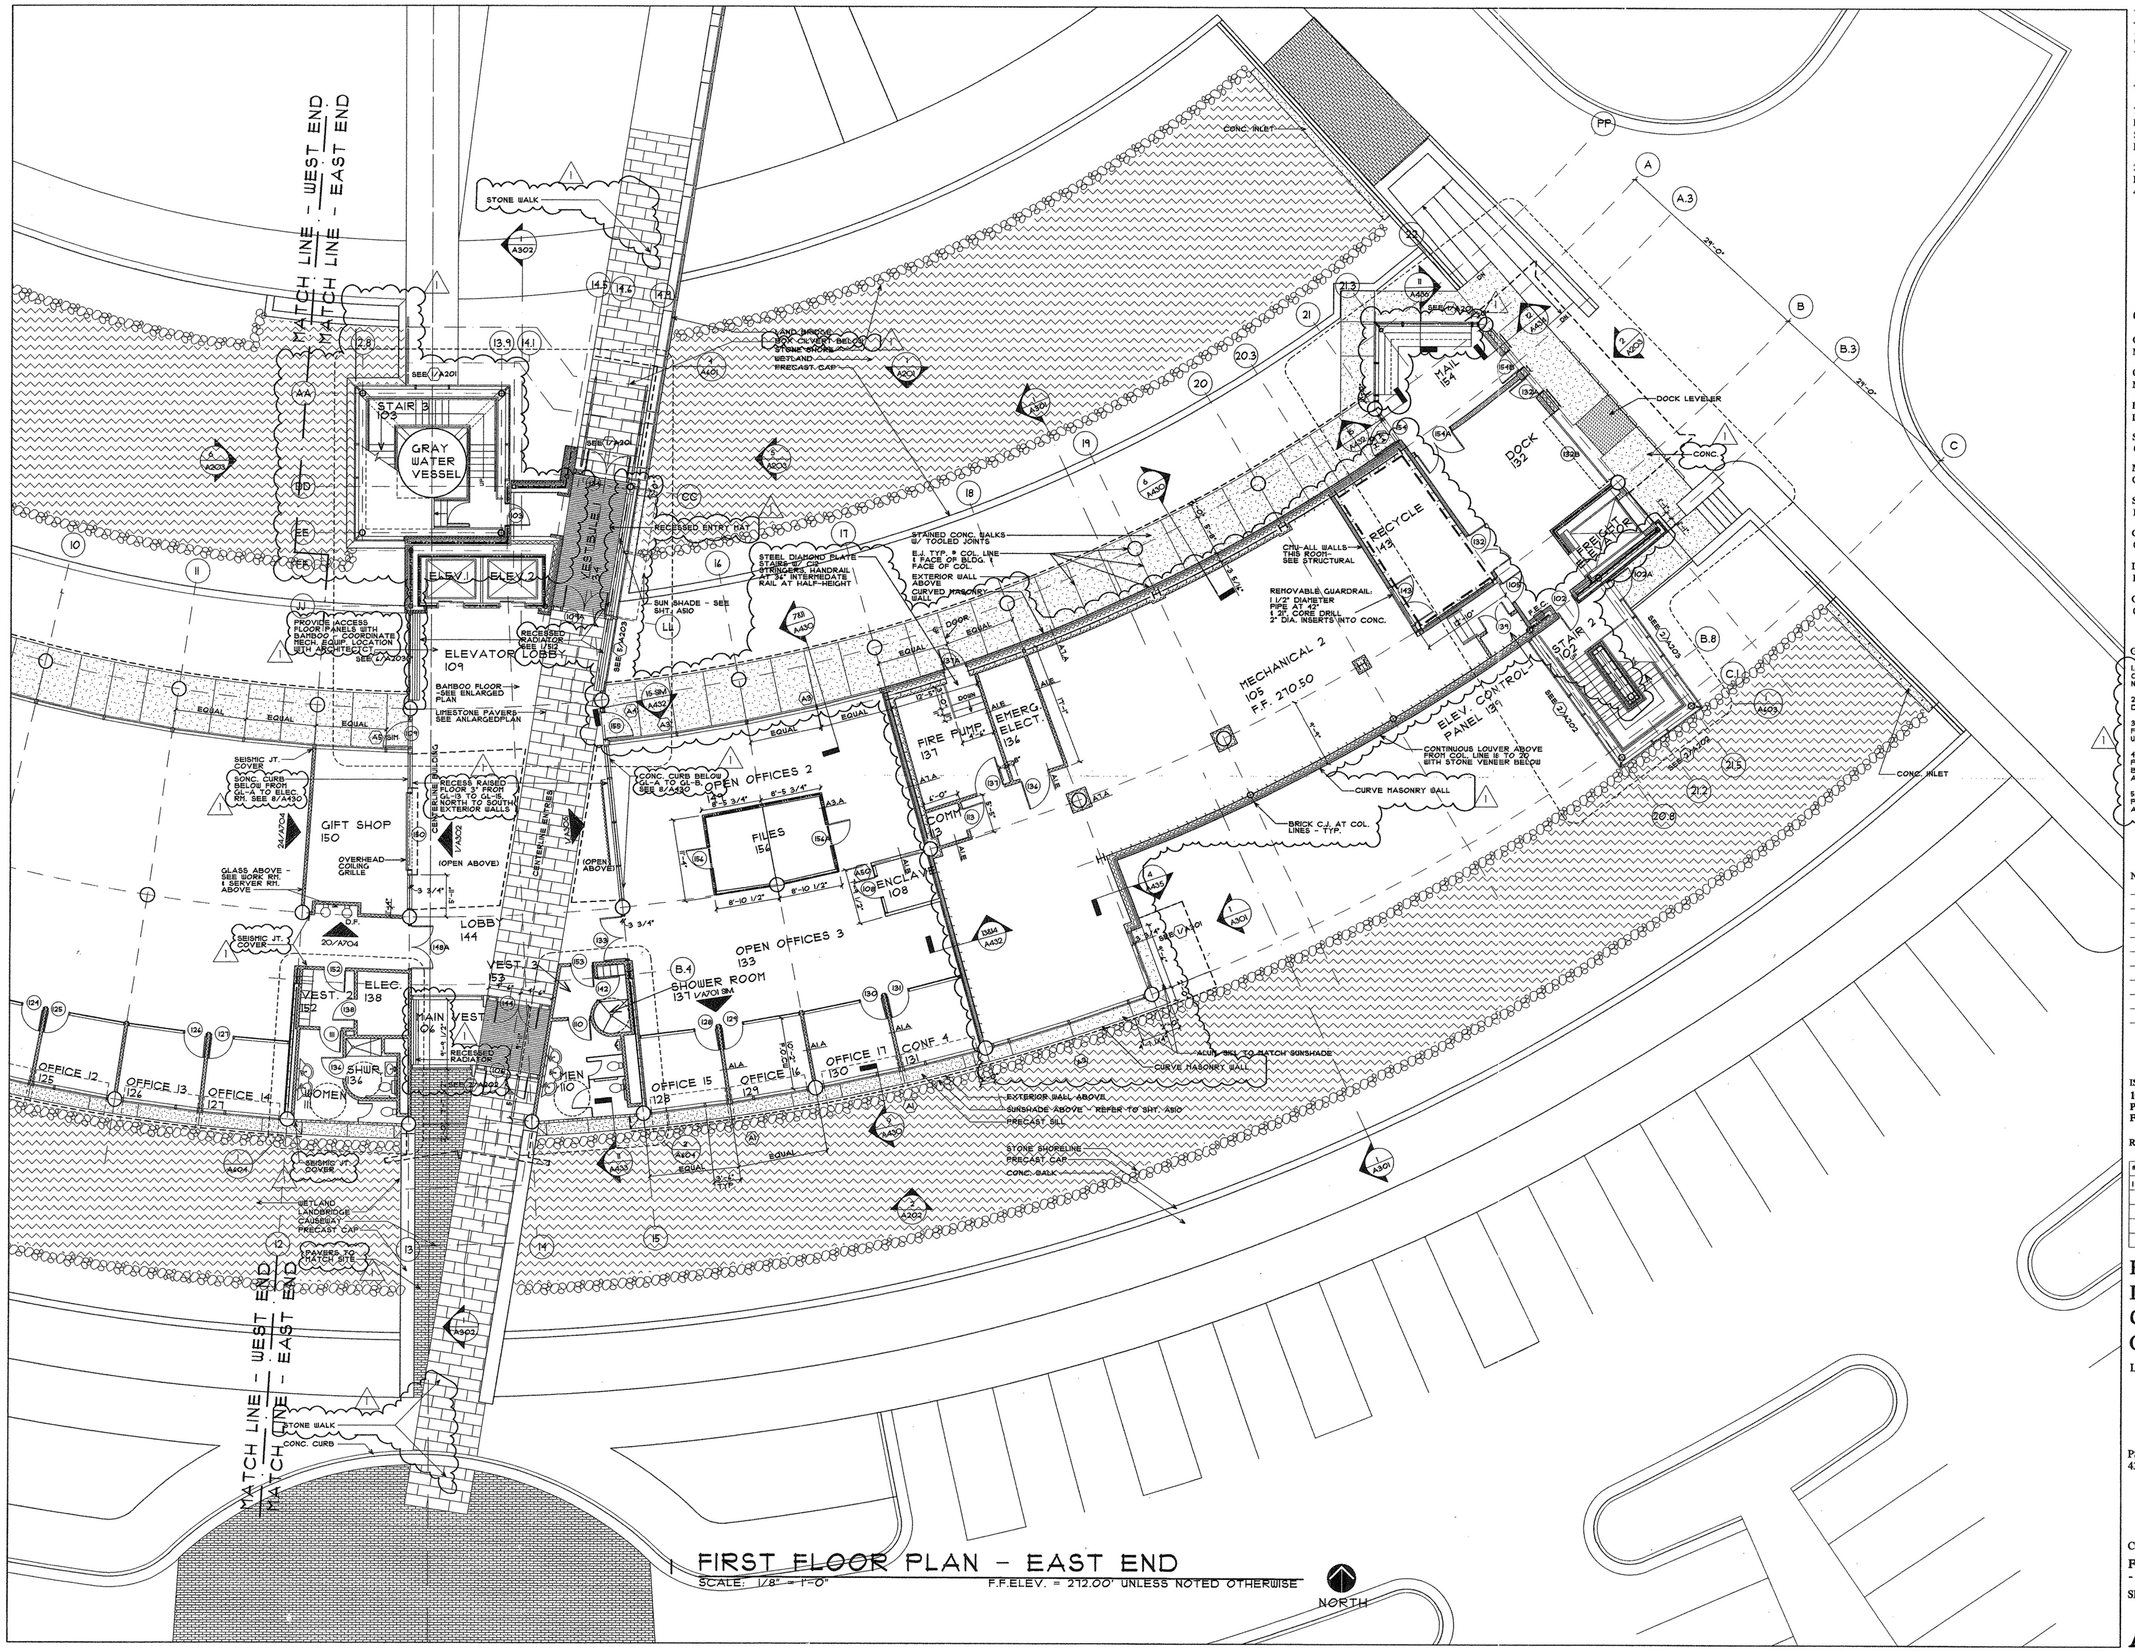

FIRST FLOOR PLAN - EAST END

SCALE: 1/8" = 1'-0"

F.F.ELEV. = 212.00' UNLESS NOTED OTHERWISE

NORTH

POLK
STANLEY
YEARY
ARCHITECTS, LTD.

700 SOUTH SCHILLER
LITTLE ROCK, AR 72201
501 378-0878
FAX 372-7629

21 W. MOUNTAIN, SUITE 227
FAYETTEVILLE, AR 72701
479-444-0473

CONSULTANTS:

OWNER'S PROJECT ADVISOR:
MOSES TUCKER REAL ESTATE, INC.

CIVIL ENGINEER:
McCLELLAND ENGINEERS

LANDSCAPE ARCHITECT:
LARSON BURNS SMITH

STRUCTURAL ENGINEER:
CROMWELL ENGINEERS INC.

MECH., ELEC., PLUMB. ENGINEER:
CROMWELL ENGINEERS INC.

SUSTAINABLE CONSULTANT:
BNIM / ELEMENTS

GLOBAL VILLAGE CONSULTANT
CAMBRIDGE SEVEN ASSOCIATES

INTERIOR DESIGNER:
POLK STANLEY YEARY

GENERAL CONTRACTOR:
CDI

GENERAL NOTES:

1. LOCATE WALLS & PARTITIONS ON CENTERLINE OF COLUMNS UNLESS NOTED OTHERWISE.
2. SEE SHEET G003 FOR COLUMN DIMENSION PLAN.
3. ALL WALLS ARE SEGMENTED TO FOLLOW CURVE OF BUILDING UNLESS NOTED OTHERWISE.
4. PROVIDE 1 HR. SPRAYED FIRE PROOFING FOR COLUMNS B-16 THRU B-20, B-11 (EAST SIDE), AND SHEAR WALL A.3/11 TO A3/20. INCLUDING COLUMNS.
5. PROVIDE 1 HR. INTUMESCENT FIRE PROOFING FOR COLUMNS A-16 THRU A-20, B-16 THRU B-11 (WEST SIDE).

NOTES:

ISSUE DATE:
100% GMP
PACKAGE #6
FEBRUARY 2, 2004

REVISIONS:

#	DATE	DESCRIPTION
1	01JUL04	PACKAGE #1

HEIFER
INTERNATIONAL
CENTER
OFFICE BUILDING

LITTLE ROCK, ARKANSAS

PSY PROJECT NUMBER:
431C

RANDAL CURZON POSTER
CORPORATE
ARCHITECT
C-138
ARKANSAS

CONTENTS:
FIRST FLOOR PLAN
- EAST END

SHEET NUMBER:

A101a

P:\D-DISC\13\C\CAD*ed\Drawings*\CD's\First\A101a-FirstFloorPlan-East End Thursday, July 01, 2004 4:38 PM