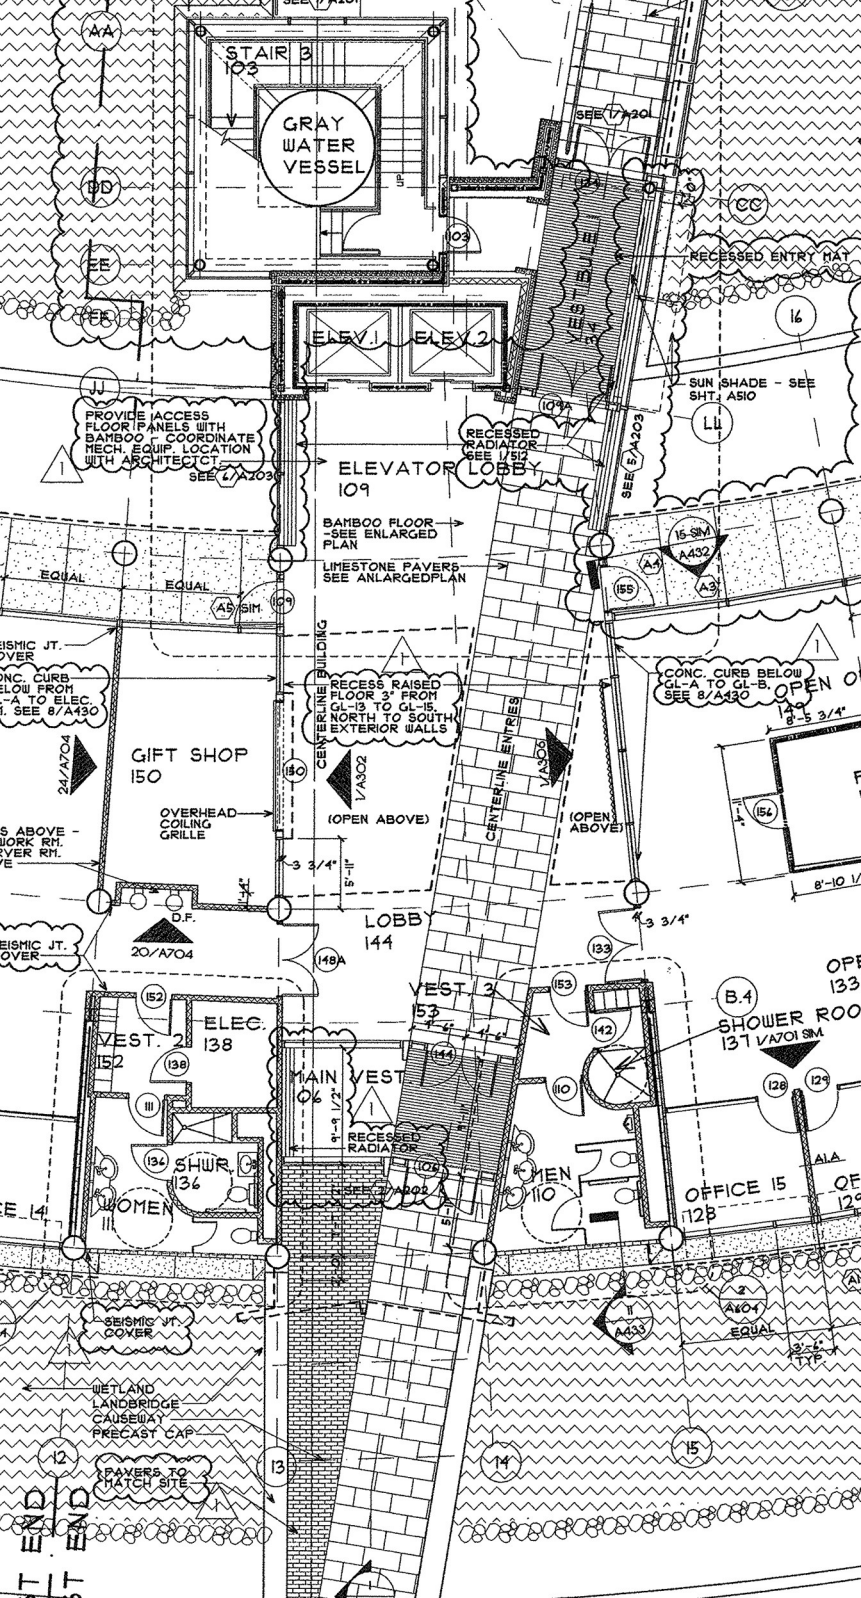
STAIR 3
103
GRAY WATER VESSEL
SEE 1/A201
RECESSED ENTRY MAT
ELEV. 1
ELEV. 2
SUN SHADE - SEE SHT. A510
PROVIDE ACCESS FLOOR PANELS WITH BAMBOO - COORDINATE MECH. EQUIP. LOCATION WITH ARCHITECT.
SEE 6/A203
RECESSED RADIATOR SEE 1/512
ELEVATOR LOBBY
109
SEE 5/A203
BAMBOO FLOOR -SEE ENLARGED PLAN
LIMESTONE PAVERS SEE ANLARGEDPLAN
EQUAL
EQUAL
15-SIM
A432
A5/SIM
CONC. CURB BELOW GL-A TO GL-B. SEE 8/A430
CONC. CURB BELOW FROM GL-A TO ELEC. SEE 8/A430
CENTERLINE BUILDING
RECESS RAISED FLOOR 3" FROM GL-13 TO GL-15. NORTH TO SOUTH EXTERIOR WALLS
CENTERLINE ENTRIES
GIFT SHOP
150
24/A704
1/A302
(OPEN ABOVE)
1/A300
(OPEN ABOVE)
OVERHEAD COILING GRILLE
D.F.
20/A704
LOBBY
144
VEST. 3
153
VEST. 2
152
ELEC.
138
MAIN VEST
106
RECESSED RADIATOR
SEE 2/A202
SHOWER ROO
137 1/A701 SIM
B.4
SHWR.
136
WOMEN
111
MEN
110
OFFICE 15
128
SEISMIC JT. COVER
WETLAND LANDBRIDGE CAUSEWAY PRECAST CAP
PAVERS TO MATCH SITE
11
A433
2
A404
EQUAL
12'-6" TYP.