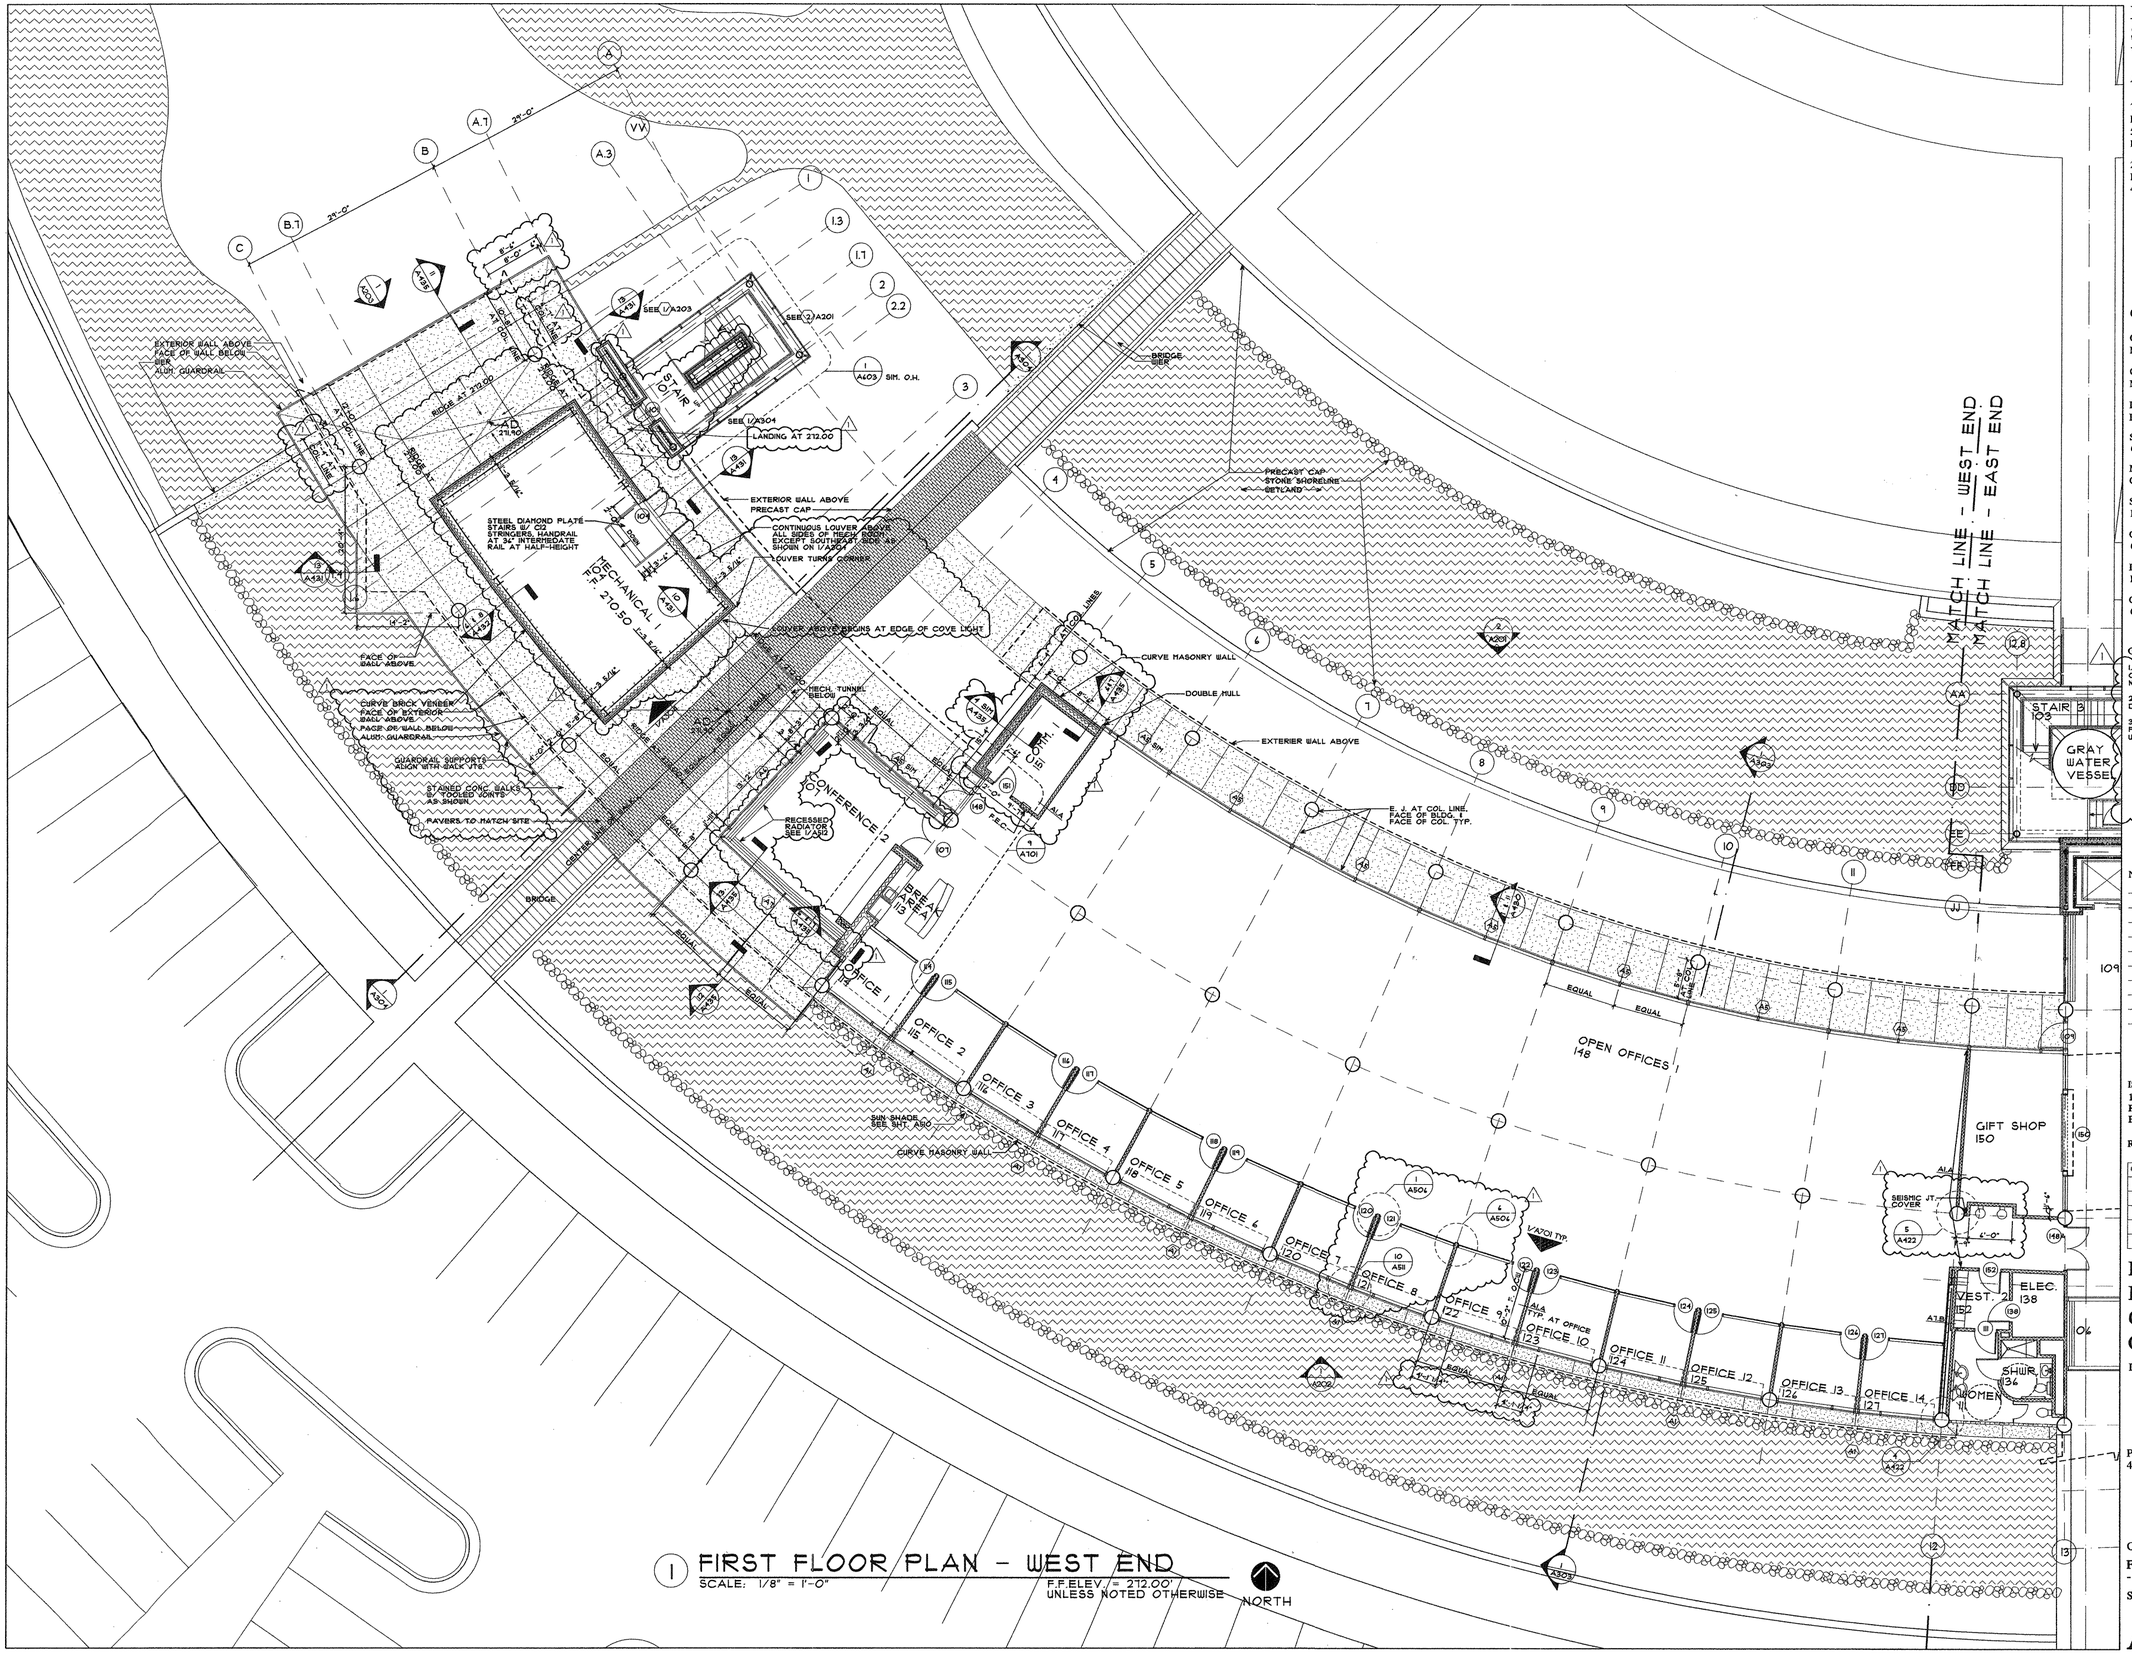

1 FIRST FLOOR PLAN - WEST END

SCALE: 1/8" = 1'-0"

F.F.ELEV. = 212.00' UNLESS NOTED OTHERWISE

NORTH

POLK STANLEY YEARY ARCHITECTS, LTD.

700 SOUTH SCHILLER
LITTLE ROCK, AR 72201
501 378-0878
FAX 372-7629

21 W. MOUNTAIN, SUITE 227
FAYETTEVILLE, AR 72701
479-444-0473

CONSULTANTS:

OWNER'S PROJECT ADVISOR:
MOSES TUCKER REAL ESTATE, INC.

CIVIL ENGINEER:
McCLELLAND ENGINEERS

LANDSCAPE ARCHITECT:
LARSON BURNS SMITH

STRUCTURAL ENGINEER:
CROMWELL ENGINEERS INC.

MECH., ELEC., PLUMB. ENGINEER:
CROMWELL ENGINEERS INC.

SUSTAINABLE CONSULTANT:
BNIM / ELEMENTS

GLOBAL VILLAGE CONSULTANT
CAMBRIDGE SEVEN ASSOCIATES

INTERIOR DESIGNER:
POLK STANLEY YEARY

GENERAL CONTRACTOR:
CDI

GENERAL NOTES:

1. LOCATE WALLS & PARTITIONS ON CENTERLINE OF COLUMNS UNLESS NOTED OTHERWISE.
2. SEE SHEET G003 FOR COLUMN DIMENSION PLAN.
3. ALL WALLS ARE SEGMENTED TO FOLLOW CURVE OF BUILDING UNLESS NOTED OTHERWISE.

NOTES:

ISSUE DATE:
100% GMP
PACKAGE #6
FEBRUARY 2, 2004

REVISIONS:

#	DATE	DESCRIPTION
1	01JUL04	PACKAGE #7

HEIFER INTERNATIONAL CENTER OFFICE BUILDING

LITTLE ROCK, ARKANSAS

PSY PROJECT NUMBER:
431C

POLK STANLEY WILCOX PORTER CORPORATION ARCHITECTS
C-136
ARKANSAS

CONTENTS:

FIRST FLOOR PLAN - WEST END

SHEET NUMBER:

A101b