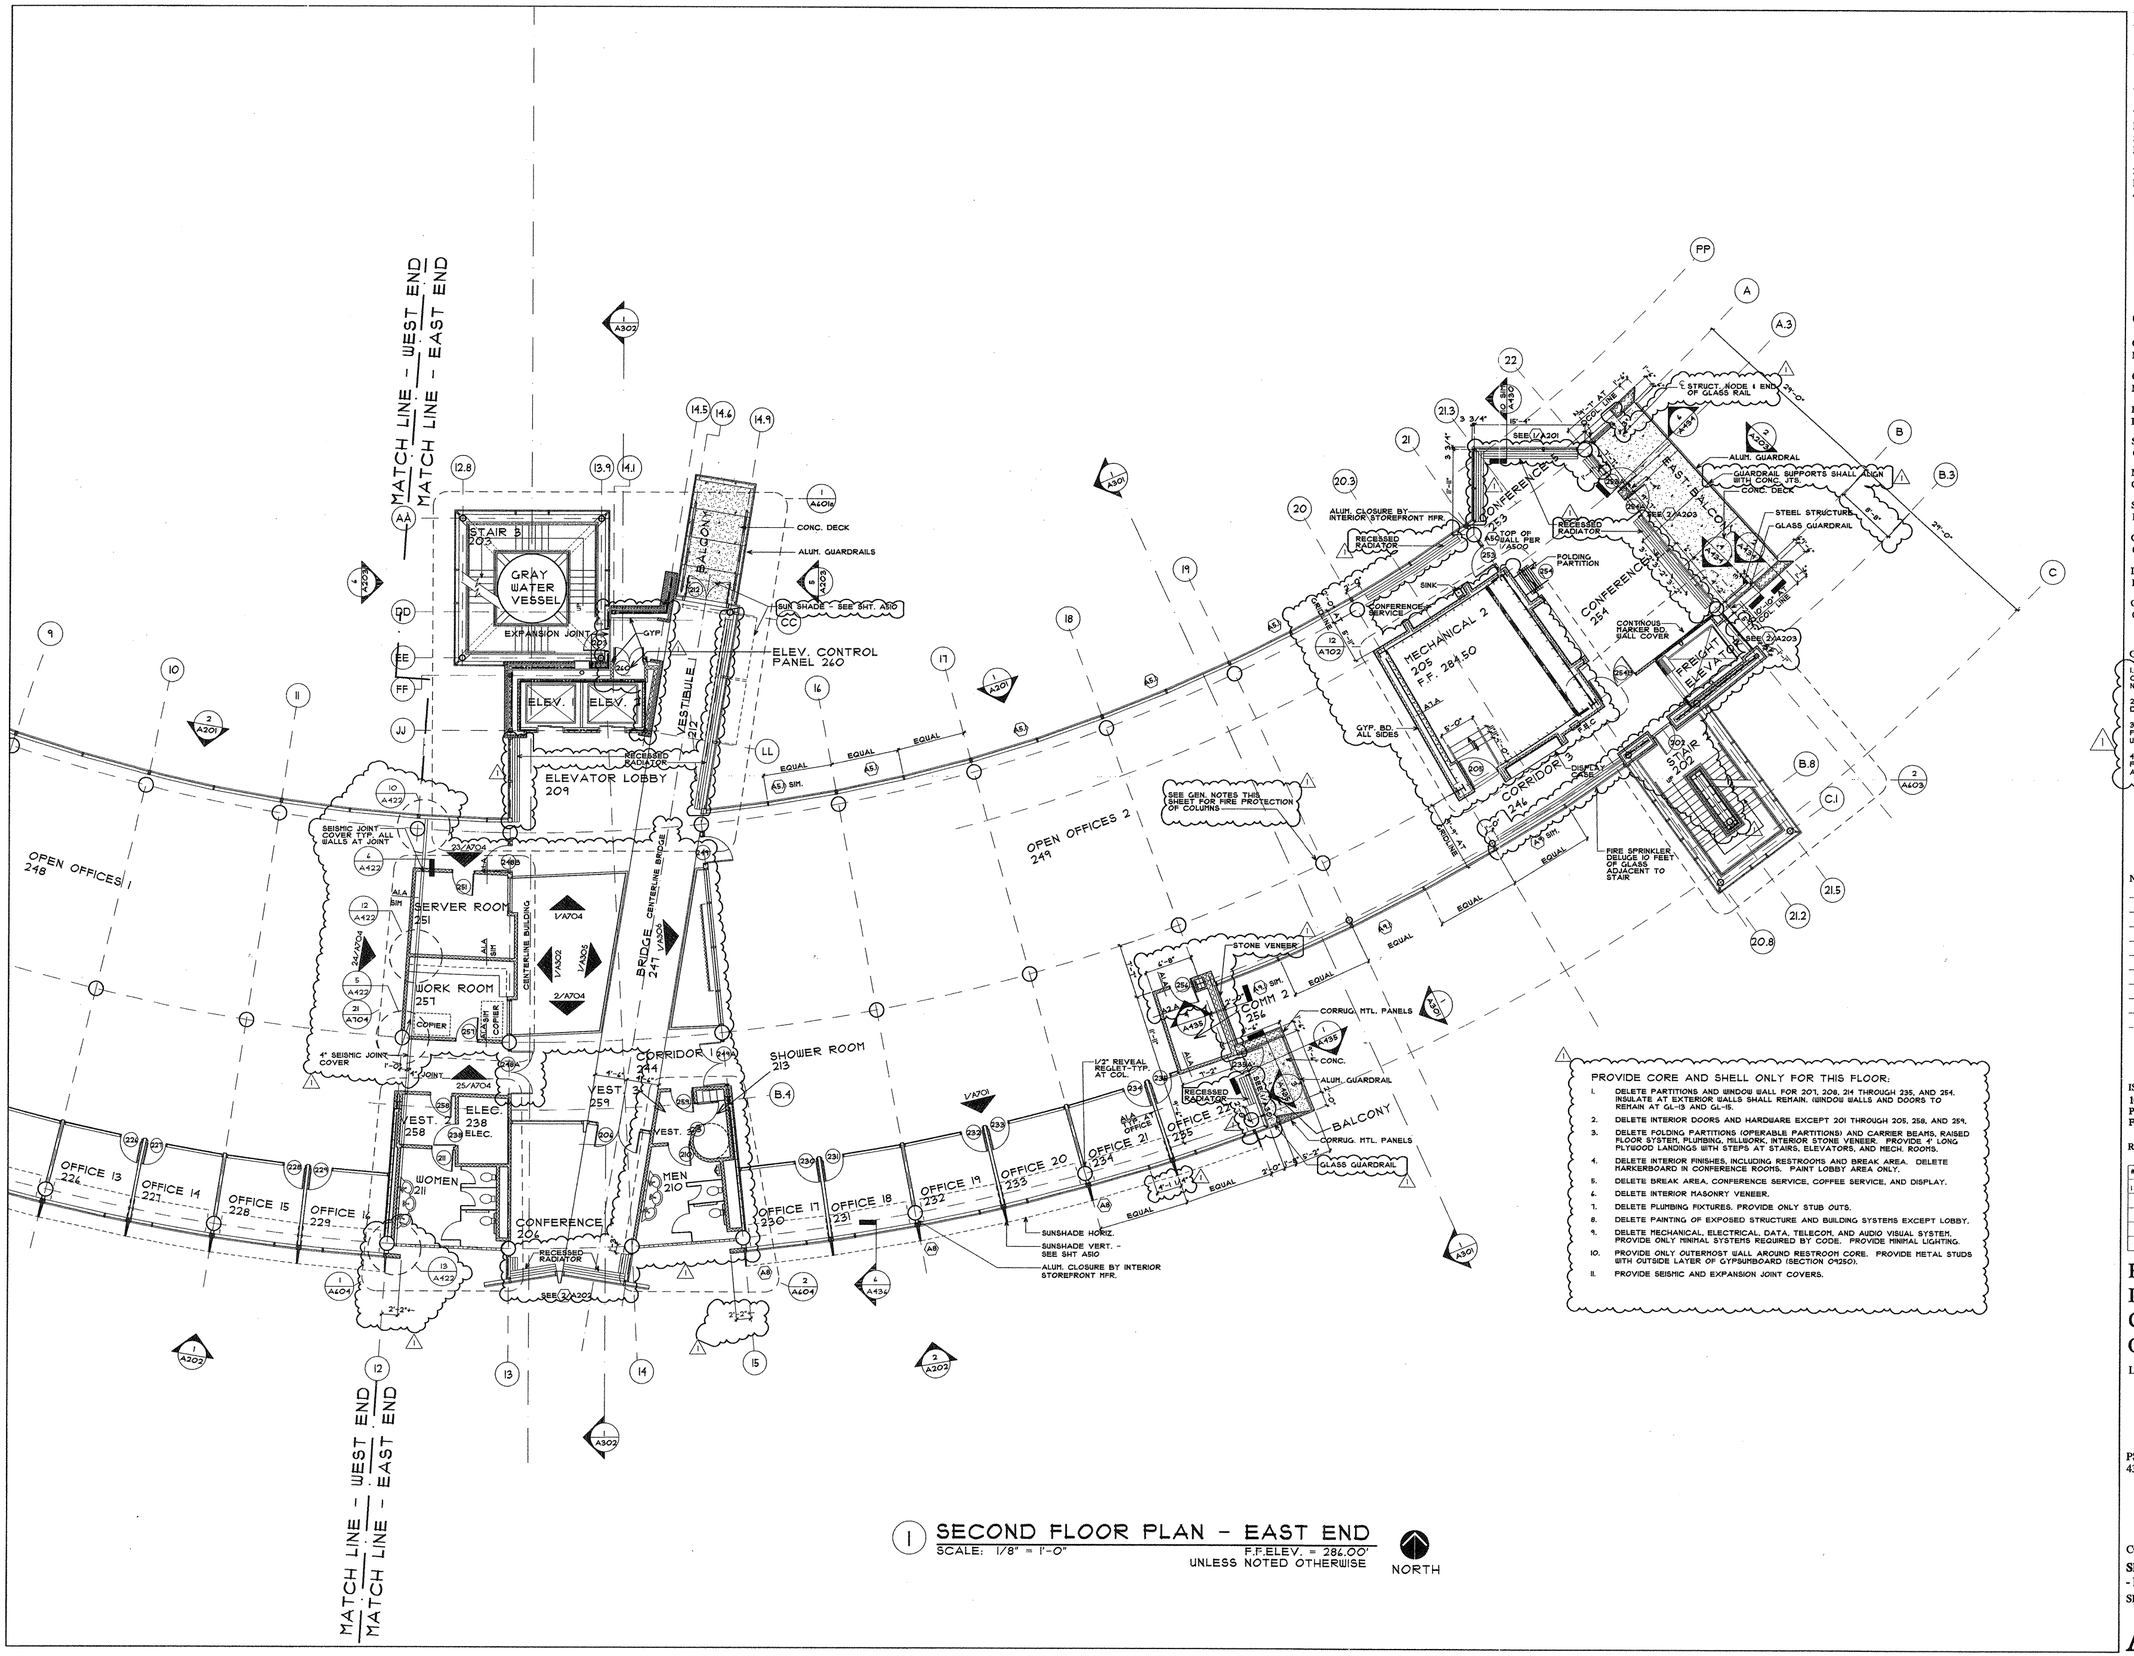

PROVIDE CORE AND SHELL ONLY FOR THIS FLOOR:

1. DELETE PARTITIONS AND WINDOW WALL FOR 207, 208, 214 THROUGH 235, AND 254. INSULATE AT EXTERIOR WALLS SHALL REMAIN. WINDOW WALLS AND DOORS TO REMAIN AT GL-13 AND GL-15.
2. DELETE INTERIOR DOORS AND HARDWARE EXCEPT 201 THROUGH 205, 256, AND 259.
3. DELETE FOLDING PARTITIONS (OPERABLE PARTITIONS) AND CARRIER BEARS. RAISED FLOOR SYSTEM, PLUMBING, MILLWORK, INTERIOR STONE VENEER. PROVIDE 4" LONG PLYWOOD LANDINGS WITH STEPS AT STAIRS, ELEVATORS, AND MECH. ROOMS.
4. DELETE INTERIOR FINISHES, INCLUDING RESTROOMS AND BREAK AREA. DELETE MARKERBOARD IN CONFERENCE ROOMS. PAINT LOBBY AREA ONLY.
5. DELETE BREAK AREA, CONFERENCE SERVICE, COFFEE SERVICE, AND DISPLAY.
6. DELETE INTERIOR MASONRY VENEER.
7. DELETE PLUMBING FIXTURES. PROVIDE ONLY STUB OUTS.
8. DELETE PAINTING OF EXPOSED STRUCTURE AND BUILDING SYSTEMS EXCEPT LOBBY.
9. DELETE MECHANICAL, ELECTRICAL, DATA, TELECOM, AND AUDIO VISUAL SYSTEM. PROVIDE ONLY MINIMAL SYSTEMS REQUIRED BY CODE. PROVIDE MINIMAL LIGHTING.
10. PROVIDE ONLY OUTERMOST WALL AROUND RESTROOM CORE. PROVIDE METAL STUDS WITH OUTSIDE LAYER OF GYPSUMBOARD (SECTION 09250).
11. PROVIDE SEISMIC AND EXPANSION JOINT COVERS.

1 SECOND FLOOR PLAN - EAST END

SCALE: 1/8" = 1'-0" F.F.ELEV. = 284.00' UNLESS NOTED OTHERWISE

NORTH

POLK
STANLEY
YEARY
ARCHITECTS, LTD.

700 SOUTH SCHILLER
LITTLE ROCK, AR 72201
501 378-0878
FAX 372-7529

21 W. MOUNTAIN, SUITE 227
FAYETTEVILLE, AR 72701
479-444-0473

CONSULTANTS:

OWNER'S PROJECT ADVISOR:
MOSES TUCKER REAL ESTATE, INC.

CIVIL ENGINEER:
McCLELLAND ENGINEERS

LANDSCAPE ARCHITECT:
LARSON BURNS SMITH

STRUCTURAL ENGINEER:
CROMWELL ENGINEERS INC.

MECH., ELEC., PLUMB. ENGINEER:
CROMWELL ENGINEERS INC.

SUSTAINABLE CONSULTANT:
BNIM / ELEMENTS

GLOBAL VILLAGE CONSULTANT
CAMBRIDGE SEVEN ASSOCIATES

INTERIOR DESIGNER:
POLK STANLEY YEARY

GENERAL CONTRACTOR:
CDI

GENERAL NOTES:

1. LOCATE WALLS & PARTITIONS ON CENTERLINE OF COLUMNS UNLESS NOTED OTHERWISE.
2. SEE SHEET G003 FOR COLUMN DIMENSION PLAN.
3. ALL WALLS ARE SEGMENTED TO FOLLOW CURVE OF BUILDING UNLESS NOTED OTHERWISE.
4. PROVIDE 1 HR. INTUMESCENT FIRE PROOFING FOR COLUMNS A-4 THRU A-20, B-14 THRU B-19.

NOTES:

ISSUE DATE:
100% GMP
PACKAGE #6
FEBRUARY 2, 2004

REVISIONS:

#	DATE	DESCRIPTION
1	01JUL04	PACKAGE #7

HEIFER INTERNATIONAL CENTER OFFICE BUILDING

LITTLE ROCK, ARKANSAS

PSY PROJECT NUMBER:
431C

CONTENTS:
SECOND FLOOR PLAN
- EAST END

SHEET NUMBER:

A102a

F:\CD-DISC\CAD\FinalDrawings\PrintCD\Finish\A102a-SecondFloorPlan-East End
Thursday, July 01, 2004 4:34 PM