

**POLK  
STANLEY  
YEARY  
ARCHITECTS, LTD.**

700 SOUTH SCHILLER  
LITTLE ROCK, AR 72201  
501.378-0878  
FAX 372-7629

21 W. MOUNTAIN, SUITE 227  
FAYETTEVILLE, AR 72701  
479-444-0473

**CONSULTANTS:**  
OWNER'S PROJECT ADVISOR:  
MOSES TUCKER REAL ESTATE, INC.  
CIVIL ENGINEER:  
McCLELLAND ENGINEERS  
LANDSCAPE ARCHITECT:  
LARSON BURNS SMITH  
STRUCTURAL ENGINEER:  
CROMWELL ENGINEERS INC.  
MECH., ELEC., PLUMB. ENGINEER:  
CROMWELL ENGINEERS INC.  
SUSTAINABLE CONSULTANT:  
BNM / ELEMENTS  
GLOBAL VILLAGE CONSULTANT  
CAMBRIDGE SEVEN ASSOCIATES  
INTERIOR DESIGNER:  
POLK STANLEY YEARY  
GENERAL CONTRACTOR:  
CDI

**GENERAL NOTES:**  
1. LOCATE WALLS & PARTITIONS ON CENTERLINE OF COLUINS UNLESS NOTED OTHERWISE.  
2. SEE SHEET 0003 FOR COLUMN DIMENSION PLAN.  
3. ALL WALLS ARE SEGMENTED TO FOLLOW CURVE OF BUILDING UNLESS NOTED OTHERWISE.

**NOTES:**

---



---



---



---



---

**ISSUE DATE:**  
100% GMP  
PACKAGE #6  
FEBRUARY 2, 2004

**REVISIONS:**

#	DATE	DESCRIPTION
1	01JUL04	PACKAGE #1


**HEIFER  
INTERNATIONAL  
CENTER  
OFFICE BUILDING**  
LITTLE ROCK, ARKANSAS

PSY PROJECT NUMBER:  
431C



**CONTENTS:**  
SECOND FLOOR PLAN - WEST END  
SHEET NUMBER:

**A102b**

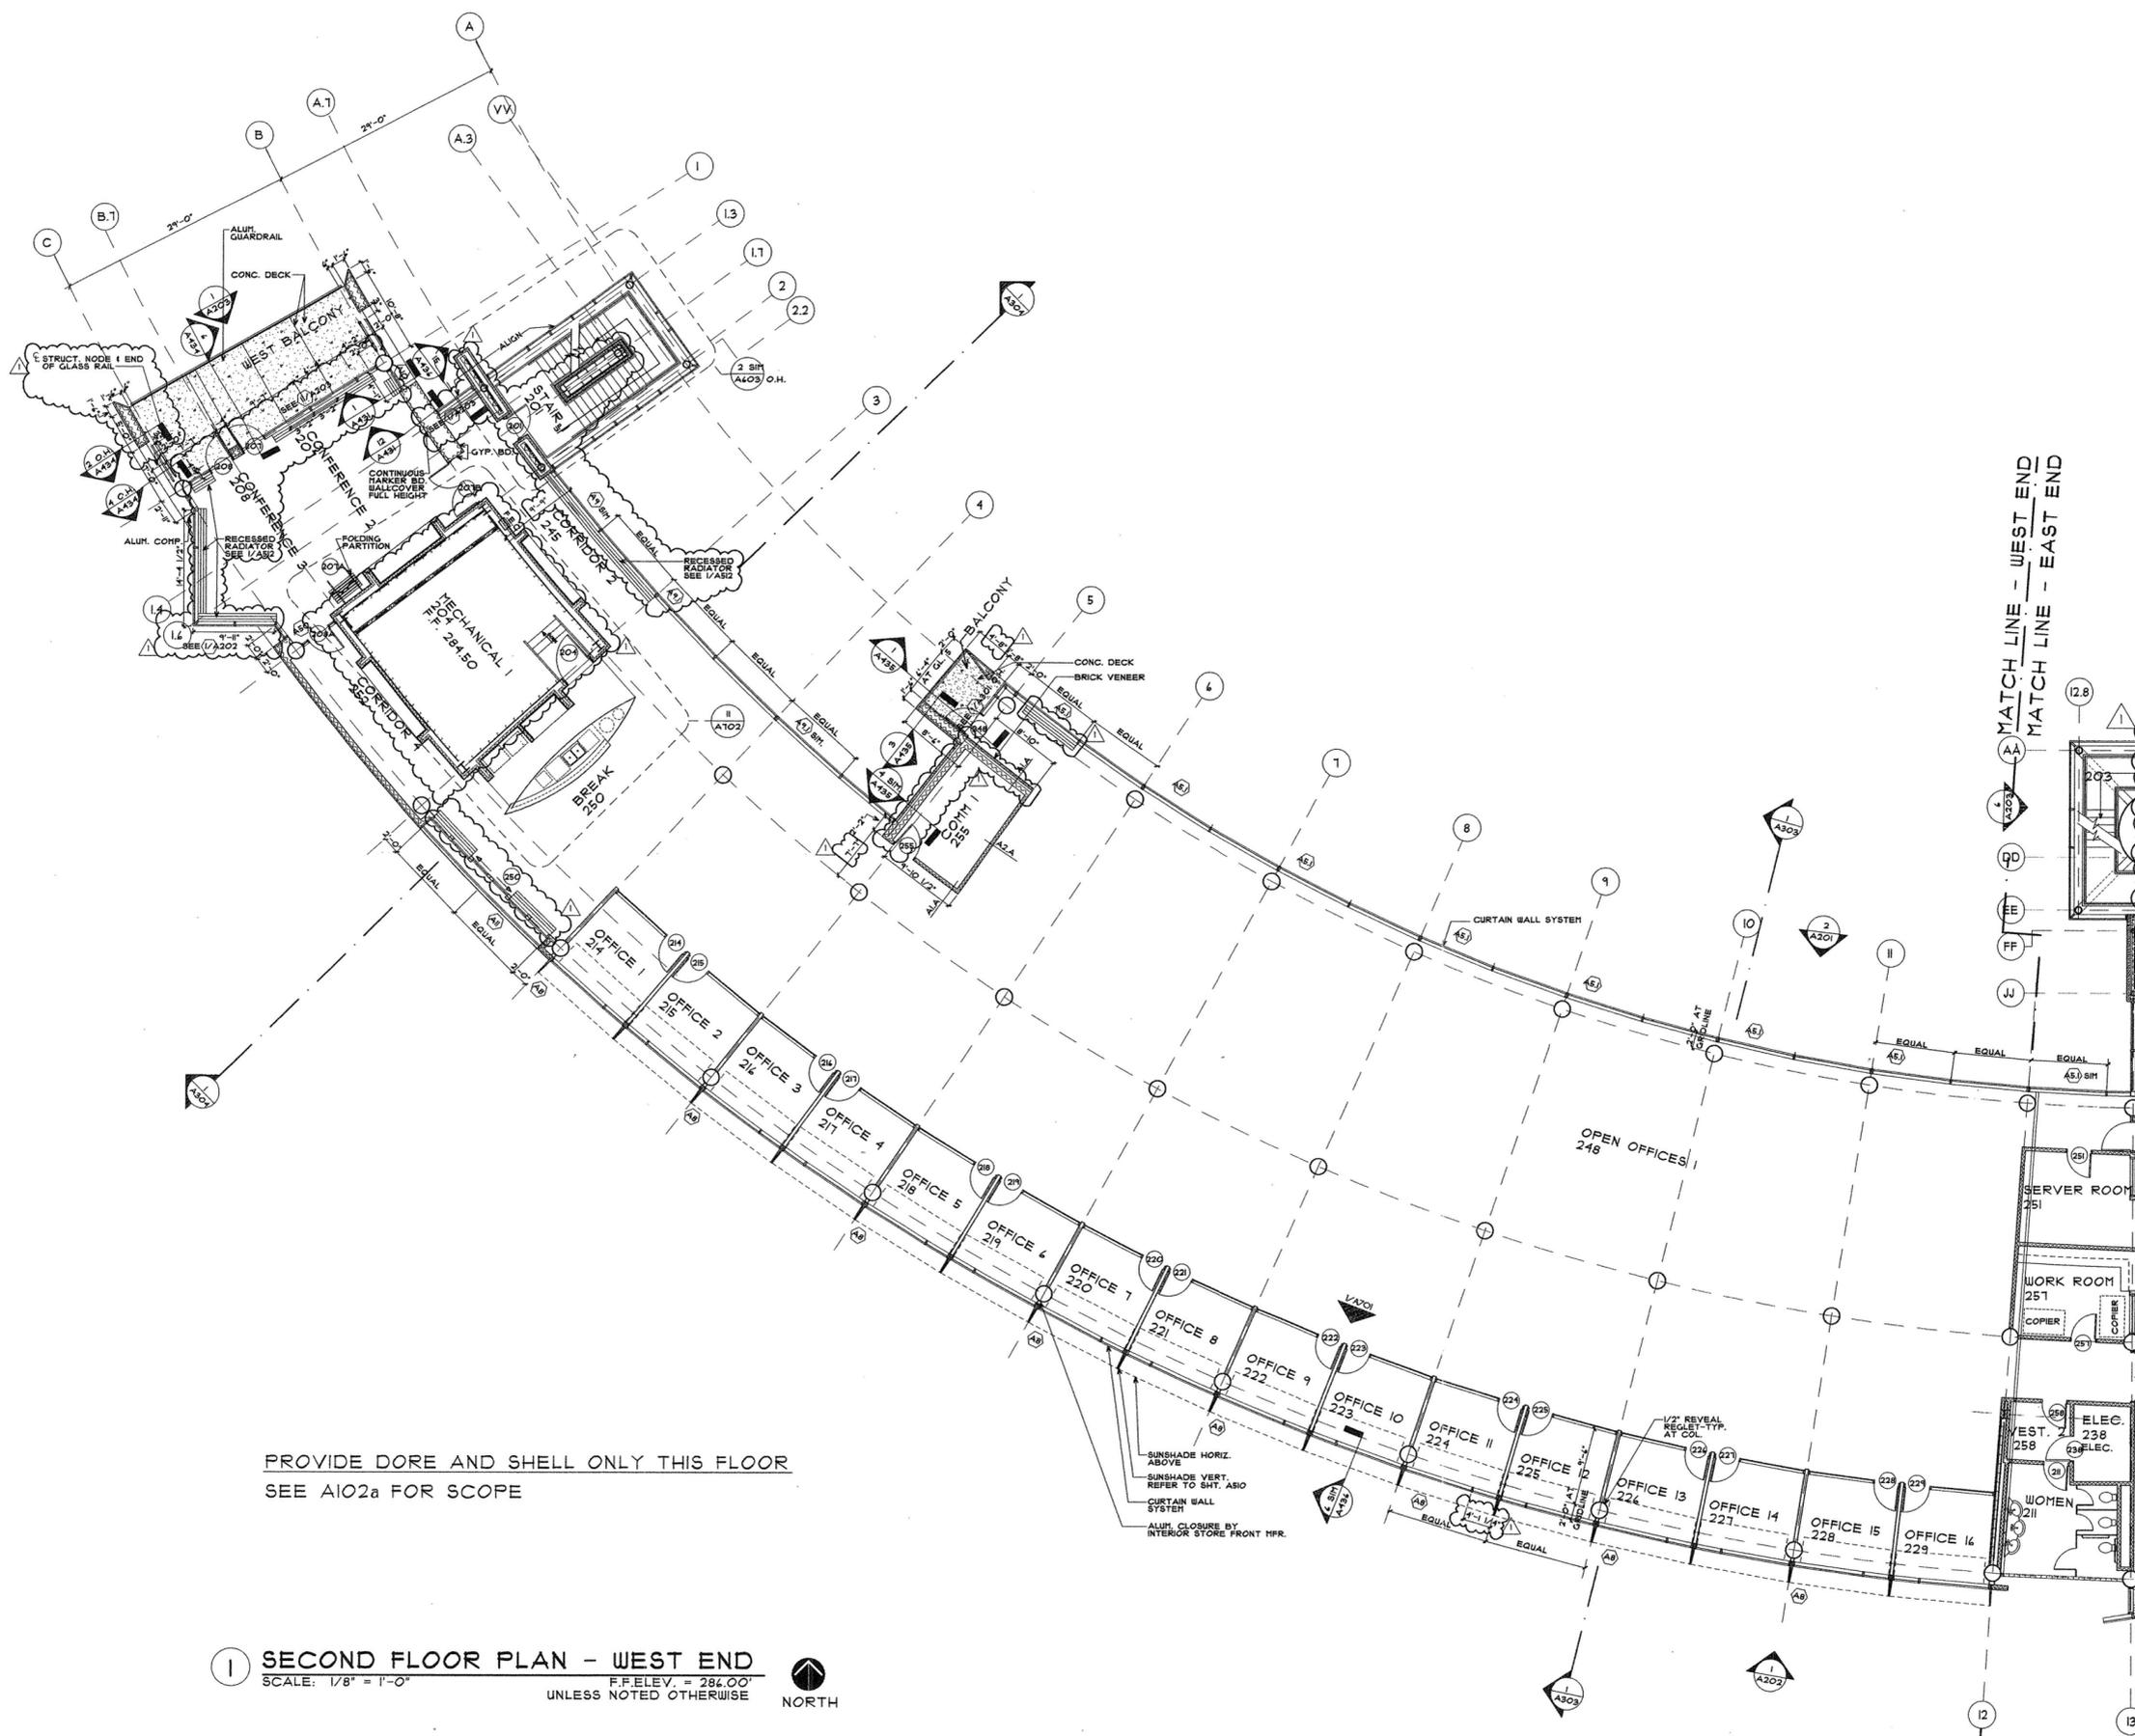

PROVIDE DORE AND SHELL ONLY THIS FLOOR  
SEE A102a FOR SCOPE

**1 SECOND FLOOR PLAN - WEST END**  
SCALE: 1/8" = 1'-0" F.F. ELEV. = 284.00'  
UNLESS NOTED OTHERWISE



P:\D:\04\480\CD\A102b.dwg 10/20/04 10:00 AM