

**POLK
STANLEY
YEARY**
ARCHITECTS, LTD.

700 SOUTH SCHILLER
LITTLE ROCK, AR 72201
501 378-0878
FAX 372-7629
21 W. MOUNTAIN, SUITE 227
FAYETTEVILLE, AR 72701
479-444-0473

CONSULTANTS:
OWNER'S PROJECT ADVISOR:
MOSES TUCKER REAL ESTATE, INC.
CIVIL ENGINEER:
McCLELLAND ENGINEERS
LANDSCAPE ARCHITECT:
LARSON BURNS SMITH
STRUCTURAL ENGINEER:
CROMWELL ENGINEERS INC.
MECL. ELEC. PLUMB. ENGINEER:
CROMWELL ENGINEERS INC.
SUSTAINABLE CONSULTANT:
BNIM / ELEMENTS
GLOBAL VILLAGE CONSULTANT:
CAMBRIDGE SEVEN ASSOCIATES
INTERIOR DESIGNER:
POLK STANLEY YEARY
GENERAL CONTRACTOR:
CDI

GENERAL NOTES:
1. PAINT ALL EXPOSED STEEL DECK & STRUCTURE - SEE SPECS FOR SCHEDULE.
2. DO NOT PAINT EXPOSED CONC. DECK.
3. DO NOT PAINT EXPOSED DUCTS.
4. PAINT ALL OTHERS EXPOSED SYSTEMS - SEE SPECS FOR SCHED.
5. DO NOT PAINT ANY ALUM. MAT.
6. ELEC. CONDUIT SHALL RUN THRU FLOOR FLESH ABOVE THEN DROP TO FIXTURE AND DEVICE F-BOX.
7. PENDANT FIXTURES: MOUNT TIGHT TO SIDES OF BEAMS INDICATED UNLESS NOTED OTHERWISE. SEE BUILDING SECTIONS FOR ADDITIONAL INFORMATION.
8. LOCATION OF ALL DEVICES, FIXTURES, ETC. SHALL BE REVISSED WITH ARCHITECT BEFORE INSTALLATION.
9. SEE BUILDING SECTIONS FOR ADDITIONAL INFORMATION ON MOUNTING OF DEVICES.
10. SEE SEC. FLOOR PLANS FOR LOCATION OF FIXTURES.

ISSUE DATE:
100% GMP
PACKAGE #6
FEBRUARY 2, 2004

REVISIONS:


#	DATE	DESCRIPTION
1	01/01/04	PACKAGE #1
2	10/01/04	ASI NO. 25

**HEIFER
INTERNATIONAL
CENTER
OFFICE BUILDING**
LITTLE ROCK, ARKANSAS

PSY PROJECT NUMBER:
431C

CONTENTS:
SECOND FLOOR REFLECTED
CEILING PLAN
- EAST END
SHEET NUMBER:

A102c

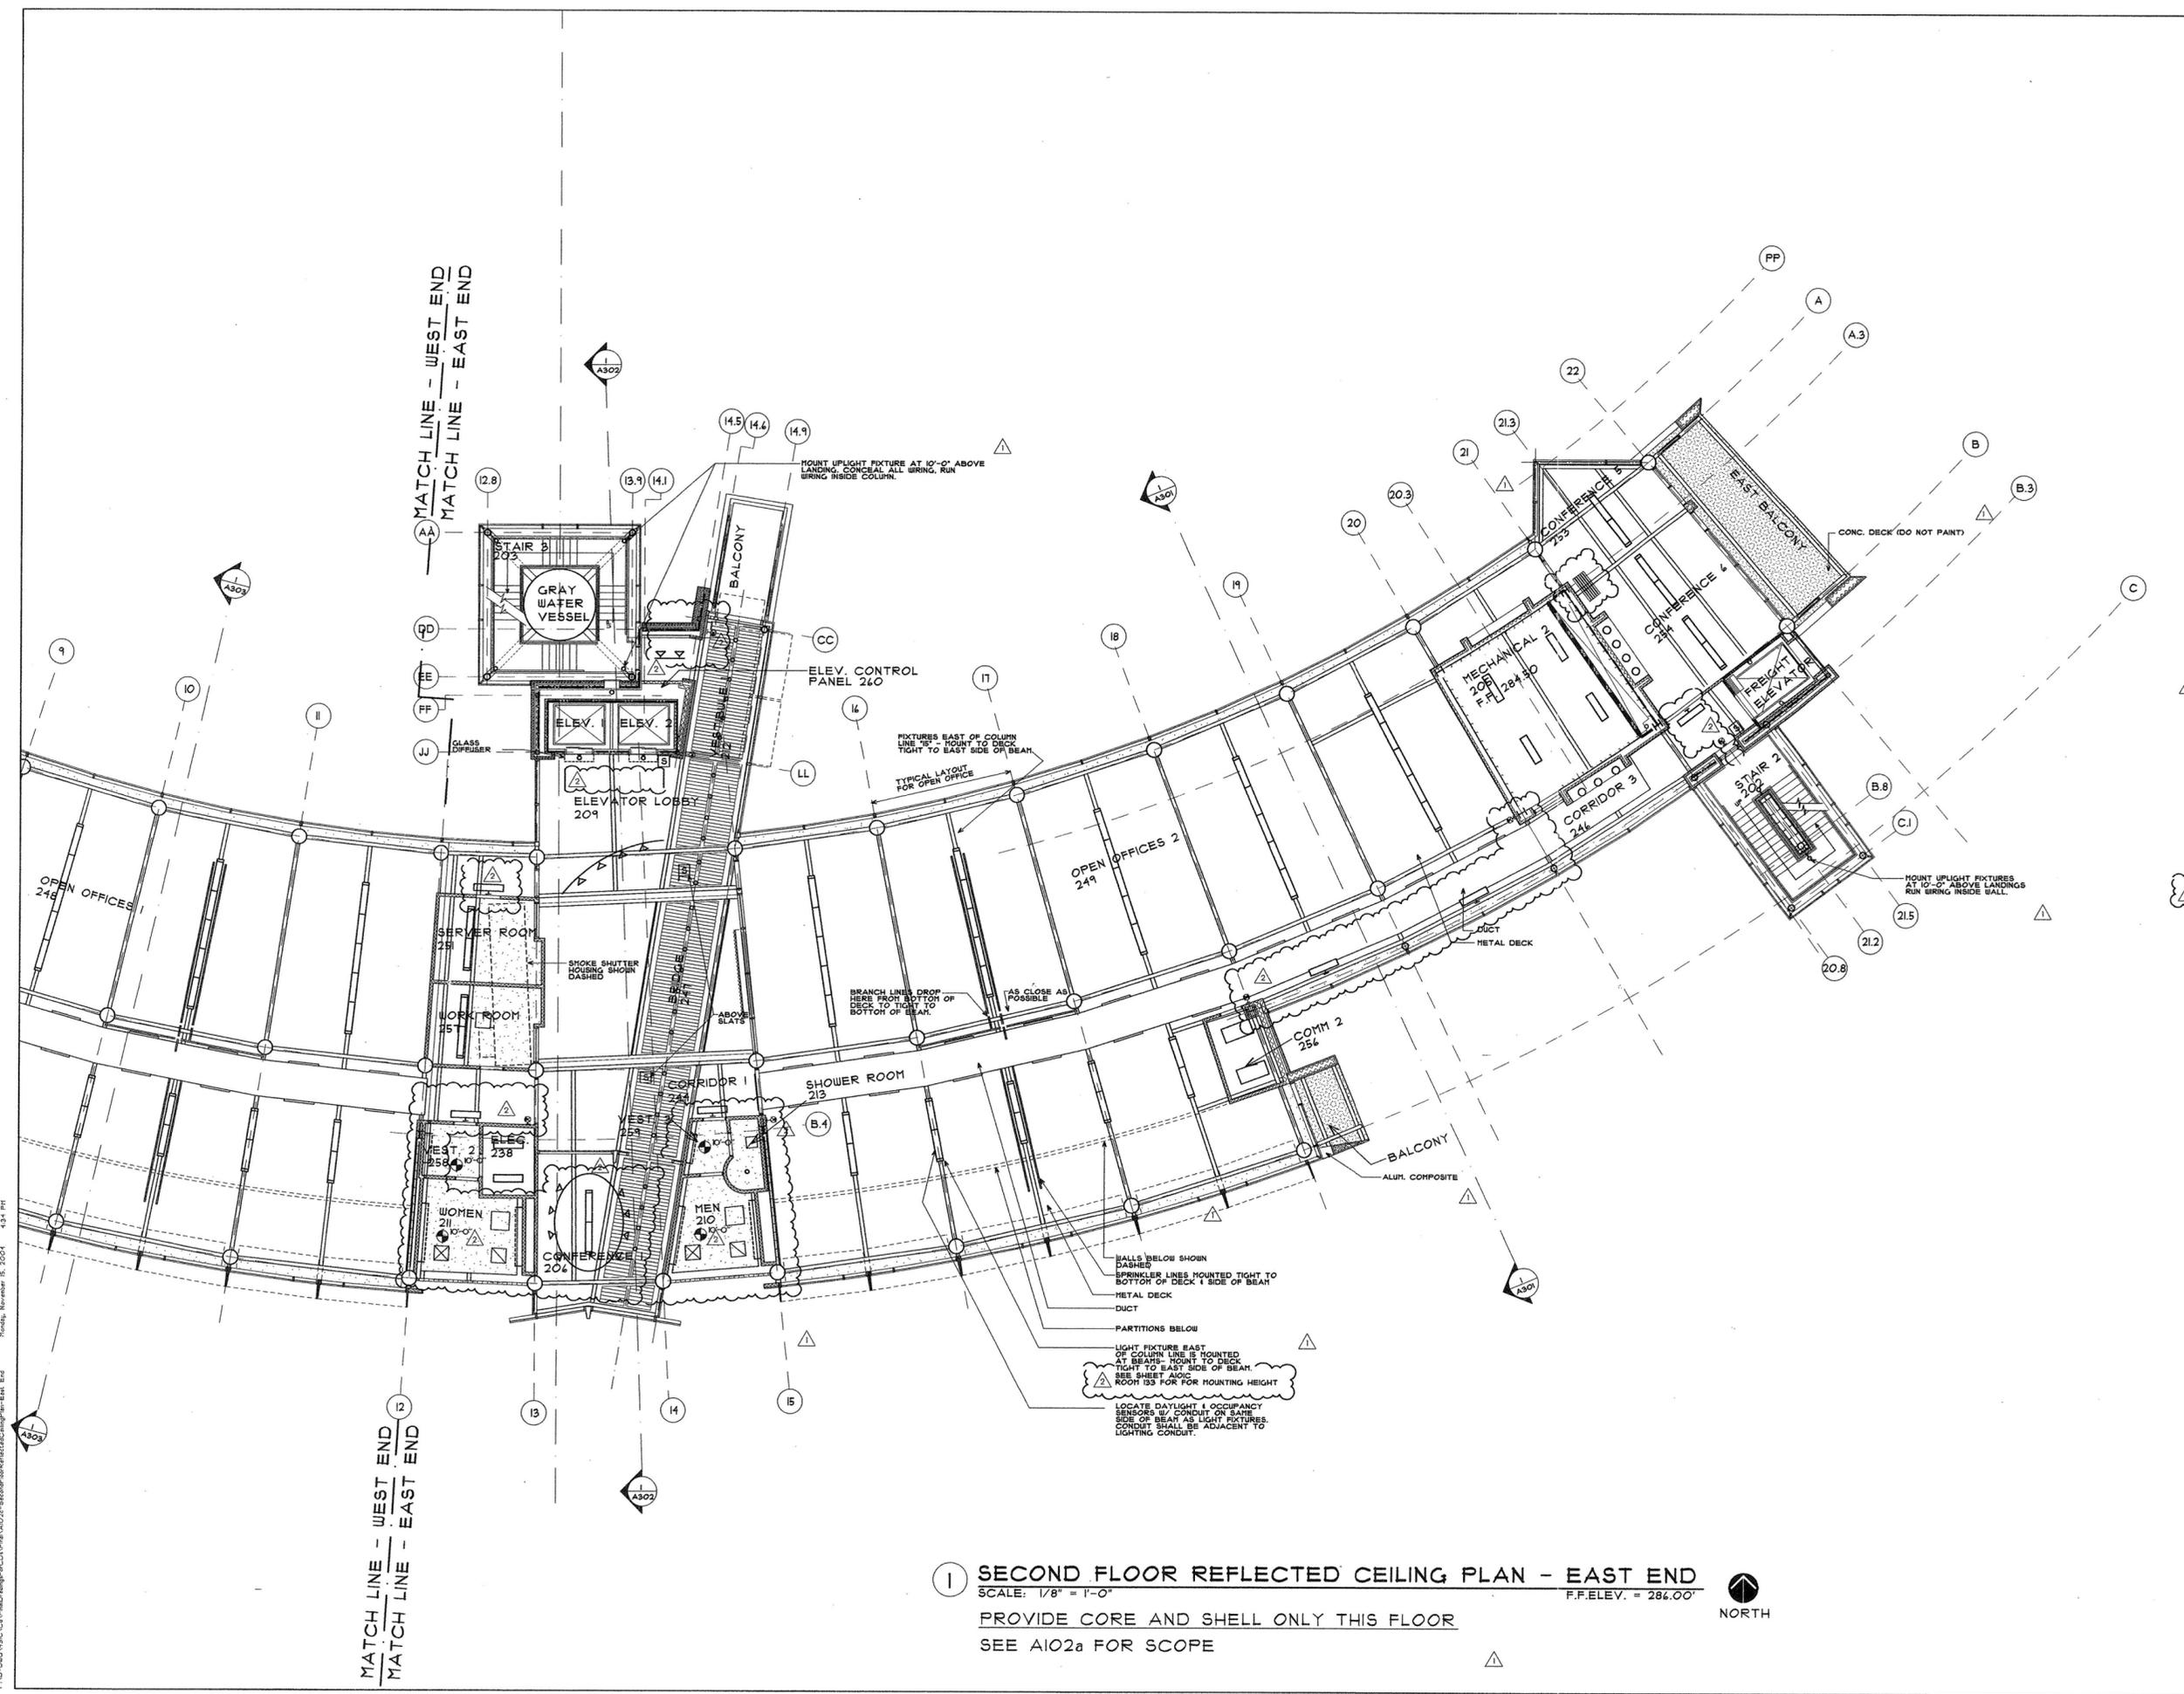

1 SECOND FLOOR REFLECTED CEILING PLAN - EAST END
SCALE: 1/8" = 1'-0"
F.F.ELEV. = 284.00'

PROVIDE CORE AND SHELL ONLY THIS FLOOR
SEE A102a FOR SCOPE



P:\AD-000-V3\CD\A102c\A102c.dwg 15/02/04 4:34 PM