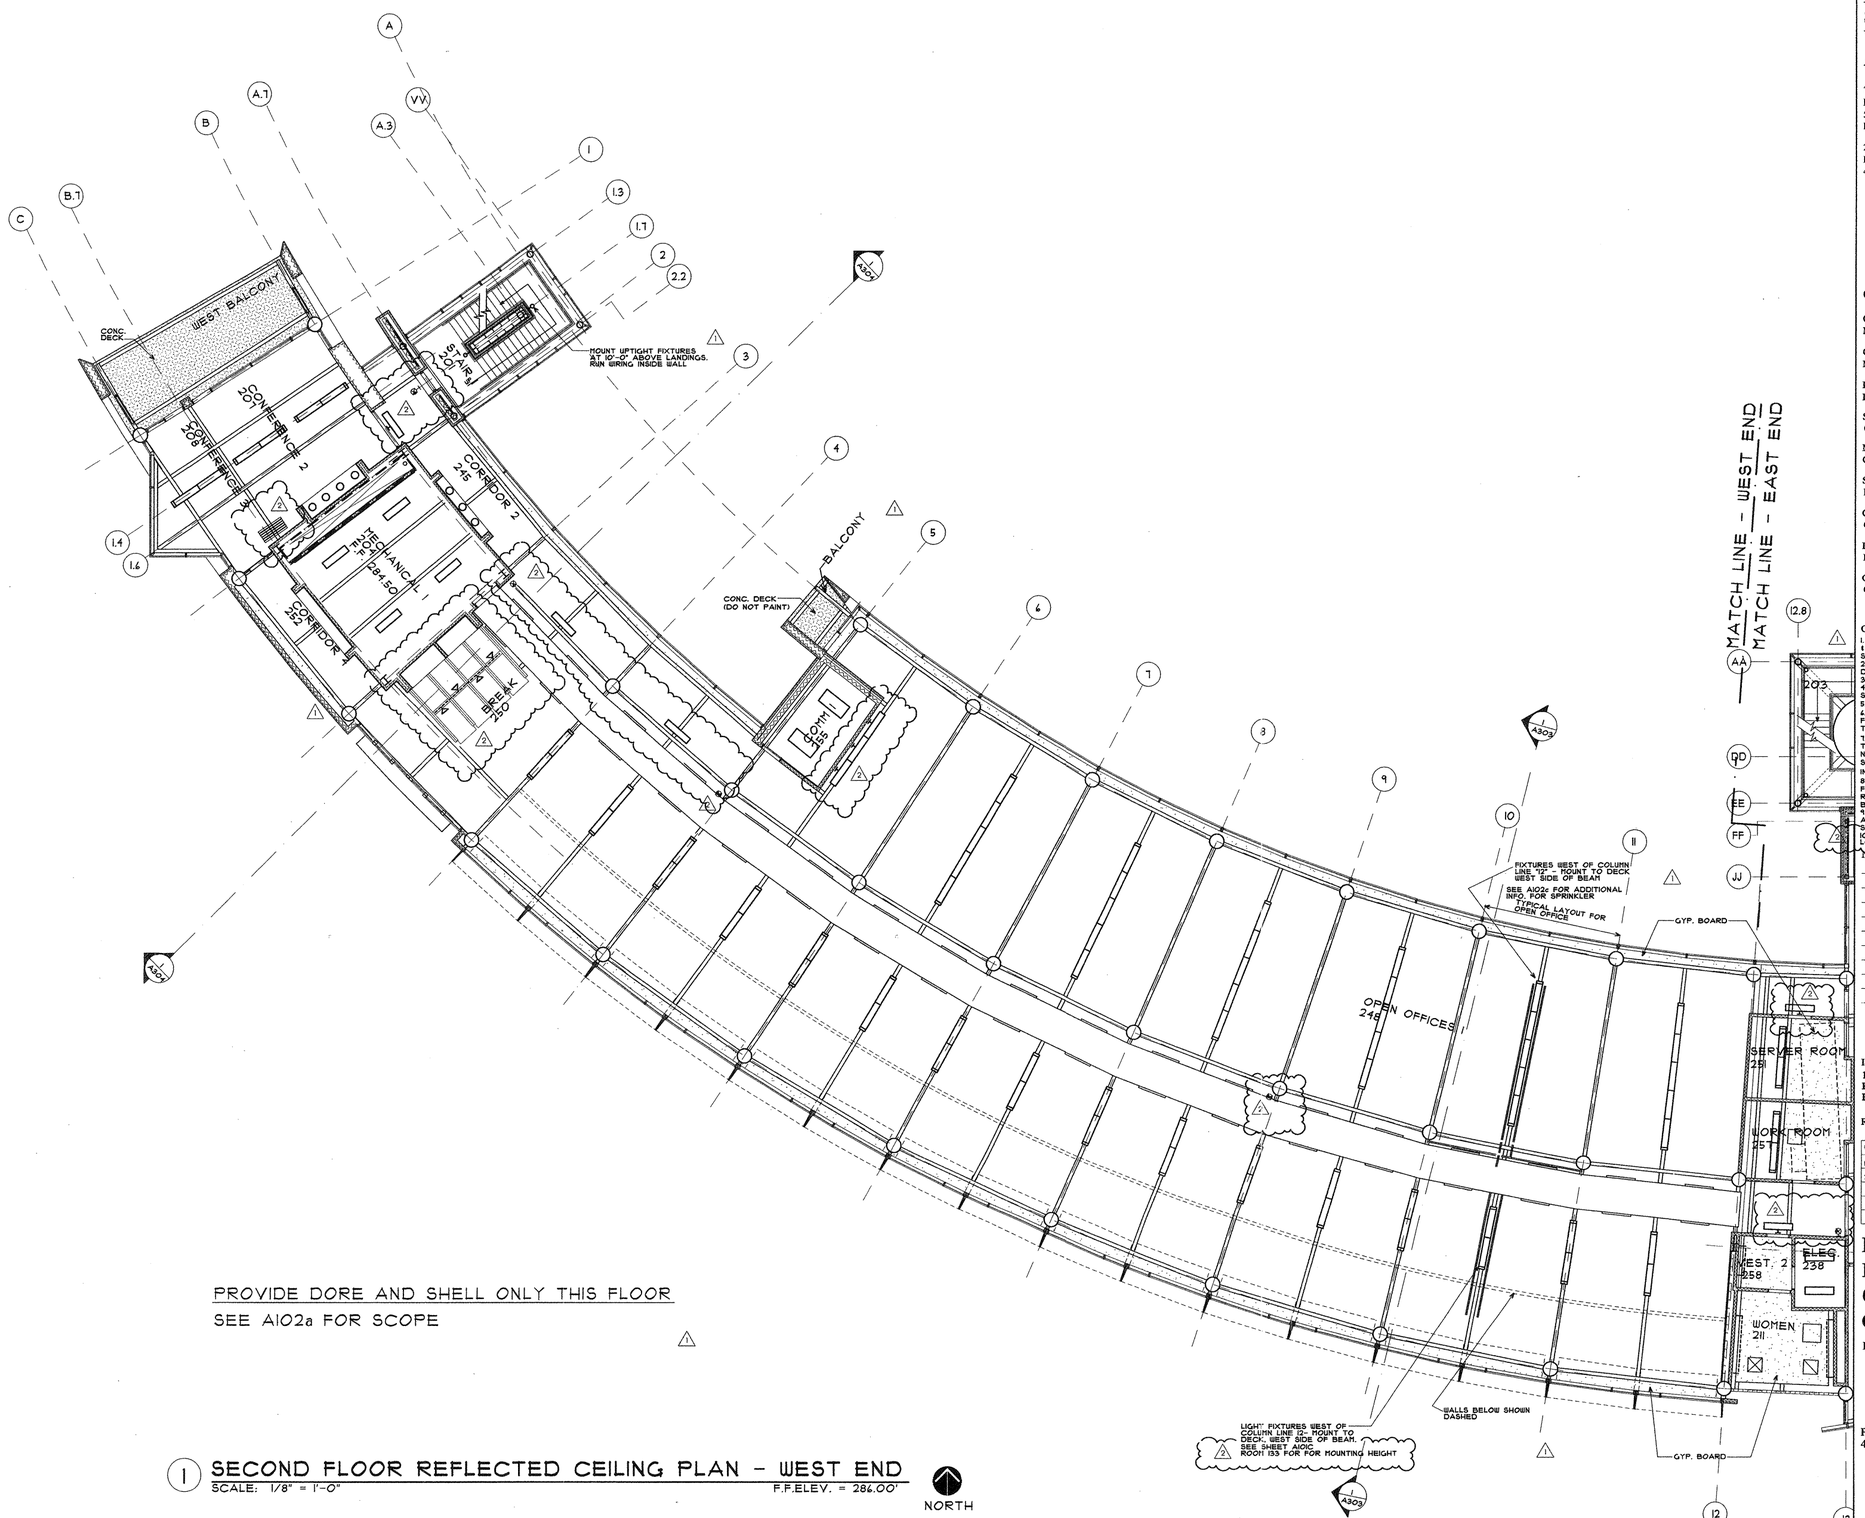

PROVIDE DORE AND SHELL ONLY THIS FLOOR

SEE A102a FOR SCOPE

1 SECOND FLOOR REFLECTED CEILING PLAN - WEST END

SCALE: 1/8" = 1'-0"

F.F.ELEV. = 286.00'

NORTH

POLK
STANLEY
YEARY
ARCHITECTS, LTD.

700 SOUTH SCHILLER
LITTLE ROCK, AR 72201
501 378-0878
FAX 372-7629

21 W. MOUNTAIN, SUITE 227
FAYETTEVILLE, AR 72701
479-444-0473

CONSULTANTS:

OWNER'S PROJECT ADVISOR:
MOSES TUCKER REAL ESTATE, INC.

CIVIL ENGINEER:
McCLELLAND ENGINEERS

LANDSCAPE ARCHITECT:
LARSON BURNS SMITH

STRUCTURAL ENGINEER:
CROMWELL ENGINEERS INC.

MECH., ELEC., PLUMB. ENGINEER:
CROMWELL ENGINEERS INC.

SUSTAINABLE CONSULTANT:
BNIM / ELEMENTS

GLOBAL VILLAGE CONSULTANT
CAMBRIDGE SEVEN ASSOCIATES

INTERIOR DESIGNER:
POLK STANLEY YEARY

GENERAL CONTRACTOR:
CDI

GENERAL NOTES:
1. PAINT ALL EXPOSED STEEL DECK & STRUCTURE - SEE SPEC'S FOR SCHEDULE.
2. DO NOT PAINT EXPOSED CONC. DECK.
3. DO NOT PAINT EXPOSED DUCTS.
4. PAINT ALL OTHER EXPOSED SYSTEMS - SEE SPEC'S FOR SCHED.
5. DO NOT PAINT ANY ALUM. MAT.
6. ELEC. CONDUIT SHALL RUN THRU FLOOR PLENUM ABOVE THEN DROP TO FIXTURE AND DEVICE J-BOX.
7. PENDANT FIXTURES: MOUNT TIGHT TO SIDES OF BEAMS INDICATED UNLESS NOTED OTHERWISE. SEE BULDING SECTIONS FOR ADDITIONAL INFORMATION.
8. LOCATION OF ALL DEVICES, FIXTURES, ETC. SHALL BE REVIEWED WITH ARCHITECT BEFORE INSTALLATION.
9. SEE BUILDING SECTIONS FOR ADDITIONAL INFORMATION ON SPRINKLER LINE LOCATIONS.
10. SEE 3RD FLOOR PLANS FOR LOCATION OF FIXTURES.

NOTES:

ISSUE DATE:
100% GMP
PACKAGE #6
FEBRUARY 2, 2004

REVISIONS:

#	DATE	DESCRIPTION
1	01JUL04	PACKAGE #7
2	15NOV04	ASI NO. 25

HEIFER INTERNATIONAL CENTER OFFICE BUILDING

LITTLE ROCK, ARKANSAS

PSY PROJECT NUMBER:
431C

CONTENTS:
SECOND FLOOR REFLECTED CEILING PLAN - WEST END
SHEET NUMBER:

A102d

P:\D-DRIVE\431C\CAD\Hardfile\CD\SHEETS\A102c-SecondFloorReflectedCeilingPlan-WestEnd.dwg, September 15, 2004 4:32 PM