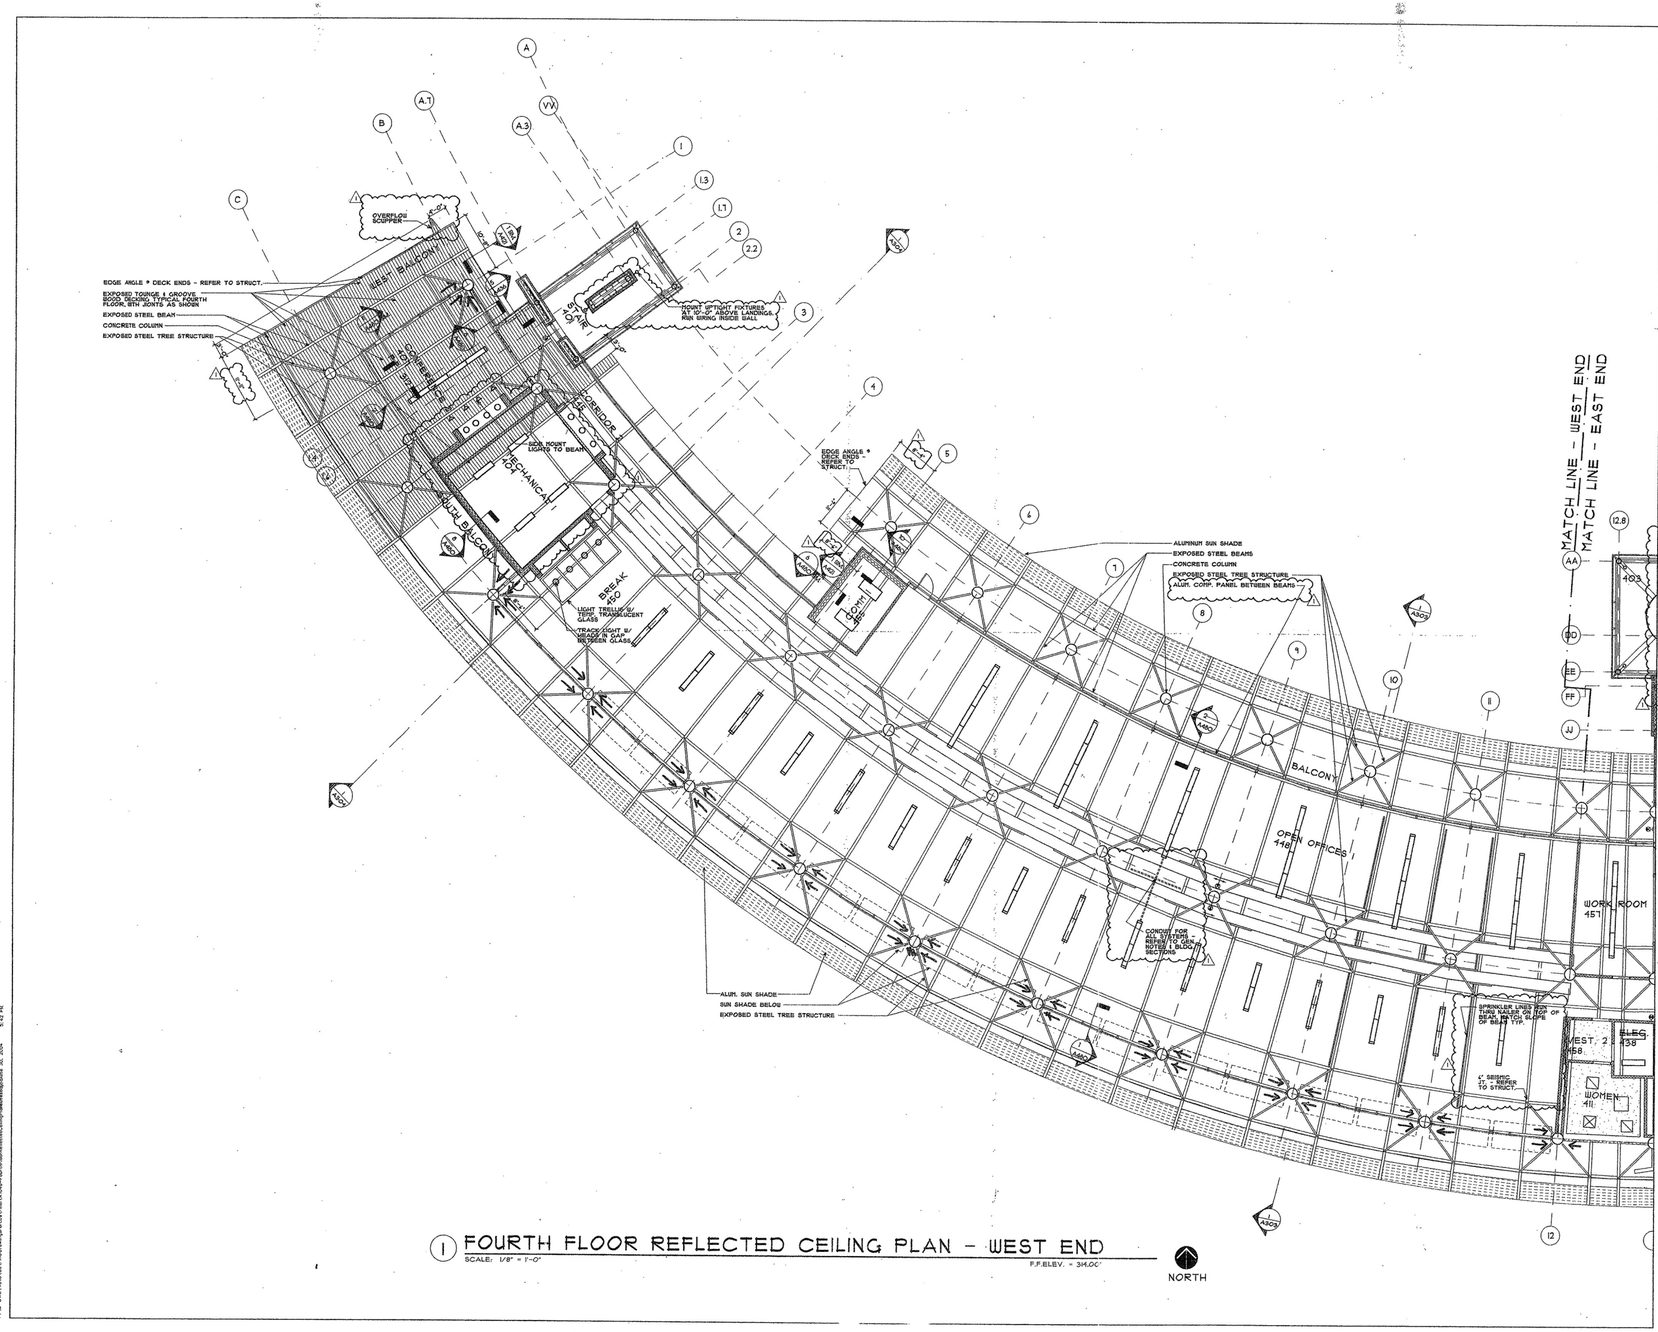

1 FOURTH FLOOR REFLECTED CEILING PLAN - WEST END

SCALE: 1/8" = 1'-0"

F.F.ELEV. = 314.0C'

POLK
STANLEY
YEARY
ARCHITECTS, LTD.

700 SOUTH SCHILLER
LITTLE ROCK, AR 72201
501 378-0878
FAX 372-7629

21 W. MOUNTAIN, SUITE 227
FAYEYTEVILLE, AR 72701
479-444-0473

CONSULTANTS:

OWNER'S PROJECT ADVISOR:
MOSES TUCKER REAL ESTATE, INC.

CIVIL ENGINEER:
McCLELLAND ENGINEERS

LANDSCAPE ARCHITECT:
LARSON BURNS SMITH

STRUCTURAL ENGINEER:
CROMWELL ENGINEERS INC.

MECH., ELEC., PLUMB. ENGINEER:
CROMWELL ENGINEERS INC.

SUSTAINABLE CONSULTANT:
BNIM / ELEMENTS

GLOBAL VILLAGE CONSULTANT
CAMBRIDGE SEVEN ASSOCIATES

INTERIOR DESIGNER:
POLK STANLEY YEARY

GENERAL CONTRACTOR:
CDI

GENERAL NOTES:
1. PAINT ALL EXPOSED STEEL DECK & STRUCTURE - SEE SPEC'S FOR SCHEDULE.
2. DO NOT PAINT EXPOSED CONC. ZIP.
3. DO NOT PAINT EXPOSED CUCTS.
4. PAINT ALL OTHER EXPOSED SYSTEMS - SEE SPEC'S FOR SCHED.
5. DO NOT PAINT ANY ALUM. MAT.
6. ELEC. CONDUIT SHALL RUN THRU FLOOR PLENUM ABOVE THEN DROP TO FIXTURE AND DEVICE J-BOX. NAILER.
7. PENDANT FIXTURES: MOUNT TIGHT TO SIDES OF BEAMS INDICATED UNLESS OTHERWISE NOTED. SEE BUILDING SECTIONS FOR ADDITIONAL INFORMATION.
8. LOCATION OF ALL DEVICES, FIXTURES, ETC. SHALL BE REVIEWED WITH ARCHITECT BEFORE INSTALLATION.
9. SEE BUILDING SECTIONS FOR ADDITIONAL INFORMATION ON SPRINKLER LINE LOCATIONS.

NOTES:

ISSUE DATE:
100% GMP
PACKAGE #6
FEBRUARY 2, 2004

REVISIONS:

#	DATE	DESCRIPTION
1	01JUL04	PACKAGE #1
	1/27/04	ASI # 07

HEIFER
INTERNATIONAL
CENTER
OFFICE BUILDING

LITTLE ROCK, ARKANSAS

ROOF TREE TUBE TRUSS
PER ED SORGBANT - PSRCP
9-14-04

PSY PROJECT NUMBER:
431C

CONTENTS:
FOURTH FLOOR REFLECTED CEILING PLAN - WEST END

SHEET NUMBER:

A104d