

**POLK
STANLEY
YEARY
ARCHITECTS, LTD.**

700 SOUTH SCHILLER
LITTLE ROCK, AR 72201
501 378-0878
FAX 372-7629

21 W. MOUNTAIN, SUITE 227
FAYETTEVILLE, AR 72701
479-444-0473

CONSULTANTS:

OWNER'S PROJECT ADVISOR:
MOSES TUCKER REAL ESTATE, INC.

CIVIL ENGINEER:
MCLELLAND ENGINEERS

LANDSCAPE ARCHITECT:
LARSON BURNS SMITH

STRUCTURAL ENGINEER:
CROMWELL ENGINEERS INC.

MECH., ELEC., PLUMB. ENGINEER:
CROMWELL ENGINEERS INC.

SUSTAINABLE CONSULTANT:
BNIM / ELEMENTS

GLOBAL VILLAGE CONSULTANT
CAMBRIDGE SEVEN ASSOCIATES

INTERIOR DESIGNER:
POLK STANLEY YEARY

GENERAL CONTRACTOR:
CDI CONTRACTORS, INC.

GENERAL NOTES:

NOTES:

ISSUE DATE:
100% GMP
PACKAGE #6
FEBRUARY 2, 2004

REVISIONS:

#	DATE	DESCRIPTION
1	1/14/04	PACKAGE 5, ADDN. 01
2	01/10/04	PACKAGE #1

**HEIFER
INTERNATIONAL
CENTER
OFFICE BUILDING**
LITTLE ROCK, ARKANSAS


PSY PROJECT NUMBER:
431C



CONTENTS:
SOUTH BUILDING
ELEVATION

SHEET NUMBER:

A202

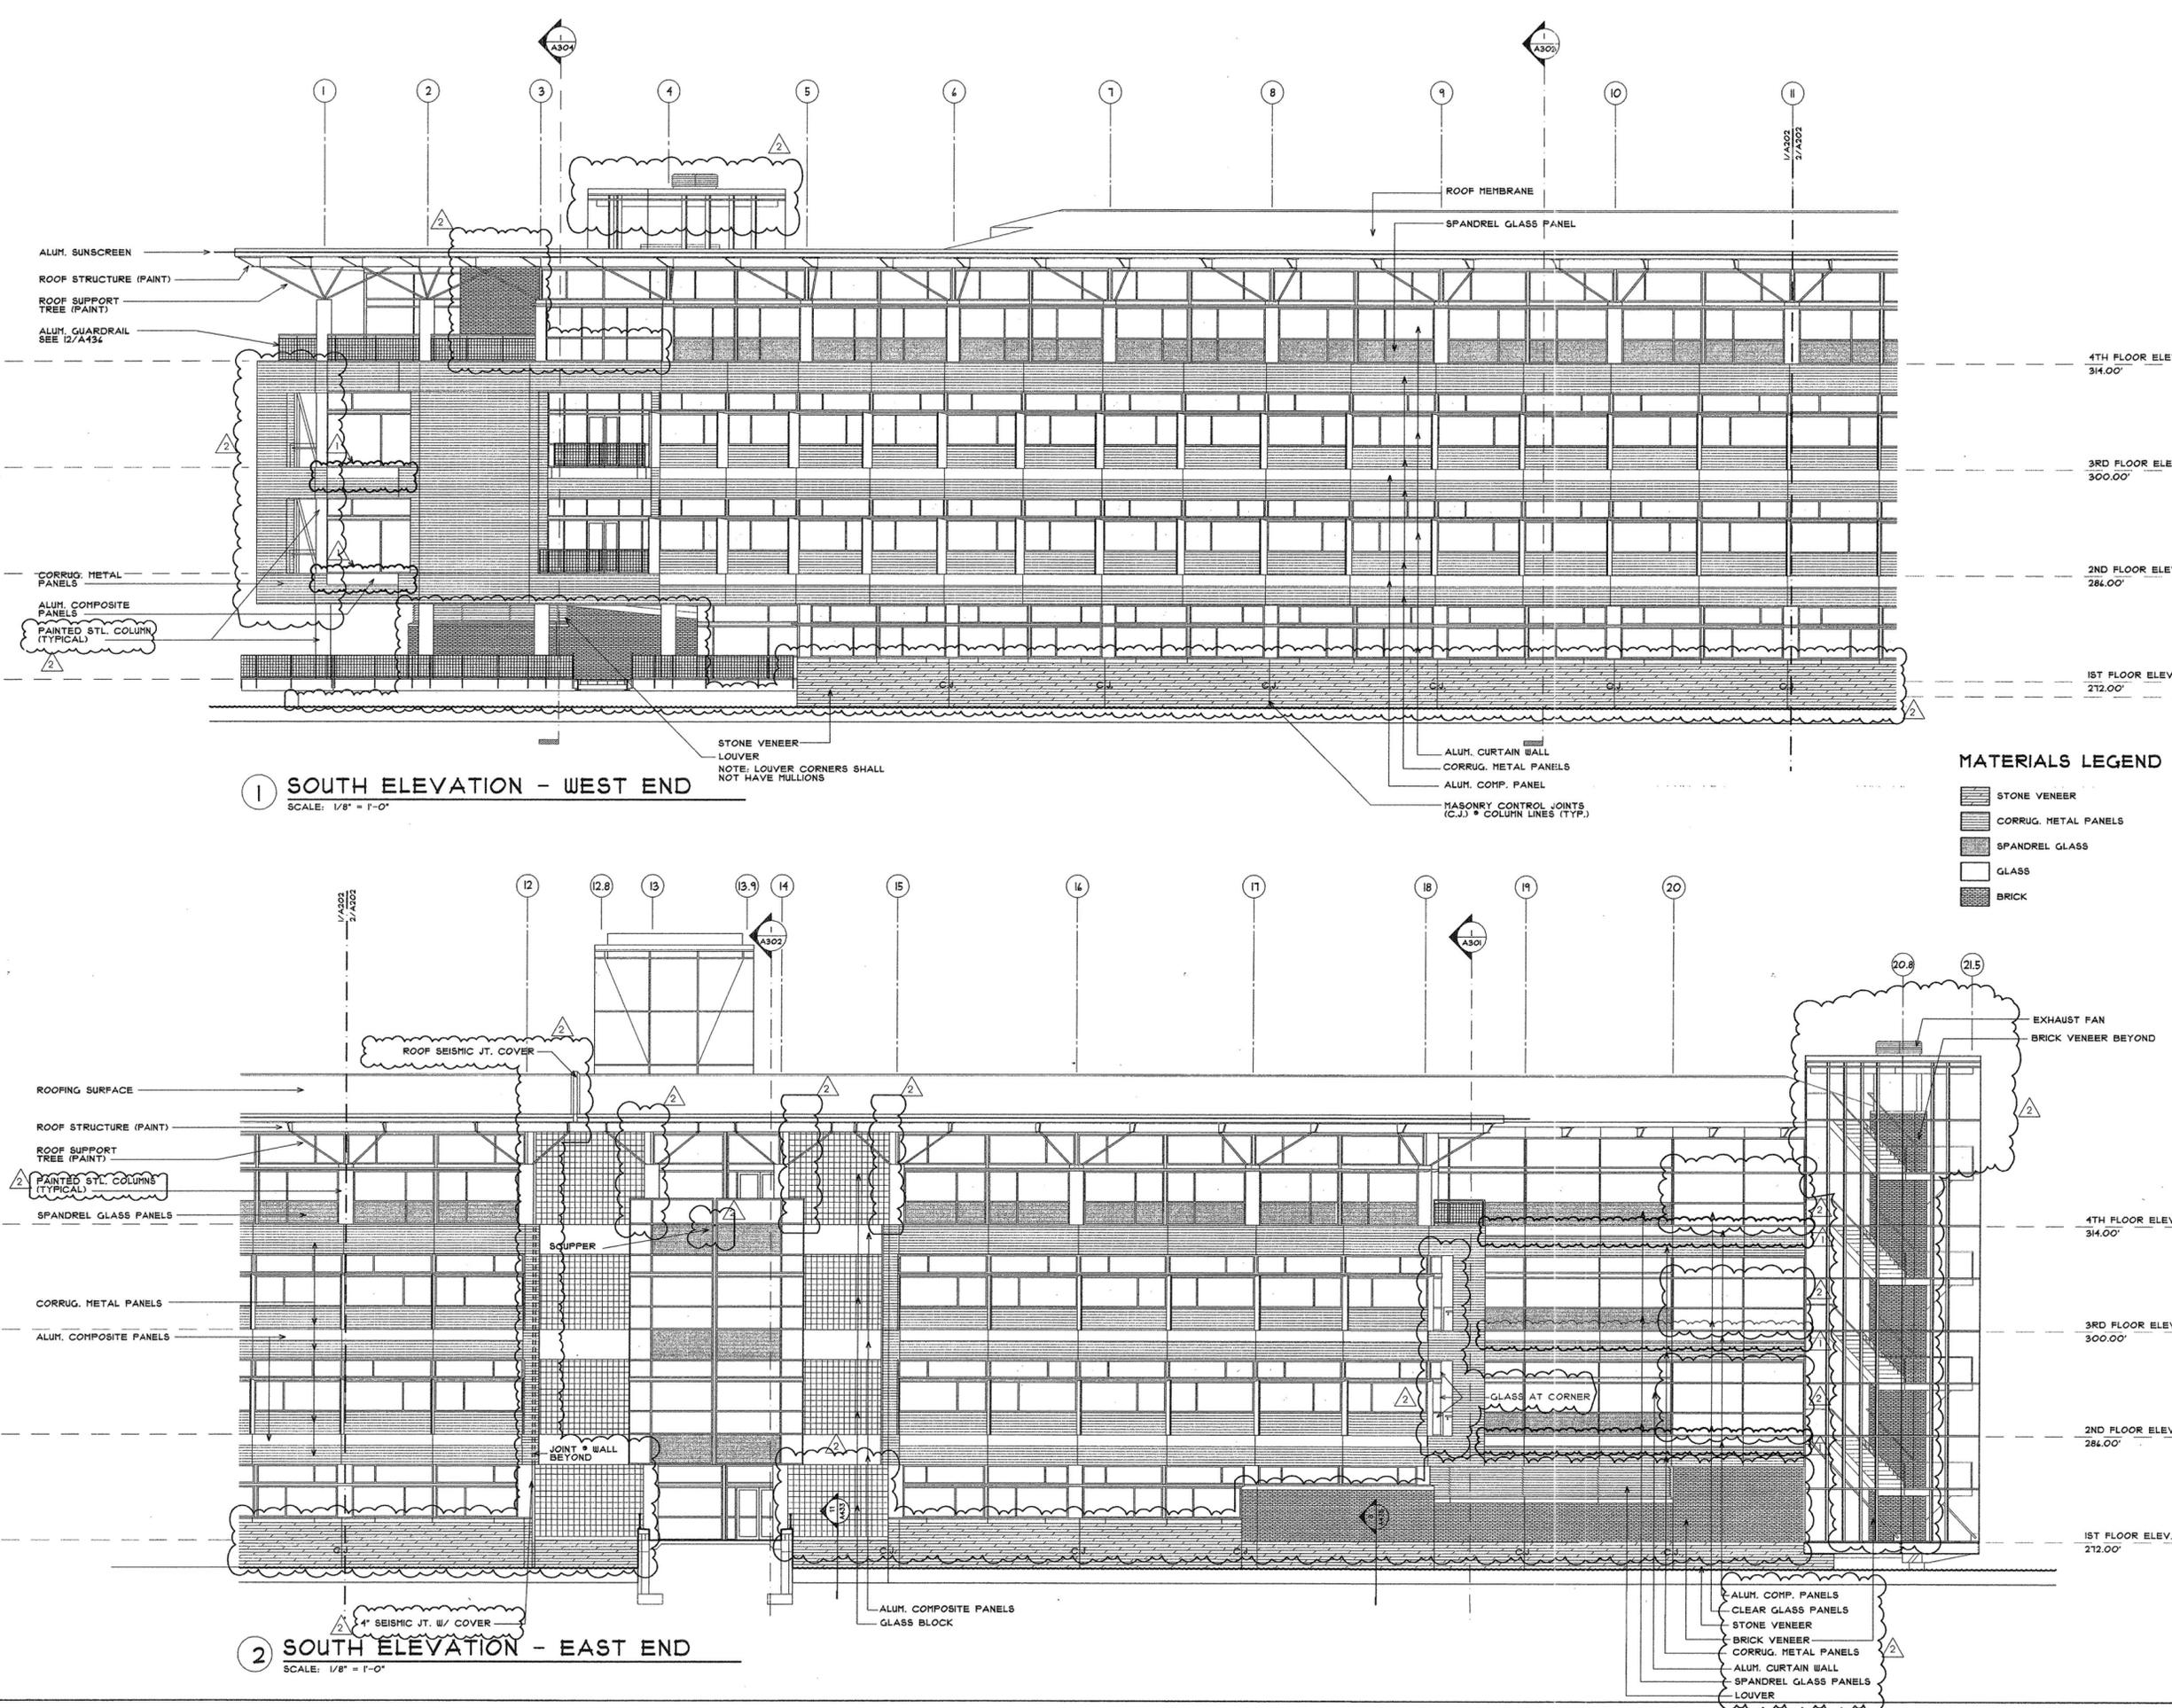

1 SOUTH ELEVATION - WEST END
SCALE: 1/8" = 1'-0"

2 SOUTH ELEVATION - EAST END
SCALE: 1/8" = 1'-0"

MATERIALS LEGEND

- STONE VENEER
- CORRUG. METAL PANELS
- SPANDREL GLASS
- GLASS
- BRICK

P:\DWG\1310\1310_Plan\1310_Plan_V202-Submittal\Drawings_Thursday, July 01, 2004 1:45 PM