

**POLK  
STANLEY  
YEARY**  
ARCHITECTS, LTD.

700 SOUTH SCHILLER  
LITTLE ROCK, AR 72201  
501 378-0878  
FAX 372-7629

21 W. MOUNTAIN, SUITE 227  
FAYETTEVILLE, AR 72701  
479-444-0473

**CONSULTANTS:**

- OWNER'S PROJECT ADVISOR:  
MOSES TUCKER REAL ESTATE, INC.
- CIVIL ENGINEER:  
McCLELLAND ENGINEERS
- LANDSCAPE ARCHITECT:  
LARSON BURNS SMITH
- STRUCTURAL ENGINEER:  
CROMWELL ENGINEERS INC.
- MECH. ELEC. PLUMB. ENGINEER:  
CROMWELL ENGINEERS INC.
- SUSTAINABLE CONSULTANT:  
BNIM / ELEMENTS
- GLOBAL VILLAGE CONSULTANT  
CAMBRIDGE SEVEN ASSOCIATES
- INTERIOR DESIGNER:  
POLK STANLEY YEARY
- GENERAL CONTRACTOR:  
CDI CONTRACTORS, INC.

**GENERAL NOTES:**

**NOTES:**

ISSUE DATE:  
100% GMP  
PACKAGE #6  
FEBRUARY 02, 2004

**REVISIONS:**

#	DATE	DESCRIPTION
1	01JUL04	PACKAGE #1


**HEIFER  
INTERNATIONAL  
CENTER  
OFFICE BUILDING**  
LITTLE ROCK, ARKANSAS

PSY PROJECT NUMBER:  
431C

CONTENTS:  
**BUILDING CROSS SECTION**

SHEET NUMBER:

**A301**

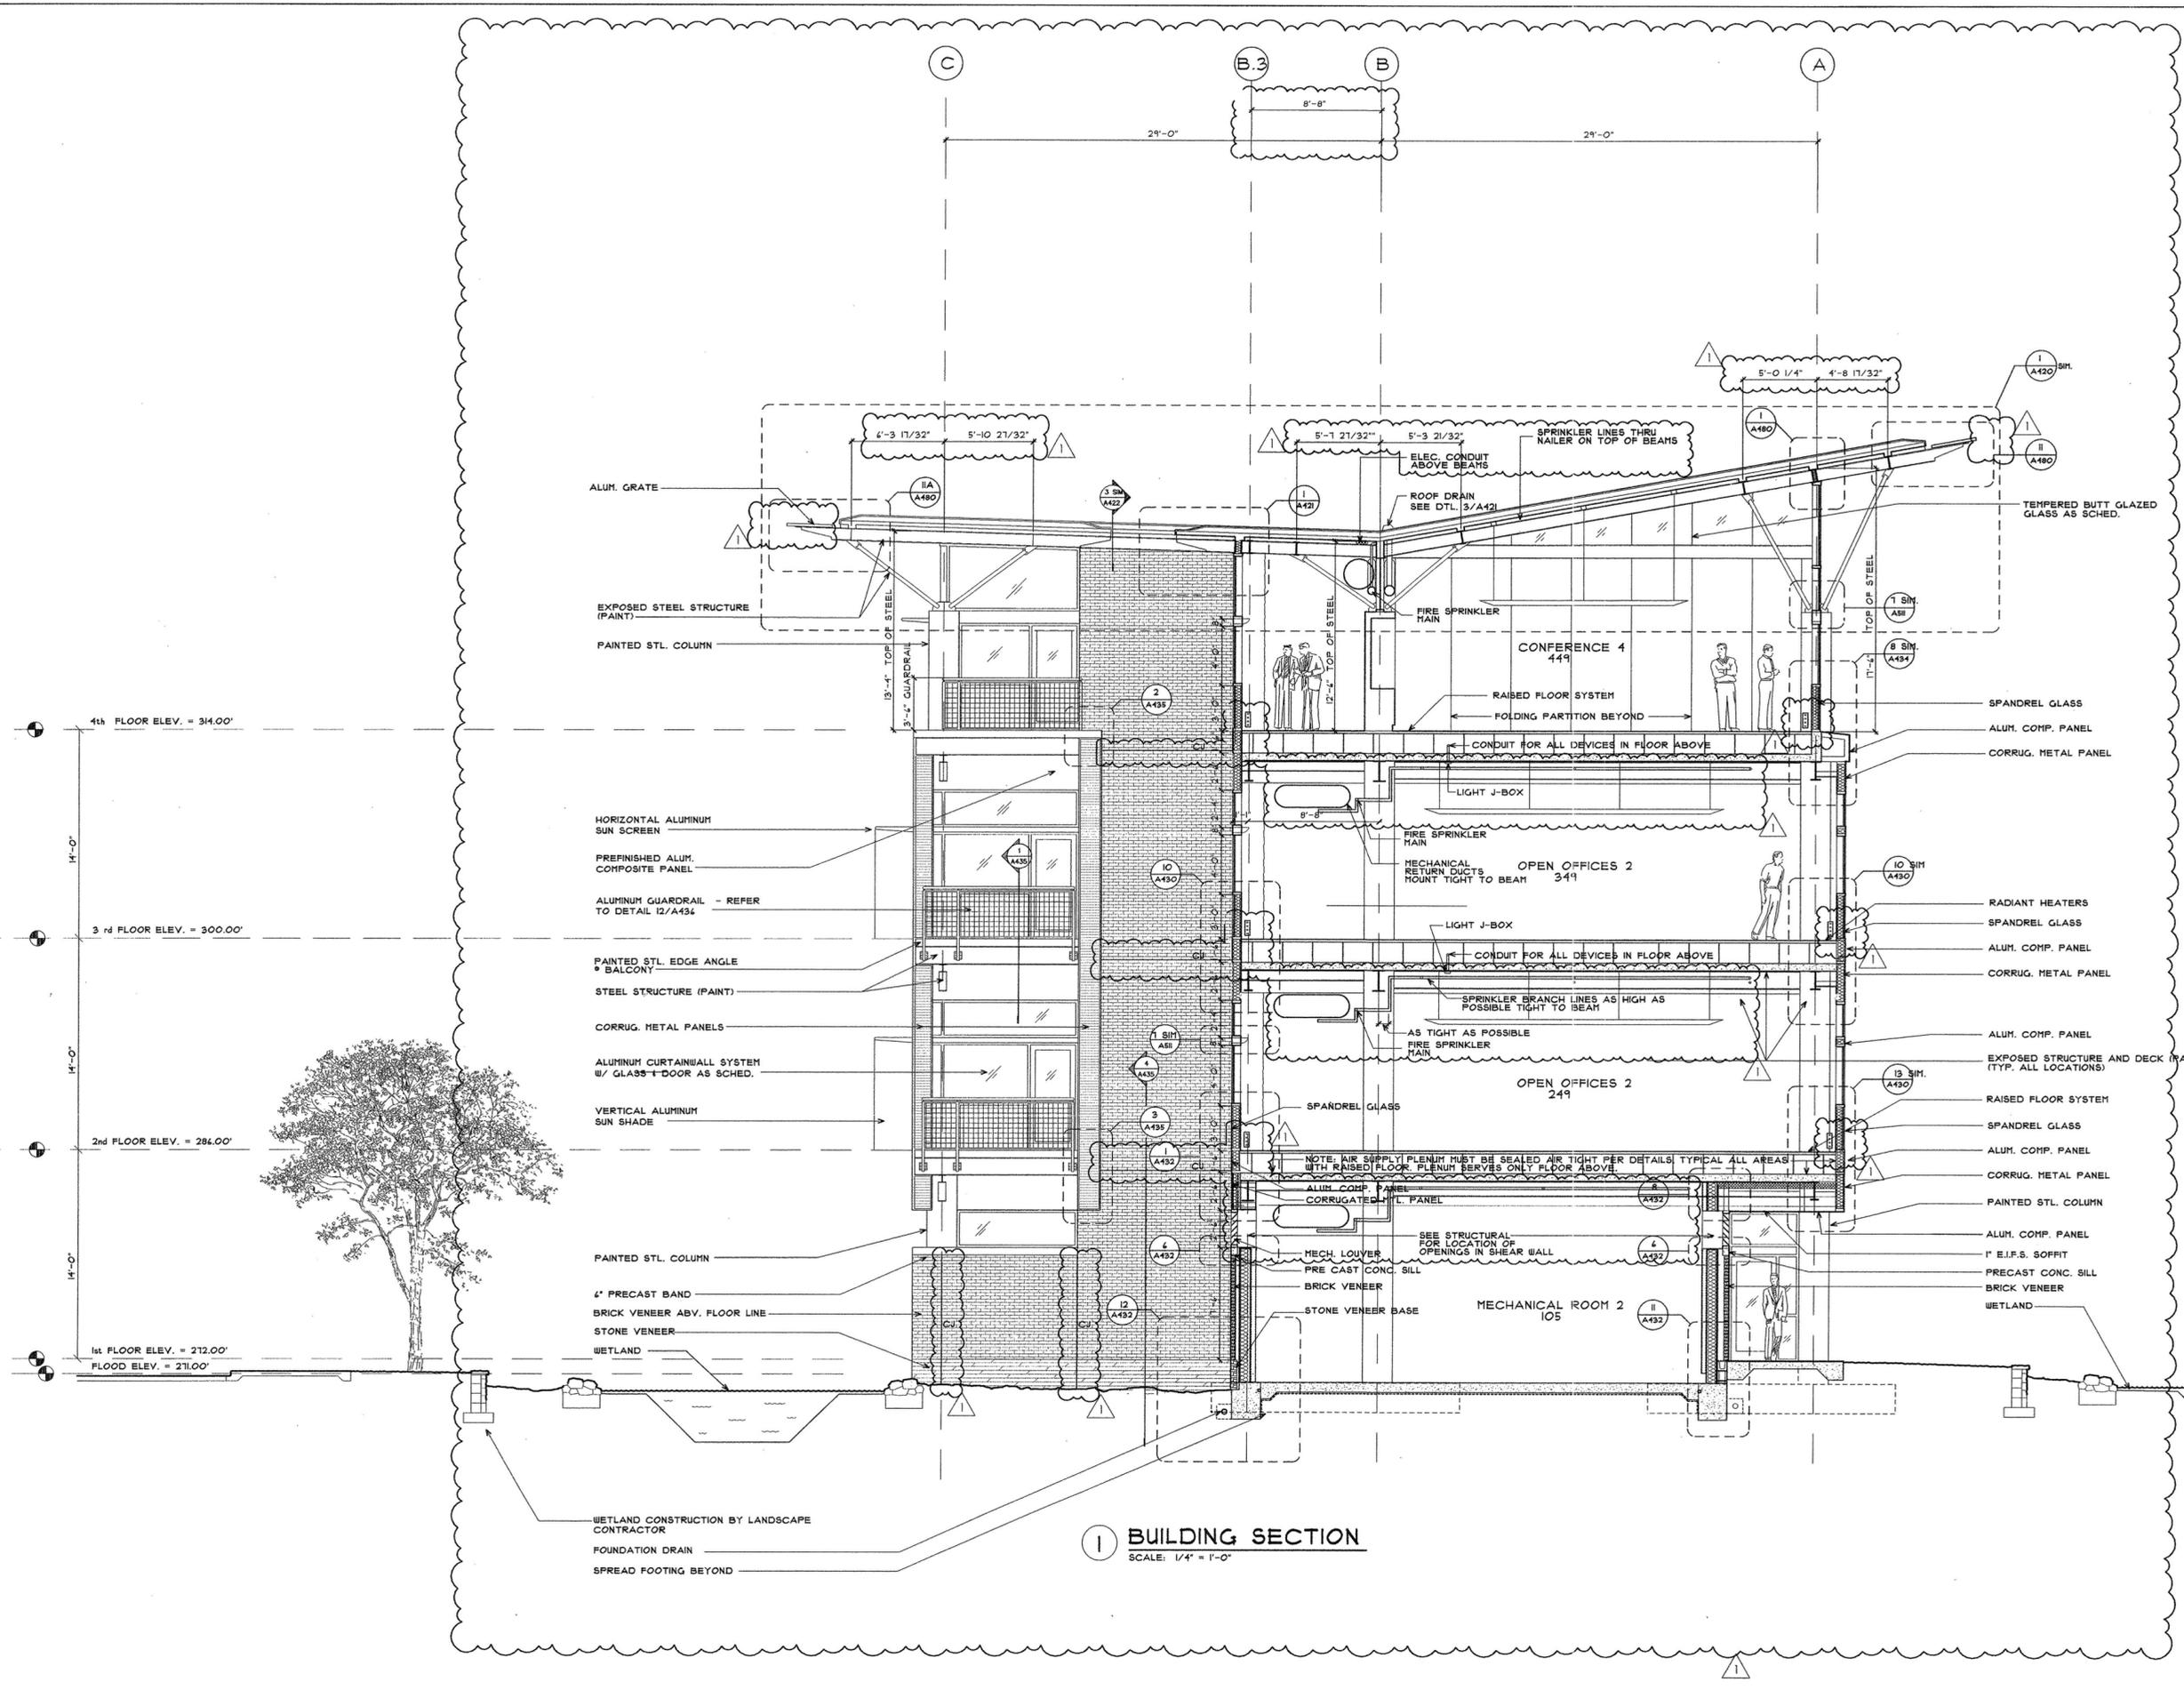

**1 BUILDING SECTION**  
SCALE: 1/4" = 1'-0"