

- CONSULTANTS:**
- OWNER'S PROJECT ADVISOR:
MOSES TUCKER REAL ESTATE, INC.
 - CIVIL ENGINEER:
MCLELLAND ENGINEERS
 - LANDSCAPE ARCHITECT:
LARSON BURNS SMITH
 - STRUCTURAL ENGINEER:
CROMWELL ENGINEERS INC.
 - MECH., ELEC., PLUMB. ENGINEER:
CROMWELL ENGINEERS INC.
 - SUSTAINABLE CONSULTANT:
BNIM / ELEMENTS
 - GLOBAL VILLAGE CONSULTANT
CAMBRIDGE SEVEN ASSOCIATES
 - INTERIOR DESIGNER:
POLK STANLEY YEARY
 - GENERAL CONTRACTOR:
CDI CONTRACTORS, INC.

GENERAL NOTES:

NOTES:

ISSUE DATE:
100% GMP
PACKAGE #6
FEBRUARY 2, 2004

REVISIONS:

#	DATE	DESCRIPTION
1	01/04/04	PACKAGE #1


**HEIFER
INTERNATIONAL
OFFICE BUILDING**
LITTLE ROCK, ARKANSAS

PSY PROJECT NUMBER:
431C

CONTENTS:
BUILDING CROSS SECTION

SHEET NUMBER:

A302

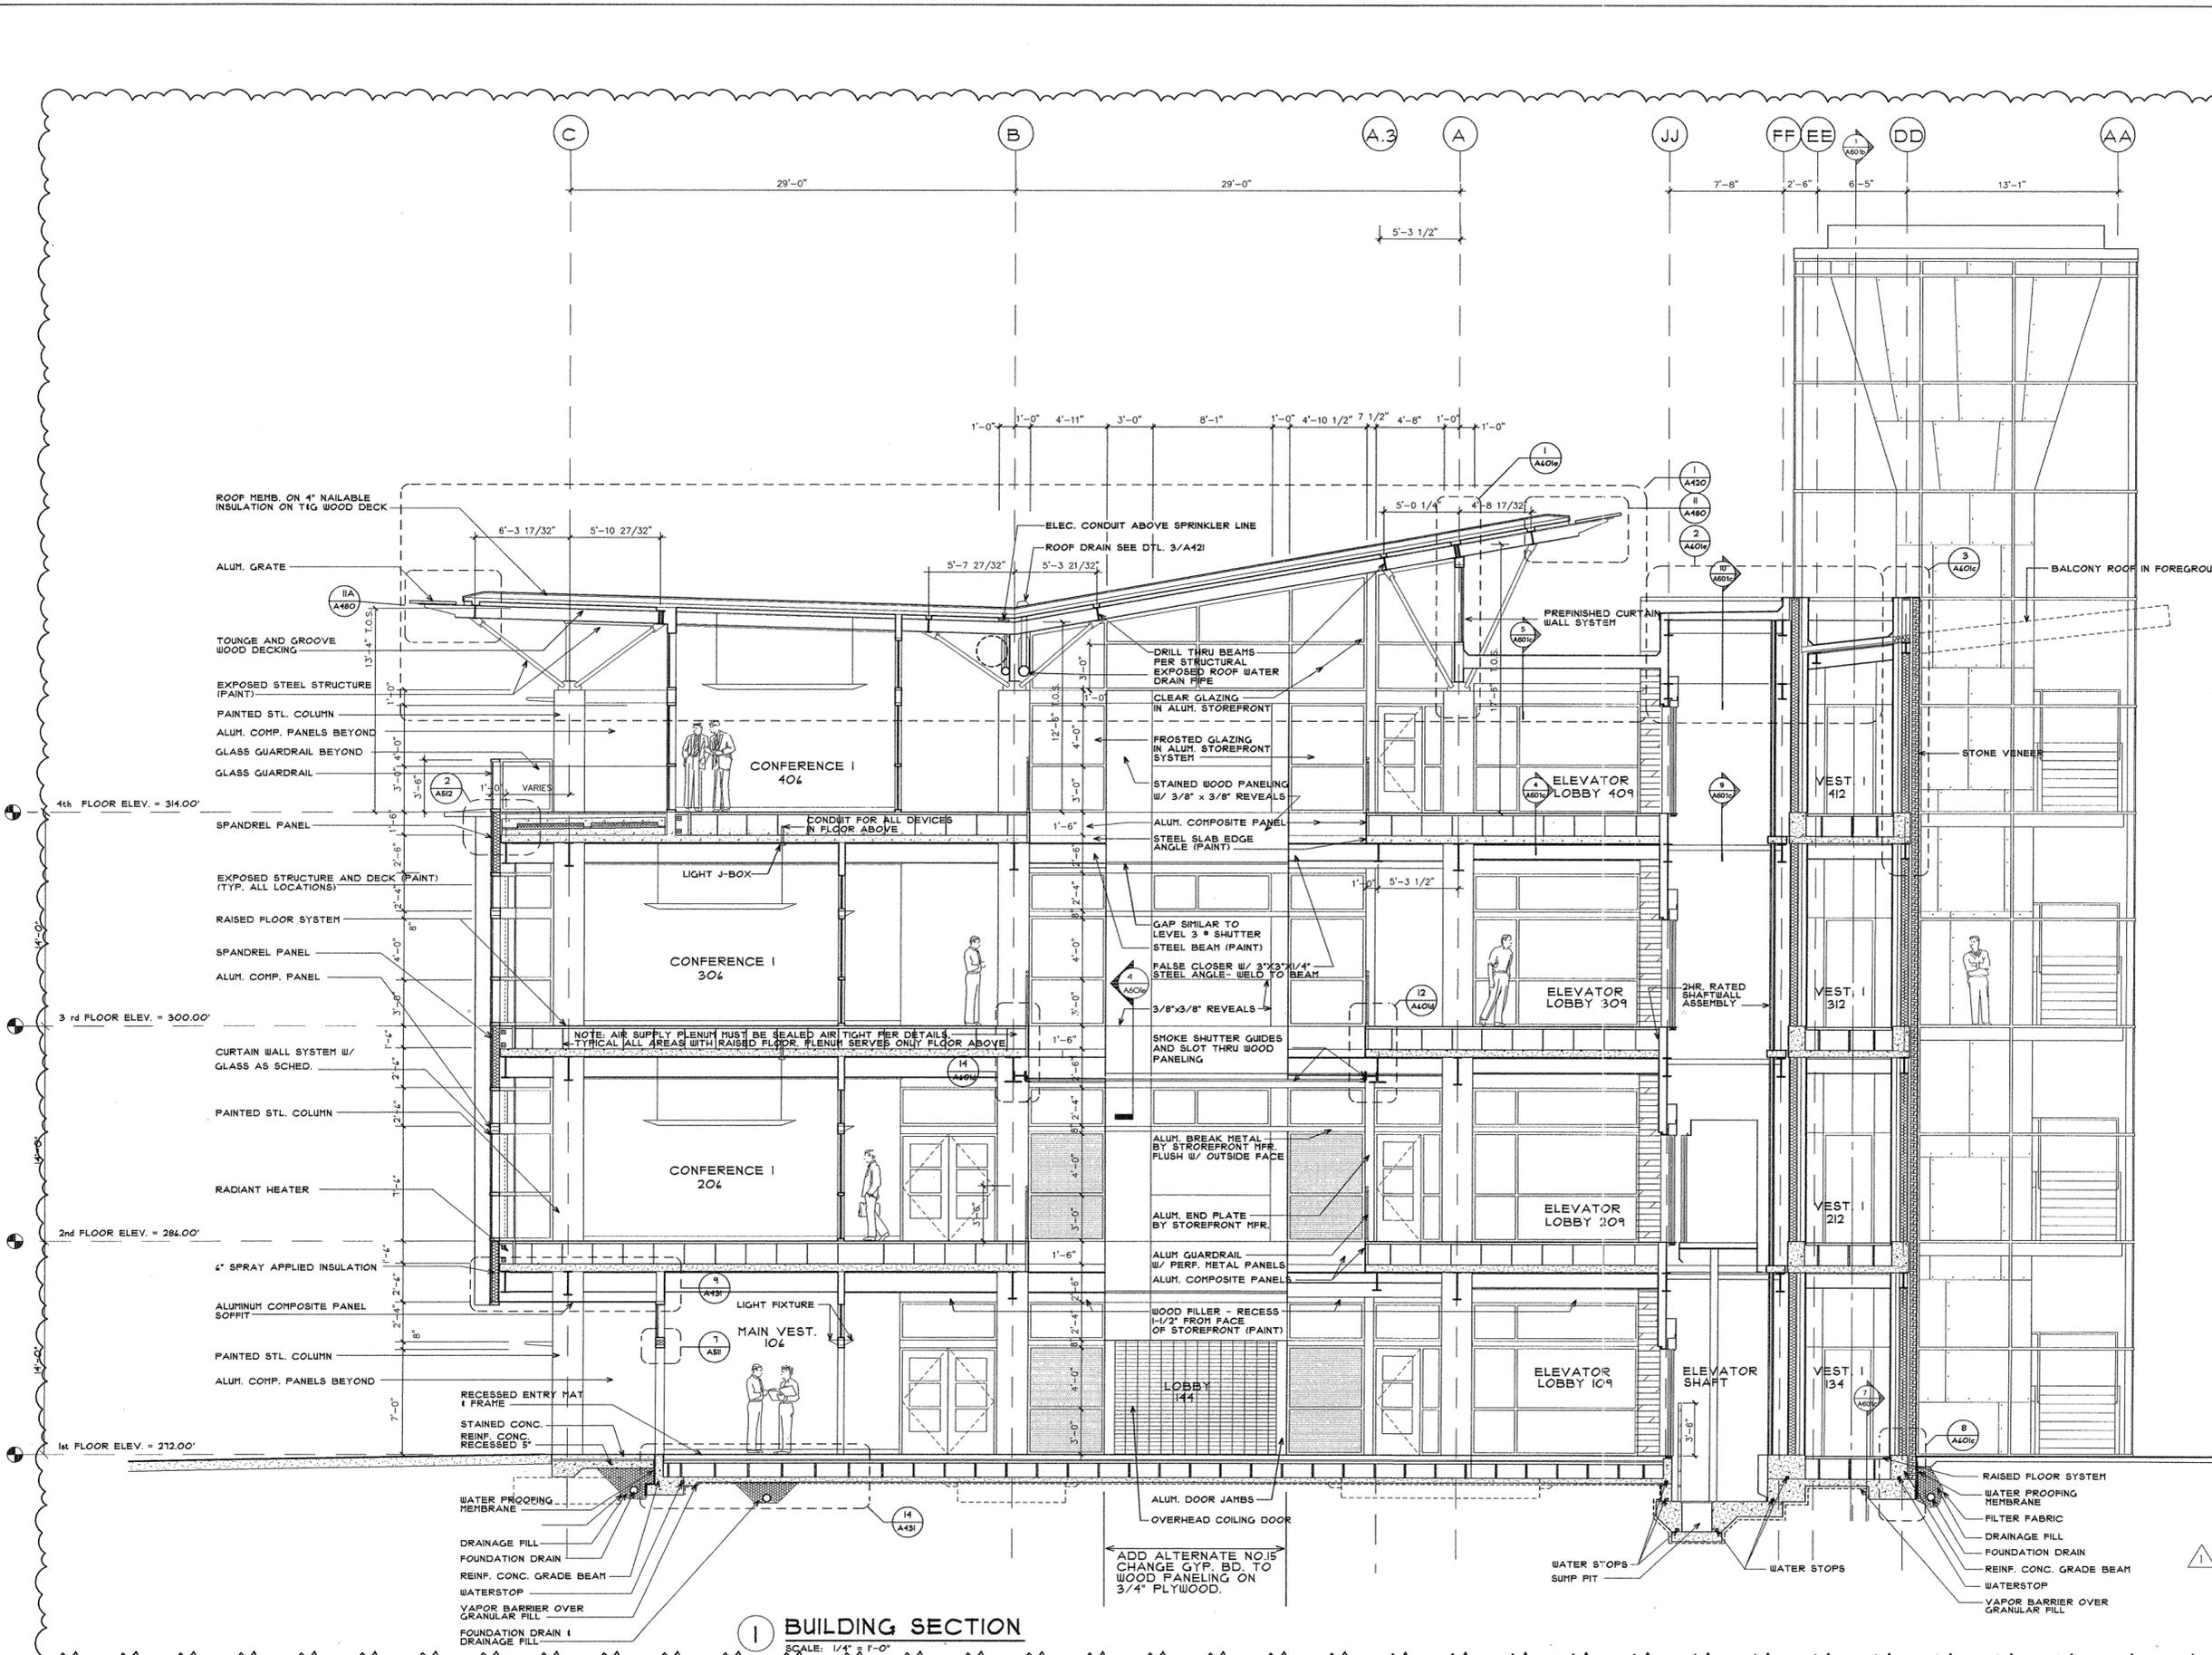

P:\D:\01\A302\A302.dwg
 Titleblock, July 26, 2004