

**CONSULTANTS:**

OWNER'S PROJECT ADVISOR:  
MOSES TUCKER REAL ESTATE, INC.

CIVIL ENGINEER:  
MCLELLAND ENGINEERS

LANDSCAPE ARCHITECT:  
LARSON BURNS SMITH

STRUCTURAL ENGINEER:  
CROMWELL ENGINEERS INC.

MECH., ELEC., PLUMB. ENGINEER:  
CROMWELL ENGINEERS INC.

SUSTAINABLE CONSULTANT:  
BNIM / ELEMENTS

GLOBAL VILLAGE CONSULTANT  
CAMBRIDGE SEVEN ASSOCIATES

INTERIOR DESIGNER:  
POLK STANLEY YEARY

GENERAL CONTRACTOR:  
CDI CONTRACTORS, INC.

**GENERAL NOTES:**

**NOTES:**

ISSUE DATE:  
100% GMP  
PACKAGE #6  
FEBRUARY 2, 2004

**REVISIONS:**

#	DATE	DESCRIPTION
1	01/07/04	PACKAGE 1


**HEIFER  
INTERNATIONAL  
CENTER  
OFFICE BUILDING**  
LITTLE ROCK, ARKANSAS

PSY PROJECT NUMBER:  
431C

CONTENTS:  
**BUILDING CROSS SECTION**

SHEET NUMBER:

**A304**

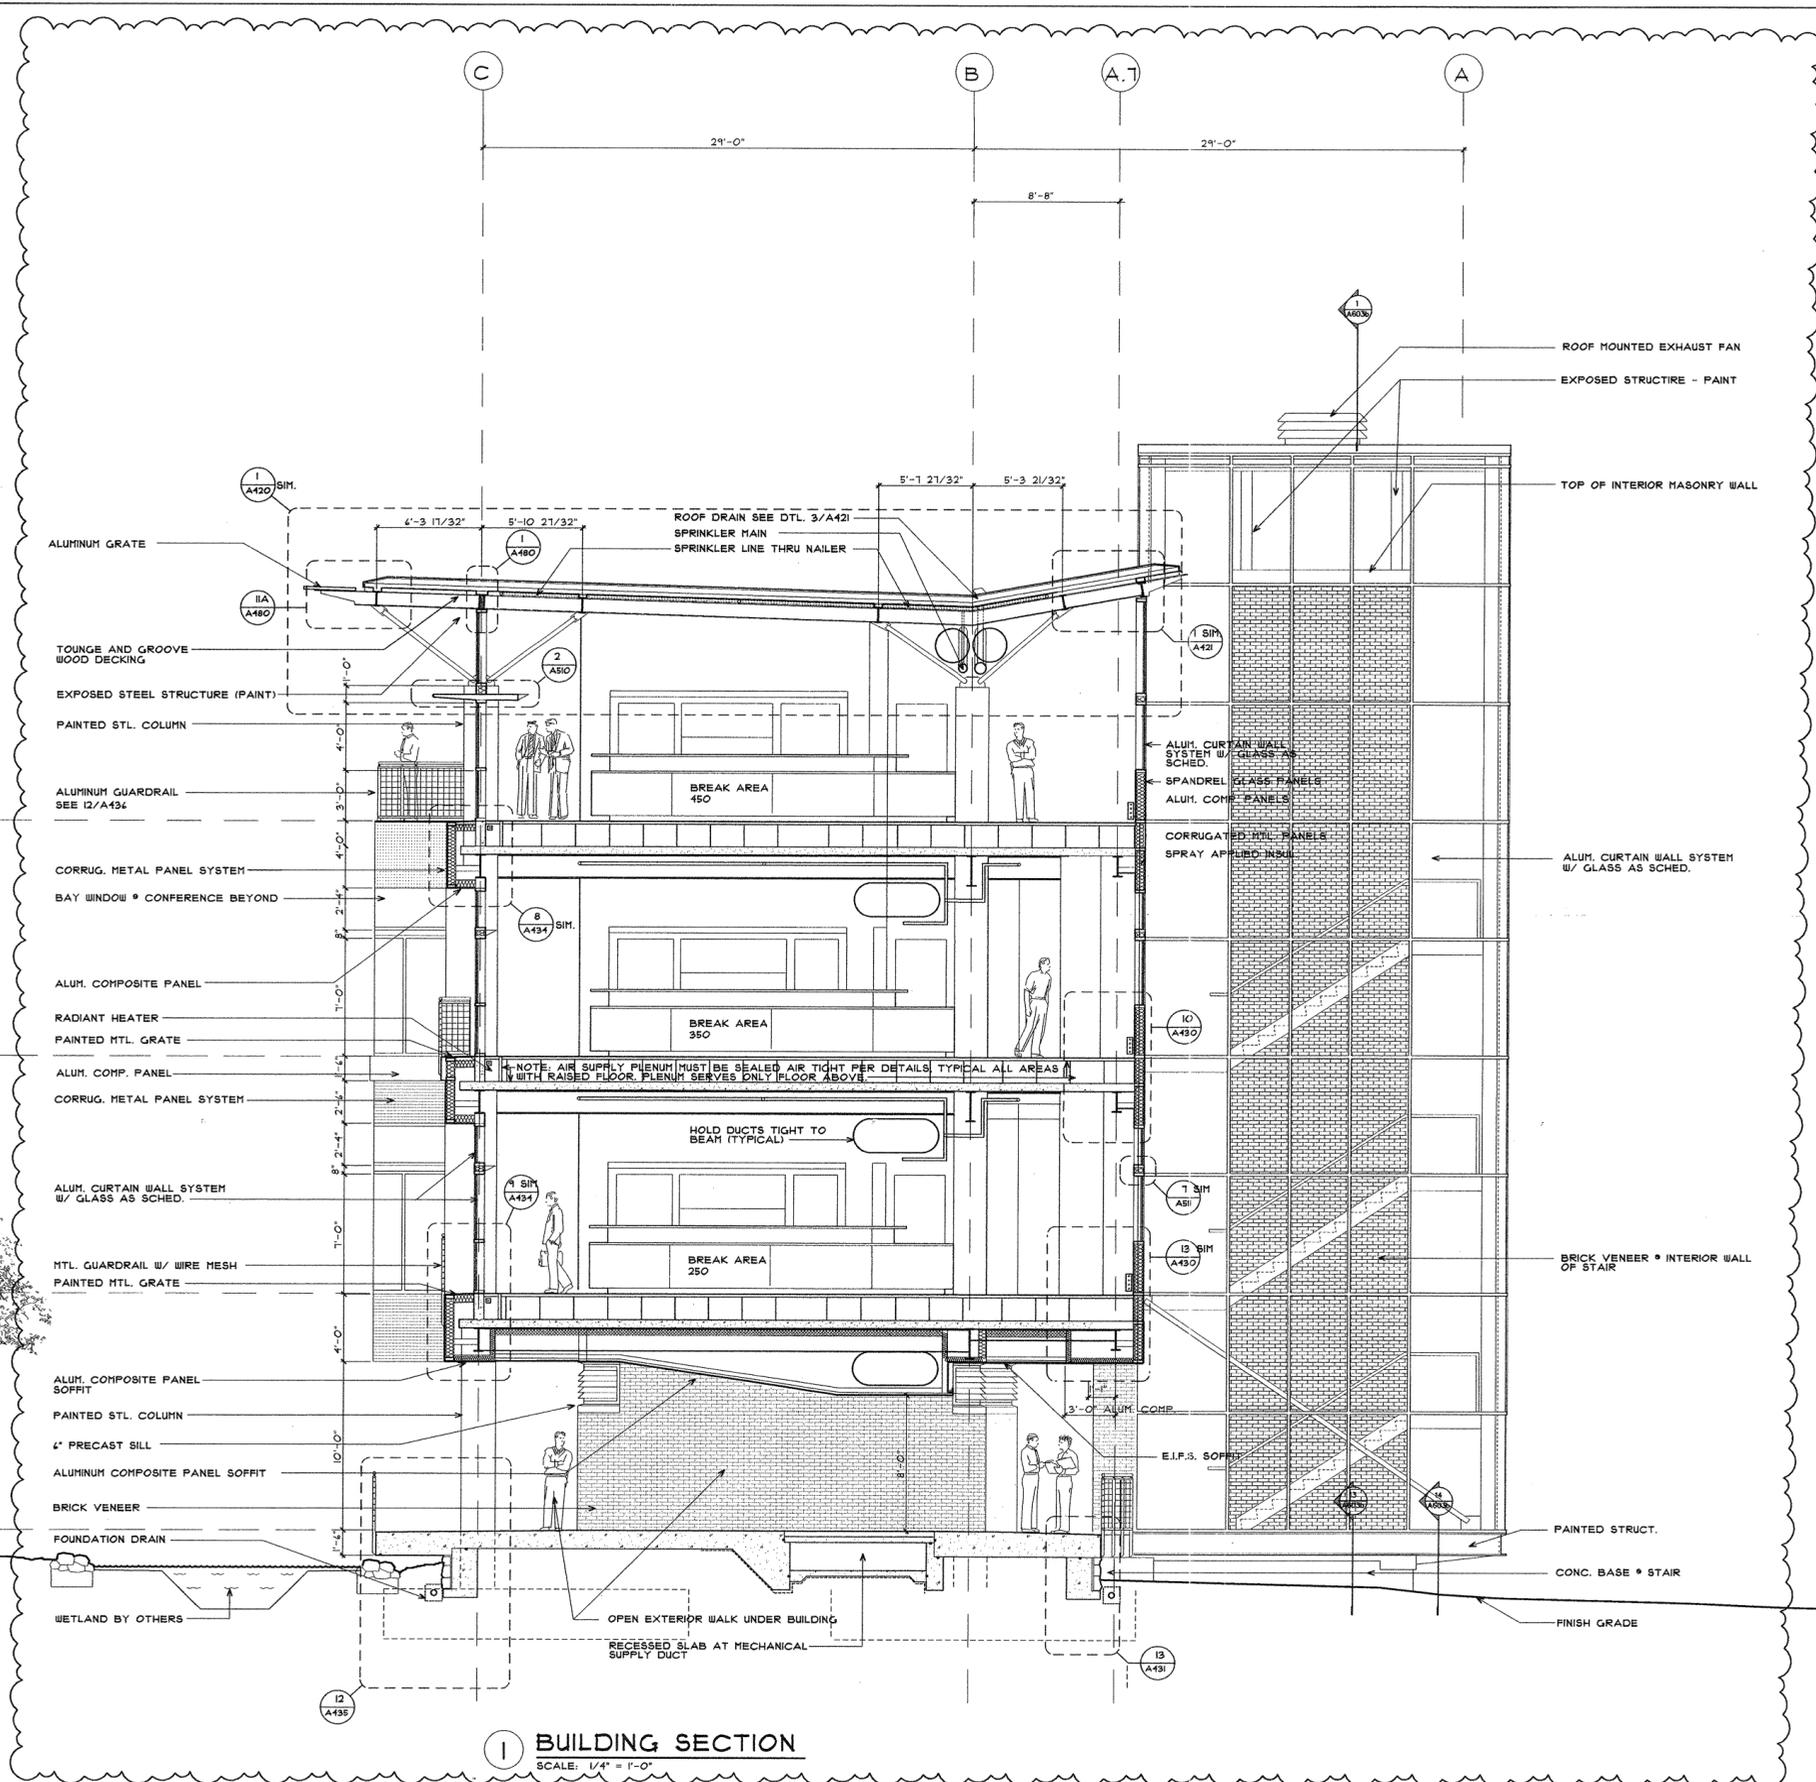

**1 BUILDING SECTION**  
SCALE: 1/4" = 1'-0"