

**POLK
STANLEY
YEARY
ARCHITECTS, LTD.**

700 SOUTH SCHILLER
LITTLE ROCK, AR 72201
501 378-0878
FAX 372-7629
21 W. MOUNTAIN, SUITE 227
FAYETTEVILLE, AR 72701
479-444-0473

CONSULTANTS:

OWNER'S PROJECT ADVISOR:
MOSES TUCKER REAL ESTATE, INC.
CIVIL ENGINEER:
McCLELLAND ENGINEERS
LANDSCAPE ARCHITECT:
LARSON BURNS SMITH
STRUCTURAL ENGINEER:
CROMWELL ENGINEERS INC.
MECH., ELEC., PLUMB. ENGINEER:
CROMWELL ENGINEERS INC.
SUSTAINABLE CONSULTANT:
BNM / ELEMENTS
GLOBAL VILLAGE CONSULTANT
CAMBRIDGE SEVEN ASSOCIATES
INTERIOR DESIGNER:
POLK STANLEY YEARY
GENERAL CONTRACTOR:
CDI

GENERAL NOTES:

NOTES:

ISSUE DATE:
100% GMP
PACKAGE #6
FEBRUARY 2, 2004

REVISIONS:

DATE	DESCRIPTION
10/04/04	PACKAGE 1

**HEIFER
INTERNATIONAL
CENTER
OFFICE BUILDING**
LITTLE ROCK, ARKANSAS


PSY PROJECT NUMBER:
431C




CONTENTS:
SECTION DETAILS

SHEET NUMBER:


A431

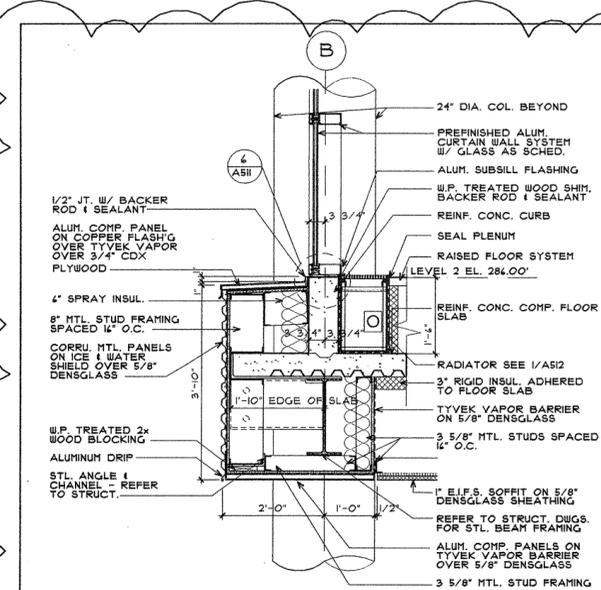


1 SECTION DETAIL
SCALE: 3/4" = 1'-0"

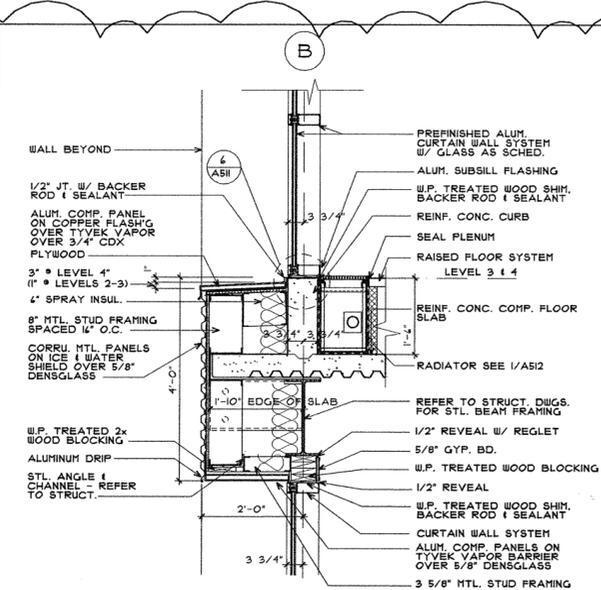


2 SECTION DETAIL
SCALE: 3/4" = 1'-0"

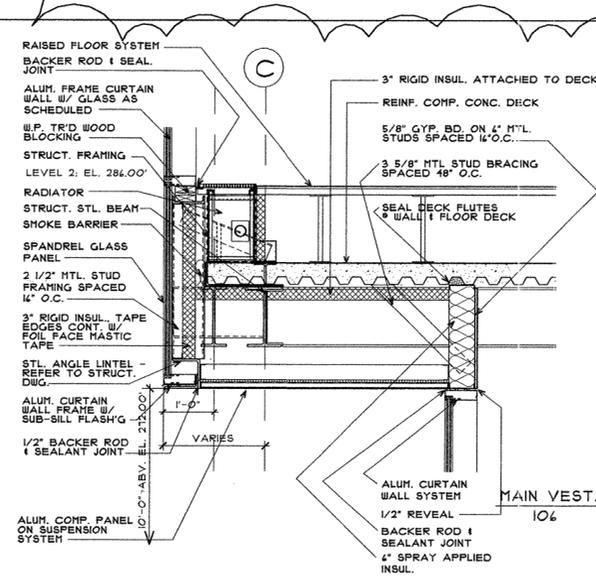


9 SECTION DETAIL
SCALE: 3/4" = 1'-0"

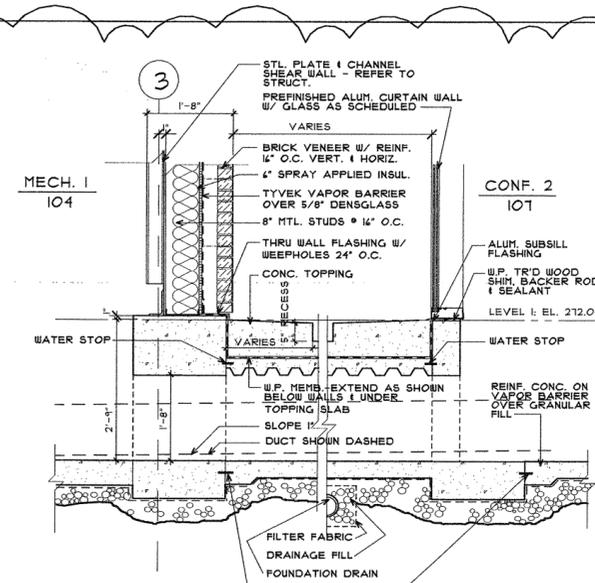


10 SECTION DETAIL
SCALE: 3/4" = 1'-0"

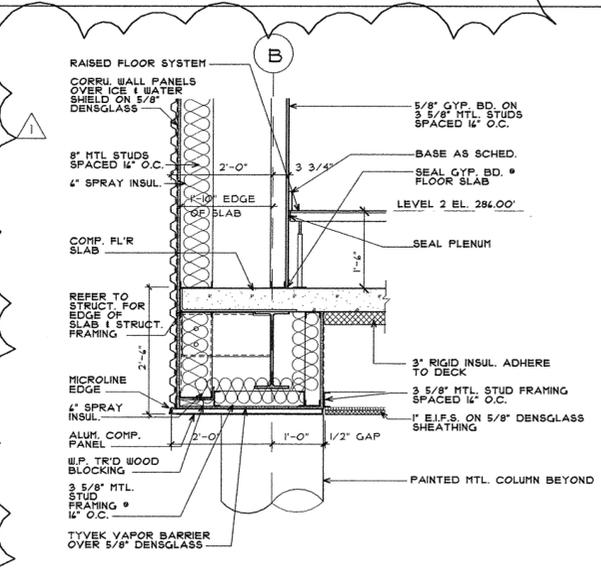

12 SECTION DETAIL
SCALE: 3/4" = 1'-0"

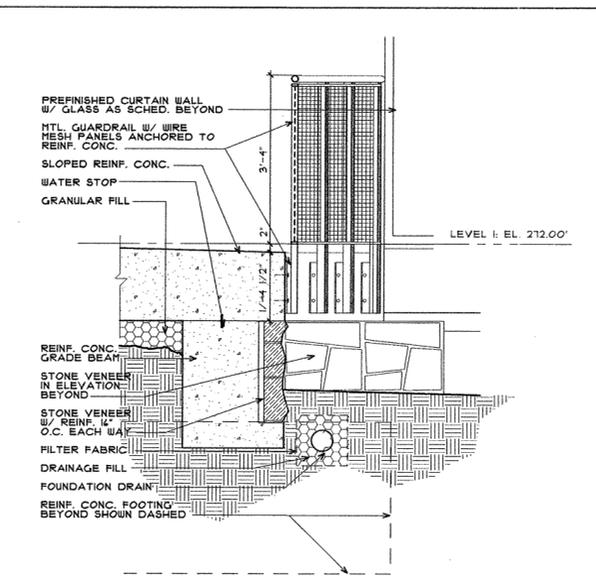

13 SECTION DETAIL
SCALE: 3/4" = 1'-0"

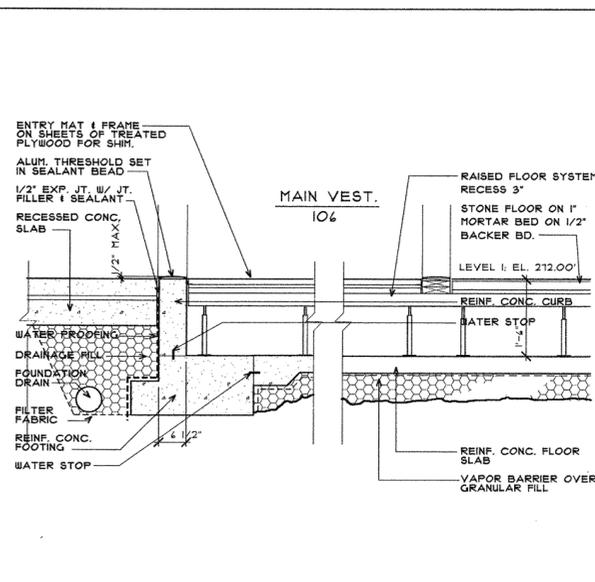

14 SECTION DETAIL
SCALE: 3/4" = 1'-0"

P:\CD-010\1431\CD\1431.dwg (P:\CD-010\1431\1431.dwg) 2/2 1/2 1/2