

CONSULTANTS:  
OWNER'S PROJECT ADVISOR:  
MOSES TUCKER REAL ESTATE, INC.

CIVIL ENGINEER:  
MCLELLAND ENGINEERS  
LANDSCAPE ARCHITECT:  
LARSON BURNS SMITH  
STRUCTURAL ENGINEER:  
CROMWELL ENGINEERS INC.  
MECH., ELEC., PLUMB. ENGINEER:  
CROMWELL ENGINEERS INC.  
SUSTAINABLE CONSULTANT:  
BNIM / ELEMENTS  
GLOBAL VILLAGE CONSULTANT  
CAMBRIDGE SEVEN ASSOCIATES  
INTERIOR DESIGNER:  
POLK STANLEY YEARY  
GENERAL CONTRACTOR:  
CDI CONTRACTORS, INC.

GENERAL NOTES:

NOTES:

ISSUE DATE:  
CORE/SHELL  
PACKAGE #5  
DECEMBER 15, 2003

REVISIONS:

#	DATE	DESCRIPTION
1	04/04/04	PACKAGE #1


**HEIFER  
INTERNATIONAL  
CENTER  
OFFICE BUILDING**  
LITTLE ROCK, ARKANSAS

PSY PROJECT NUMBER:  
431C



CONTENTS:  
WINDOW SCHEDULE  
SCALE 1/4" = 1'-0"  
SHEET NUMBER:

**A504a**

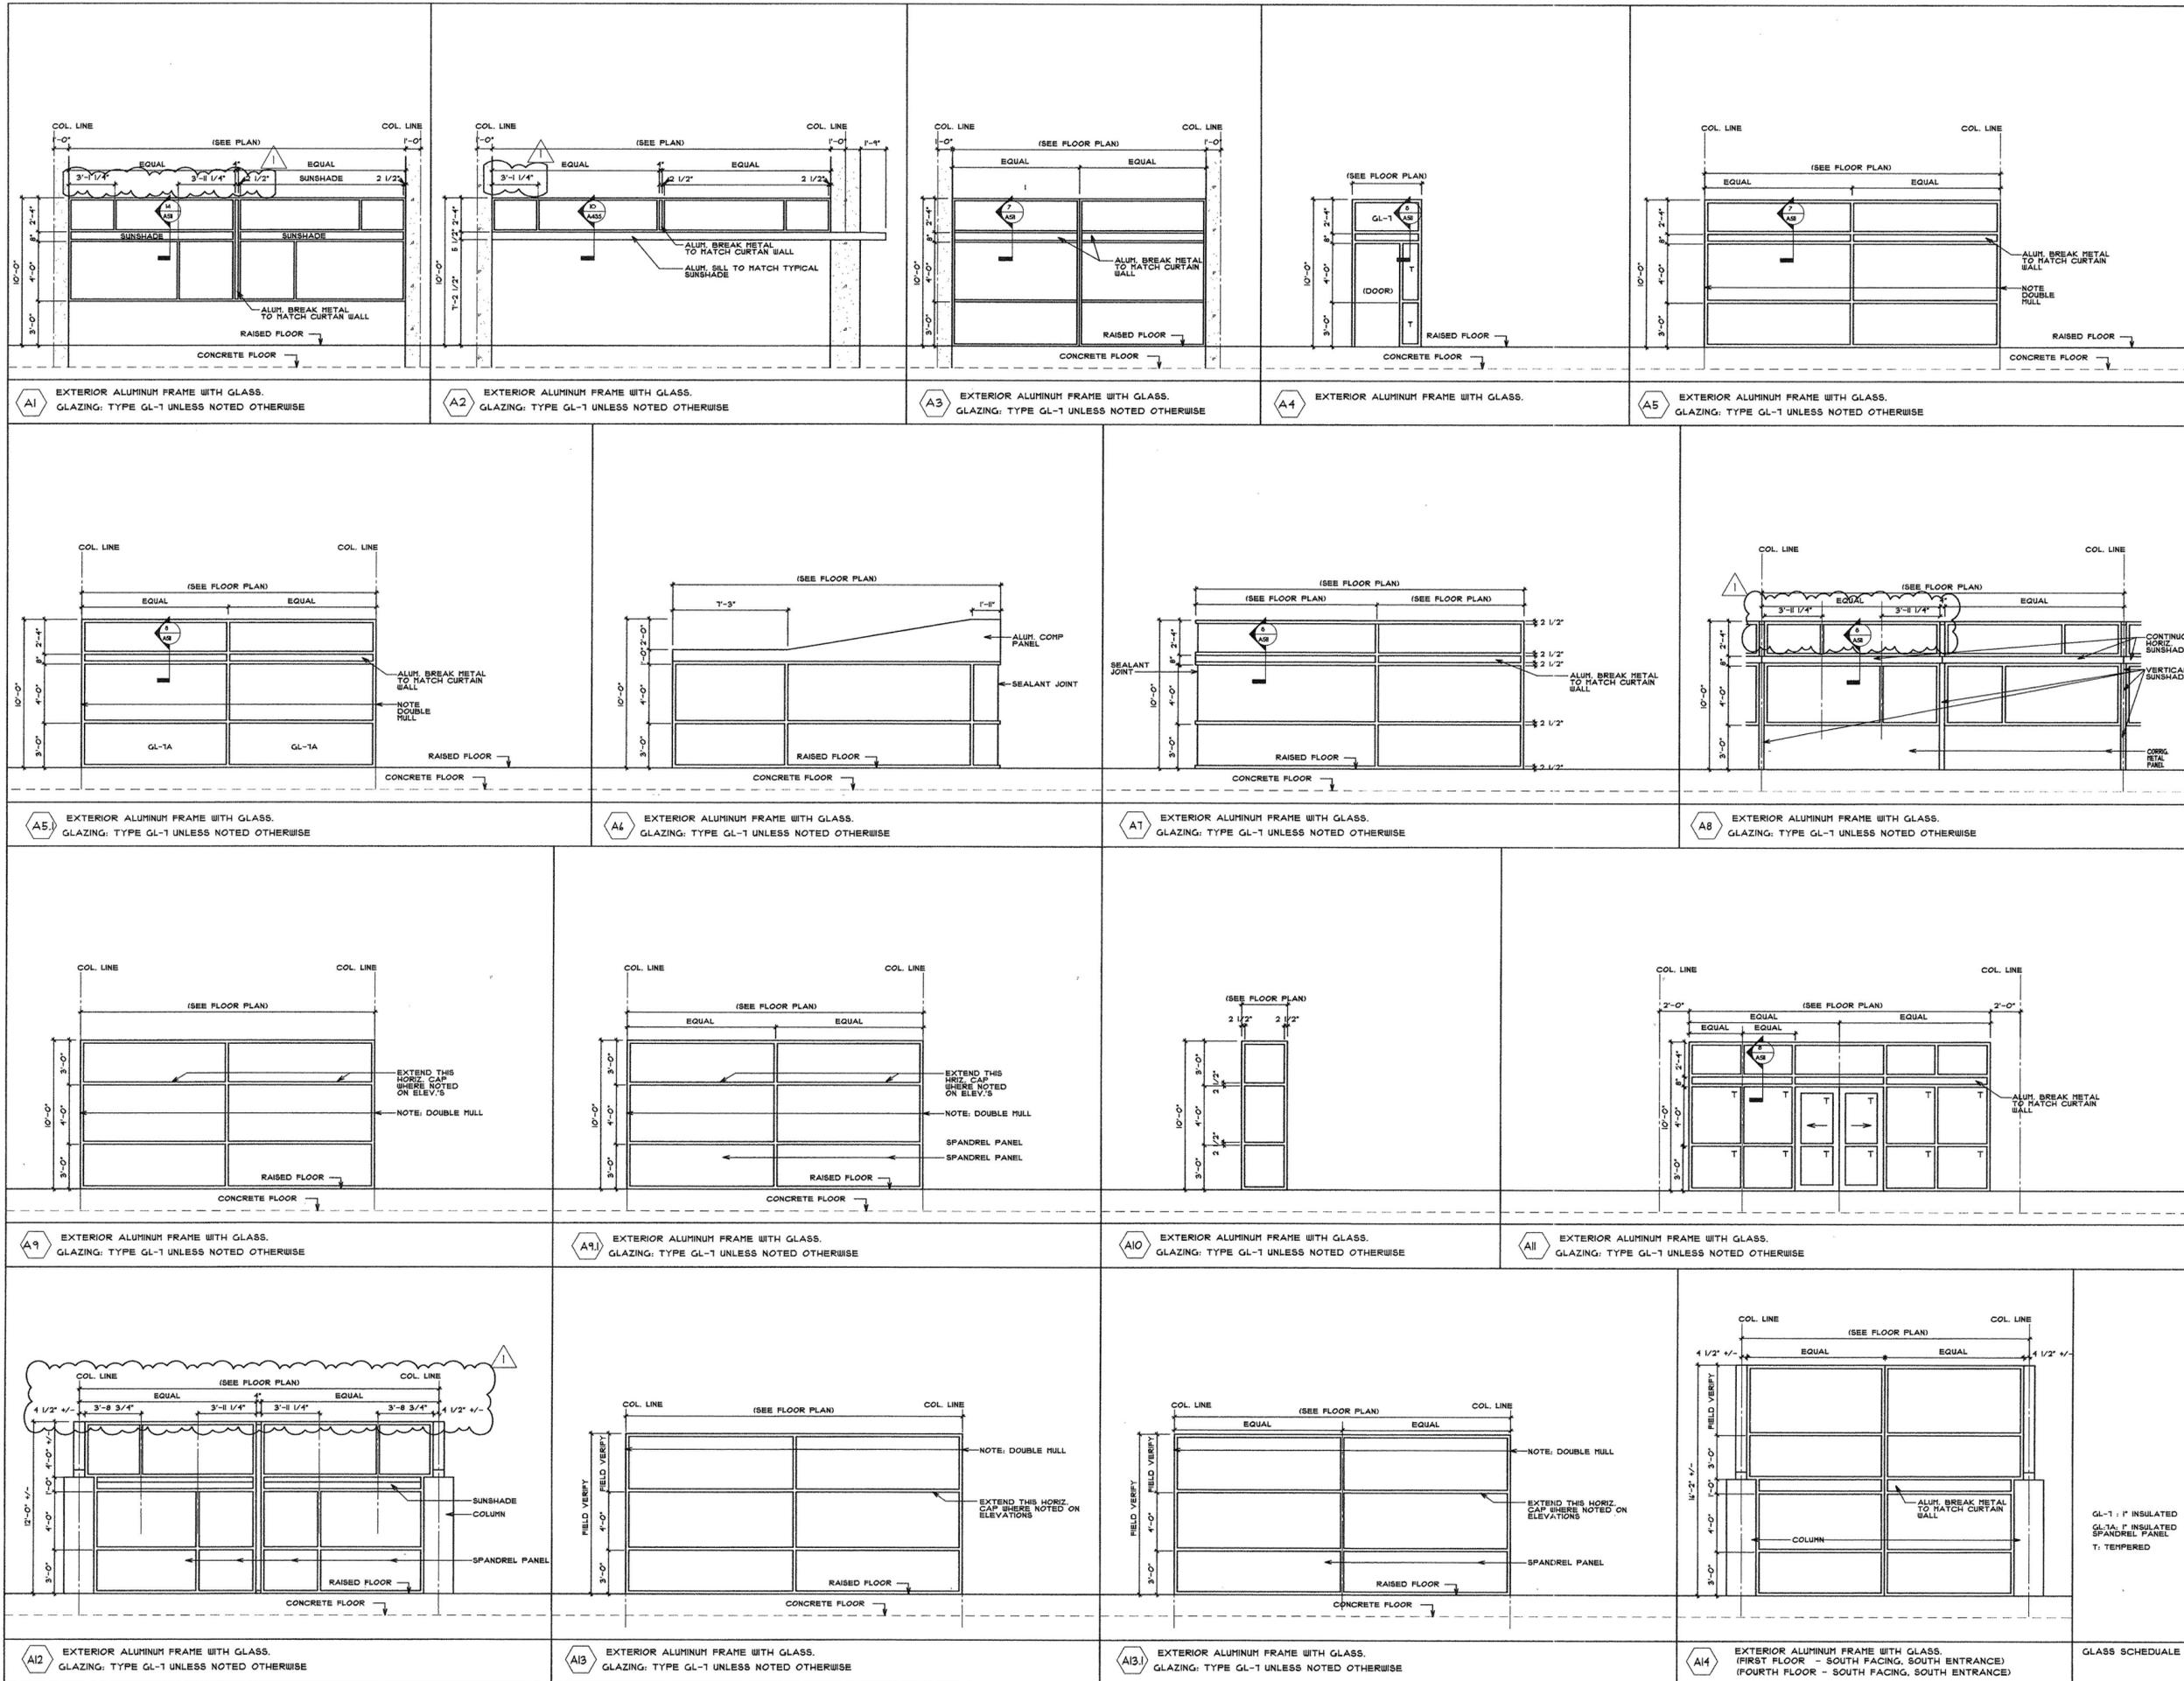

P:\0-DWG\A504a\A504a.dwg  
 Friday, June 18, 2004 3:41 PM