

CONSULTANTS:

OWNER'S PROJECT ADVISOR:
MOSES TUCKER REAL ESTATE, INC.
CIVIL ENGINEER:
McCLELLAND ENGINEERS
LANDSCAPE ARCHITECT:
LARSON BURNS SMITH
STRUCTURAL ENGINEER:
CROMWELL ENGINEERS INC.
MECH., ELEC., PLUMB. ENGINEER:
CROMWELL ENGINEERS INC.
SUSTAINABLE CONSULTANT:
BNIM / ELEMENTS
GLOBAL VILLAGE CONSULTANT
CAMBRIDGE SEVEN ASSOCIATES

INTERIOR DESIGNER:
POLK STANLEY YEARY
GENERAL CONTRACTOR:
CDI

GENERAL NOTES:

NOTES:

ISSUE DATE:
CONSTRUCTION DOCUMENTS
PACKAGE #5
DECEMBER 15, 2003

REVISIONS:


#	DATE	DESCRIPTION
1	04/01/04	PACKAGE 1

**HEIFER
INTERNATIONAL
CENTER
OFFICE BUILDING**
LITTLE ROCK, ARKANSAS


PSY PROJECT NUMBER:
431C

CONTENTS:
DETAILS @ ALUM.
CURTAIN WALL
SHEET NUMBER:


A511

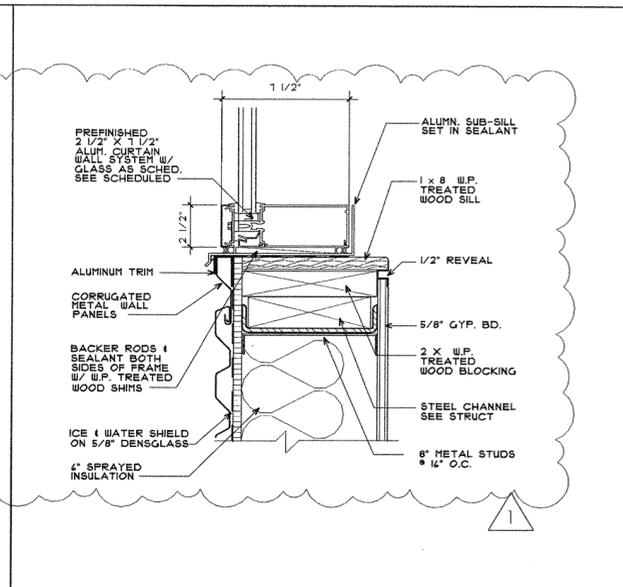


4 DETAIL @ ALUM. CURTAIN WALL SILL
SCALE: 3" = 1'-0"

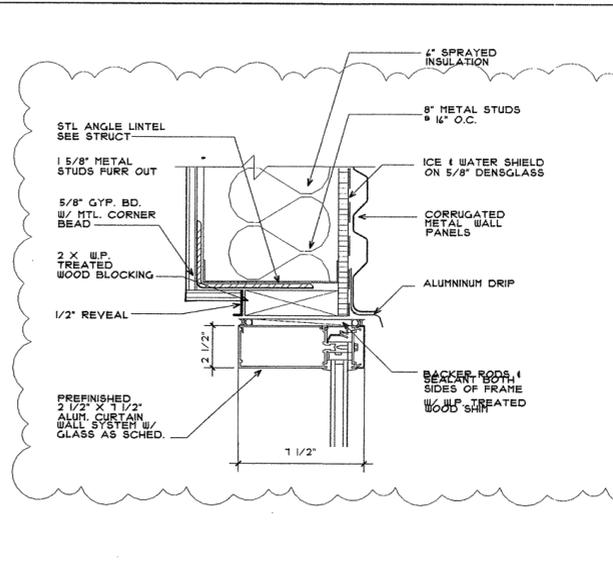


3 DETAIL @ ALUM. CURTAIN WALL HEAD
SCALE: 3" = 1'-0"

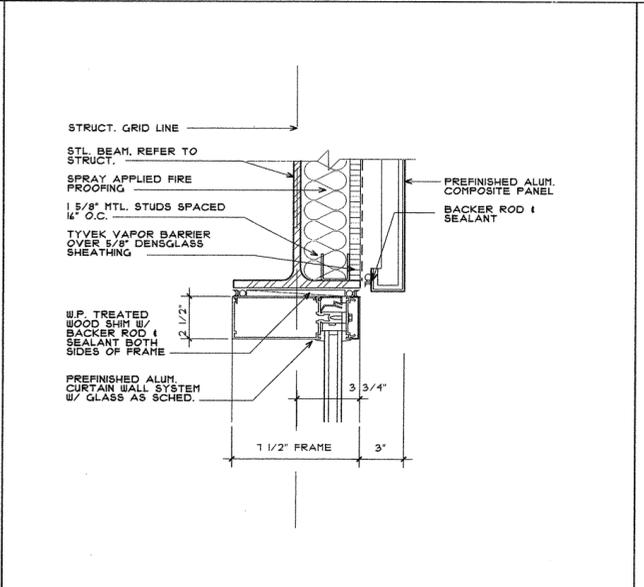


2 DETAIL @ ALUM. CURTAIN WALL HEAD
SCALE: 3" = 1'-0"

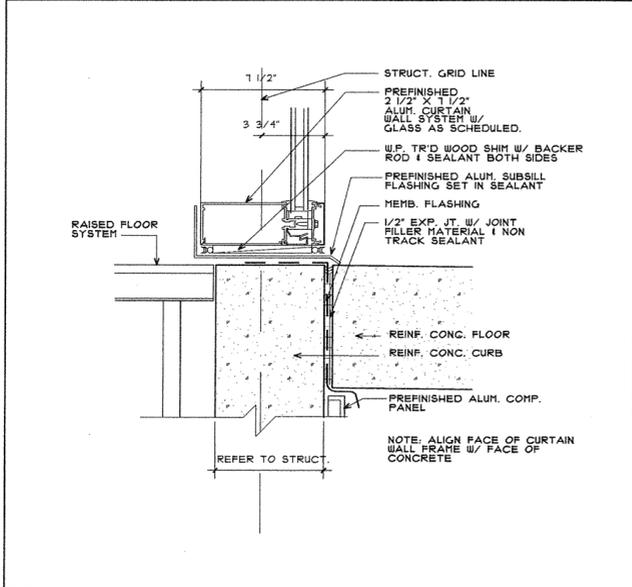


1 DETAIL @ ALUM. CURTAIN WALL SILL
SCALE: 3" = 1'-0"

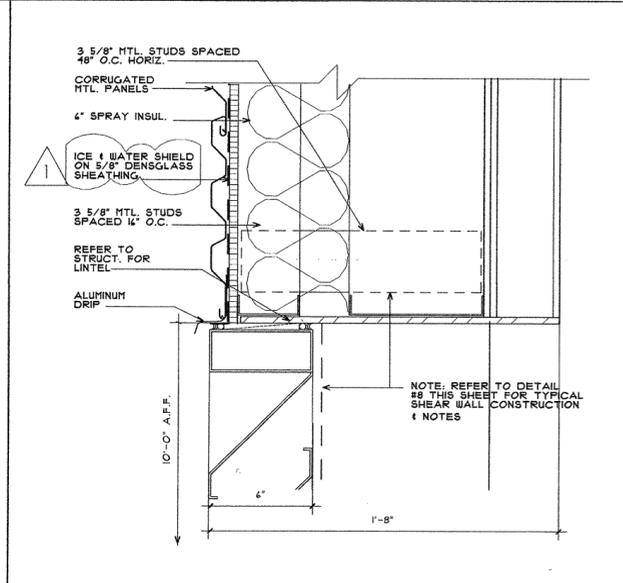


9 DETAIL @ ALUM. LOUVER HEAD
SCALE: 3" = 1'-0"

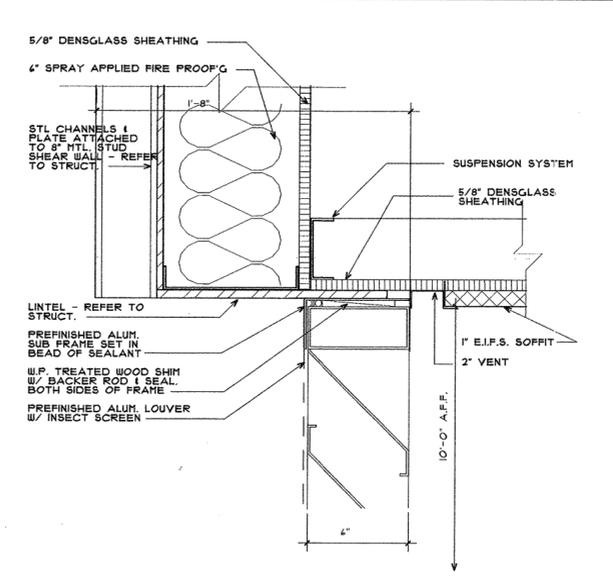


8 DETAIL @ ALUM. LOUVER HEAD
SCALE: 3" = 1'-0"

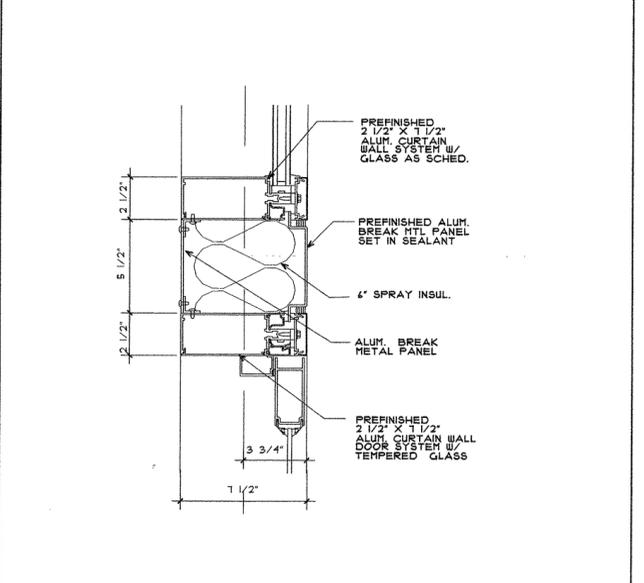


7 DTL. @ ALUM. CURTAIN WALL SILL & DOOR HEAD
SCALE: 3" = 1'-0"

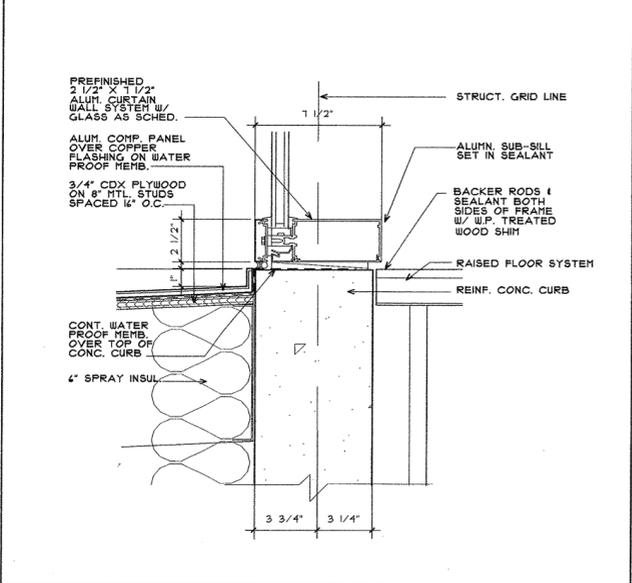


6 DETAIL @ ALUM. CURTAIN WALL SILL
SCALE: 3" = 1'-0"

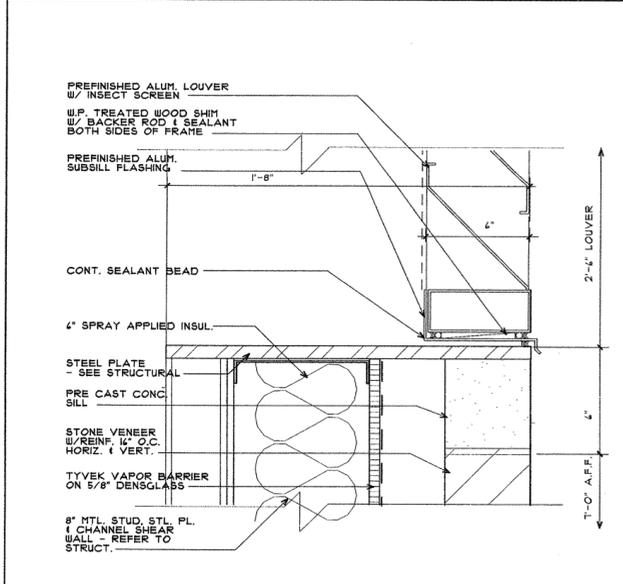


13 DETAIL @ ALUM. LOUVER SILL
SCALE: 3" = 1'-0"

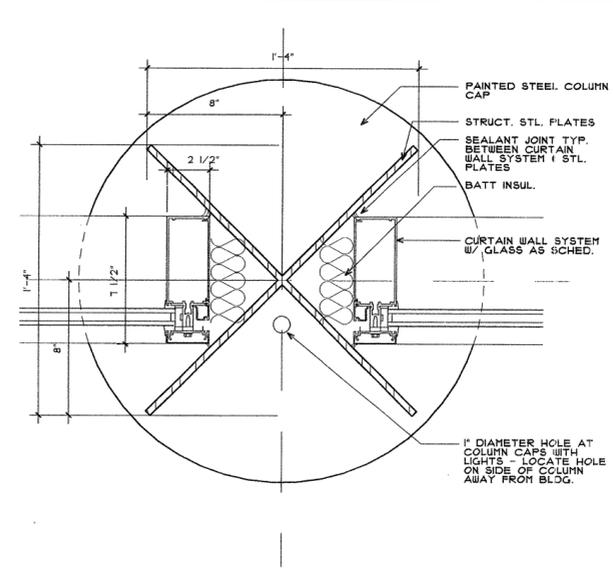

12 DETAIL @ ROOF TREE BASE
SCALE: 3" = 1'-0"

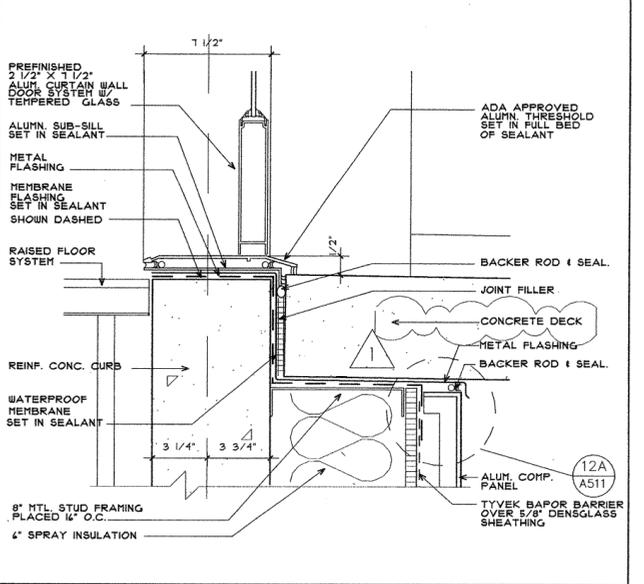

11 DETAIL @ ALUM. CURTAIN WALL DOOR SILL
SCALE: 3" = 1'-0"

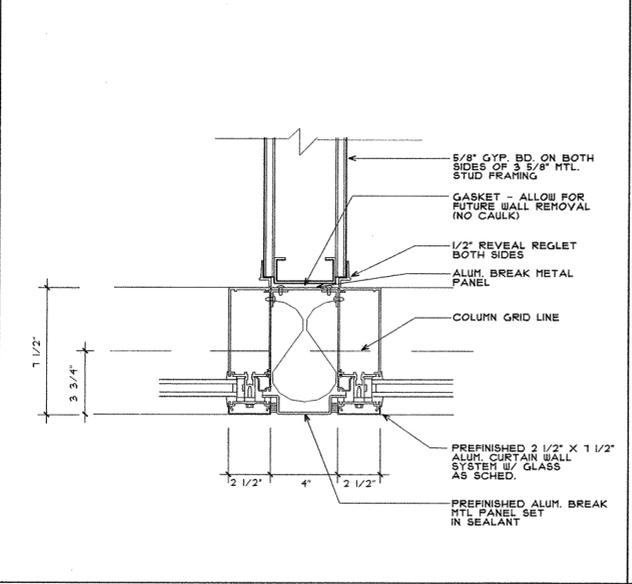

10 DTL. @ ALUM. CURTAIN WALL
SCALE: 3" = 1'-0"