

**POLK  
STANLEY  
YEARY**  
ARCHITECTS, LTD.

700 SOUTH SCHILLER  
LITTLE ROCK, AR 72201  
501.378-0878  
FAX 372-7629  
21 W. MOUNTAIN, SUITE 227  
FAYETTEVILLE, AR 72701  
479-444-0473

**CONSULTANTS:**  
OWNER'S PROJECT ADVISOR:  
MOSES TUCKER REAL ESTATE, INC.  
CIVIL ENGINEER:  
MCLELLAND ENGINEERS  
LANDSCAPE ARCHITECT:  
LARSON BURNS SMITH  
STRUCTURAL ENGINEER:  
CROMWELL ENGINEERS INC.  
MECH. ELEC. PLUMB. ENGINEER:  
CROMWELL ENGINEERS INC.  
SUSTAINABLE CONSULTANT:  
BNIM / ELEMENTS  
GLOBAL VILLAGE CONSULTANT  
CAMBRIDGE SEVEN ASSOCIATES  
INTERIOR DESIGNER:  
POLK STANLEY YEARY  
GENERAL CONTRACTOR:  
CDI

GENERAL NOTES:

NOTES:

ISSUE DATE:  
100% GMP  
PACKAGE #6  
FEBRUARY 2, 2004

REVISIONS:


#	DATE	DESCRIPTION
1	2/02/04	100% G.M.P.
2	02/04	PACKAGE #1

**HEIFER  
INTERNATIONAL  
CENTER  
OFFICE BUILDING**  
LITTLE ROCK, ARKANSAS


PSY PROJECT NUMBER:  
431C

CONTENTS:  
ENLARGED PLANS -  
ELEVATOR CORE & LOBBY  
SHEET NUMBER:

**A601**

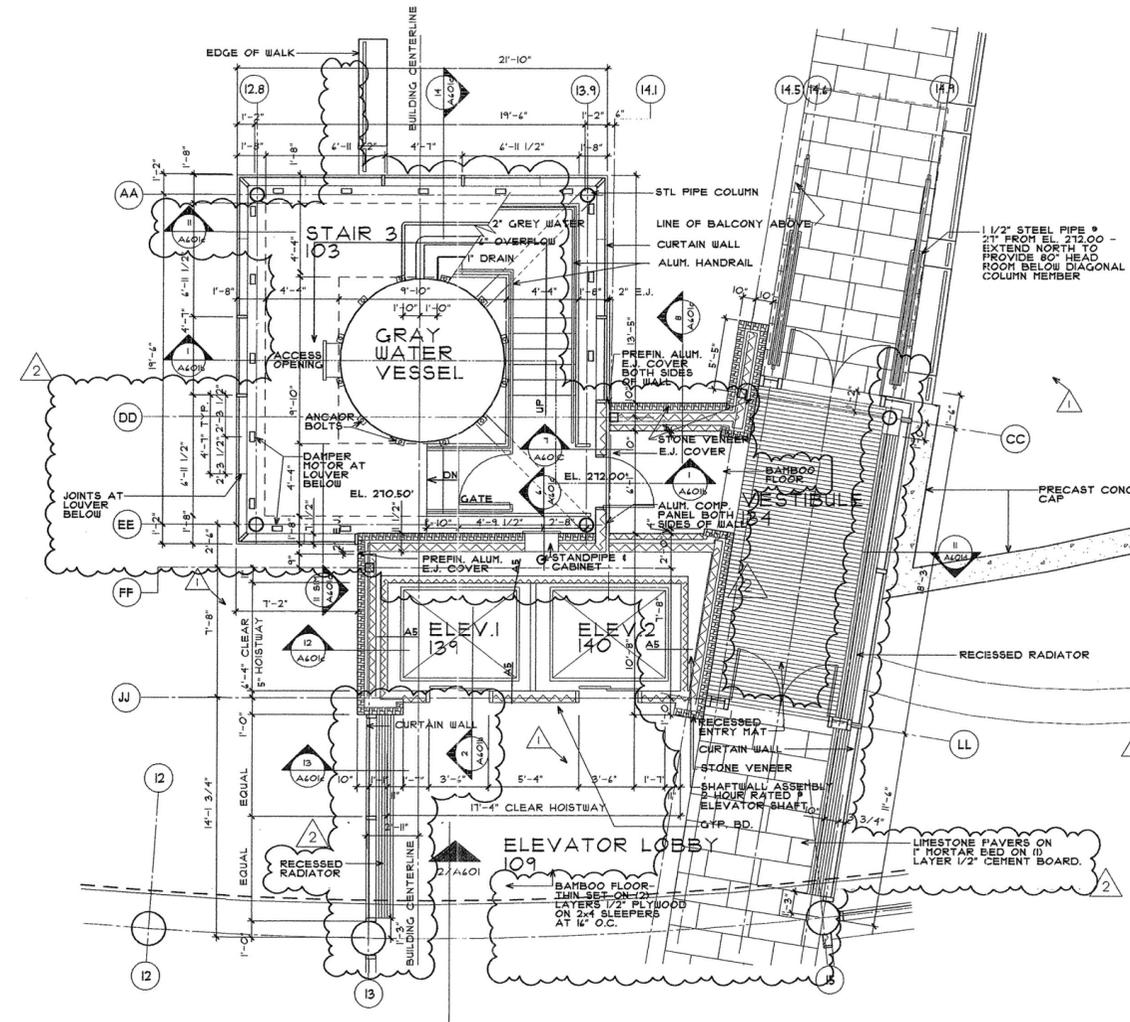


**4 LEVEL I - CORE**  
SCALE: 1/4" = 1'-0"

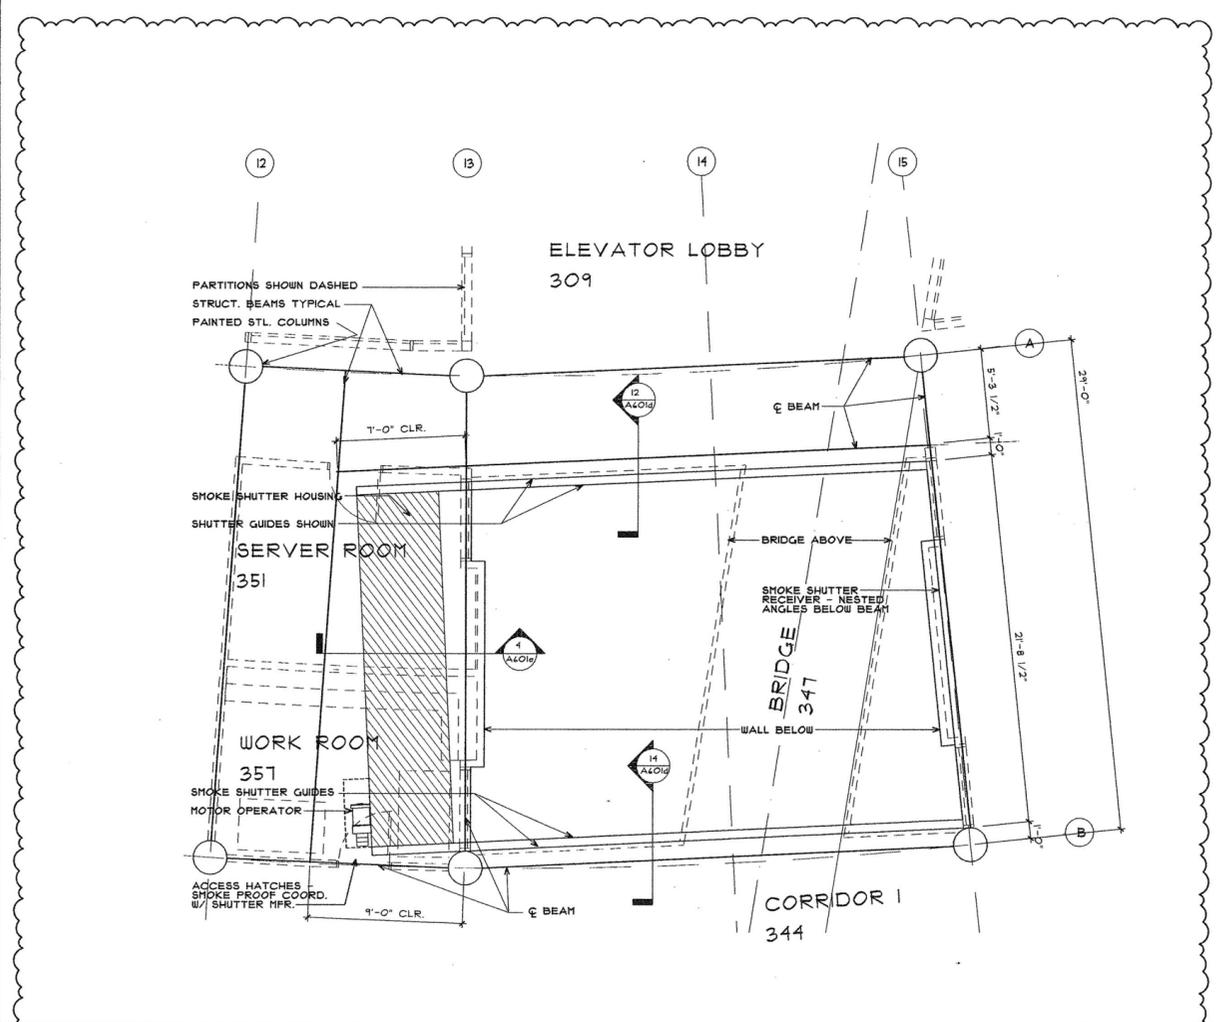

**1 ELEVATOR LOBBY SMOKE SHUTTER PLAN**  
SCALE: 1/4" = 1'-0"

**STAIR ELEVATIONS TABLE**  
F.O.S. DIAGONAL BEAMS IN (PARENTHESIS)

ROOF LEVEL - 328.00' (321.61')
THIRD LANDING - 324.50' (324.11')
SECOND LANDING - 321.00' (320.61')
FIRST LANDING - 317.50' (317.11')
FOURTH FLOOR LEVEL - 314.00' (313.61')
THIRD LANDING - 310.50' (310.11')
SECOND LANDING - 307.00' (306.61')
FIRST LANDING - 303.50' (303.11')
THIRD FLOOR LEVEL - 300.00' (299.61')
THIRD LANDING - 296.50' (296.11')
SECOND LANDING - 293.00' (292.61')
FIRST LANDING - 289.50' (289.11')
SECOND FLOOR LEVEL - 286.00' (285.61')
THIRD LANDING - 282.50' (282.11')
SECOND LANDING - 279.00' (278.61')
FIRST LANDING - 275.50' (275.11')
FIRST FLOOR LEVEL - 272.00' (271.61')

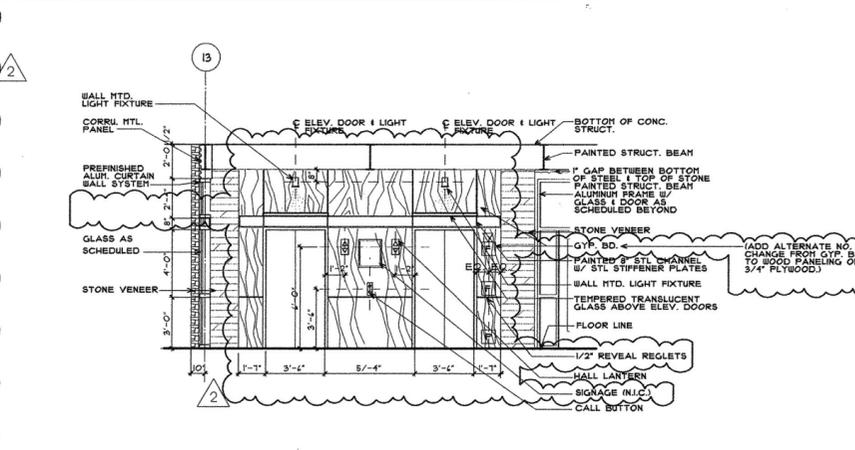

**2 ELEV. LOBBY INTERIOR ELEVATION**  
SCALE: 1/4" = 1'-0"

P:\AD-DB\04\13\CA\Final\Drawings\Final\A601-CORE.DWG 1/17/2004 11:51 AM