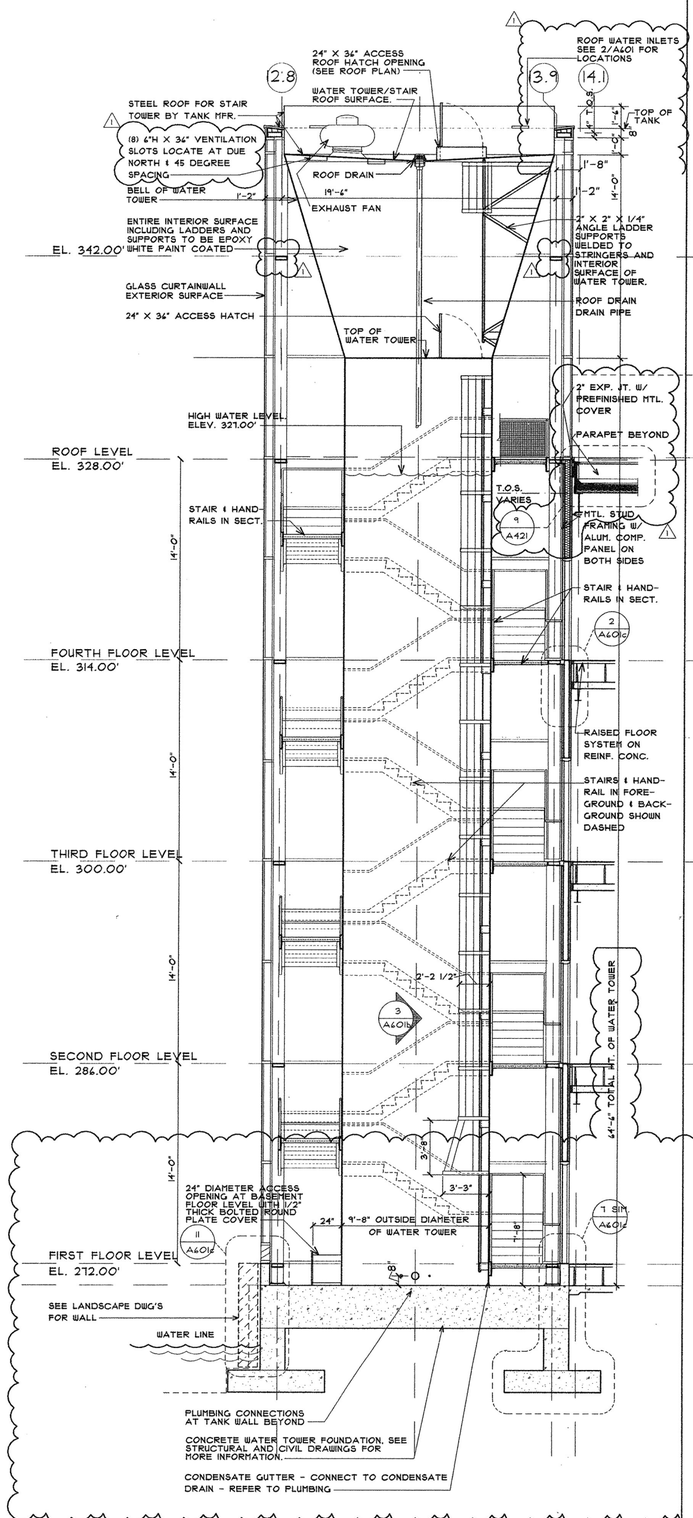

1 SECTION THRU WATER TOWER AT STAIR 3
SCALE: 1/4" = 1'-0"

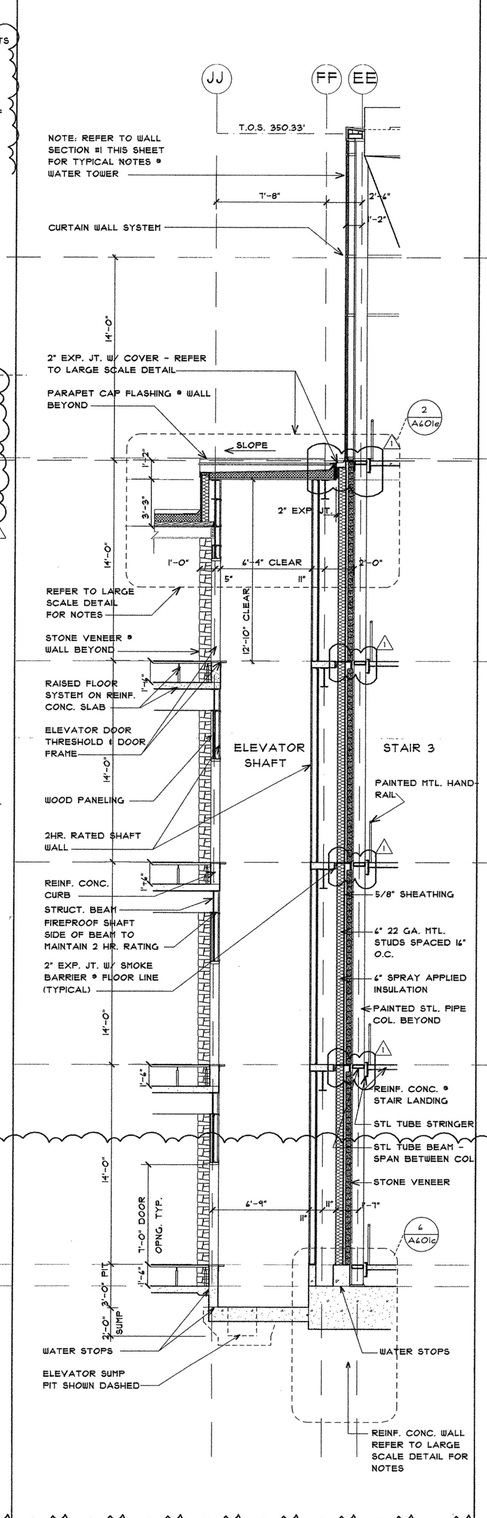

2 SECTION @ ELEV. #1
SCALE: 1/4" = 1'-0"

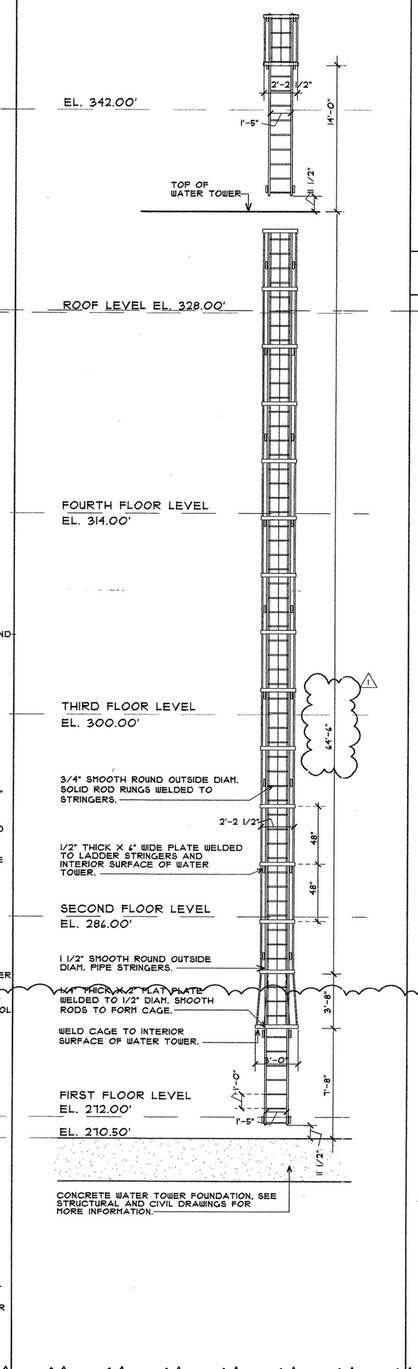

3 ELEV. - LADDERS @ WATER TOWER
SCALE: 1/4" = 1'-0"

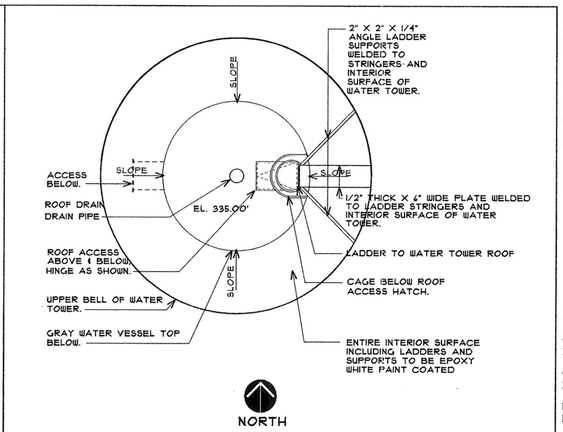

4 WATER TOWER PLAN
SCALE: 1/4" = 1'-0"

POLK
STANLEY
YEARY
ARCHITECTS, LTD.

700 SOUTH SCHILLER
LITTLE ROCK, AR 72201
501 378-0878
FAX 372-7629

21 W. MOUNTAIN, SUITE 227
FAYETTEVILLE, AR 72701
479-444-0473

CONSULTANTS:

OWNER'S PROJECT ADVISOR:
MOSES TUCKER REAL ESTATE, INC.

CIVIL ENGINEER:
McCLELLAND ENGINEERS

LANDSCAPE ARCHITECT:
LARSON BURNS SMITH

STRUCTURAL ENGINEER:
CROMWELL ENGINEERS INC.

MECH., ELEC., PLUMB. ENGINEER:
CROMWELL ENGINEERS INC.

SUSTAINABLE CONSULTANT:
BNIM / ELEMENTS

GLOBAL VILLAGE CONSULTANT
CAMBRIDGE SEVEN ASSOCIATES

INTERIOR DESIGNER:
POLK STANLEY YEARY

GENERAL CONTRACTOR:
CDI

GENERAL NOTES:

1. REFER TO STRUCTURAL FOR EXTERIOR WALL STUD GAUGE.

NOTES:

ISSUE DATE:
100% G.M.P.
PACKAGE #6
FEBRUARY 2, 2004

REVISIONS:

#	DATE	DESCRIPTION
1	01JUL04	PACKAGE #7

HEIFER
INTERNATIONAL
CENTER
OFFICE BUILDING
LITTLE ROCK, ARKANSAS

PSY PROJECT NUMBER:
431C

CONTENTS:
STAIR 3 SECTION

SHEET NUMBER:
A601b

P:\D-DWG\431C\CAD\Final Drawings For CDs\Final\A601b-Stair3Section Thursday, July 01, 2004 1:28 PM