
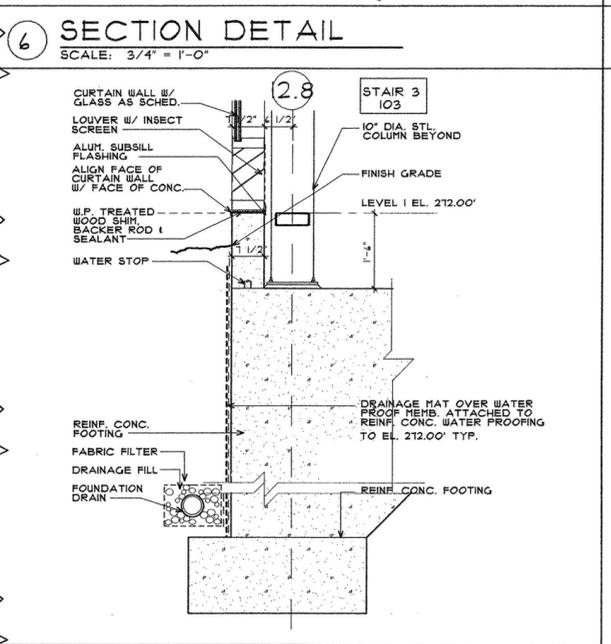
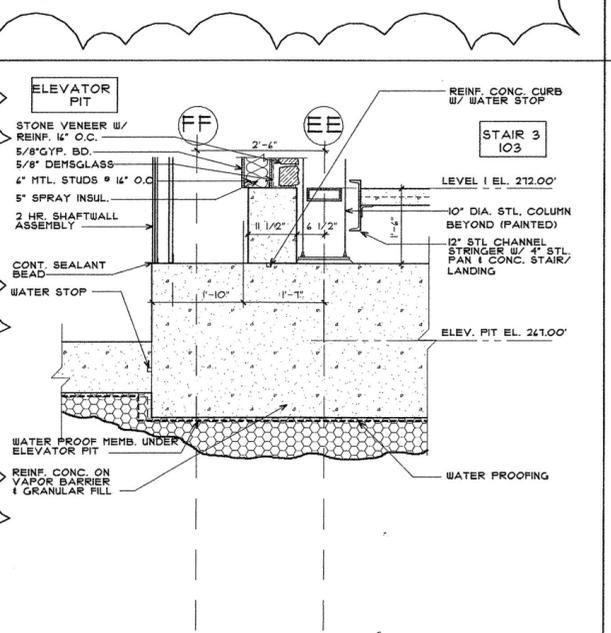
 
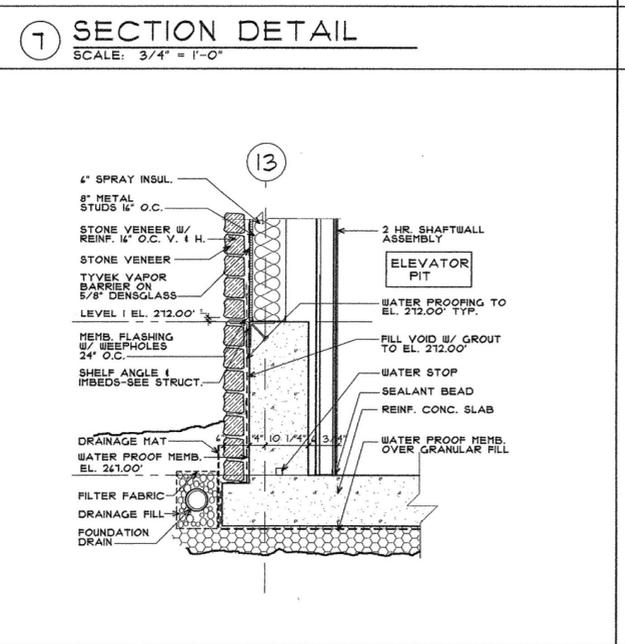
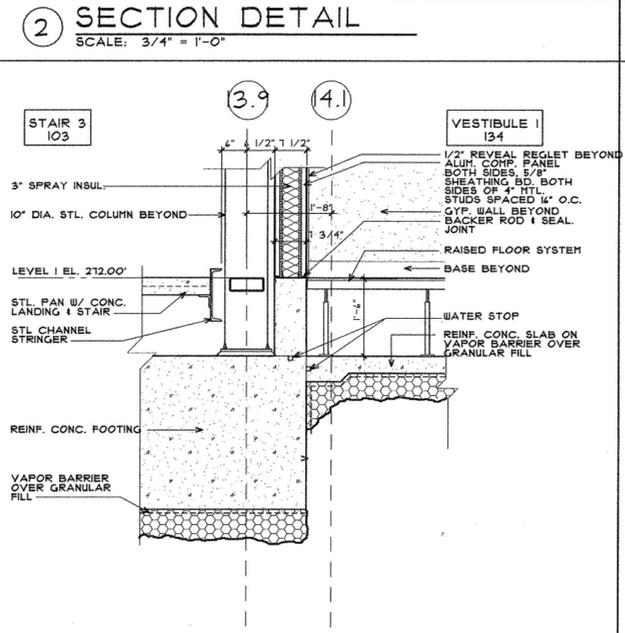
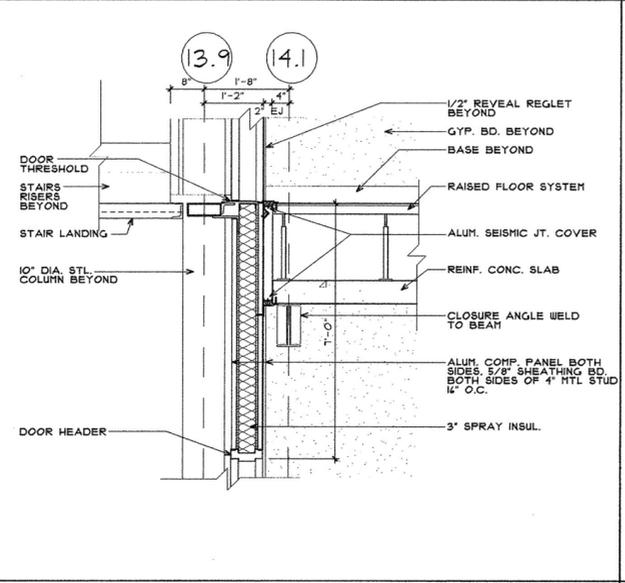
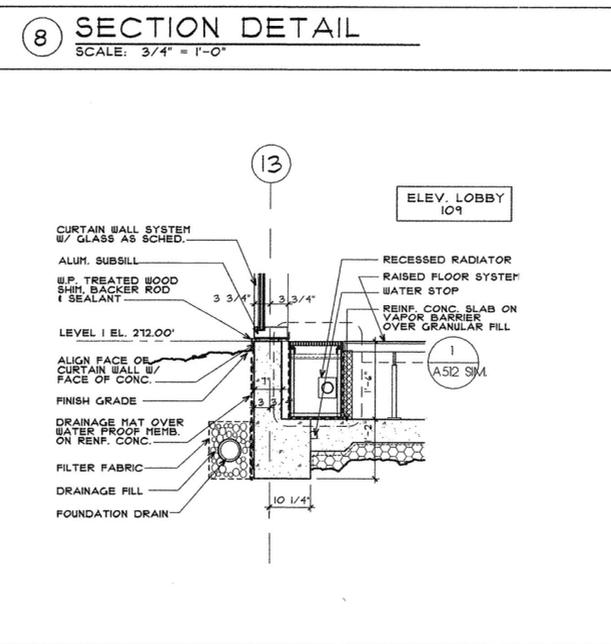
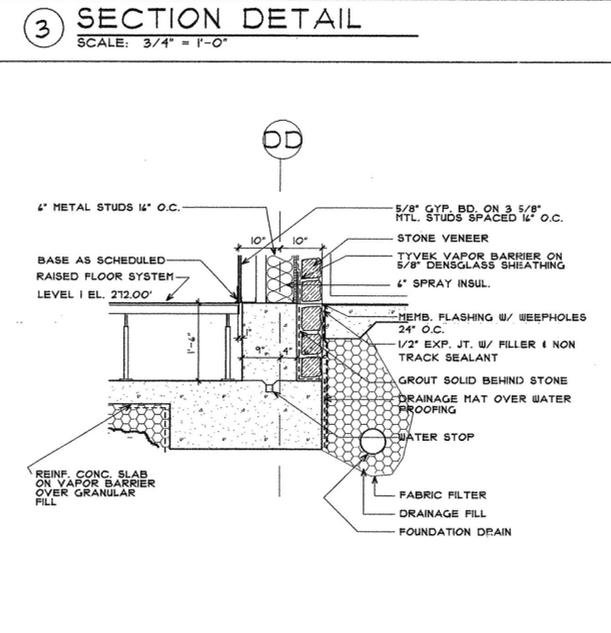
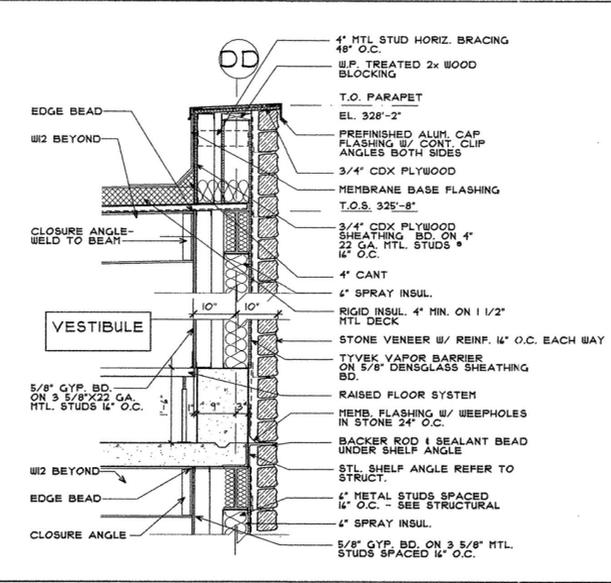
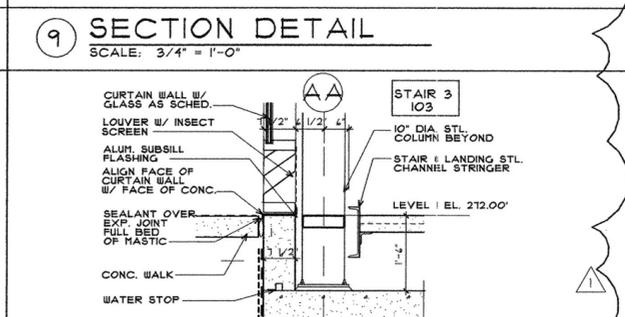
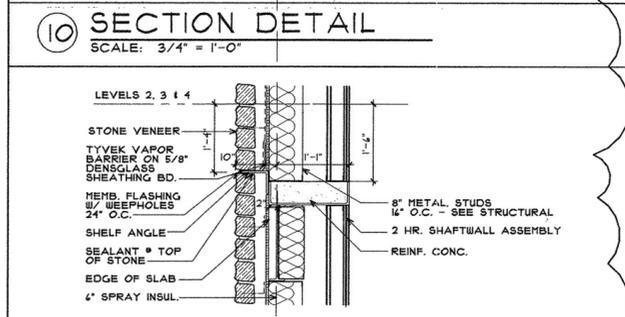
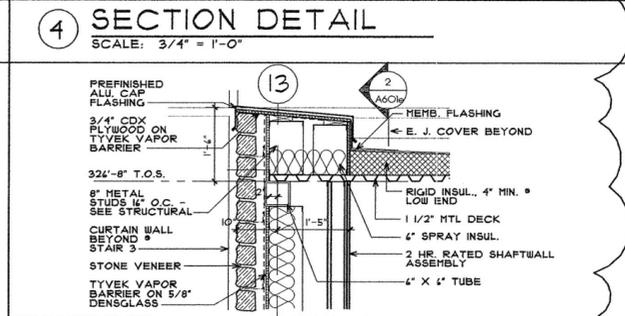
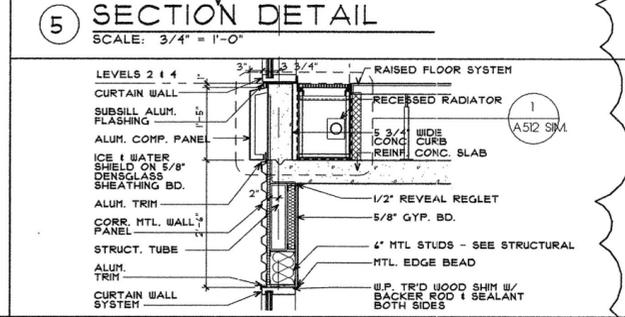


**REVISIONS:**

#	DATE	DESCRIPTION
1		PACKAGE #1

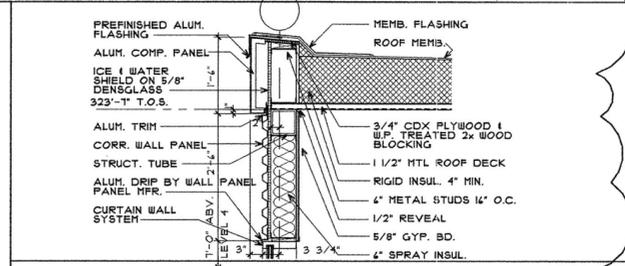

P:\0-DWG\100000\100000.dwg  
 Thursday, July 01, 2004  
 2:38 PM