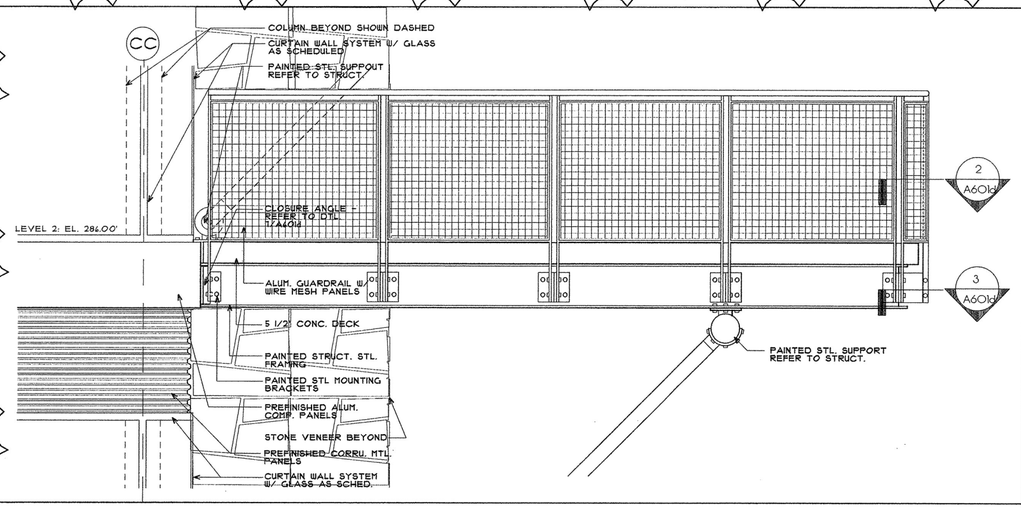

1 BALCONY 251 ELEVATION
SCALE: 3/4" = 1'-0"

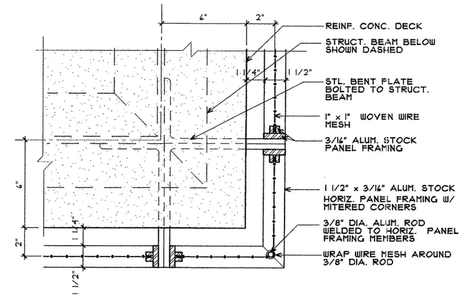

PLAN

2 GUARDRAIL DETAIL
SCALE: 3" = 1'-0"

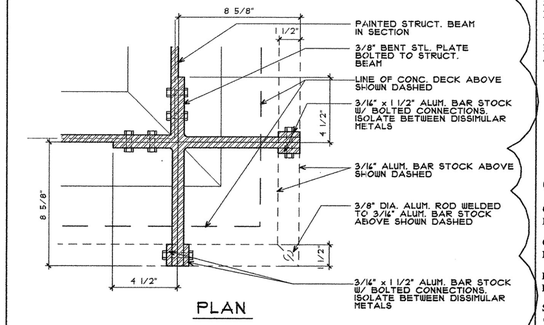

PLAN

3 GUARDRAIL DETAIL
SCALE: 3" = 1'-0"

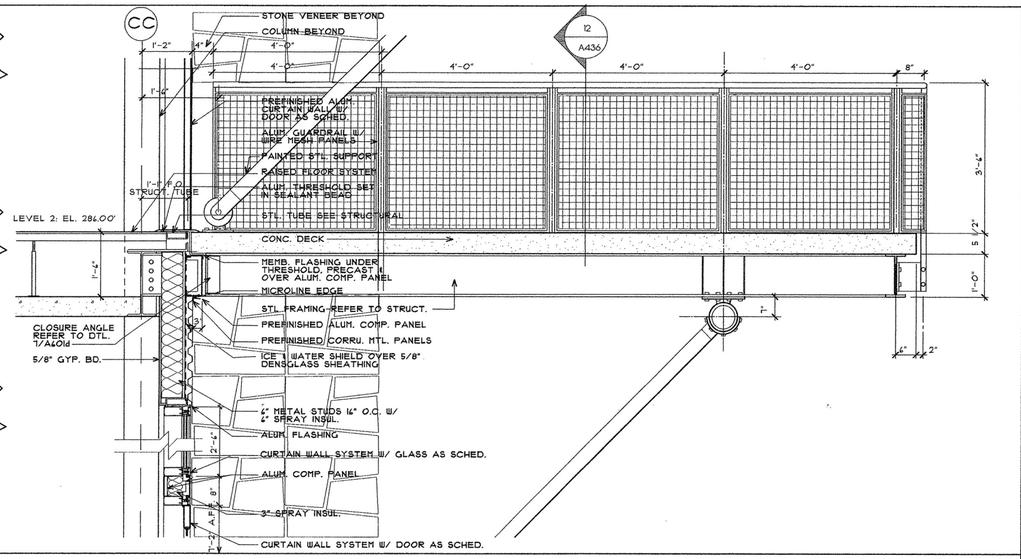

6 BALCONY 251 SECTION
SCALE: 3/4" = 1'-0"

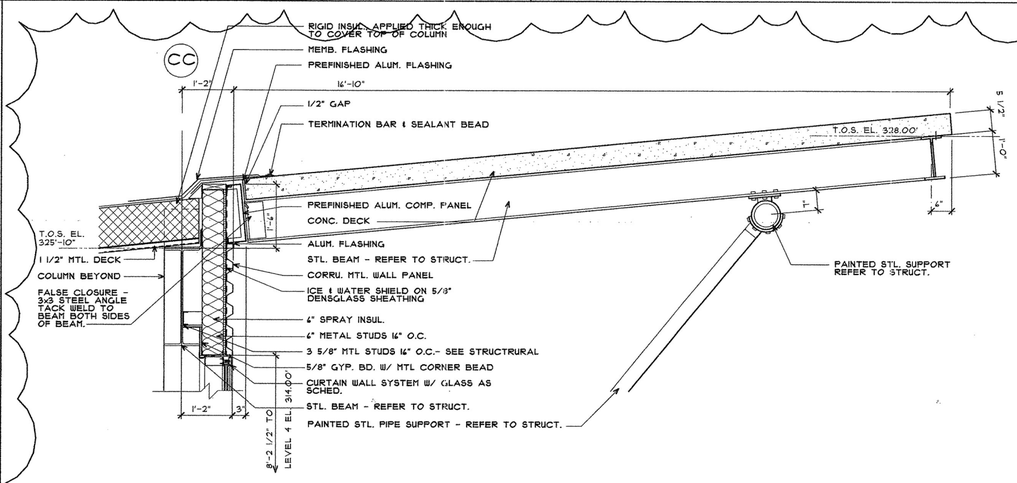

7 SECTION DETAIL
SCALE: 3/4" = 1'-0"

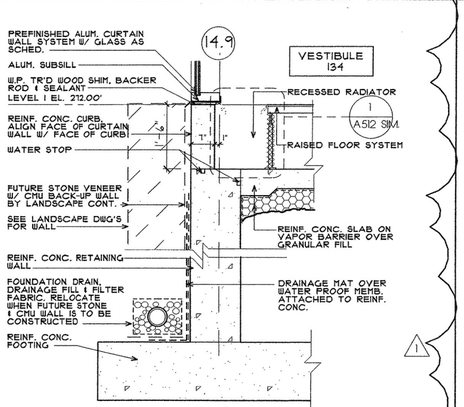

11 SECTION DETAIL
SCALE: 3/4" = 1'-0"

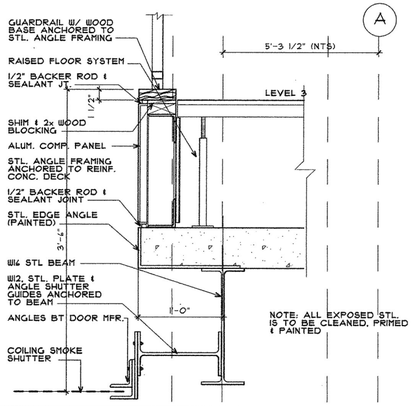

12 SMOKE SHUTTER-NORTH JAMB
SCALE: 3/4" = 1'-0" SCALE: 1 1/2" = 1'-0"

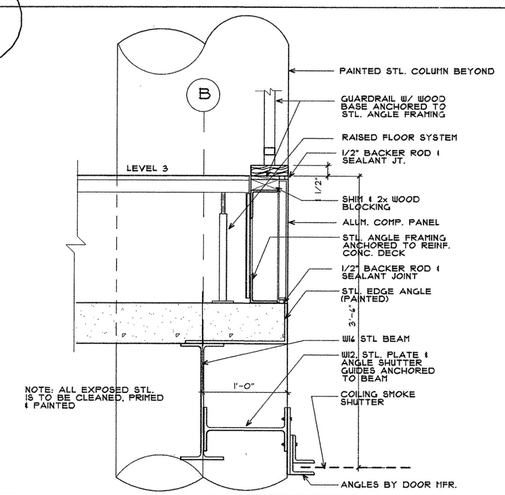

14 SMOKE SHUTTER -SOUTH JAMB
SCALE: 3/4" = 1'-0"

POLK STANLEY YEARY
ARCHITECTS, LTD.

700 SOUTH SCHILLER
LITTLE ROCK, AR 72201
501 378-0878
FAX 372-7629

21 W. MOUNTAIN, SUITE 227
FAYETTEVILLE, AR 72701
479-444-0473

CONSULTANTS:

OWNER'S PROJECT ADVISOR:
MOSES TUCKER REAL ESTATE, INC.

CIVIL ENGINEER:
McCLELLAND ENGINEERS

LANDSCAPE ARCHITECT:
LARSON BURNS SMITH

STRUCTURAL ENGINEER:
CROMWELL ENGINEERS INC.

MECH., ELEC., PLUMB. ENGINEER:
CROMWELL ENGINEERS INC.

SUSTAINABLE CONSULTANT:
BNIM / ELEMENTS

GLOBAL VILLAGE CONSULTANT
CAMBRIDGE SEVEN ASSOCIATES

INTERIOR DESIGNER:
POLK STANLEY YEARY

GENERAL CONTRACTOR:
CDI

GENERAL NOTES:

1. REFER TO STRUCTURAL FOR EXTERIOR WALL STUD GAUGE.

NOTES:

ISSUE DATE:
100% GMP
PACKAGE #6
FEBRUARY 2, 2004

REVISIONS:

#	DATE	DESCRIPTION
1	01JUL04	PACKAGE 07

HEIFER INTERNATIONAL CENTER OFFICE BUILDING

LITTLE ROCK, ARKANSAS

PSY PROJECT NUMBER:
431C

CONTENTS:
SECTION DETAILS

SHEET NUMBER:
A601d

P:\0-DWG\431C\CD\Pwd2\temp\Pr\CD\Pwd\A601d\A601d-Vwrs\ArDetails Thursday, July 01, 2004 4:44 PM