

CONSULTANTS:

- OWNER'S PROJECT ADVISOR:
MOSES TUCKER REAL ESTATE, INC.
- CIVIL ENGINEER:
MCCLELLAND ENGINEERS
- LANDSCAPE ARCHITECT:
LARSON BURNS SMITH
- STRUCTURAL ENGINEER:
CROMWELL ENGINEERS INC.
- MECH., ELEC., PLUMB. ENGINEER:
CROMWELL ENGINEERS INC.
- SUSTAINABLE CONSULTANT:
BNIM/ELEMENTS
- GLOBAL VILLAGE CONSULTANT
CAMBRIDGE SEVEN ASSOCIATES
- INTERIOR DESIGNER:
POLK STANLEY YEARY
- GENERAL CONTRACTOR:
CDI

GENERAL NOTES:

- 1. REFER TO STRUCTURAL FOR
EXTERIOR WALL STUD GAUGE.

NOTES:

ISSUE DATE:

100% GMP
PACKAGE #6
FEBRUARY 2, 2004

REVISIONS:

#	DATE	DESCRIPTION
1	02JUL04	100% GMP ADDENDUM

**HEIFER
INTERNATIONAL
CENTER
OFFICE BUILDING**
LITTLE ROCK, ARKANSAS


PSY PROJECT NUMBER:
431C




CONTENTS:
SECTION DETAILS

SHEET NUMBER:


A601e

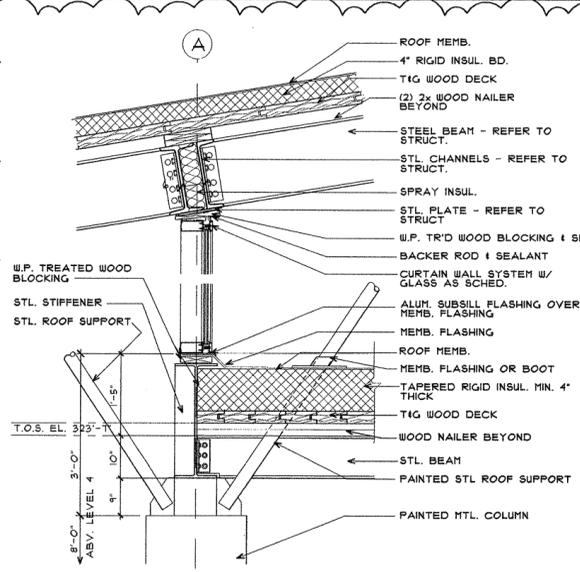


1 SECTION DETAIL
SCALE: 3/4" = 1'-0"

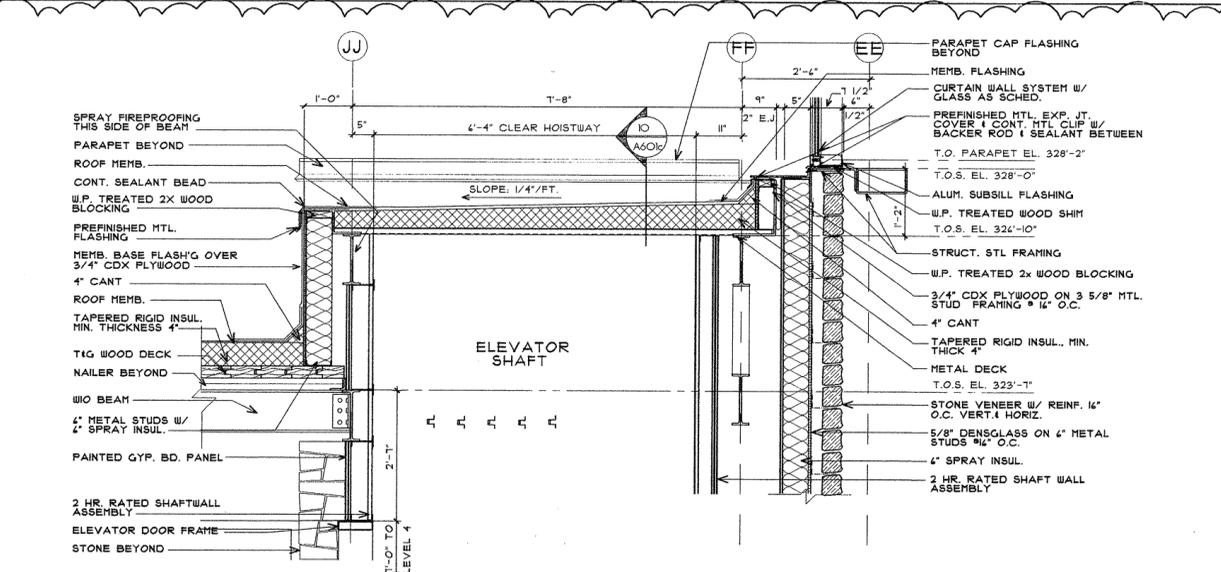

2 SECTION DETAIL
SCALE: 3/4" = 1'-0"

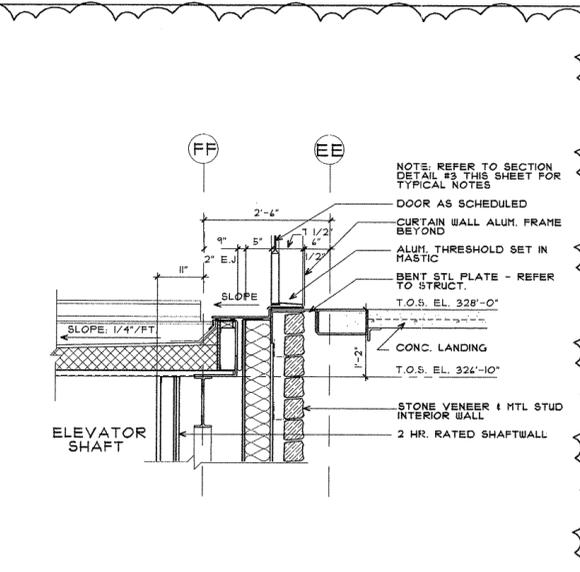

3 SECTION DETAIL
SCALE: 3/4" = 1'-0"

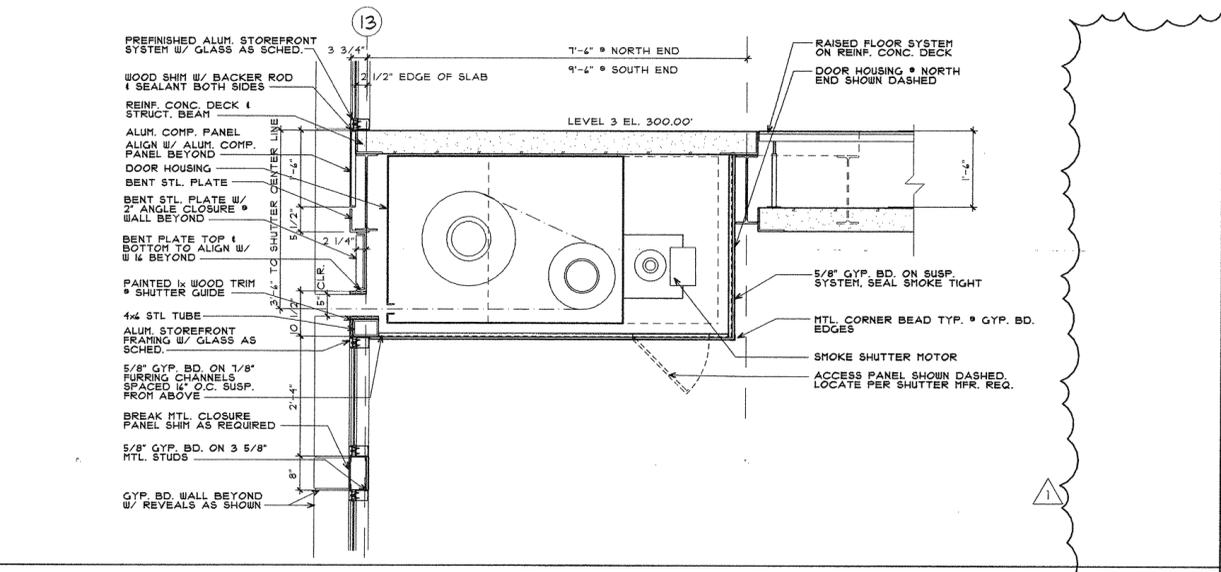

4 SMOKE SHUTTER SECTION
SCALE: 3/4" = 1'-0"