

**POLK
STANLEY
YEARY
ARCHITECTS, LTD.**

700 SOUTH SCHILLER
LITTLE ROCK, AR 7201
501 378-0878
FAX 372-7629

21 W. MOUNTAIN, SUITE 227
FAYETTEVILLE, AR 72701
479-444-0473

CONSULTANTS:

OWNER'S PROJECT ADVISOR:
MOSES TUCKER REAL ESTATE, INC.

CIVIL ENGINEER:
MCLELLAND ENGINEERS

LANDSCAPE ARCHITECT:
LARSON BURNS SMITH

STRUCTURAL ENGINEER:
CROMWELL ENGINEERS INC.

MECH., ELEC., PLUMB. ENGINEER:
CROMWELL ENGINEERS INC.

SUSTAINABLE CONSULTANT:
BNIM / ELEMENTS

GLOBAL VILLAGE CONSULTANT
CAMBRIDGE SEVEN ASSOCIATES

INTERIOR DESIGNER:
POLK STANLEY YEARY

GENERAL CONTRACTOR:
CDI

GENERAL NOTES:

NOTES:

ISSUE DATE:
CORE/SHELL
PACKAGE #5
DECEMBER 15, 2003

REVISIONS:

#	DATE	DESCRIPTION
1	01 JULY 04	PACKAGE #1


**HEIFER
INTERNATIONAL
CENTER
OFFICE BUILDING**
LITTLE ROCK, ARKANSAS

PSY PROJECT NUMBER:
431C




CONTENTS:
ENLARGED PLANS, SECTION-
STAIR 1


SHEET NUMBER:

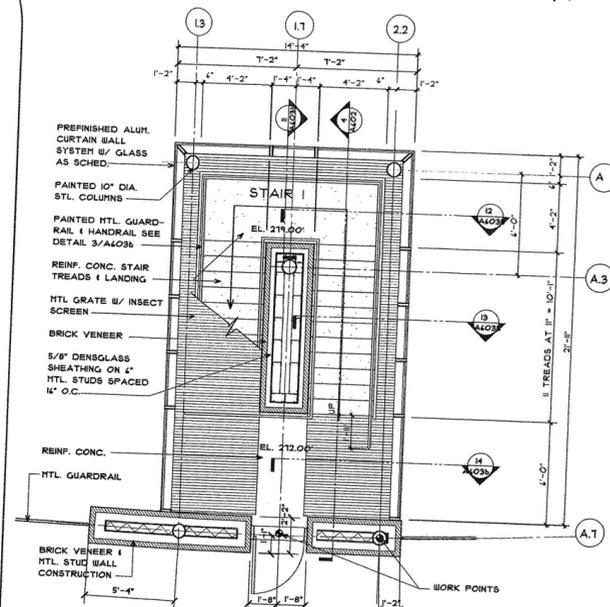

1 STAIR I AT 1st. FLOOR LEVEL
SCALE: 1/4" = 1'-0"

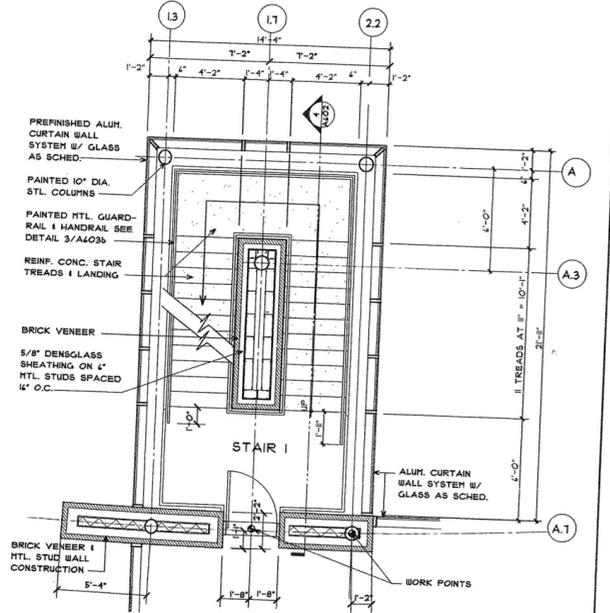

2 STAIR I AT 2nd., 3rd., & 4th. FLOOR LEVEL
SCALE: 1/4" = 1'-0"

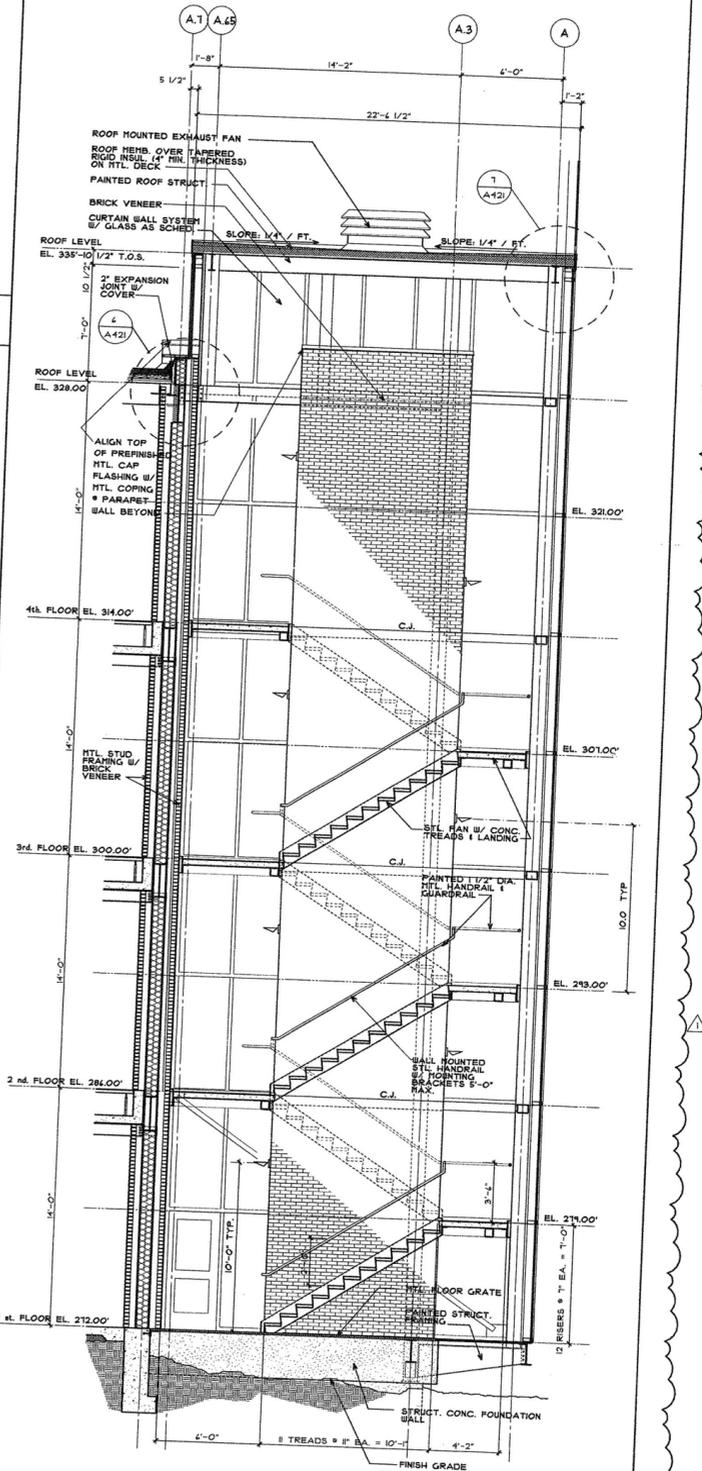

4 STAIR I - SECTION
SCALE: 1/4" = 1'-0"