

**CONSULTANTS:**

OWNER'S PROJECT ADVISOR:  
MOSES TUCKER REAL ESTATE, INC.

CIVIL ENGINEER:  
McCLELLAND ENGINEERS

LANDSCAPE ARCHITECT:  
LARSON BURNS SMITH

STRUCTURAL ENGINEER:  
CROMWELL ENGINEERS INC.

MECH., ELEC., PLUMB. ENGINEER:  
CROMWELL ENGINEERS INC.

SUSTAINABLE CONSULTANT:  
BNIM / ELEMENTS

GLOBAL VILLAGE CONSULTANT  
CAMBRIDGE SEVEN ASSOCIATES

INTERIOR DESIGNER:  
POLK STANLEY YEARY

GENERAL CONTRACTOR:  
CDI

**GENERAL NOTES:**

**NOTES:**

ISSUE DATE:  
100% G.M.P.  
PACKAGE #6  
FEBRUARY 2, 2004

**REVISIONS:**


#	DATE	DESCRIPTION
1	10 JULY 04	PACKAGE #1

**HEIFER  
INTERNATIONAL  
CENTER  
OFFICE BUILDING**  
LITTLE ROCK, ARKANSAS


PSY PROJECT NUMBER:  
431C

CONTENTS:  
ENLARGED PLANS-  
STAIR 2 & FREIGHT ELEV.  
SHEET NUMBER:


**A603**

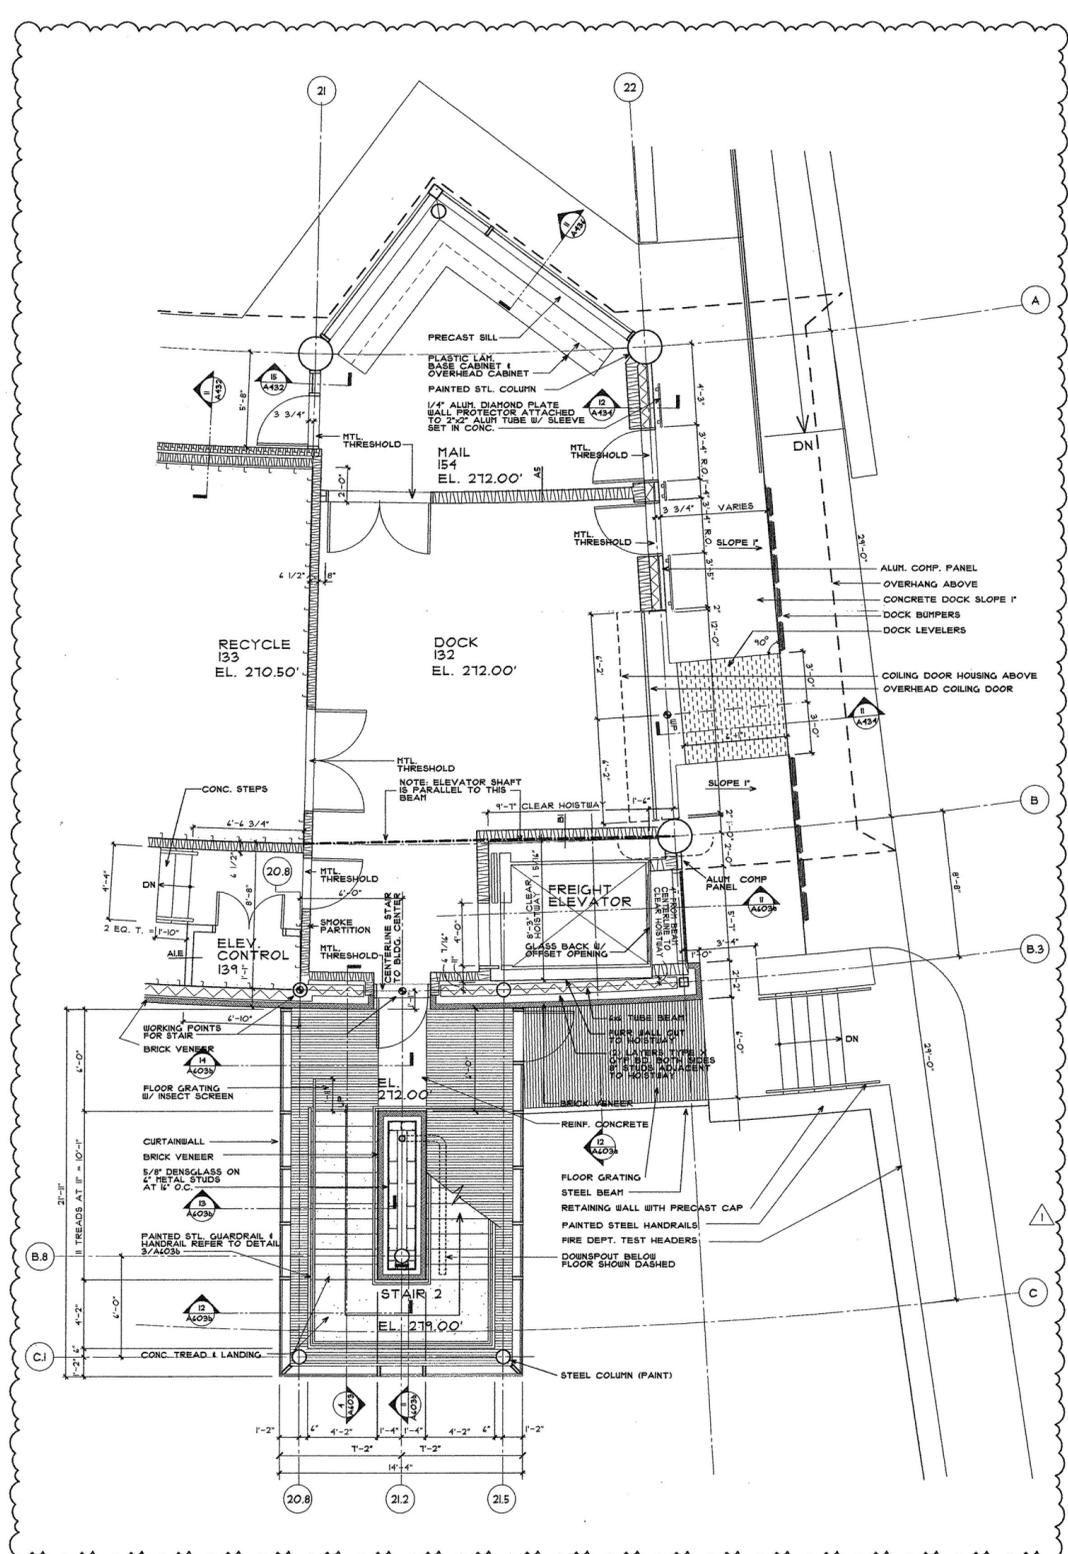


**1 STAIR 2 AT 1st. FLOOR LEVEL**  
SCALE: 1/4" = 1'-0"

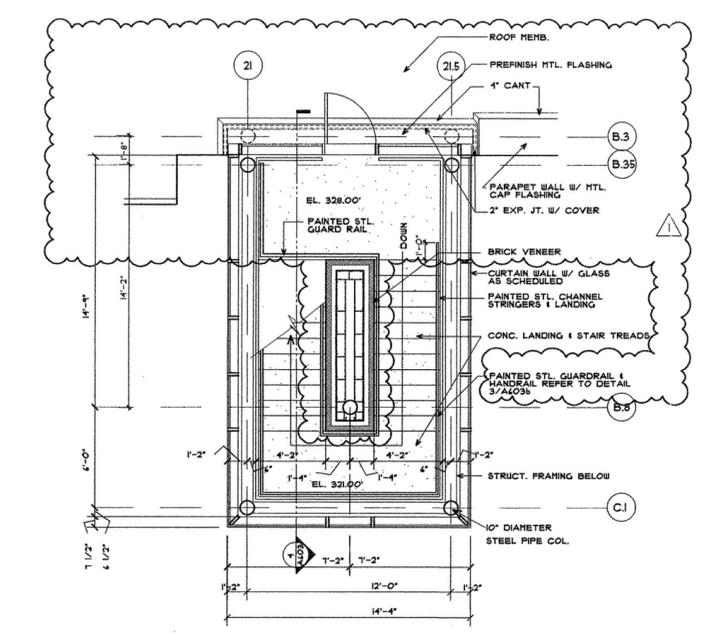

**3 STAIR 2 AT ROOF LEVEL**  
SCALE: 1/4" = 1'-0"

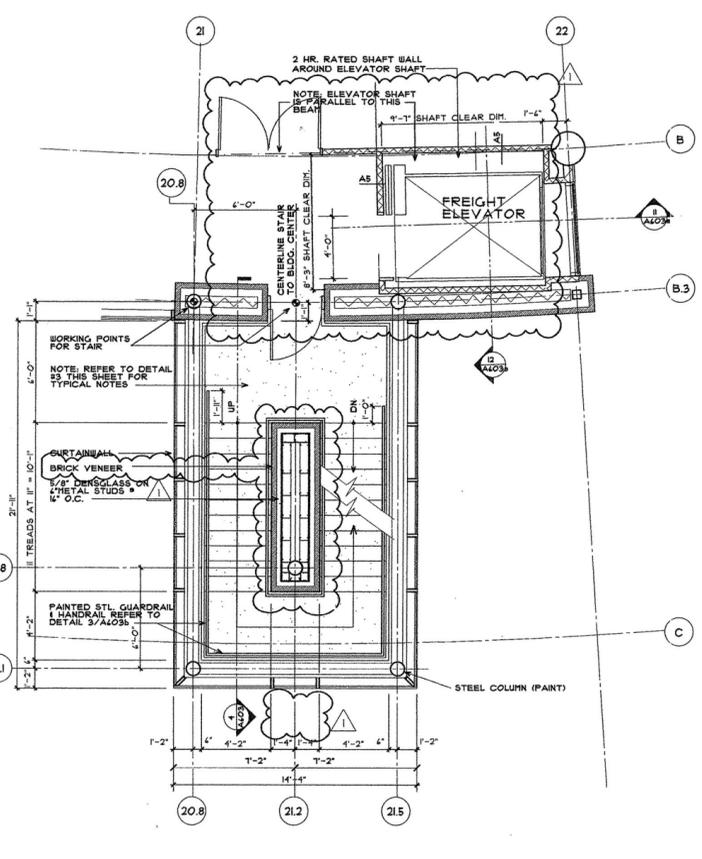

**2 STAIR 2 AT 2nd, 3rd, & 4th. FLOOR LEVEL**  
SCALE: 1/4" = 1'-0"

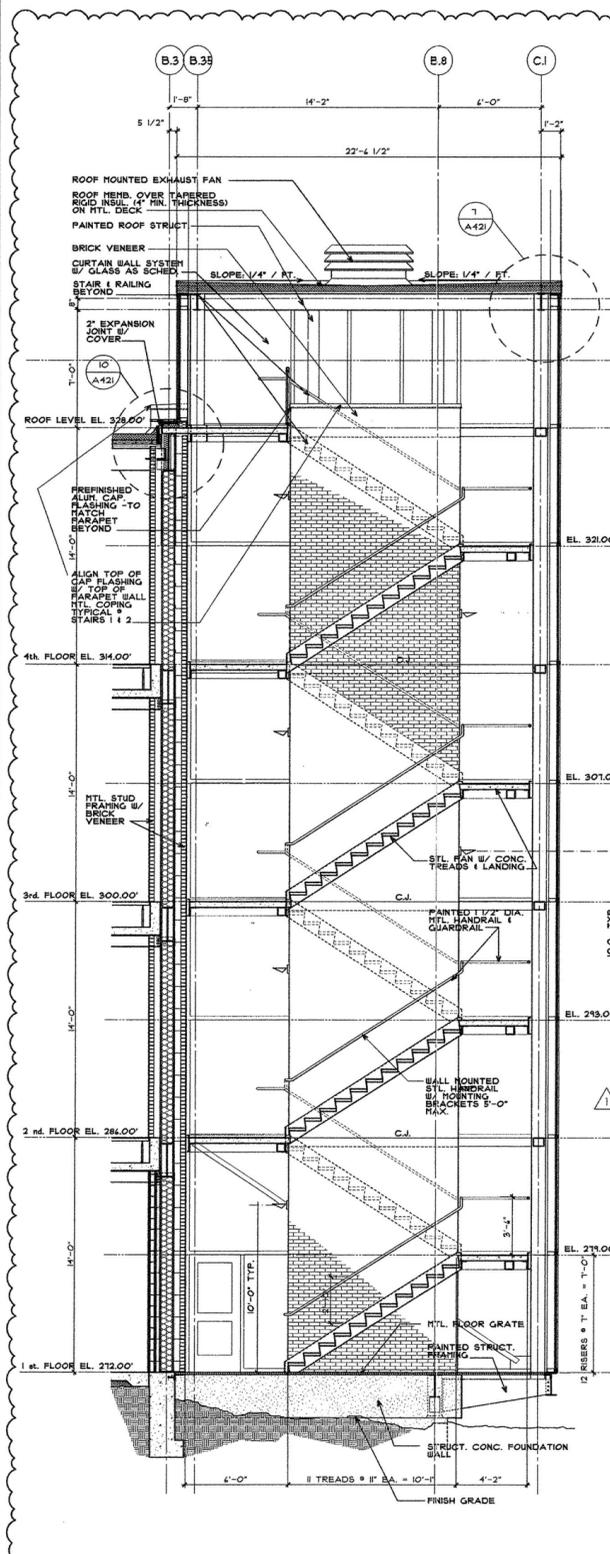

**4 STAIR 2 - SECTION**  
SCALE: 1/4" = 1'-0"

P:\D-000\VC\VC\Arch\Drawings\A603-EnlargedStair2Plan.dwg, 01/02/2004, 1:31 AM