

CONSULTANTS:

OWNER'S PROJECT ADVISOR:
MOSES TUCKER REAL ESTATE, INC.
CIVIL ENGINEER:
McCLELLAND ENGINEERS
LANDSCAPE ARCHITECT:
LARSON BURNS SMITH
STRUCTURAL ENGINEER:
CROMWELL ENGINEERS INC.
MECH., ELEC., PLUMB. ENGINEER:
CROMWELL ENGINEERS INC.
SUSTAINABLE CONSULTANT:
BNIM / ELEMENTS
GLOBAL VILLAGE CONSULTANT
CAMBRIDGE SEVEN ASSOCIATES
INTERIOR DESIGNER:
POLK STANLEY YEARY
GENERAL CONTRACTOR:
CDI

GENERAL NOTES:

1. REFER TO STRUCTURAL FOR
EXTERIOR WALL STUD GAUGE.

NOTES:

ISSUE DATE:
100% G.M.P.
PACKAGE #6
FEBRUARY 2, 2004

REVISIONS:

#	DATE	DESCRIPTION
1	01/01/04	PACKAGE 1

**HEIFER
INTERNATIONAL
CENTER
OFFICE BUILDING**
LITTLE ROCK, ARKANSAS



PSY PROJECT NUMBER:
431C



CONTENTS:
FREIGHT ELEVATOR SECTION

SHEET NUMBER:

A603a

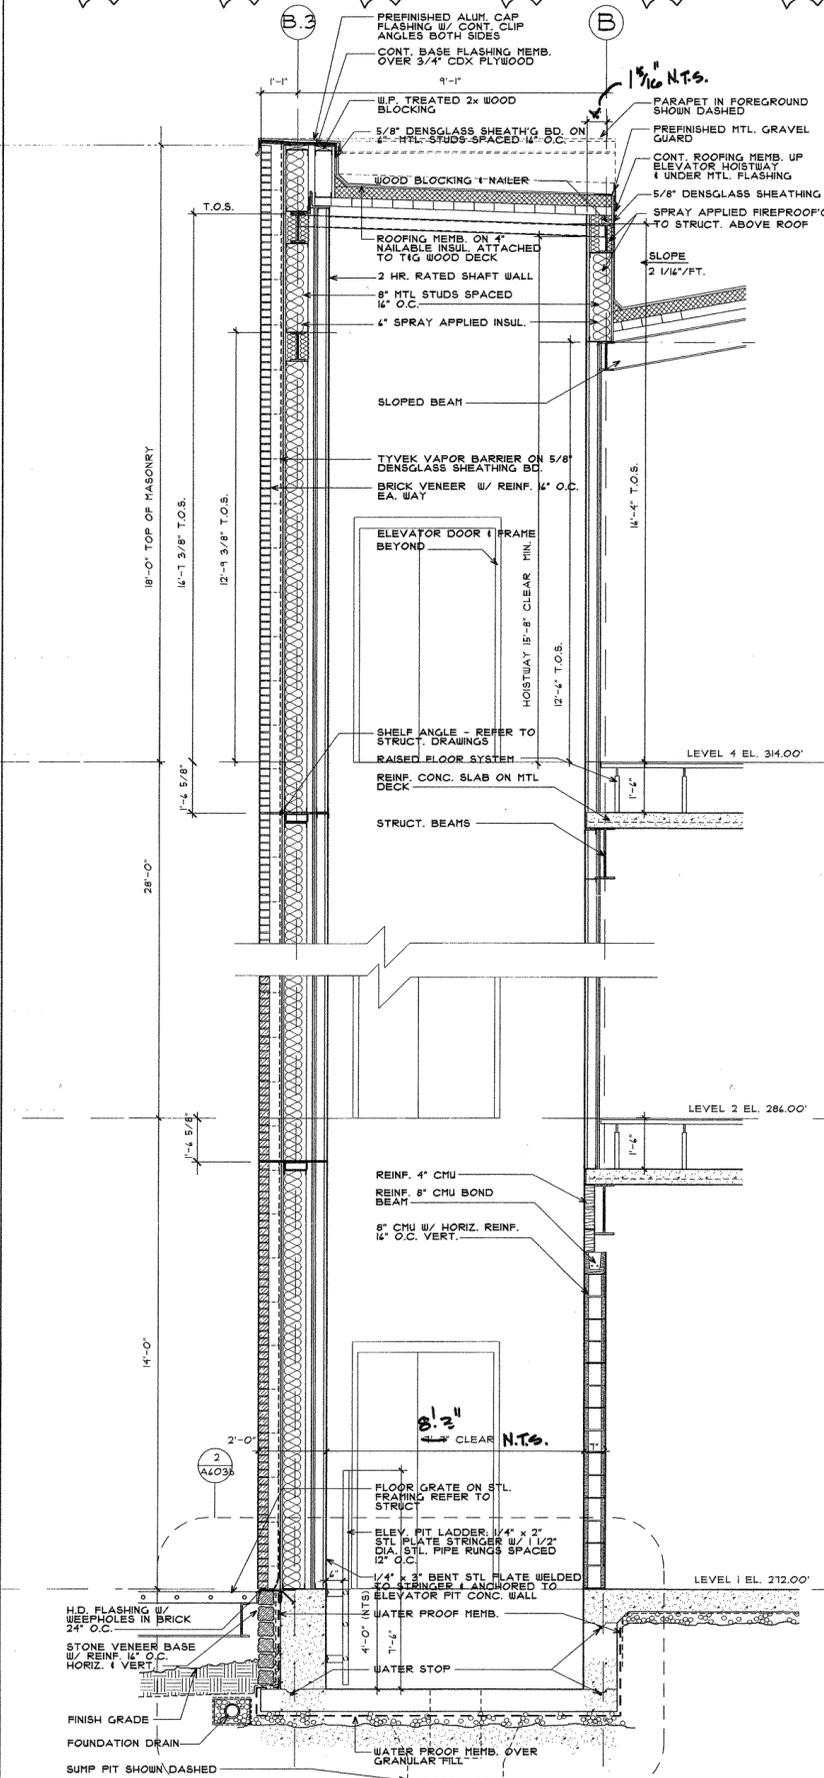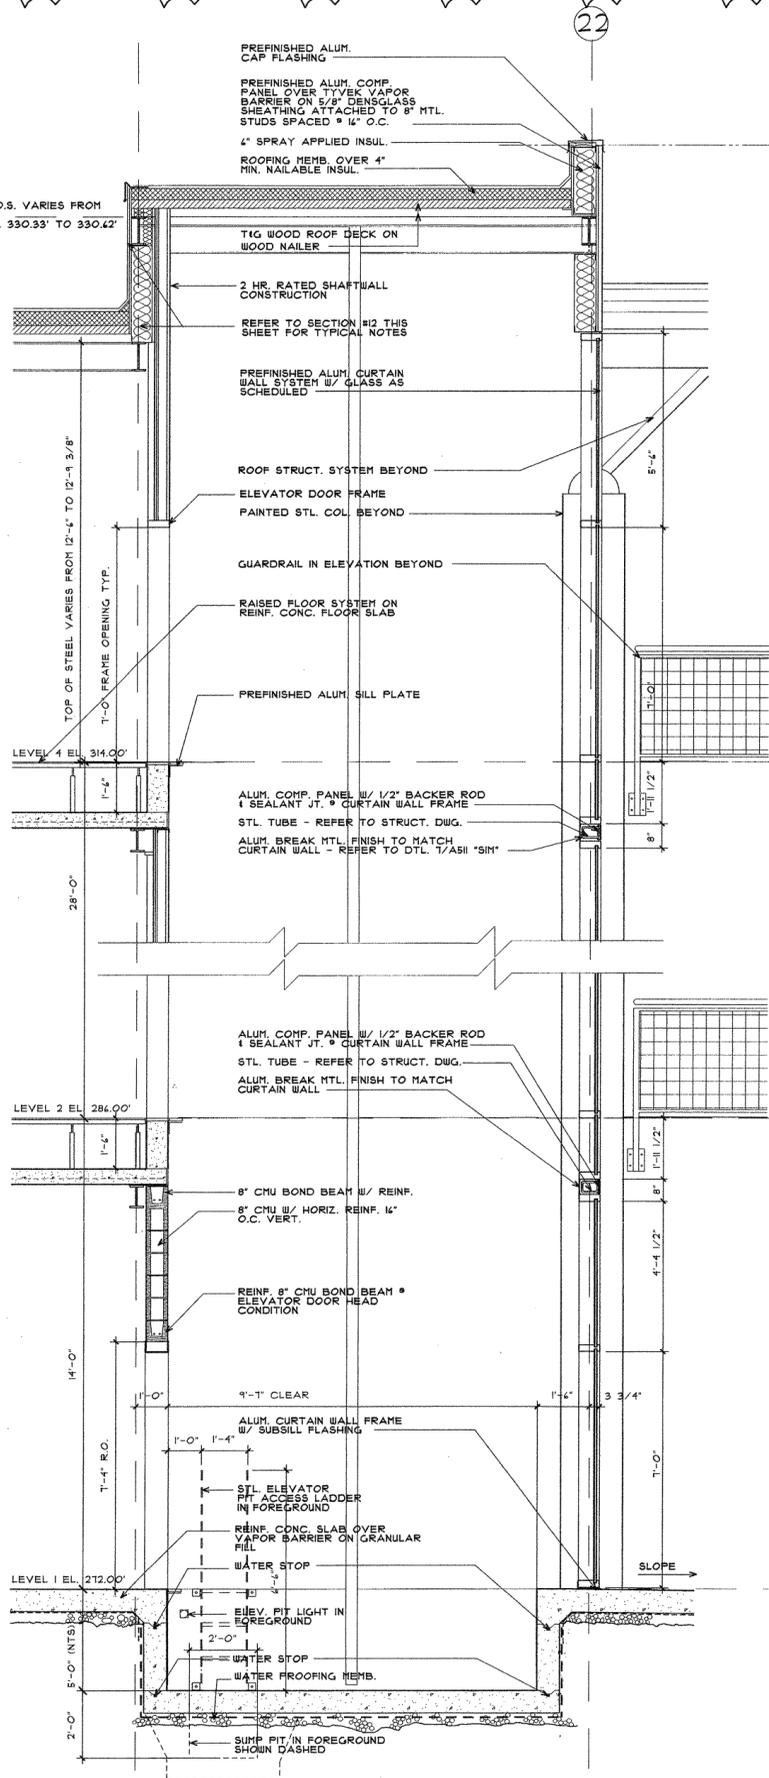

II FREIGHT ELEVATOR SECTION
SCALE: 1/2" = 1'-0"

12 FREIGHT ELEVATOR SECTION
SCALE: 1/2" = 1'-0"

