

**CONSULTANTS:**

OWNER'S PROJECT ADVISOR:  
MOSES TUCKER REAL ESTATE, INC.

CIVIL ENGINEER:  
McCLELLAND ENGINEERS

LANDSCAPE ARCHITECT:  
LARSON BURNS SMITH

STRUCTURAL ENGINEER:  
CROMWELL ENGINEERS INC.

MECH., ELEC., PLUMB. ENGINEER:  
CROMWELL ENGINEERS INC.

SUSTAINABLE CONSULTANT:  
BNIM / ELEMENTS

GLOBAL VILLAGE CONSULTANT  
CAMBRIDGE SEVEN ASSOCIATES

INTERIOR DESIGNER:  
POLK STANLEY YEARY

GENERAL CONTRACTOR:  
CDI

**GENERAL NOTES:**

**NOTES:**

ISSUE DATE:  
100% G.M.P.  
PACKAGE #6  
FEBRUARY 2, 2004

**REVISIONS:**

#	DATE	DESCRIPTION
1	07/04/04	PACKAGE #1

**HEIFER  
INTERNATIONAL  
CENTER  
OFFICE BUILDING**  
LITTLE ROCK, ARKANSAS





PSY PROJECT NUMBER:  
431C



CONTENTS:  
**ENLARGED TOILET PLANS**







SHEET NUMBER:

**A604**

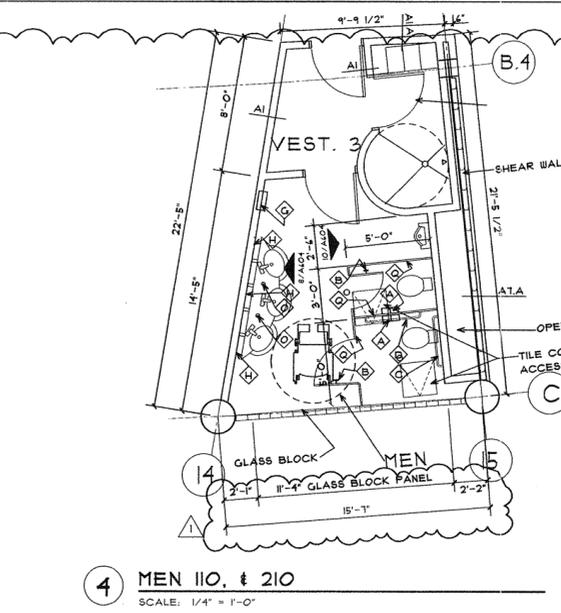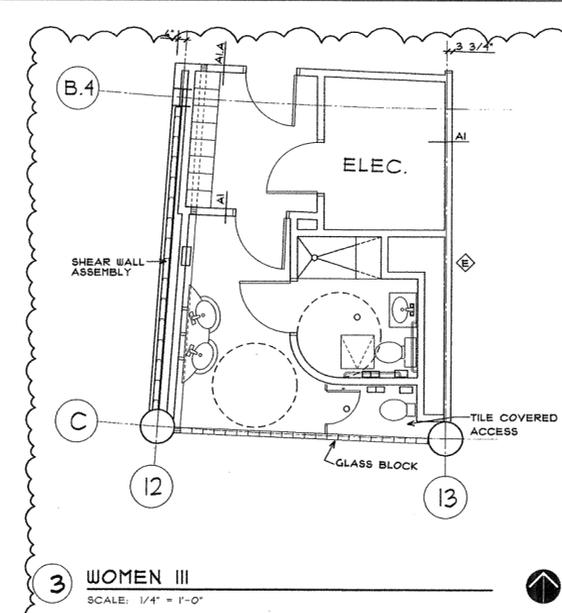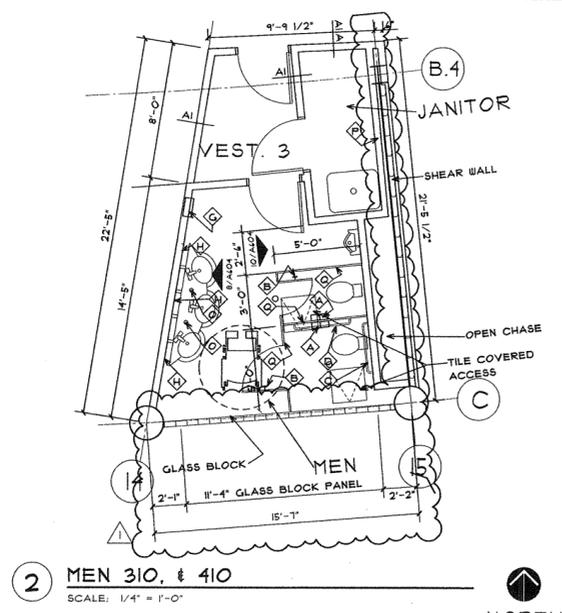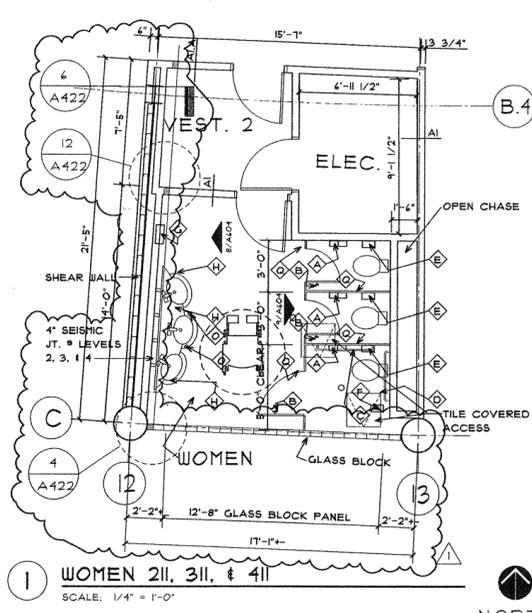

**TOILET ACCESSORIES SCHEDULE**

MARK	SIZE	MANUFACTURER	MODEL NUMBER AND FINISH	DESCRIPTION / REMARKS
A	DOUBLE ROLL	BOBRICK	B-484 STAINLESS STEEL	SURFACE MOUNTED DOUBLE ROLL TOILET TISSUE HOLDER. MOUNT 20" TO CENTER ABOVE FINISH FLOOR.
B	2" X 2"	BOBRICK	B-470 STAINLESS STEEL	SURFACE MOUNTED UTILITY HOOK. MOUNT AT 48" ABOVE FINISH FLOOR
C	1 1/4" DIAMETER	BOBRICK	B-5804 X 48 STAINLESS STEEL	SURFACE MOUNTED GRAB BAR WITH CONCEALED FASTENERS. MOUNT 35" ABOVE FINISH FLOOR
D	1 1/4" DIAMETER	BOBRICK	B-5804 X 36 STAINLESS STEEL	SURFACE MOUNTED GRAB BAR WITH CONCEALED FASTENERS. MOUNT 35" ABOVE FINISH FLOOR
E	8" X 11" W/SHLEF	BOBRICK	B-271 & B270-12 STAINLESS STEEL	SURFACE MOUNTED SANITARY NAPKIN DISPOSAL CABINET. MOUNT 24" ABOVE FINISH FLOOR
F	14 1/2" X 5 3/4"	BOBRICK	B-2871 STAINLESS STEEL	SURFACE MOUNTED FOLDING UTILITY SHELF. MOUNT 34" ABOVE FINISH FLOOR
G	15 1/8" X 54"	BOBRICK	B-3441 STAINLESS STEEL	RECESSED MOUNTED PAPER TOWEL DISP. AND WASTE RECEPT. MOUNT BOT. OF CAB. ABOVE FLOOR BASE
H	108" X 48"	BOBRICK	B-240-4834 STAIN. STL. FRAMED	SURFACE MOUNTED TEMPERED GLASS MIRROR. MOUNT BOTTOM OF MIRROR.
I	30" X 48"	BOBRICK	B-240-4830 STAIN. STL. FRAMED	SURFACE MOUNTED TEMPERED GLASS MIRROR. MOUNT BOTTOM OF MIRROR.
J	NOT USED	NOT USED	NOT USED	NOT USED
K	42" X 12"	BOBRICK	B-204-2 VINYL	VINYL SHOWER CURTAIN. MOUNTED ON SHOWER CURTAIN ROD.
L	42"	BOBRICK	B-4101 STAINLESS STEEL	SURFACE MOUNTED SHOWER CURTAIN ROD. MOUNTED AT 73" ABOVE FINISH FLOOR.
M	1" DIAMETER	BOBRICK	B-204-1 STAINLESS STEEL	SHOWER CURTAIN ROD HOOKS. MOUNTED AT TOP OF CURTAIN.
N	2 3/4" DIAMETER	BOBRICK	B-211 STAINLESS STEEL	HEAVY DUTY ROBE HOOK WITH CONCEALED FASTENERS. MOUNTED AT 40" ABOVE FINISH FLOOR.
O	3 1/4" DIAMETER	BOBRICK	B-8224 STAINLESS STEEL	LAVATORY MOUNTED LIQUID SOAP DISPENSER. MOUNTED THRU LAV HOLE.
P	48" LONG	BOBRICK	B-224 X 48 STAINLESS STEEL	SURFACE MOUNTED UTILITY SHELF MOP/BROOM (4) HOLDERS. MOUNTED 40" ABOVE FINISH FLOOR.
Q	1010 SERIES	BOBRICK	1011 STAINLESS STEEL	FLOOR ANCHORED TOILET COMPARTMENTS. TOP OF PANEL TO BE 5'-10" ABOVE FINISH FLOOR.
R	5' LONG	IDEAL PRODUCTS	1 1/4" RED OAK TOP WITH 1 1/2" HIGH BLACK T-LEGS	RED OAK WOOD TOP WITH METAL BLACK POWDERCOATED T-LEGS, NOT ANCHORED TO FLOOR.
S	1000 SERIES	IDEAL PRODUCTS	PLAST. LAM. WHITE INTERIOR	LOCKERS - 12" W. X 18" D. X 84" H. ON 4" BASE WITH KEY LOCKING DEVICES.

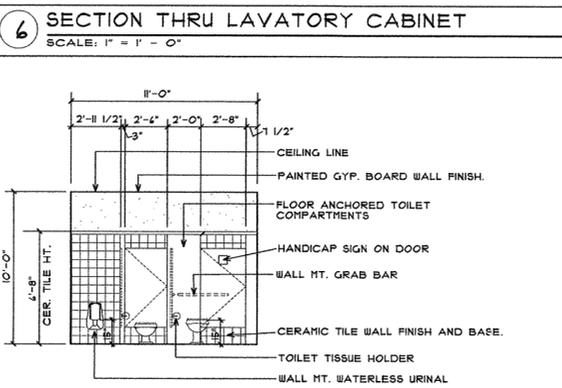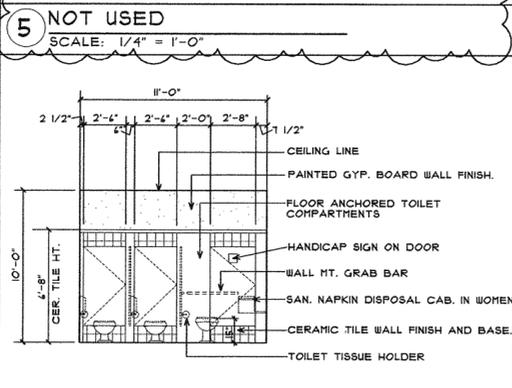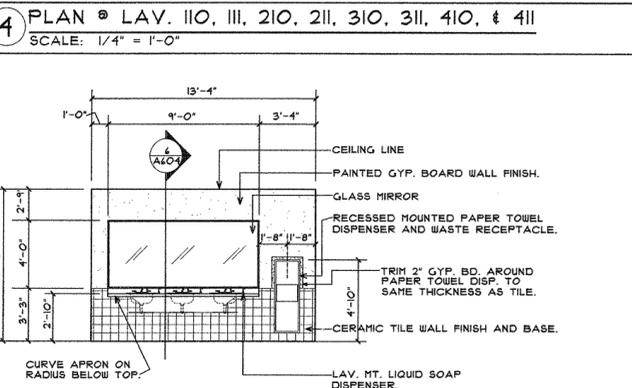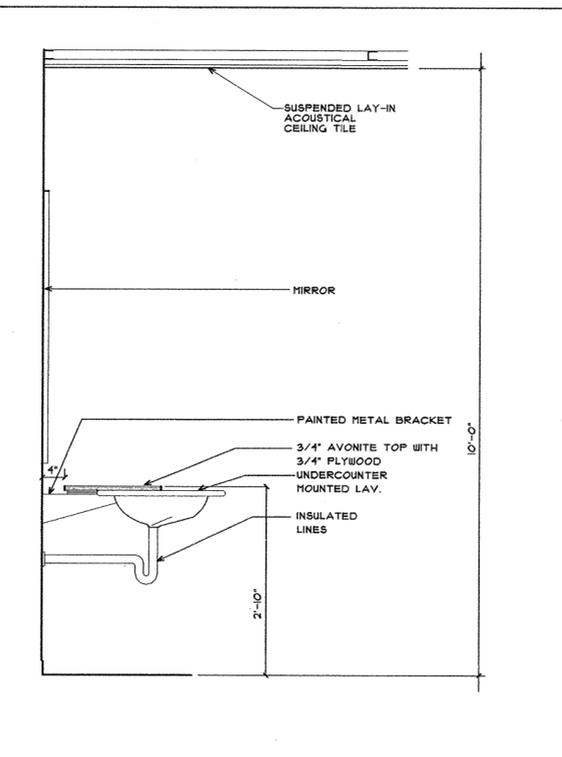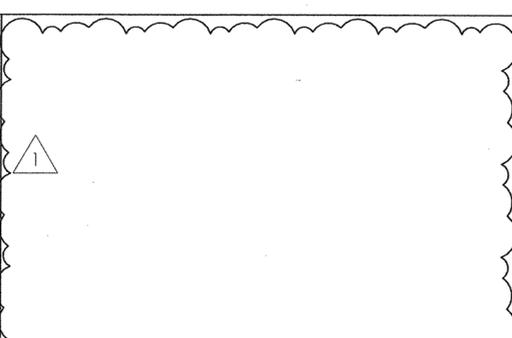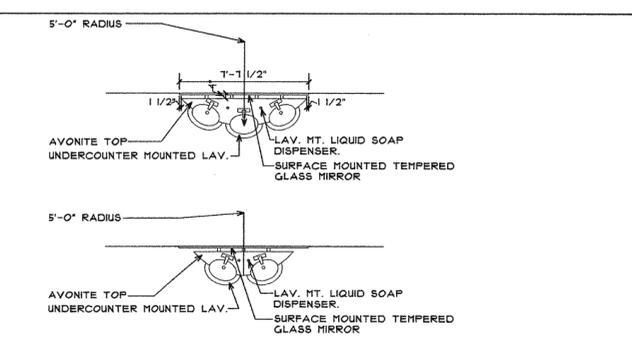

8 TLT. WALL ELEV. - 110, III, 210, 211, 310, 311, 410, & 411  
SCALE: 1/4" = 1'-0"

9 TLT. WALL ELEV. - III, 211, 311, & 411  
SCALE: 1/4" = 1'-0"

10 TLT. WALL ELEV. - 110, 210, 310, & 410  
SCALE: 1/4" = 1'-0"

P:\0-DWG\A604.dwg Plot Date: 02/02/04 10:46 AM Thursday, July 01, 2004