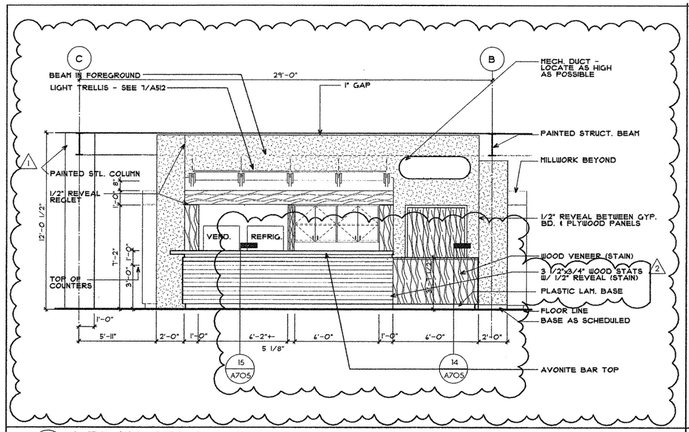

1 BREAK AREA - INTERIOR ELEVATION
SCALE: 1/4" = 1'-0"

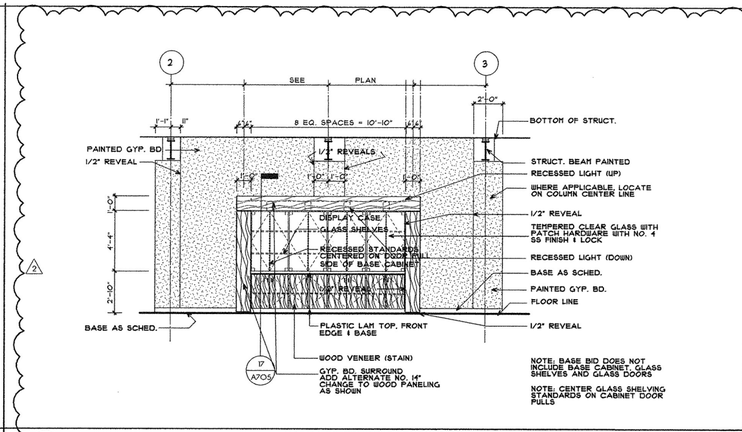

2 DISPLAY CASE - INTERIOR ELEVATION
SCALE: 1/4" = 1'-0"

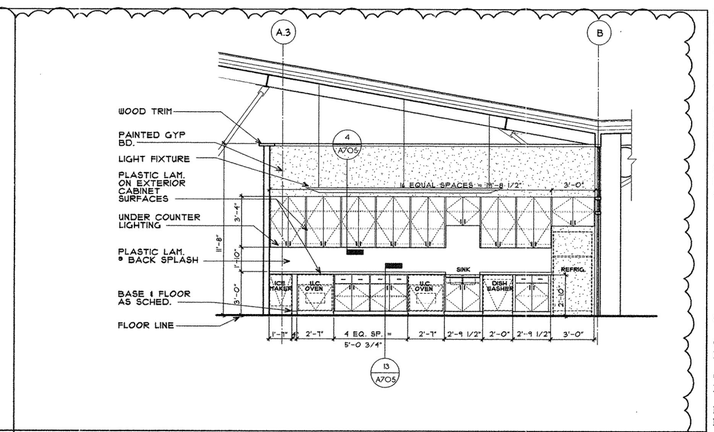

3 BREAK ROOM 461 - INTERIOR ELEVATION
SCALE: 1/4" = 1'-0"

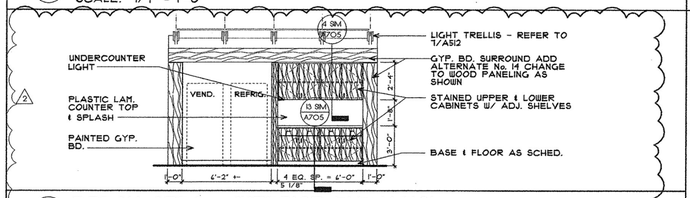

6 BREAK AREA - INTERIOR ELEVATION
SCALE: 1/4" = 1'-0"

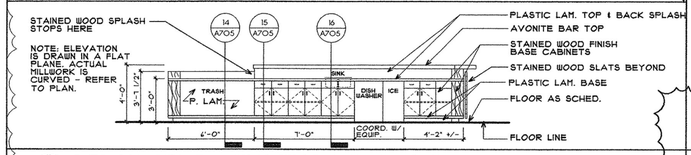

7 BREAK AREA - INTERIOR ELEVATION
SCALE: 1/4" = 1'-0"

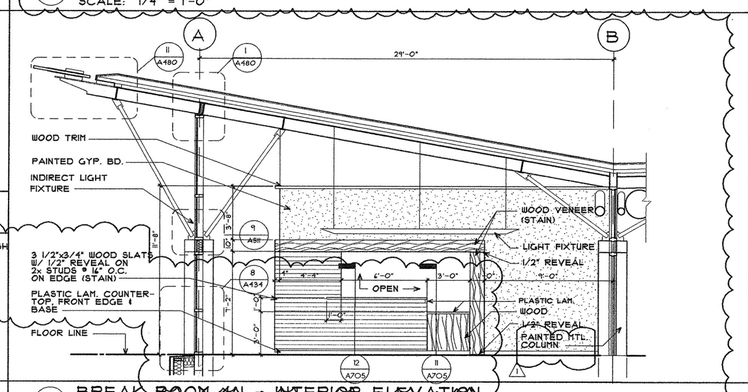

8 BREAK ROOM 461 - INTERIOR ELEVATION
SCALE: 1/4" = 1'-0"

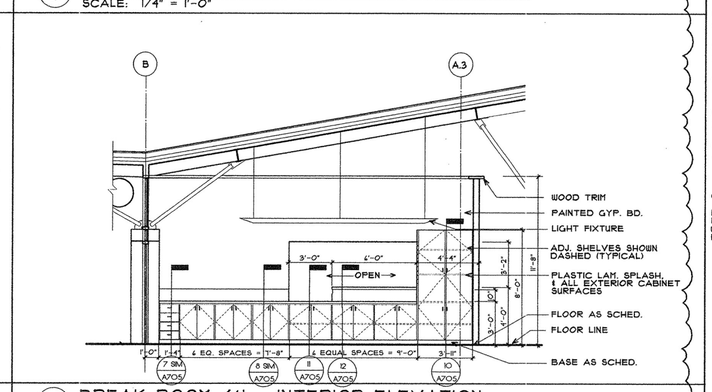

9 BREAK ROOM 461 - INTERIOR ELEVATION
SCALE: 1/4" = 1'-0"

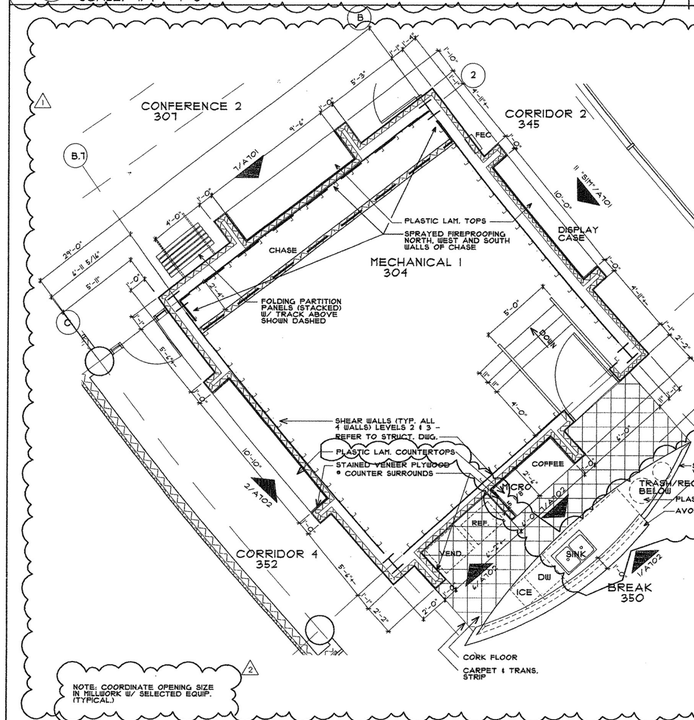

11 MECH. 1 / ROOMS 204 & 304, 404 "SIM." - PLAN
SCALE: 1/4" = 1'-0"

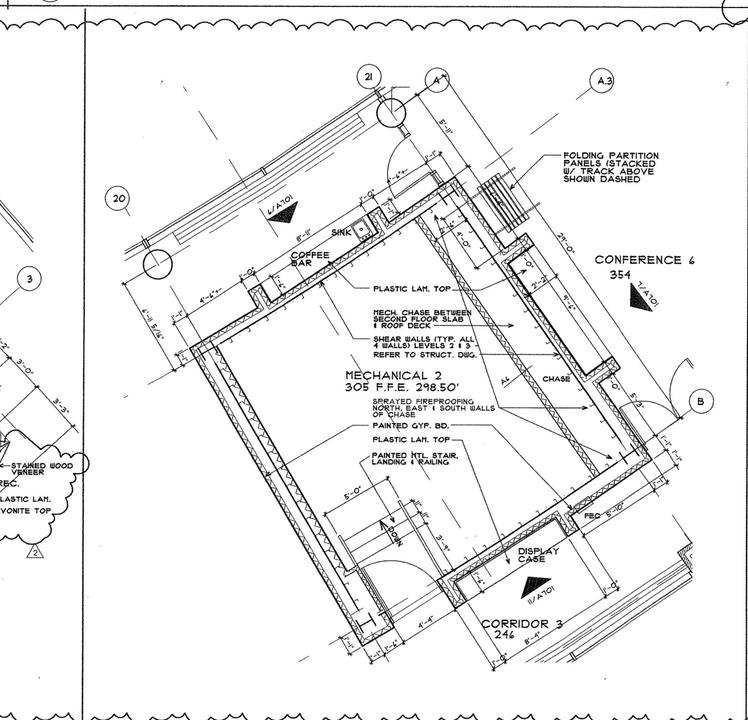

12 MECH. 2 / ROOMS 205 & 305, 405 "SIM." - PLAN
SCALE: 1/4" = 1'-0"

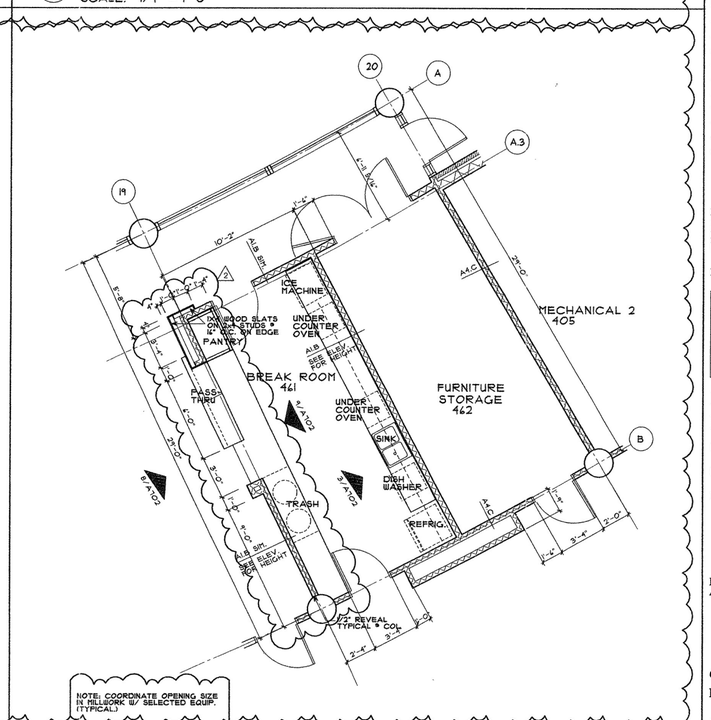

13 BREAK ROOM 461 - PLAN
SCALE: 1/4" = 1'-0"

POLK
STANLEY
YEARY
ARCHITECTS, LTD.

700 SOUTH SCHILLER
LITTLE ROCK, AR 72201
501 378-0878
FAX 372-7629

21 W. MOUNTAIN, SUITE 227
FAYETTEVILLE, AR 72701
479-444-0473

CONSULTANTS:

OWNER'S PROJECT ADVISOR:
MOSES TUCKER REAL ESTATE, INC.

CIVIL ENGINEER:
McCLELLAND ENGINEERS

LANDSCAPE ARCHITECT:
LARSON BURNS SMITH

STRUCTURAL ENGINEER:
CROMWELL ENGINEERS INC.

MECH., ELEC., PLUMB. ENGINEER:
CROMWELL ENGINEERS INC.

SUSTAINABLE CONSULTANT:
BNIM / ELEMENTS

GLOBAL VILLAGE CONSULTANT
CAMBRIDGE SEVEN ASSOCIATES

INTERIOR DESIGNER:
POLK STANLEY YEARY

GENERAL CONTRACTOR:
CDI

GENERAL NOTES:

1. WOOD REVEALS SHALL BE 1/4"x1/4" WITH EDGEBAND AND 1/4" WIDE x 1/2" SPACER. CORNERS SHALL BE 1/4"x1/4" QUIRK WITH EDGEBAND.

NOTES:

ISSUE DATE:
100% GMP
PACKAGE #6
FEBRUARY 2, 2004

REVISIONS:

#	DATE	DESCRIPTION
1	01JUL04	PACKAGE 7
2	30JUL04	A.S.I. 11

HEIFER
INTERNATIONAL
CENTER
OFFICE BUILDING
LITTLE ROCK, ARKANSAS

PSY PROJECT NUMBER:
431C

CONTENTS:
INTERIOR ELEVATIONS

SHEET NUMBER:
A702

P:\0-DWG\VBC\CAP\HeifDrawings\Fc-CD\A\Final\A702-Interior Elevations Monday, August 09, 2004 10:50 AM