

CONSULTANTS:

OWNER'S PROJECT ADVISOR:
MOSES TUCKER REAL ESTATE, INC.

CIVIL ENGINEER:
MCLELLAND ENGINEERS

LANDSCAPE ARCHITECT:
LARSON BURNS SMITH

STRUCTURAL ENGINEER:
CROMWELL ENGINEERS INC.

MECH., ELEC., PLUMB. ENGINEER:
CROMWELL ENGINEERS INC.

SUSTAINABLE CONSULTANT:
BNIM / ELEMENTS

GLOBAL VILLAGE CONSULTANT
CAMBRIDGE SEVEN ASSOCIATES

INTERIOR DESIGNER:
POLK STANLEY YEARY

GENERAL CONTRACTOR:
CDI

GENERAL NOTES:

1. WOOD REVEALS SHALL BE
1/4" x 1/4" WITH EDGE BAND AND 1/4"
WIDE x 1/2" SPACER. CORNERS SHALL
BE 1/4" x 1/4" QUIRK WITH EDGE BAND.

NOTES:

ISSUE DATE:
100% GMP
PACKAGE #6
FEBRUARY 2, 2004

REVISIONS:

#	DATE	DESCRIPTION
1	01 JUL 04	PACKAGE #1
2	02 JUL 04	AS. 1


**HEIFER
INTERNATIONAL
CENTER
OFFICE BUILDING**
LITTLE ROCK, ARKANSAS

PSY PROJECT NUMBER:
431C


CONTENTS:
INTERIOR ELEVATIONS

SHEET NUMBER:


A703

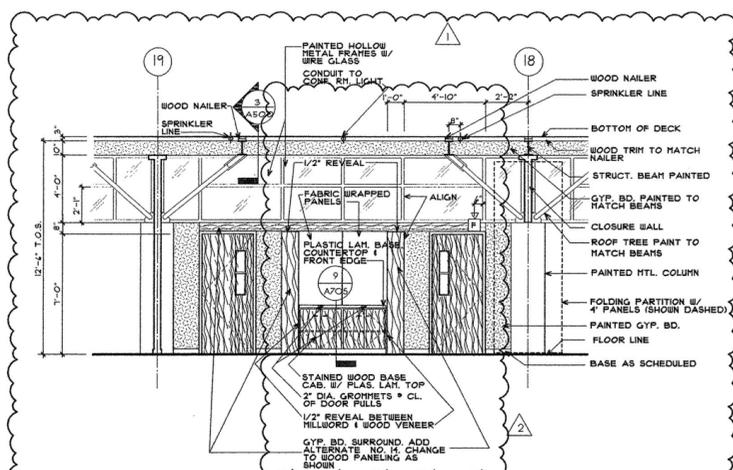

1 CONF. 4 / 449 - INTERIOR ELEVATION (SOUTH)
SCALE: 1/4" = 1'-0"

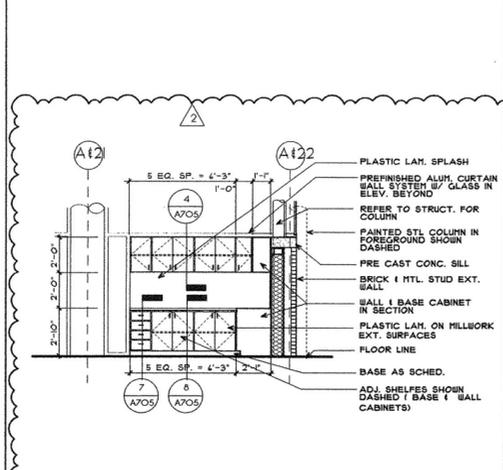


2 MAIL ROOM 154
SCALE: 1/4" = 1'-0"

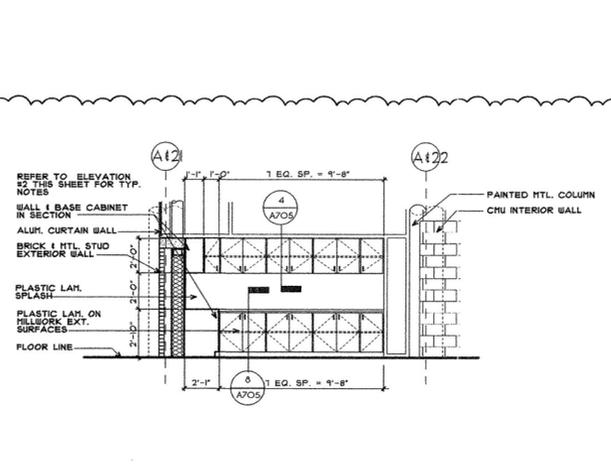


3 MAIL ROOM 154
SCALE: 1/4" = 1'-0"



4 INTERIOR ELEVATION
SCALE: 1/4" = 1'-0"

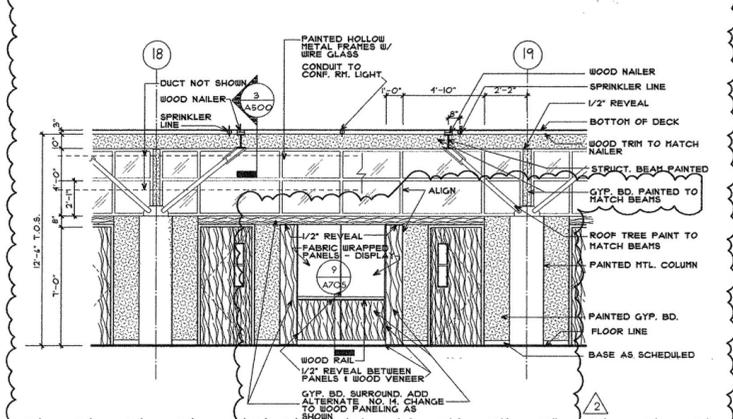

6 CORR. 3 / 446 - INT. ELEVATION (NORTH @ CONF. 4 / 449)
SCALE: 1/4" = 1'-0"

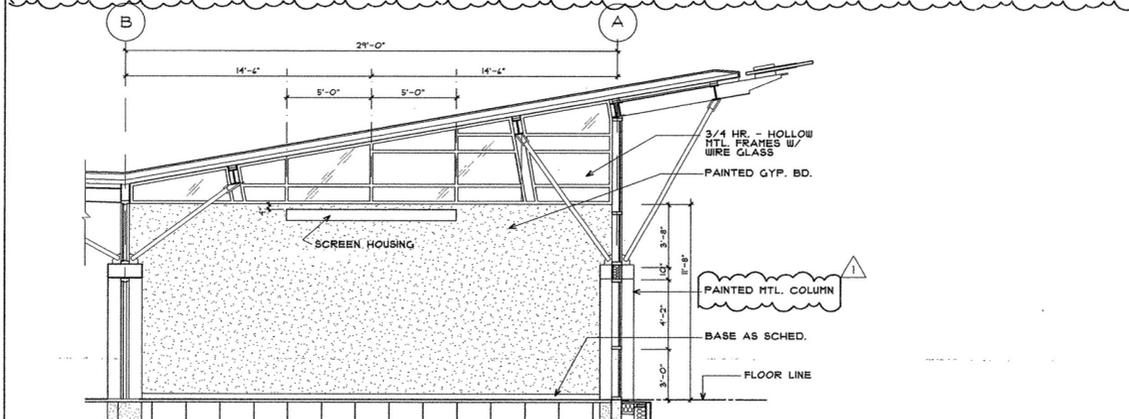

7 CONF. 4 / 449 - INTERIOR ELEVATION (EAST)
SCALE: 1/4" = 1'-0"



8 INTERIOR ELEVATION
SCALE: 1/4" = 1'-0"