

CONSULTANTS:

OWNER'S PROJECT ADVISOR:
MOSES TUCKER REAL ESTATE, INC.

CIVIL ENGINEER:
MCLELLAND ENGINEERS

LANDSCAPE ARCHITECT:
LARSON BURNS SMITH

STRUCTURAL ENGINEER:
CROMWELL ENGINEERS INC.

MECH., ELEC., FLUMB. ENGINEER:
CROMWELL ENGINEERS INC.

SUSTAINABLE CONSULTANT:
BNIM / ELEMENTS

GLOBAL VILLAGE CONSULTANT
CAMBRIDGE SEVEN ASSOCIATES

INTERIOR DESIGNER:
POLK STANLEY YEARY

GENERAL CONTRACTOR:
CDI

GENERAL NOTES:

NOTES:

ISSUE DATE:
100% GMP
PACKAGE #6
FEBRUARY 2, 2004

REVISIONS:

#	DATE	DESCRIPTION
1	02/02/04	PACKAGE 01
2	02/02/04	A.S.I. #


**HEIFER
INTERNATIONAL
CENTER
OFFICE BUILDING**
LITTLE ROCK, ARKANSAS

PSY PROJECT NUMBER:
431C


CONTENTS:
INTERIOR ELEVATIONS

SHEET NUMBER:


A704

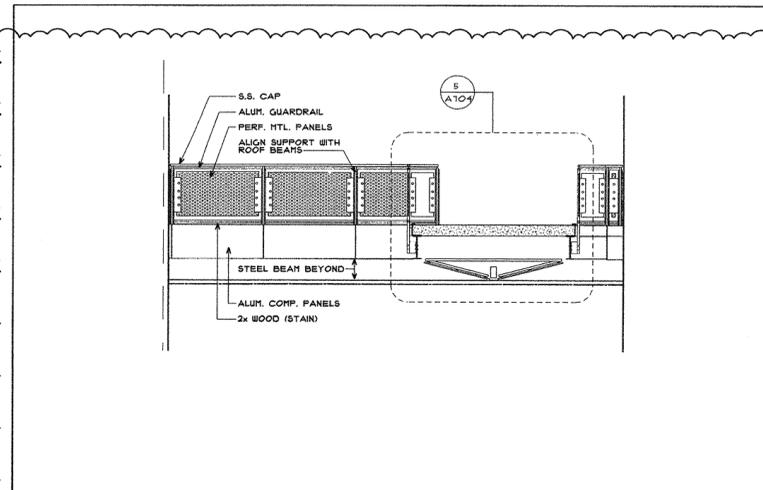


1 GUARDRAIL ELEVATION @ BRIDGE
SCALE: 1/4" = 1'-0"

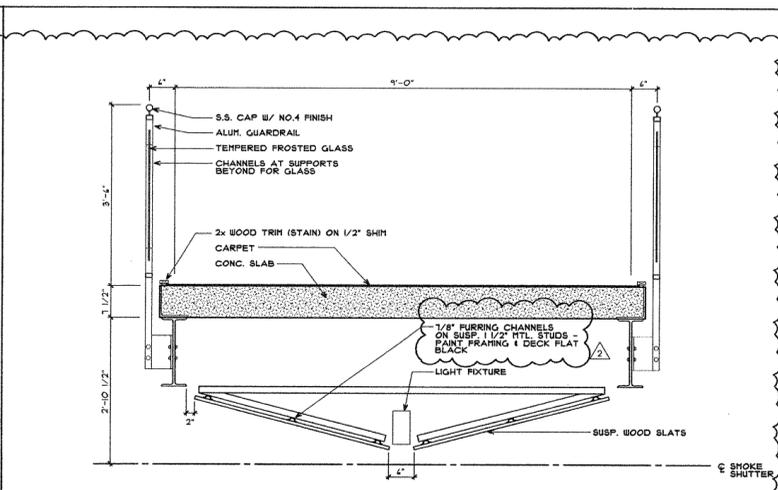


5 BRIDGE SECTION
SCALE: 3/4" = 1'-0"

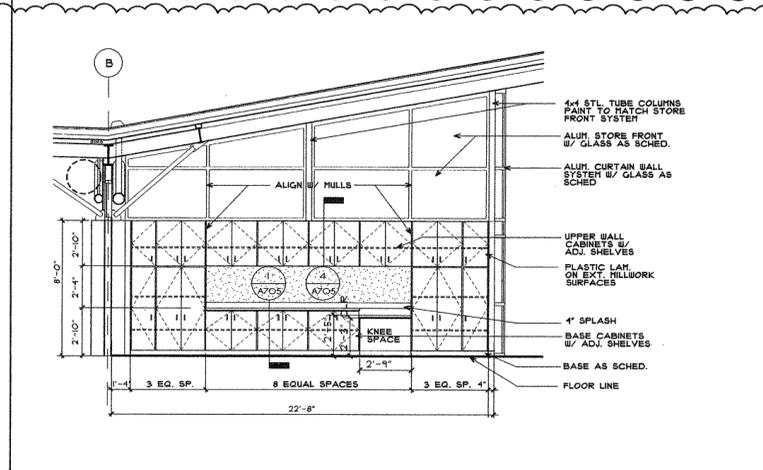


7 WORK ROOM 451- INT. ELEV.
SCALE: 1/4" = 1'-0"

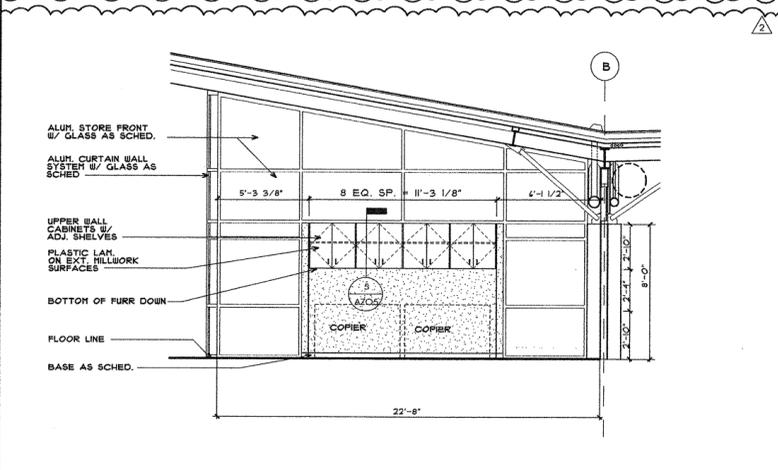


8 WORK ROOM 451- INT. ELEV.
SCALE: 1/4" = 1'-0"

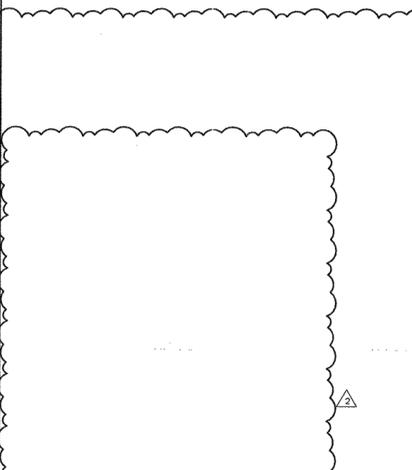


9 NOT USED
SCALE: 1/4" = 1'-0"

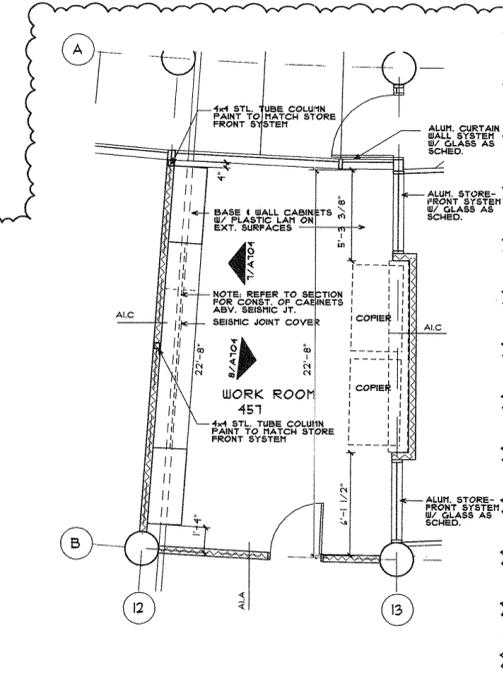


10 WORK ROOM 451- PLAN
SCALE: 1/4" = 1'-0"

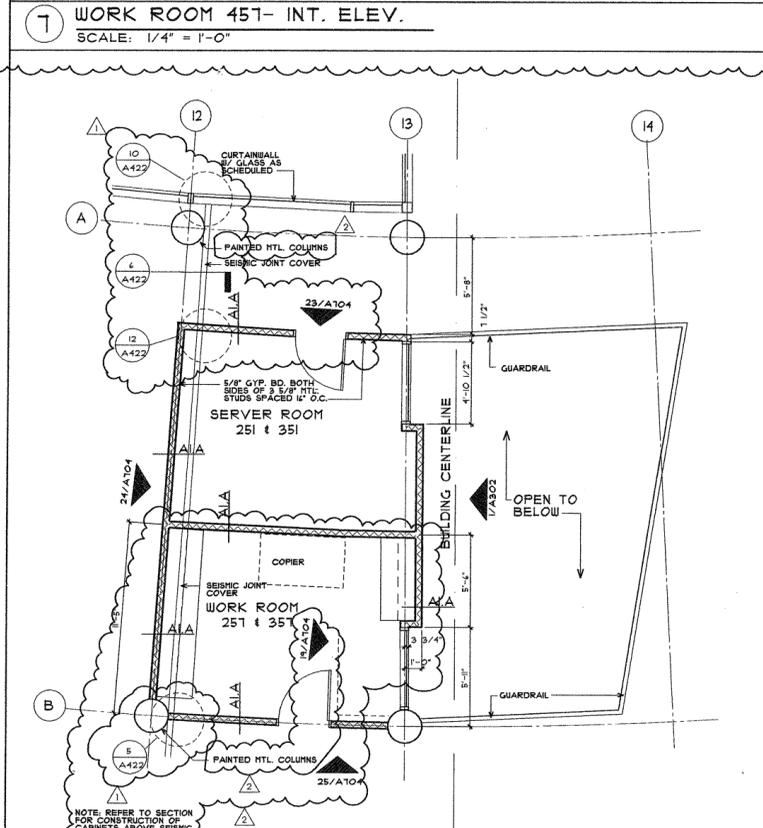


21 WORK RM. 251, 351 & SERVER RM. 251, 351 - PLAN
SCALE: 1/4" = 1'-0"

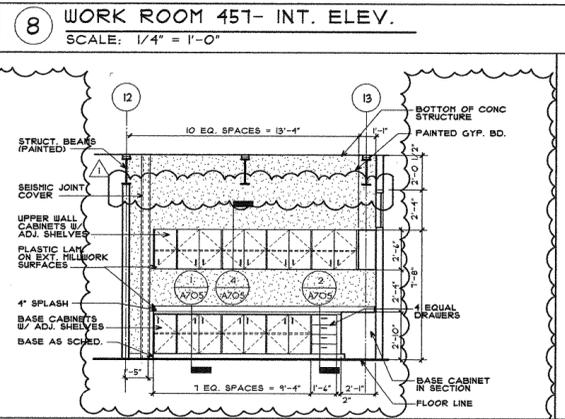


18 WORK ROOM 251 & 351 - INT. ELEV.
SCALE: 1/4" = 1'-0"

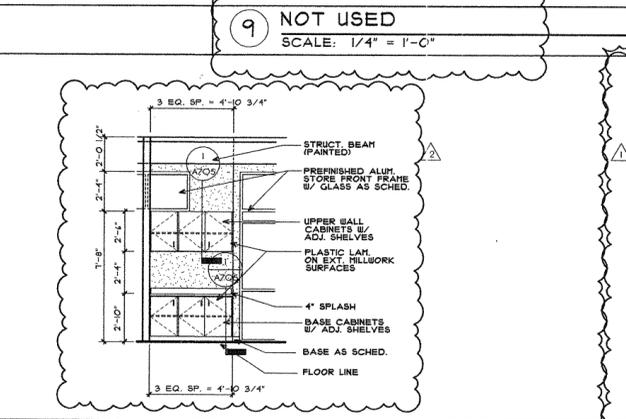


19 WORK ROOM 251 & 351 - INT. ELEV.
SCALE: 1/4" = 1'-0"

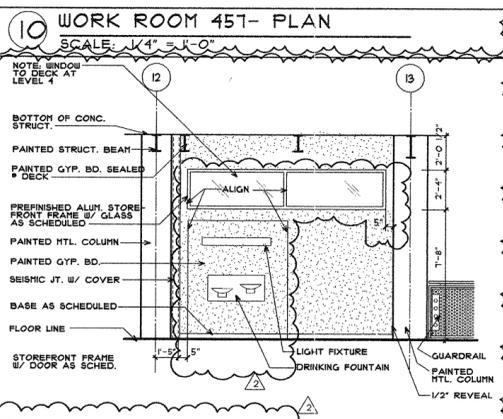


20 DRINKING FOUNTAIN
SCALE: 1/4" = 1'-0"

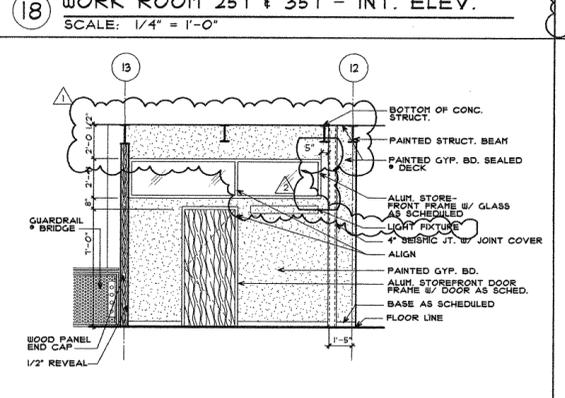

23 SERVER ROOM 251 & 351 - INT. ELEV.
SCALE: 1/4" = 1'-0"

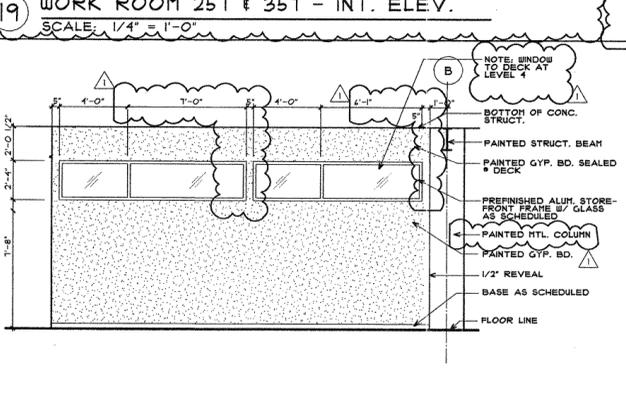

24 SERVER ROOM & WORK ROOM
SCALE: 1/4" = 1'-0"

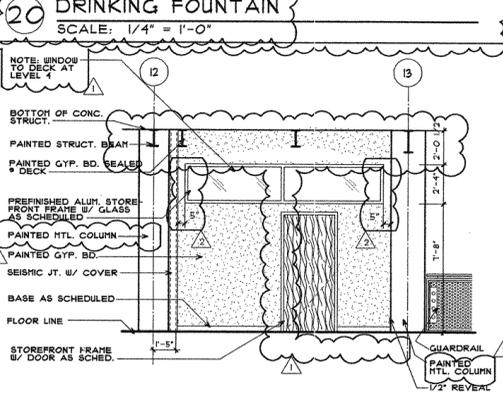

25 WORK ROOM 251 & 351
SCALE: 1/4" = 1'-0"

P:\D-2004\151C-Corridor\Drawings\A704-Arch-Interior-Elevations
 Monday, August 02, 2004 2:28 PM