

**POLK
STANLEY
YEARY**
ARCHITECTS, LTD.
700 SOUTH SCHILLER
LITTLE ROCK, AR 72201
501 378-0878
FAX 372-7629
21 W. MOUNTAIN, SUITE 227
FAYETTEVILLE, AR 72701
479-444-0473

CONSULTANTS:
OWNER'S PROJECT ADVISOR:
MOSES TUCKER REAL ESTATE, INC.
CIVIL ENGINEER:
McCLELLAND ENGINEERS
LANDSCAPE ARCHITECT:
LARSON BURNS SMITH
STRUCTURAL ENGINEER:
CROMWELL ENGINEERS INC.
MECH., ELEC., PLUMB. ENGINEER:
CROMWELL ENGINEERS INC.
SUSTAINABLE CONSULTANT:
BNIM / ELEMENTS
GLOBAL VILLAGE CONSULTANT
CAMBRIDGE SEVEN ASSOCIATES
INTERIOR DESIGNER:
POLK STANLEY YEARY
GENERAL CONTRACTOR:
CDI

GENERAL NOTES:

NOTES:

ISSUE DATE:
STRUCTURAL/FOUNDATION
PACKAGE #4
NOVEMBER 17, 2003

REVISIONS:

#	DATE	DESCRIPTION
1	24FEB04	PACKAGE 04, ADD 05
2	13APR04	PACKAGE 04, ADD 04
3	01JUL04	PACKAGE 01


**HEIFER
INTERNATIONAL
CENTER
OFFICE BUILDING**
LITTLE ROCK, ARKANSAS

PSY PROJECT NUMBER:
431C



CONTENTS:
COLUMN LOCATION PLAN
SHEET NUMBER:

G003

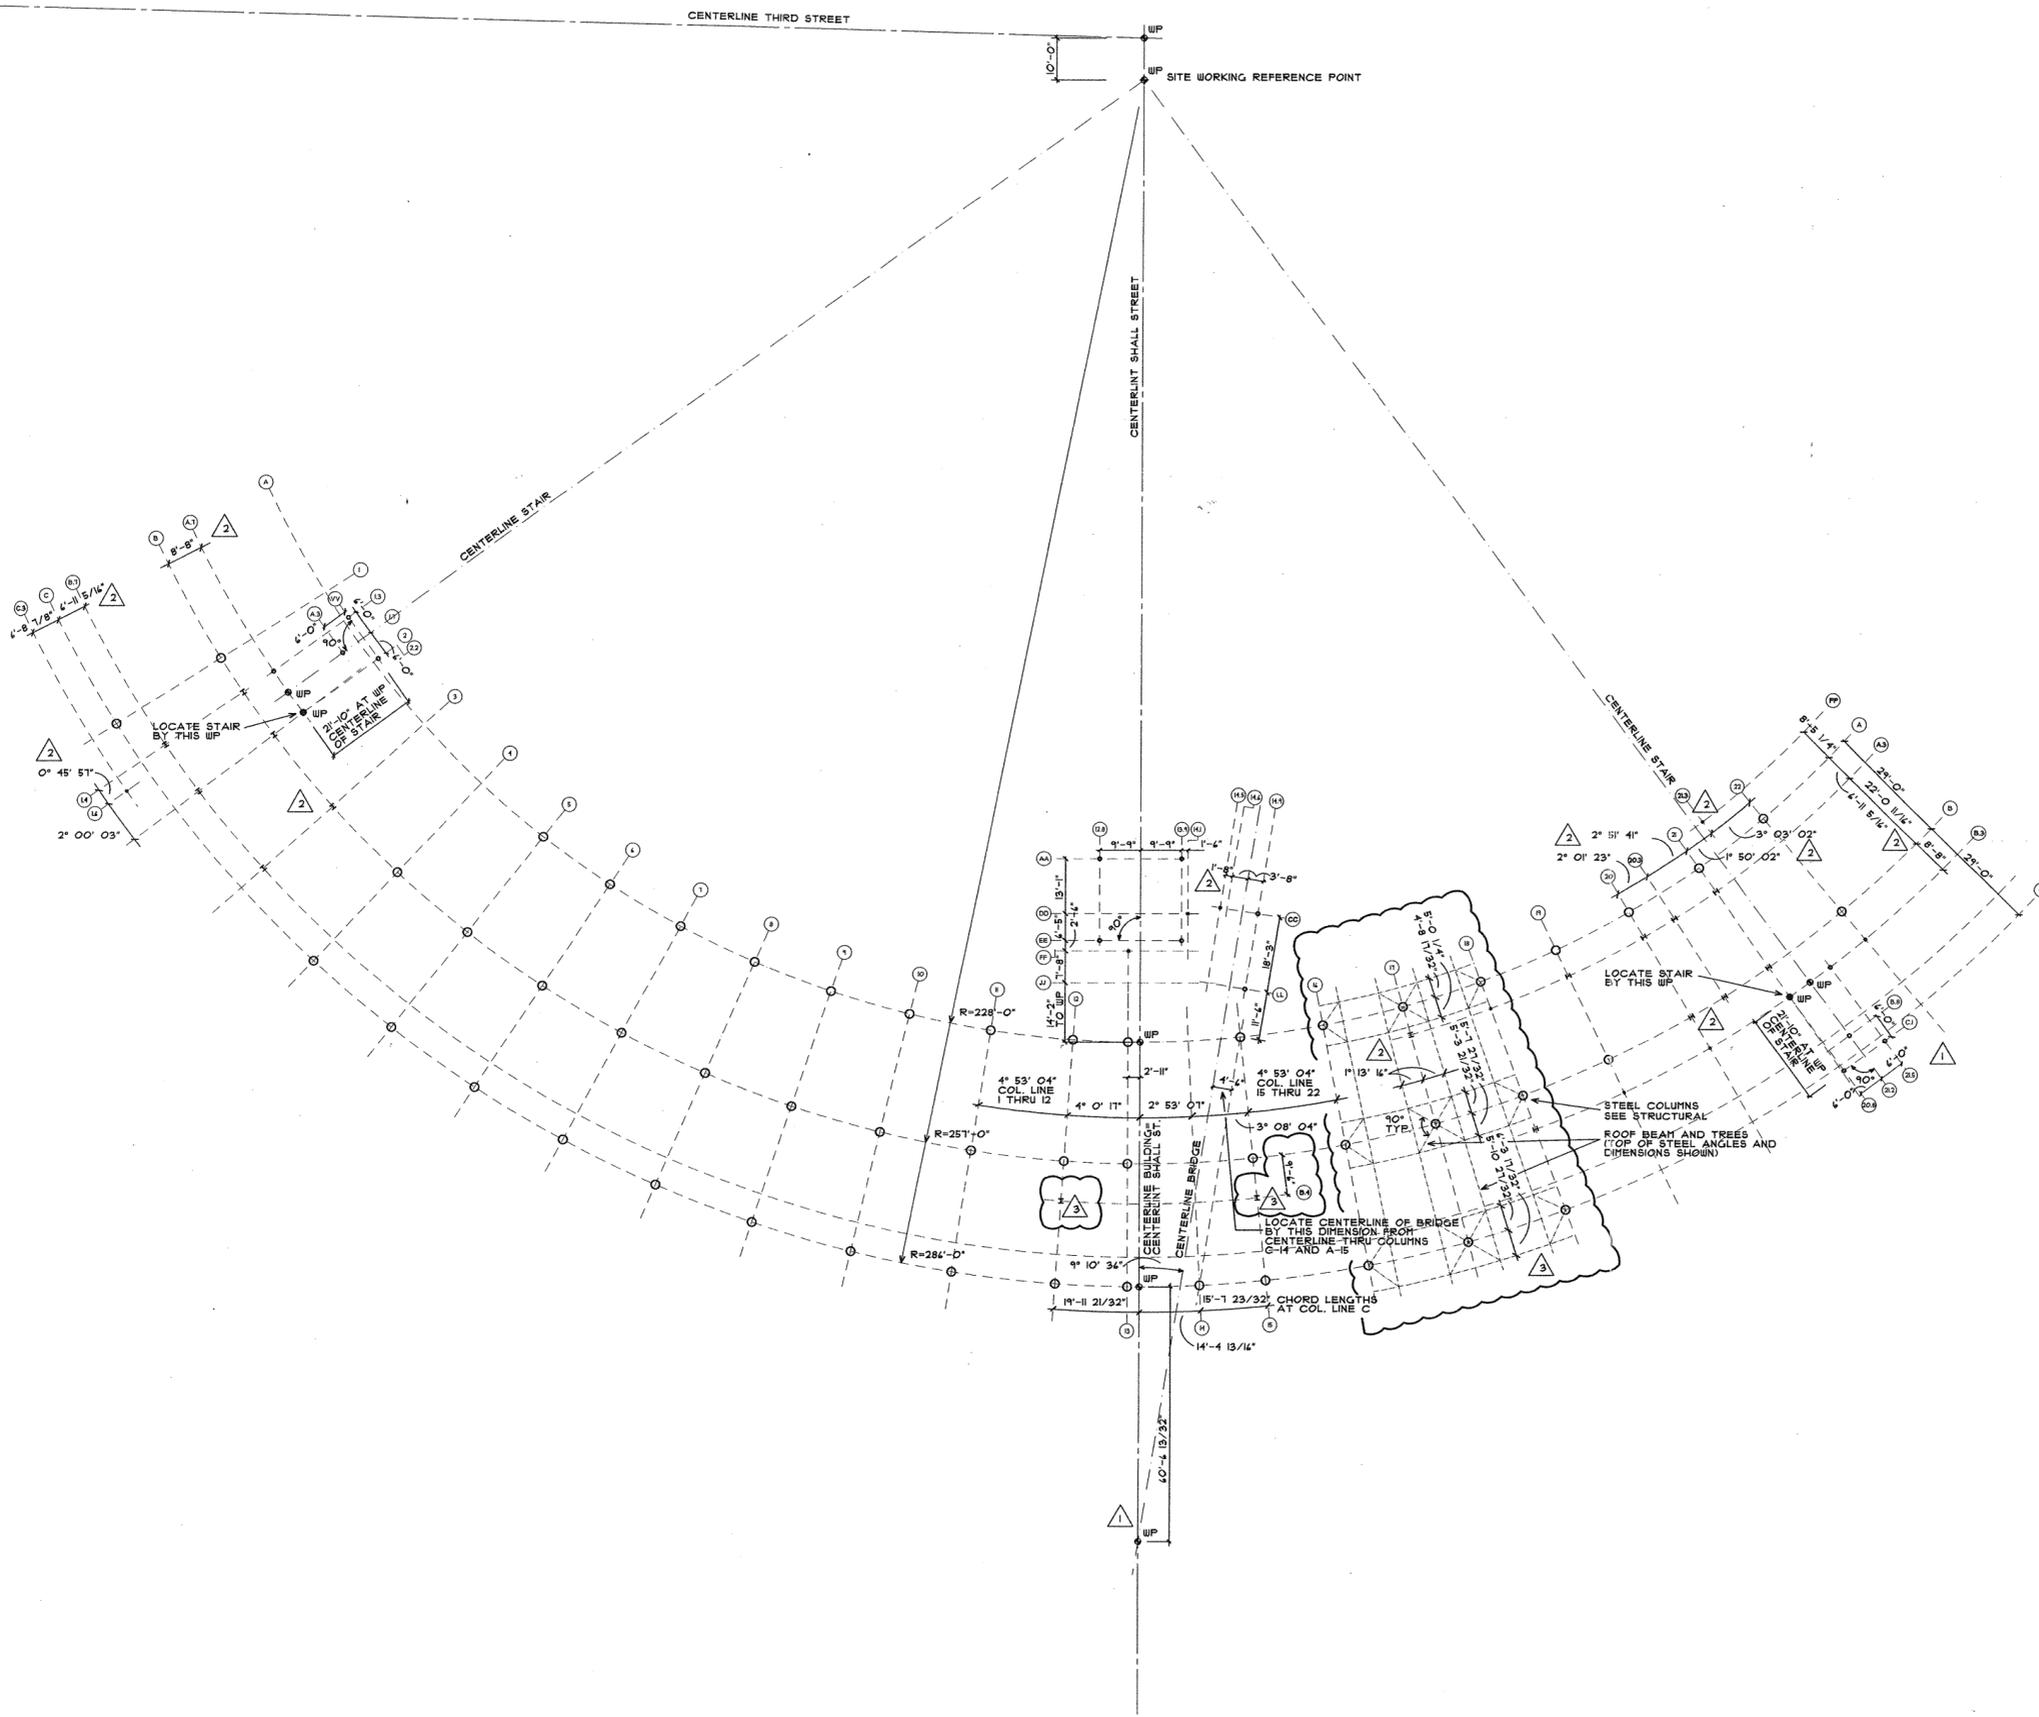

1 COLUMN LOCATION PLAN
SCALE: 1/4" = 1'-0"
REFER TO SHEET TS101 FOR TOPOGRAPHIC AND BOUNDARY SURVEY INFORMATION.



Wednesday, June 30, 2004 2:08 PM
 Wednesday, June 30, 2004 2:08 PM
 Wednesday, June 30, 2004 2:08 PM