

**POLK  
STANLEY  
YEARY  
ARCHITECTS, LTD.**

700 SOUTH SCHILLER  
LITTLE ROCK, AR 72201  
501 378-0878  
FAX 372-7629

21 W. MOUNTAIN, SUITE 227  
FAYETTEVILLE, AR 72701  
479-444-0473

**CONSULTANTS:**  
OWNER'S PROJECT ADVISOR:  
MOSES TUCKER REAL ESTATE, INC.

**CIVIL ENGINEER:**  
MCLELLAND CONSULTING  
ENGINEERS INC.

**LANDSCAPE ARCHITECT:**  
LARSON BURNS SMITH

**STRUCTURAL ENGINEER:**  
CROMWELL ENGINEERS INC.

**MECH., ELEC., PLUMB. ENGINEER:**  
CROMWELL ENGINEERS INC.



**SUSTAINABLE CONSULTANT:**  
BNIM / ELEMENTS

**GLOBAL VILLAGE CONSULTANT:**  
CAMBRIDGE SEVEN ASSOCIATES

**INTERIOR DESIGNER:**  
POLK STANLEY YEARY

**GENERAL CONTRACTOR:**  
CDI CONTRACTORS, INC.

**GENERAL NOTES:**

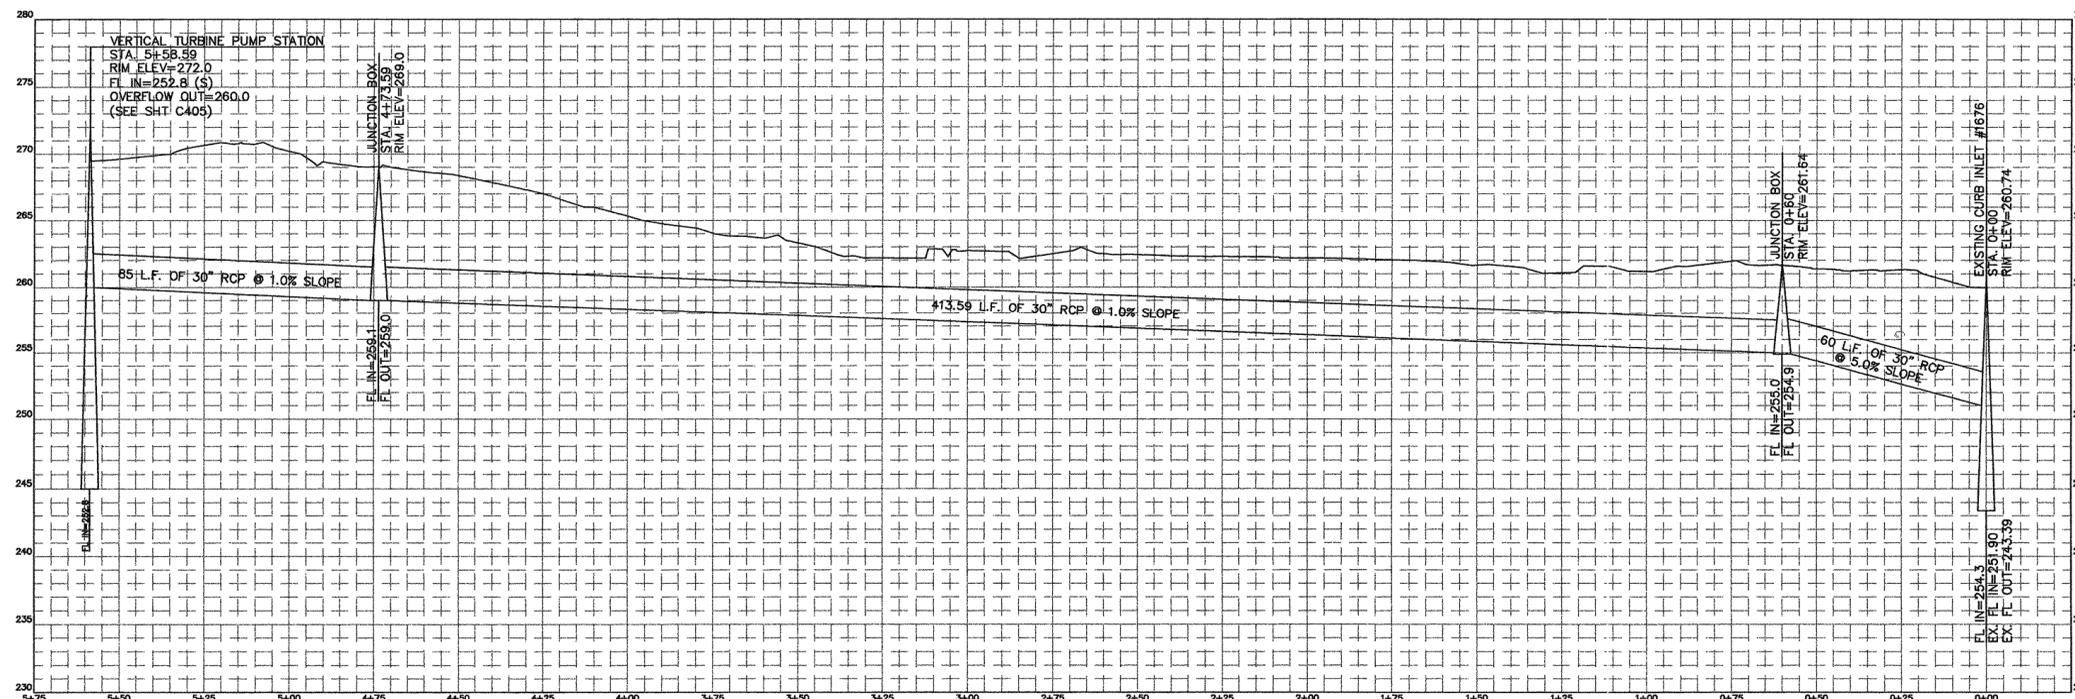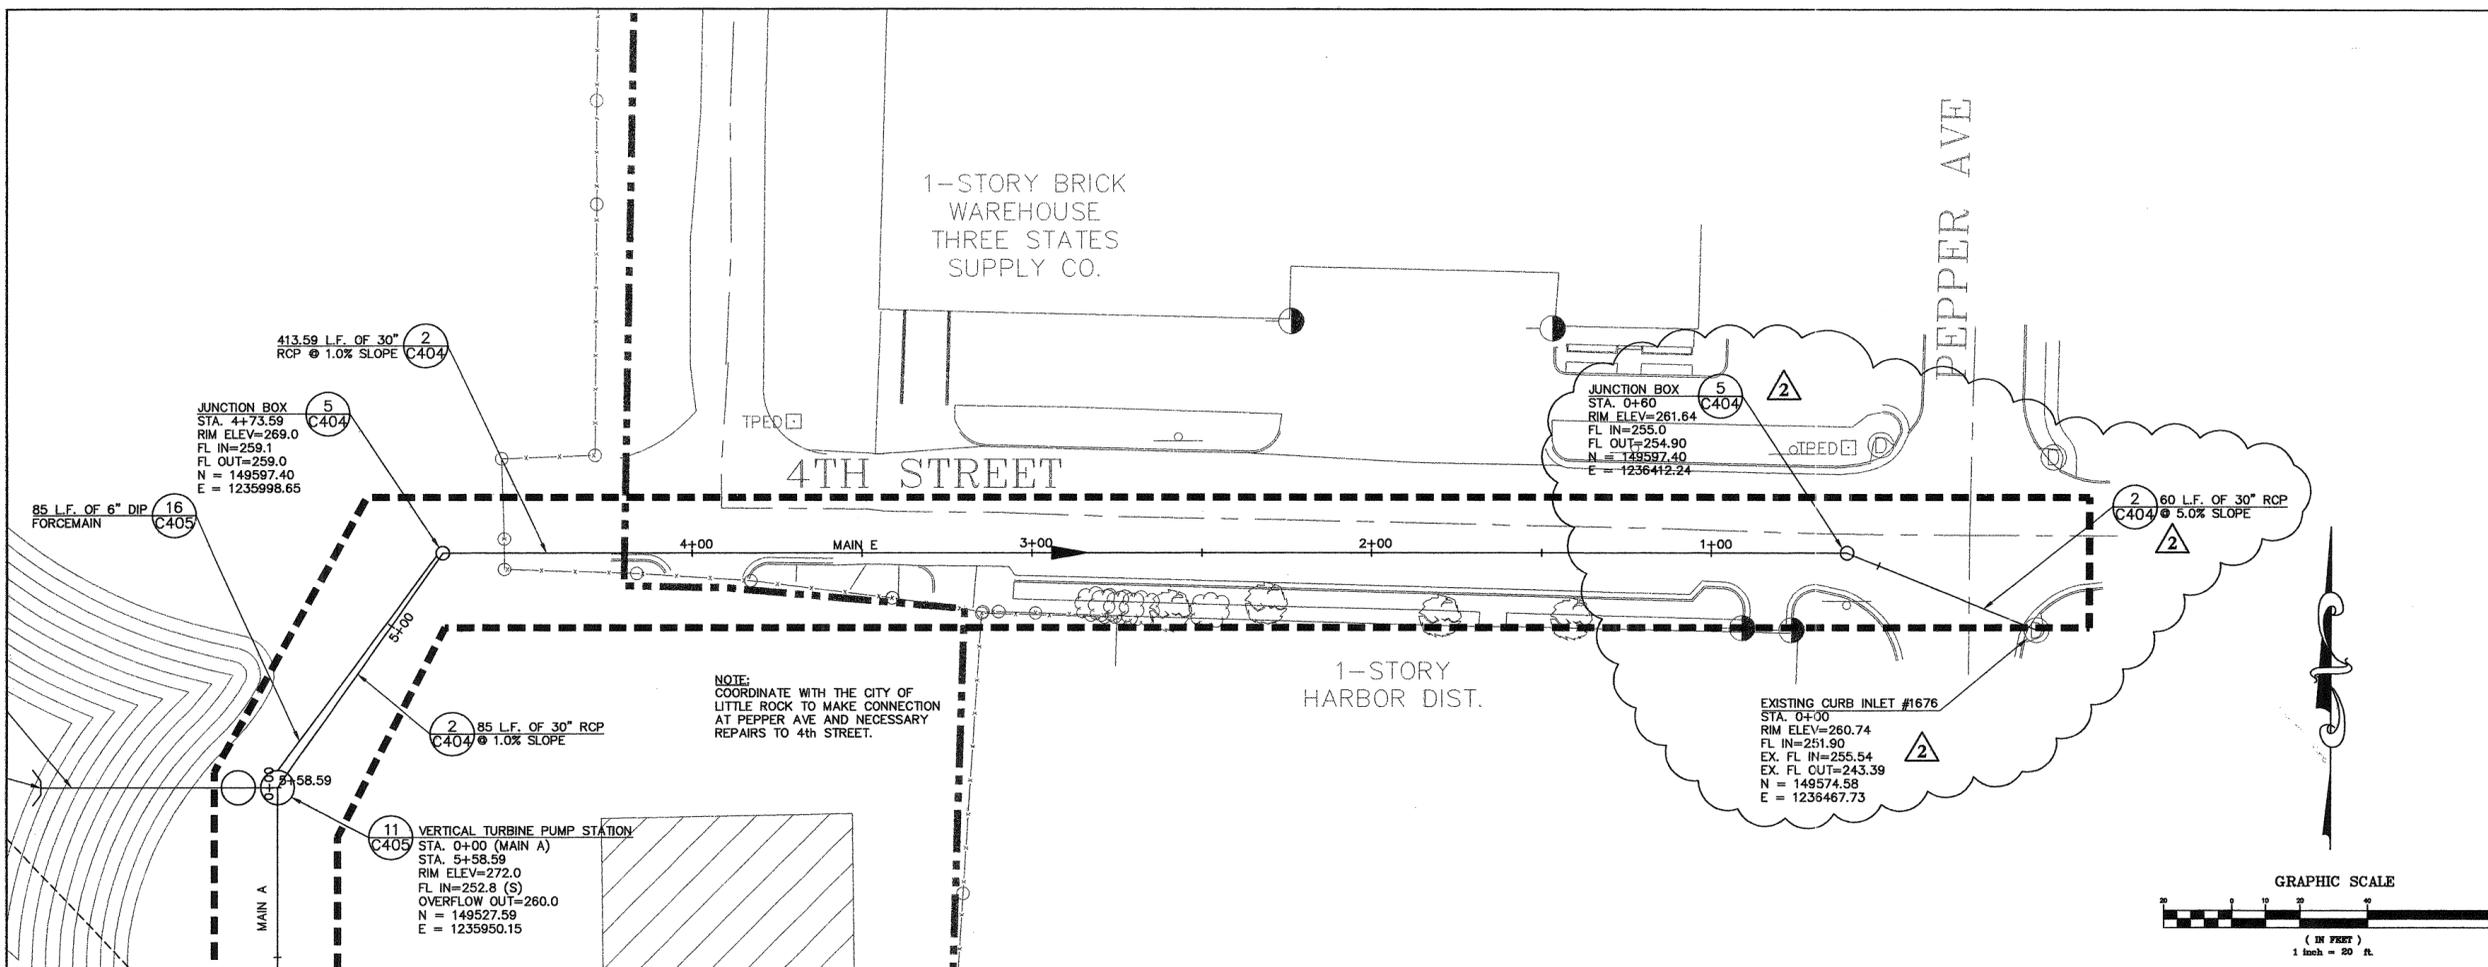

**NOTES:**

\_\_\_\_\_

\_\_\_\_\_

\_\_\_\_\_

\_\_\_\_\_

\_\_\_\_\_

**ISSUE DATE:**  
CORE / SHELL  
BID PACKAGE #5  
DECEMBER 15, 2003

**REVISIONS:**

#	DATE	DESCRIPTION
1	7-1-04	PKG 7 100% ROLL UP
2	8-18-04	ASI 13

**HEIFER  
INTERNATIONAL  
CENTER  
OFFICE BUILDING**  
LITTLE ROCK, ARKANSAS

**PSY PROJECT NUMBER:**  
431C

**CONTENTS:**  
SITE DRAINAGE  
PLAN & PROFILE

**SHEET NUMBER:**

**C409**



ORIGINAL SIGNATURE ON FILE