

**POLK
STANLEY
YEARY**
ARCHITECTS, LTD.

700 SOUTH SCHILLER
LITTLE ROCK, AR 72201
501 378-0878
FAX 372-7629

21 W. MOUNTAIN, SUITE 227
FAYETTEVILLE, AR 72701
479-444-0473

CONSULTANTS:

OWNER'S PROJECT ADVISOR:
MOSES TUCKER REAL ESTATE, INC.

CIVIL ENGINEER:
MCCLELLAND ENGINEERS

LANDSCAPE ARCHITECT:
LARSON BURNS SMITH

STRUCTURAL ENGINEER:
CROMWELL ENGINEERS INC.

MECH. ELEC. PLUMB. ENGINEER:
CROMWELL ENGINEERS INC.

SUSTAINABLE CONSULTANT:
BNIM / ELEMENTS

GLOBAL VILLAGE CONSULTANT
CAMBRIDGE SEVEN ASSOCIATES

INTERIOR DESIGNER:
POLK STANLEY YEARY

GENERAL CONTRACTOR:
CDI

GENERAL NOTES:

NOTES:

ISSUE DATE:
DECEMBER 15, 2003
CORE/SHELL
PACKAGE #5

REVISIONS:


#	DATE	DESCRIPTION
1	1/16/04	ADDENDUM #1
2	4/07/04	PACKAGE 5 - ADDM. 05
3	7/01/04	PACKAGE 7, 100% ROLLUP
4	10/12/04	ASI #20
5	11/29/04	ASI #27

**HEIFER
INTERNATIONAL
CENTER
OFFICE BUILDING**

LITTLE ROCK, ARKANSAS

PSY PROJECT NUMBER:
431C

CONTENTS:
SECOND FLOOR LIGHTING
PLAN - EAST END
SHEET NUMBER:
E102a

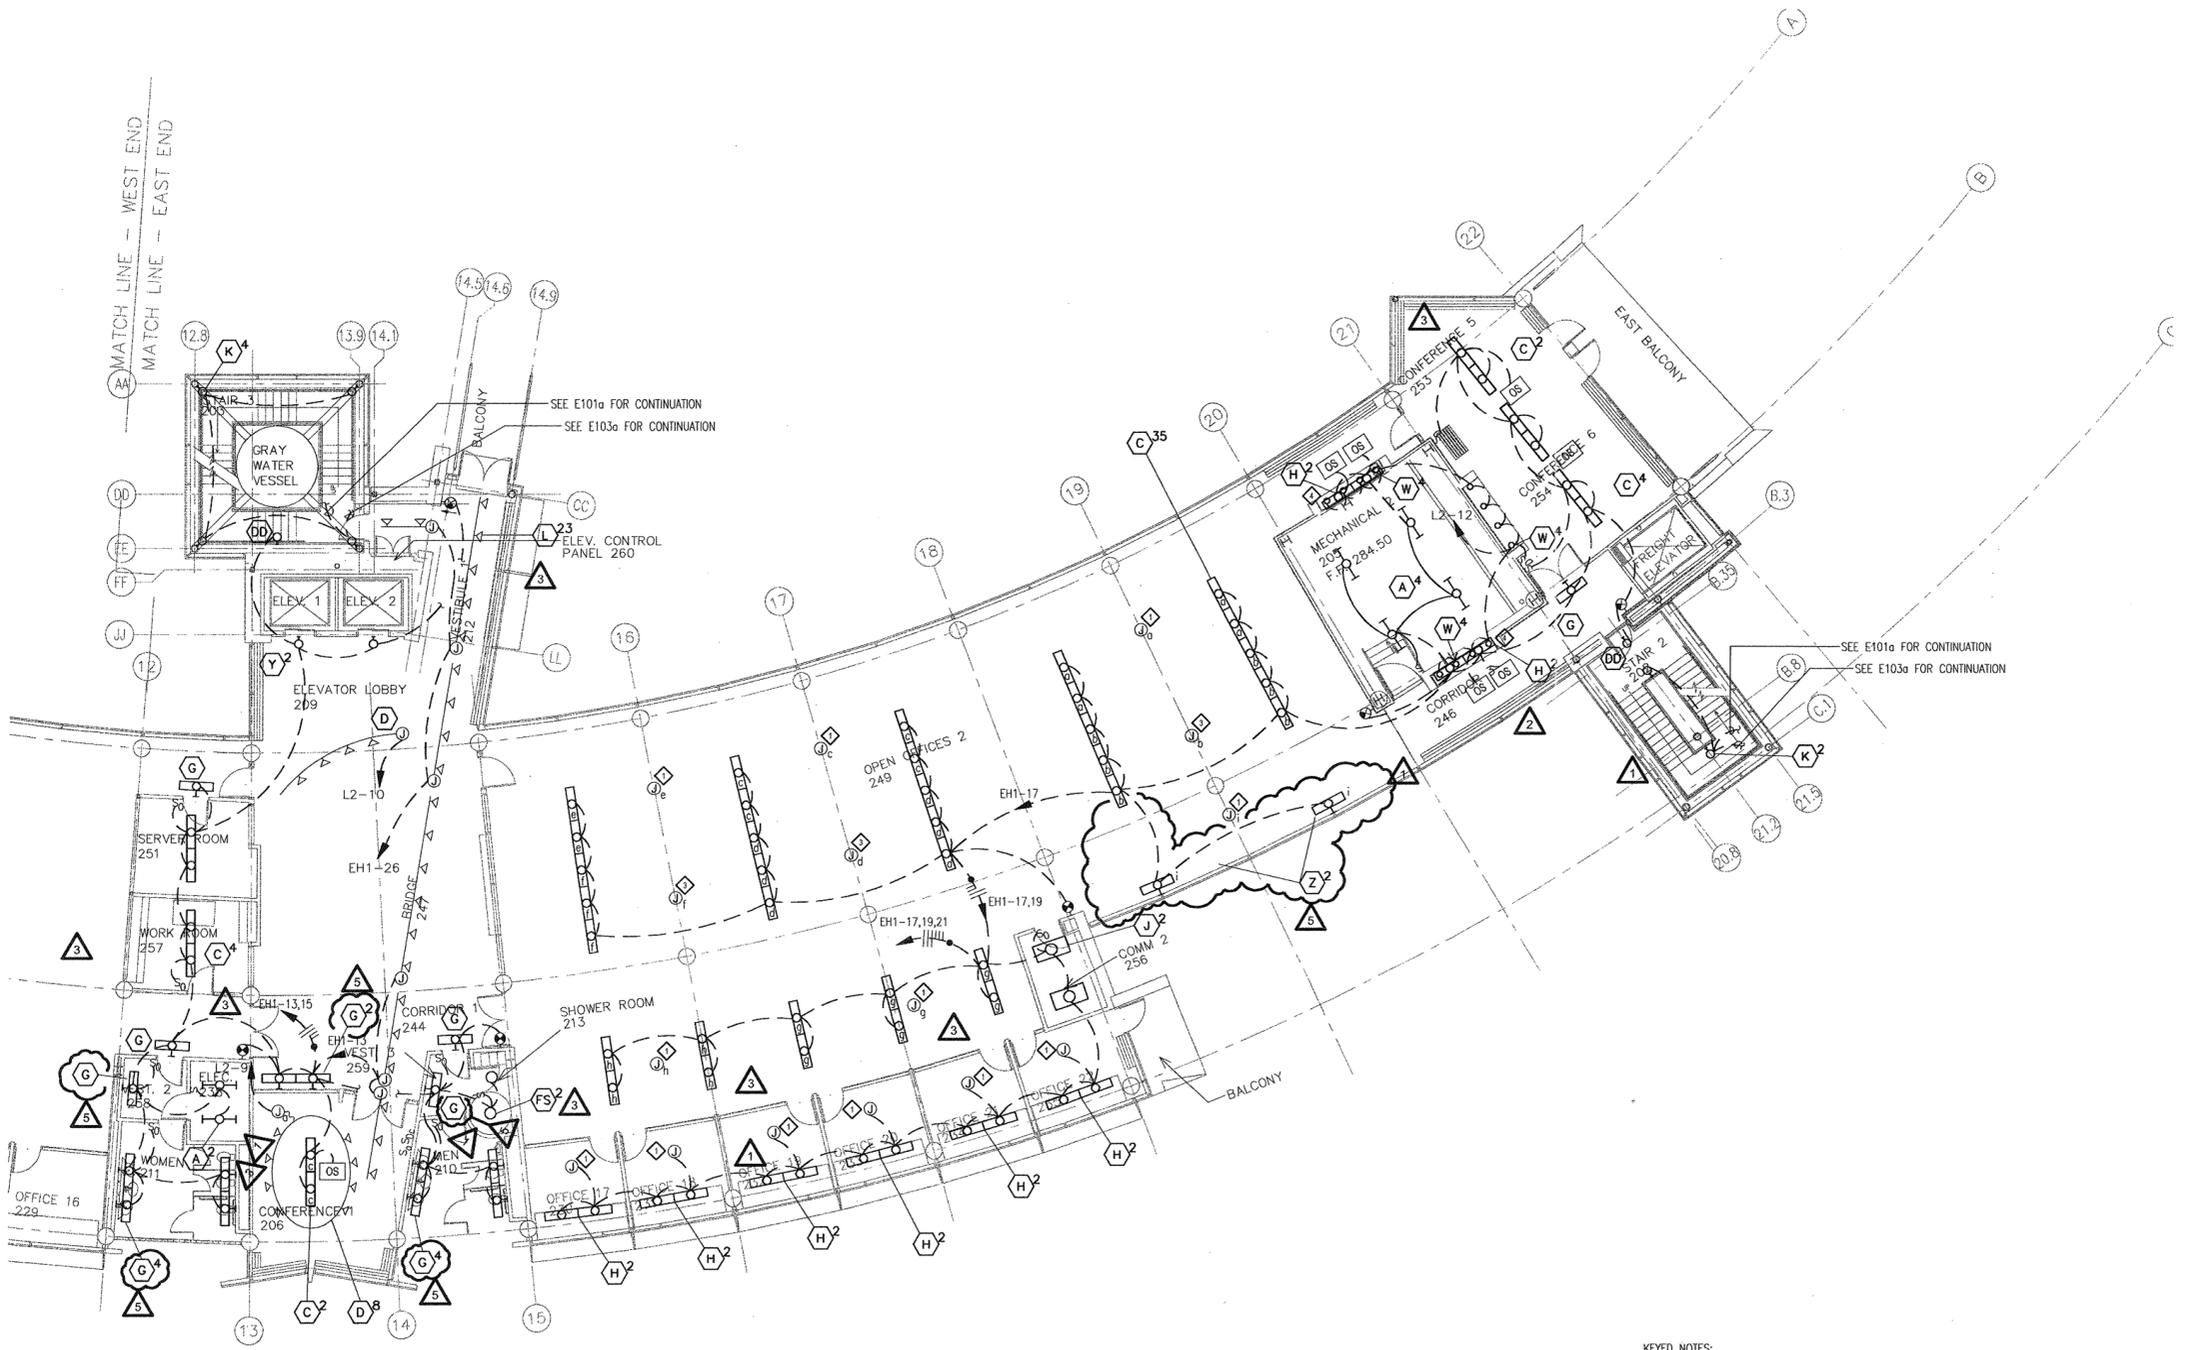

- KEYED NOTES:**
- 1 DAYLIGHT SENSOR / OCCUPANCY SENSOR.
 - 2 NOT USED
 - 3 DAYLIGHT SENSOR.
 - 4 SEE ARCHITECTURAL INTERIOR ELEVATIONS FOR LOCATION OF H AND L TYPE LIGHTS.

MATCH LINE -- WEST END
MATCH LINE -- EAST END

1 SECOND FLOOR LIGHTING PLAN - EAST END
SCALE: 1/8" = 1'-0"

