

CONSULTANTS:

OWNER'S PROJECT ADVISOR:
MOSES TUCKER REAL ESTATE, INC.

CIVIL ENGINEER:
MCCLELLAND ENGINEERS

LANDSCAPE ARCHITECT:
LARSON BURNS SMITH

STRUCTURAL ENGINEER:
CROMWELL ENGINEERS INC.

MECH., ELEC., PLUMB. ENGINEER:
CROMWELL ENGINEERS INC.

SUSTAINABLE CONSULTANT:
BNIM / ELEMENTS

GLOBAL VILLAGE CONSULTANT
CAMBRIDGE SEVEN ASSOCIATES

INTERIOR DESIGNER:
POLK STANLEY YEARY

GENERAL CONTRACTOR:
CDI

GENERAL NOTES:

NOTES:

ISSUE DATE:
DECEMBER 15, 2003
CORE/SHELL
PACKAGE #5

REVISIONS:

#	DATE	DESCRIPTION
1	11/16/04	ADDENDUM #1
2	4/07/04	PACKAGE 5 - ADDM. 05
3	7/01/04	PACKAGE 7.100% ROLLUP
4	10/12/04	ASI #20
5	11/29/04	ASI #27


**HEIFER
INTERNATIONAL
CENTER
OFFICE BUILDING**

LITTLE ROCK, ARKANSAS

PSY PROJECT NUMBER:
431C

CONTENTS:
FOURTH FLOOR LIGHTING
PLAN - EAST END
SHEET NUMBER:

E104a

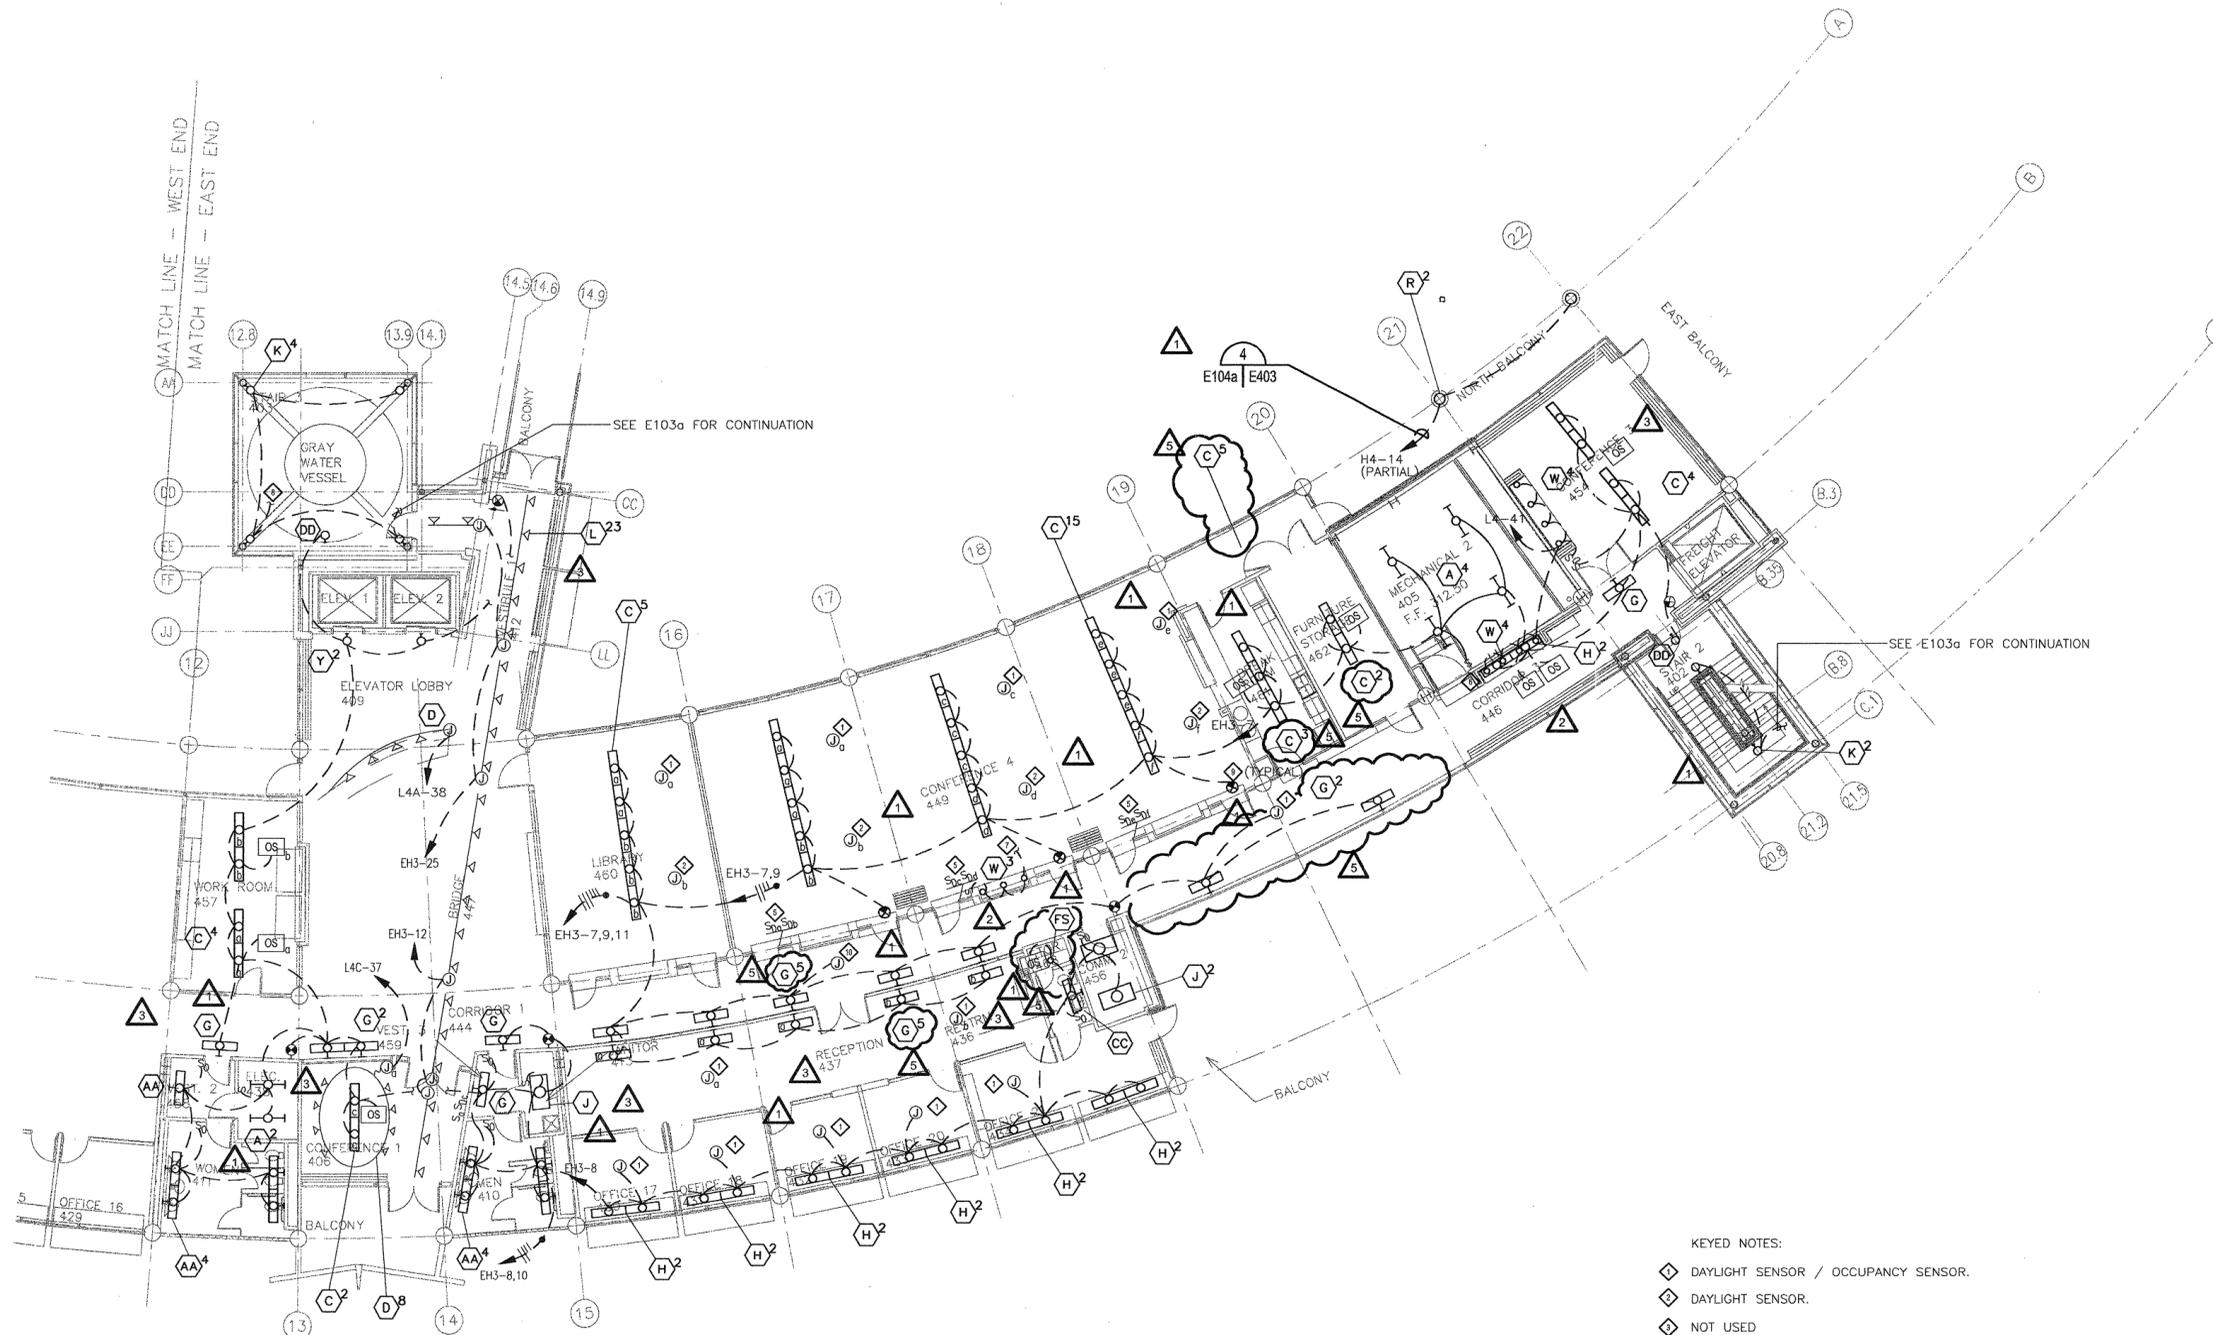

- KEYED NOTES:**
- ◇ DAYLIGHT SENSOR / OCCUPANCY SENSOR.
 - ◇ DAYLIGHT SENSOR.
 - ◇ NOT USED
 - ◇ CONNECT SUCH THAT IF EITHER SENSOR DETECTS OCCUPANCY, LIGHTS SHALL COME ON.
 - ◇ SWITCHES SHALL ONLY CONTROL LIGHTS WHEN OCCUPANCY IS DETECTED.
 - △ SEE ARCHITECTURAL INTERIOR ELEVATIONS FOR LOCATION OF H AND L TYPE LIGHTS.
 - ◇ CIRCUIT TO NEAREST 120V CIRCUIT.
 - ◇ PROVIDE TWO ADDITIONAL TYPE K FIXTURES AND ONE ADDITIONAL TYPE DD FIXTURE FOR STAIR TO ROOF.
 - ◇ SEE ARCHITECTURAL FOR MOUNTING OF EXIT LIGHTS.
 - ◇ OCCUPANCY SENSOR.

1 FOURTH FLOOR LIGHTING PLAN - EAST END
SCALE: 1/8" = 1'-0"



DATE PLOTTED: 12/15/03