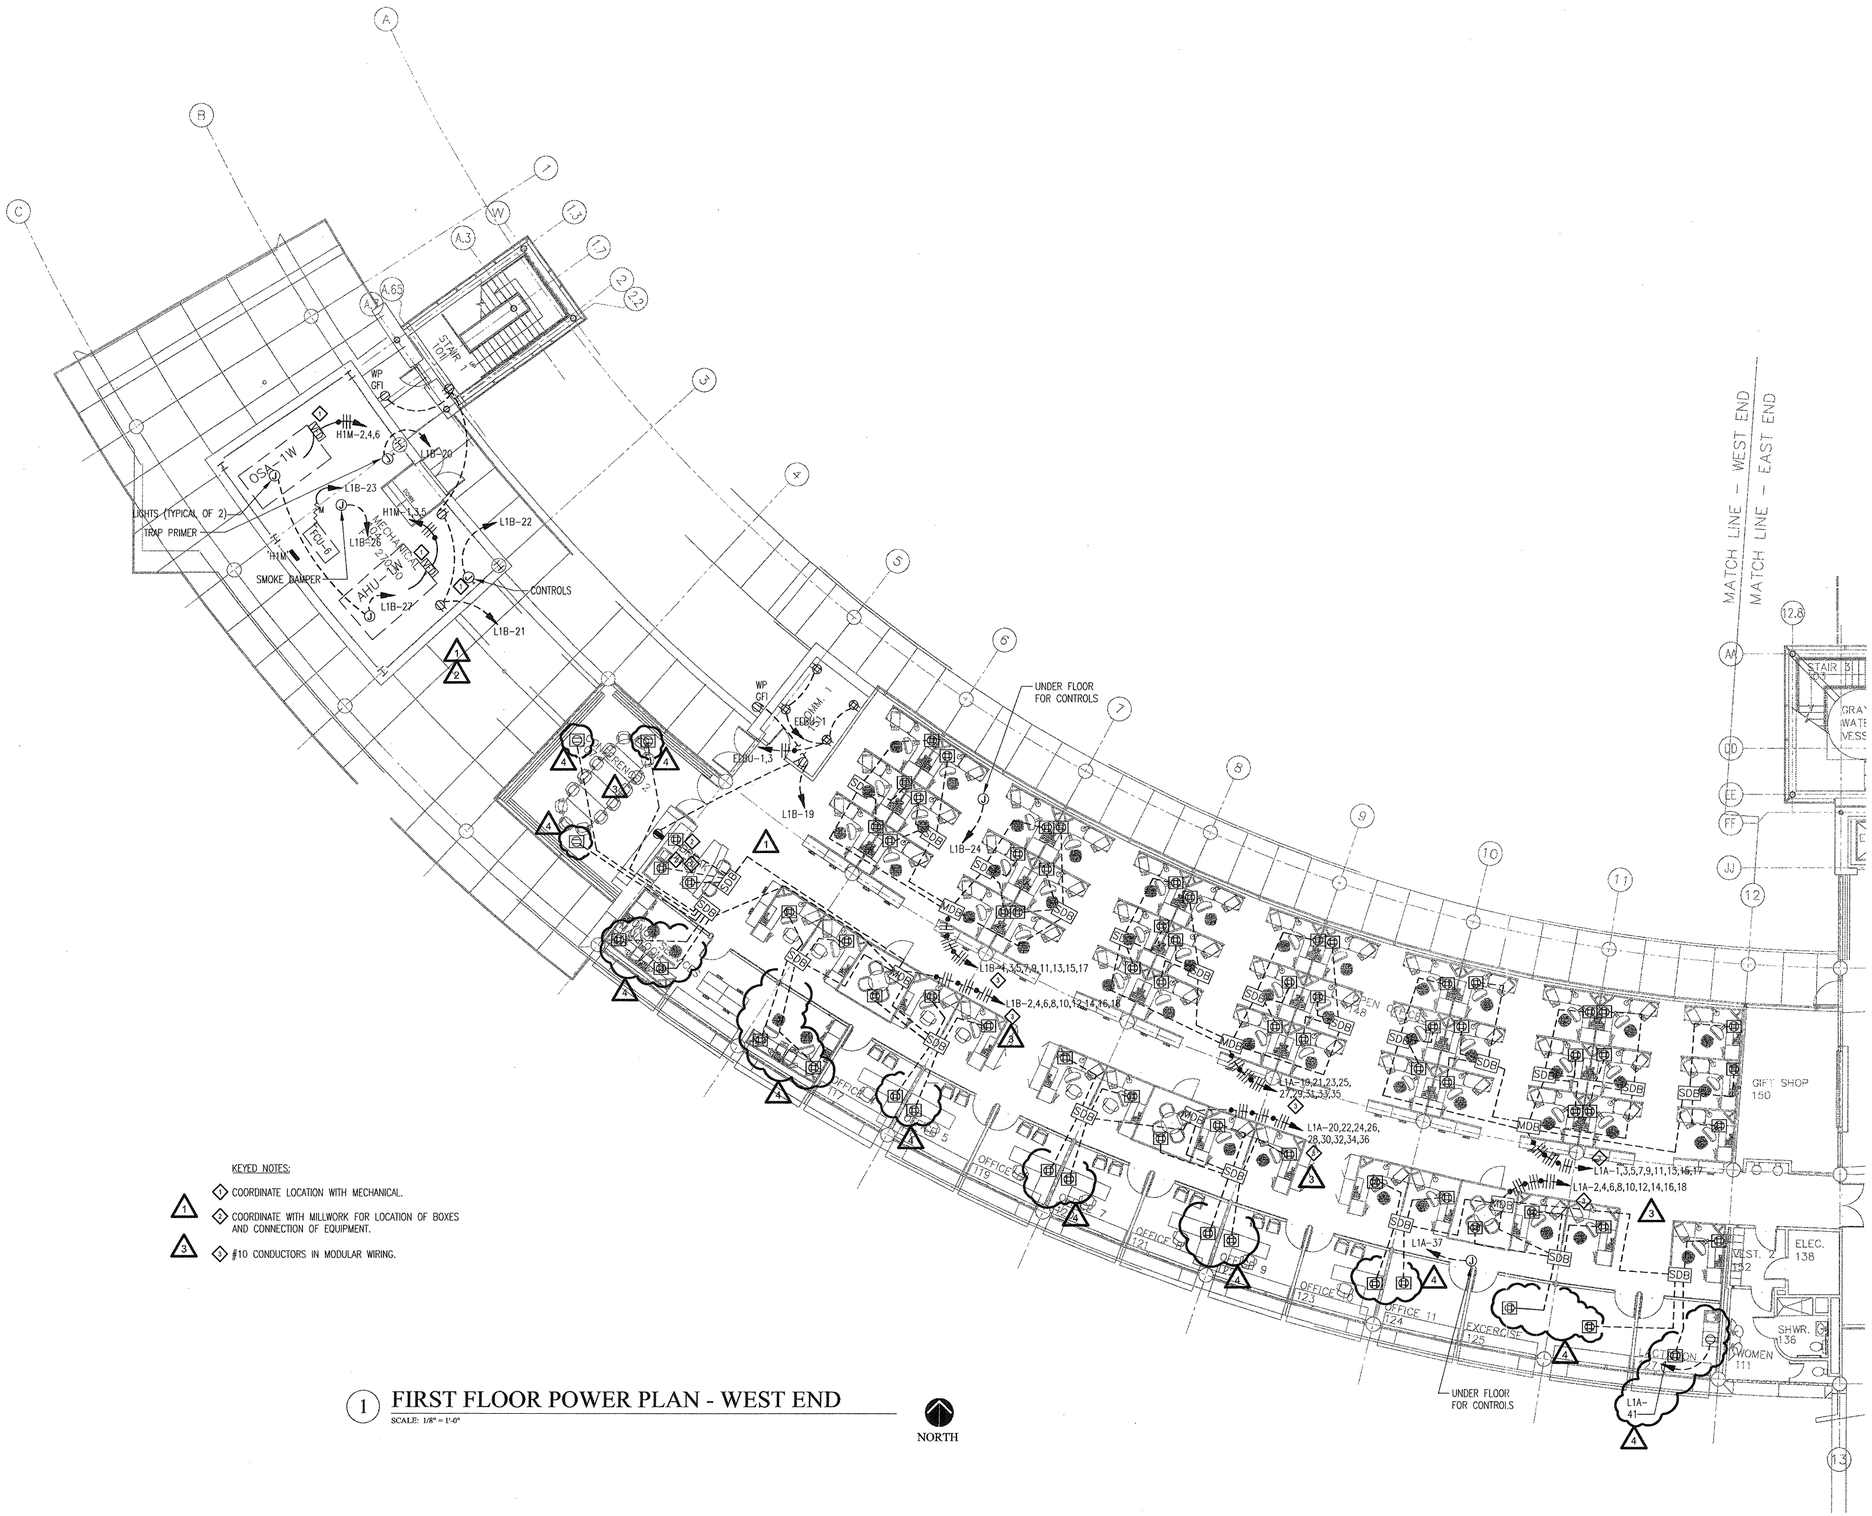

KEYED NOTES:

1. COORDINATE LOCATION WITH MECHANICAL.
2. COORDINATE WITH MILLWORK FOR LOCATION OF BOXES AND CONNECTION OF EQUIPMENT.
3. #10 CONDUCTORS IN MODULAR WIRING.

1 FIRST FLOOR POWER PLAN - WEST END

SCALE: 1/8" = 1'-0"

NORTH

POLK STANLEY YEARY
ARCHITECTS, LTD.

700 SOUTH SCHILLER
LITTLE ROCK, AR 72201
501 378-0878
FAX 372-7629

21 W. MOUNTAIN, SUITE 227
FAYETTEVILLE, AR 72701
479-444-0473

CONSULTANTS:

OWNER'S PROJECT ADVISOR:
MOSES TUCKER REAL ESTATE, INC.

CIVIL ENGINEER:
McCLELLAND ENGINEERS

LANDSCAPE ARCHITECT:
LARSON BURNS SMITH

STRUCTURAL ENGINEER:
CROMWELL ENGINEERS INC.

MECH., ELEC., PLUMB. ENGINEER:
CROMWELL ENGINEERS INC.

SUSTAINABLE CONSULTANT:
BNIM / ELEMENTS

GLOBAL VILLAGE CONSULTANT
CAMBRIDGE SEVEN ASSOCIATES

INTERIOR DESIGNER:
POLK STANLEY YEARY

GENERAL CONTRACTOR:
CDI

GENERAL NOTES:

NOTES:

ISSUE DATE:
DECEMBER 15, 2003
CORE/SHELL
PACKAGE #5

REVISIONS:

#	DATE	DESCRIPTION
1	1/16/04	ADDENDUM #1
2	1/23/04	PACKAGE 5 - ADDM. 02
3	7/01/04	PACKAGE 7,100% ROLLUP
4	11/29/04	ASI #27

HEIFER INTERNATIONAL CENTER OFFICE BUILDING

LITTLE ROCK, ARKANSAS

PSY PROJECT NUMBER:
431C

CONTENTS:
FIRST FLOOR POWER PLAN - WEST END

SHEET NUMBER:
E201b

CERTIFICATE OF AUTHORIZATION
CROMWELL ENGINEERS
#56
ARKANSAS

STATE OF ARKANSAS
REGISTERED PROFESSIONAL ENGINEER
No. 9401
PAMELA S. FLOYD
12/15/03