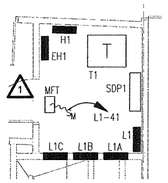

1 ELECTRICAL ROOM 138
E201b | E402 1/4"=1'-0"

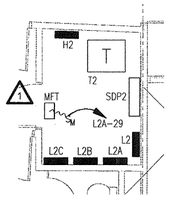

2 ELECTRICAL ROOM 238
E202b | E402 1/4"=1'-0"

0 2' 4' 8' 12'

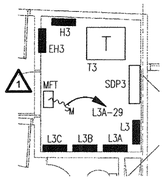

3 ELECTRICAL ROOM 336
E203b | E402 1/4"=1'-0"

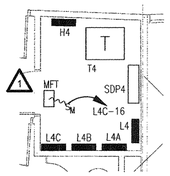

4 ELECTRICAL ROOM 436
E204b | E402 1/4"=1'-0"

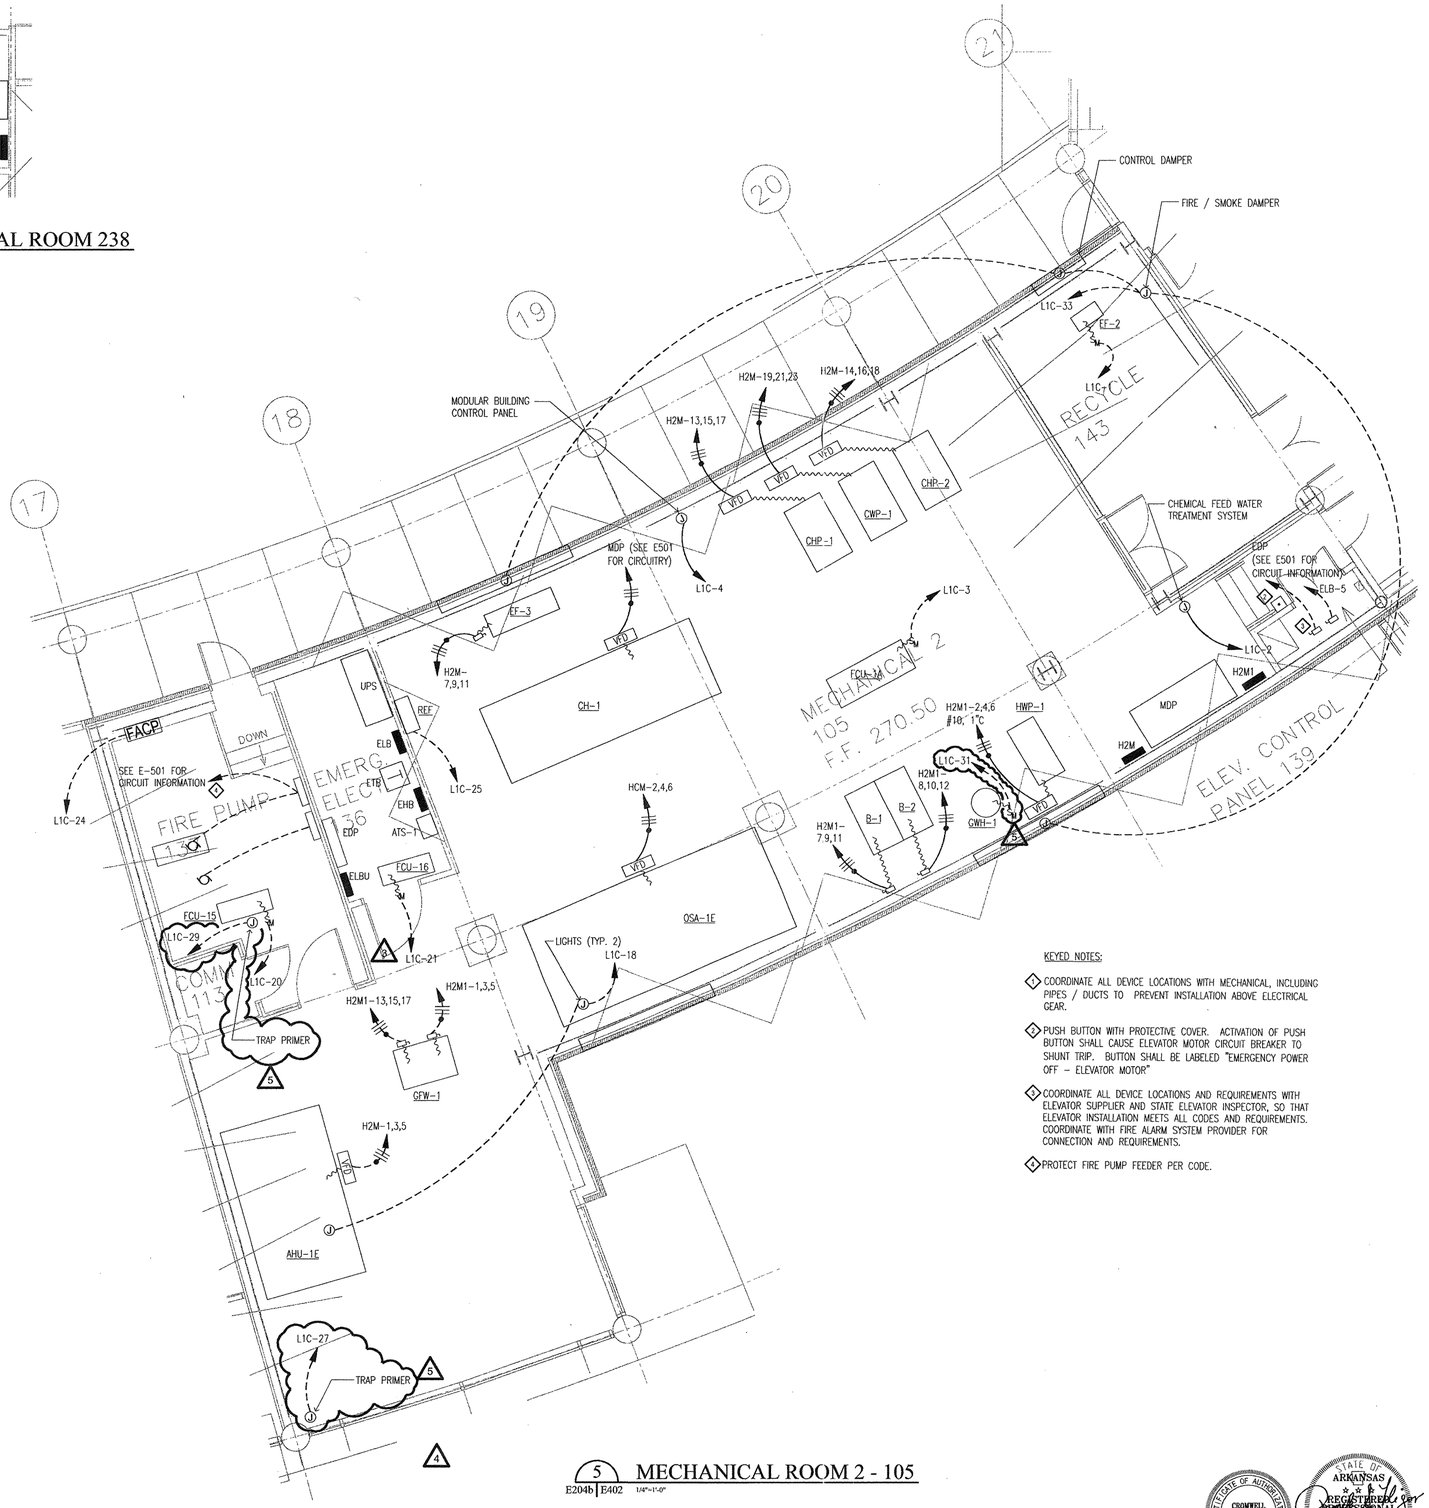

5 MECHANICAL ROOM 2 - 105
E204b | E402 1/4"=1'-0"

KEYED NOTES:

1. COORDINATE ALL DEVICE LOCATIONS WITH MECHANICAL, INCLUDING PIPES / DUCTS TO PREVENT INSTALLATION ABOVE ELECTRICAL GEAR.
2. PUSH BUTTON WITH PROTECTIVE COVER. ACTIVATION OF PUSH BUTTON SHALL CAUSE ELEVATOR MOTOR CIRCUIT BREAKER TO SHUNT TRIP. BUTTON SHALL BE LABELED "EMERGENCY POWER OFF – ELEVATOR MOTOR"
3. COORDINATE ALL DEVICE LOCATIONS AND REQUIREMENTS WITH ELEVATOR SUPPLIER AND STATE ELEVATOR INSPECTOR, SO THAT ELEVATOR INSTALLATION MEETS ALL CODES AND REQUIREMENTS. COORDINATE WITH FIRE ALARM SYSTEM PROVIDER FOR CONNECTION AND REQUIREMENTS.
4. PROTECT FIRE PUMP FEEDER PER CODE.

POLK STANLEY YEARY
ARCHITECTS, LTD.

700 SOUTH SCHILLER
LITTLE ROCK, AR 72201
501 378-0878
FAX 372-7629

21 W. MOUNTAIN, SUITE 227
FAYETTEVILLE, AR 72701
479-444-0473

CONSULTANTS:

OWNER'S PROJECT ADVISOR:
MOSES TUCKER REAL ESTATE, INC.

CIVIL ENGINEER:
McCLELLAND ENGINEERS

LANDSCAPE ARCHITECT:
LARSON BURNS SMITH

STRUCTURAL ENGINEER:
CROMWELL ENGINEERS INC.

MECH., ELEC., PLUMB. ENGINEER:
CROMWELL ENGINEERS INC.

SUSTAINABLE CONSULTANT:
BNIM / ELEMENTS

GLOBAL VILLAGE CONSULTANT
CAMBRIDGE SEVEN ASSOCIATES

INTERIOR DESIGNER:
POLK STANLEY YEARY

GENERAL CONTRACTOR:
CDI

GENERAL NOTES:

NOTES:

ISSUE DATE:
DECEMBER 15, 2003
CORE/SHELL
PACKAGE #5

REVISIONS:

#	DATE	DESCRIPTION
1	1/16/04	ADDENDUM #1
2	1/23/04	PACKAGE 5 - ADDM. 02
3	5/26/04	ASI #03
4	7/01/04	PACKAGE 7.100% ROLL UP
5	11/29/04	ASI #27

HEIFER INTERNATIONAL CENTER OFFICE BUILDING

LITTLE ROCK, ARKANSAS

PSY PROJECT NUMBER:
431C

CERTIFICATE OF AUTHORITY
CROMWELL ENGINEERS #55
ARKANSAS ENGINEER

STATE OF ARKANSAS
REGISTERED PROFESSIONAL ENGINEER
No. 9401
PAMELA S. FLICK
12/15/03

CONTENTS:
ELECTRICAL DETAILS

SHEET NUMBER:
E402