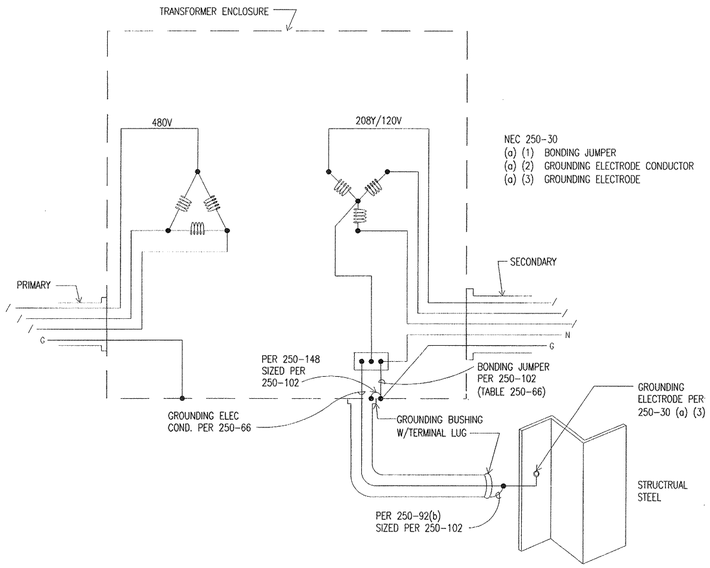

1 TYPICAL TRANSFORMER GROUNDING
E403 | E403 NOT TO SCALE

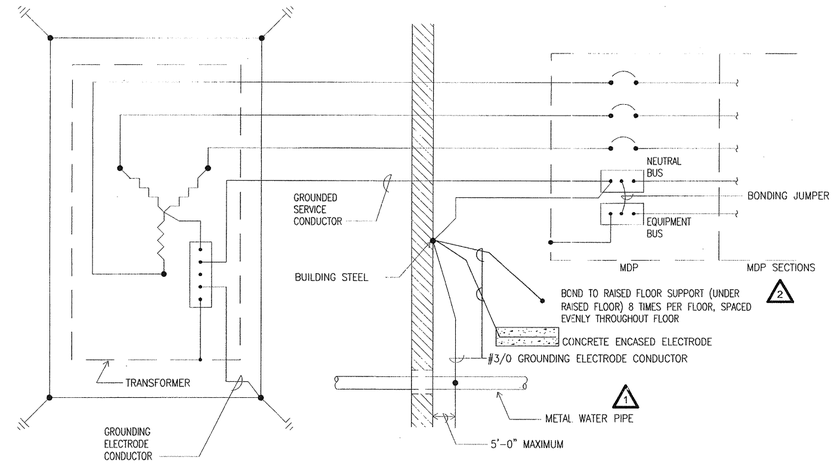

2 PRIMARY SERVICE GROUNDING
E403 | E403 NOT TO SCALE

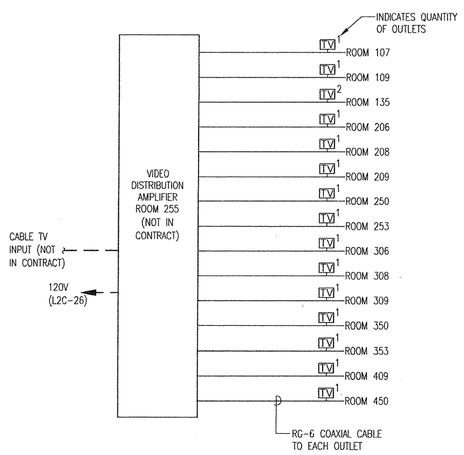

GENERAL NOTES:

1. COORDINATE WITH CABLE PROVIDER.

2. PROVIDE CABLING TO VIDEO DISTRIBUTION AMPLIFIER LOCATION PLUS 5' SLACK IN EACH CABLE. WHERE IN WALLS, CABLING SHALL BE IN CONDUIT (WHERE UNDER RAISED FLOOR, UTILIZE PLENUM RATED CABLE).

2

3 CABLE TV SCHEMATIC
E302b | E403 NOT TO SCALE

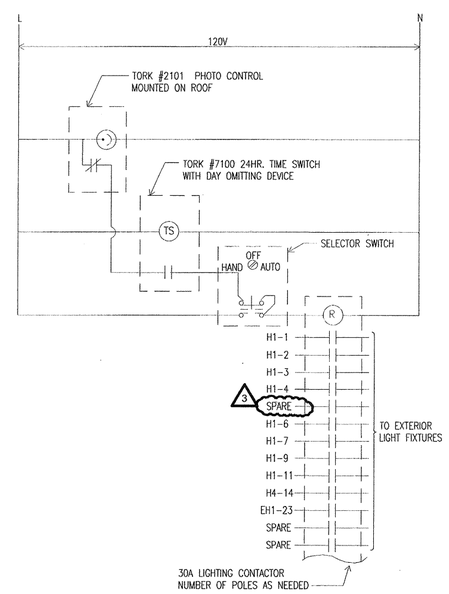

4 TIME SWITCH SCHEMATIC DIAGRAM
E001 | E403 NOT TO SCALE
E101a
E101b
E104a
E104b

1

POLK STANLEY YEARY
ARCHITECTS, LTD.

700 SOUTH SCHILLER
LITTLE ROCK, AR 72201
501 378-0878
FAX 372-7629

21 W. MOUNTAIN, SUITE 227
FAYETTEVILLE, AR 72701
479-444-0473

CONSULTANTS:

OWNER'S PROJECT ADVISOR:
MOSES TUCKER REAL ESTATE, INC.

CIVIL ENGINEER:
McCLELLAND ENGINEERS

LANDSCAPE ARCHITECT:
LARSON BURNS SMITH

STRUCTURAL ENGINEER:
CROMWELL ENGINEERS INC.

MECH., ELEC., PLUMB. ENGINEER:
CROMWELL ENGINEERS INC.

SUSTAINABLE CONSULTANT:
BNIM / ELEMENTS

GLOBAL VILLAGE CONSULTANT
CAMBRIDGE SEVEN ASSOCIATES

INTERIOR DESIGNER:
POLK STANLEY YEARY

GENERAL CONTRACTOR:
CDI

GENERAL NOTES:

NOTES:

ISSUE DATE:
DECEMBER 15, 2003
CORE/SHELL
PACKAGE #5

REVISIONS:

#	DATE	DESCRIPTION
1	1/16/04	ADDENDUM #1
2	1/23/04	PACKAGE 5 - ADDM. 02
	7/01/04	PACKAGE 7,100% ROLLUP
3	10/12/04	ASI #20

HEIFER INTERNATIONAL CENTER OFFICE BUILDING

LITTLE ROCK, ARKANSAS

PSY PROJECT NUMBER:
431C

CONTENTS:
ELECTRICAL DETAILS

SHEET NUMBER:
E403

CERTIFICATE OF AUTHORIZATION
CROMWELL ENGINEERS
#66
ARKANSAS · ENGINEER

STATE OF ARKANSAS
REGISTERED PROFESSIONAL ENGINEER
No. 9401
PAMELA S. FLEGER
12/15/03