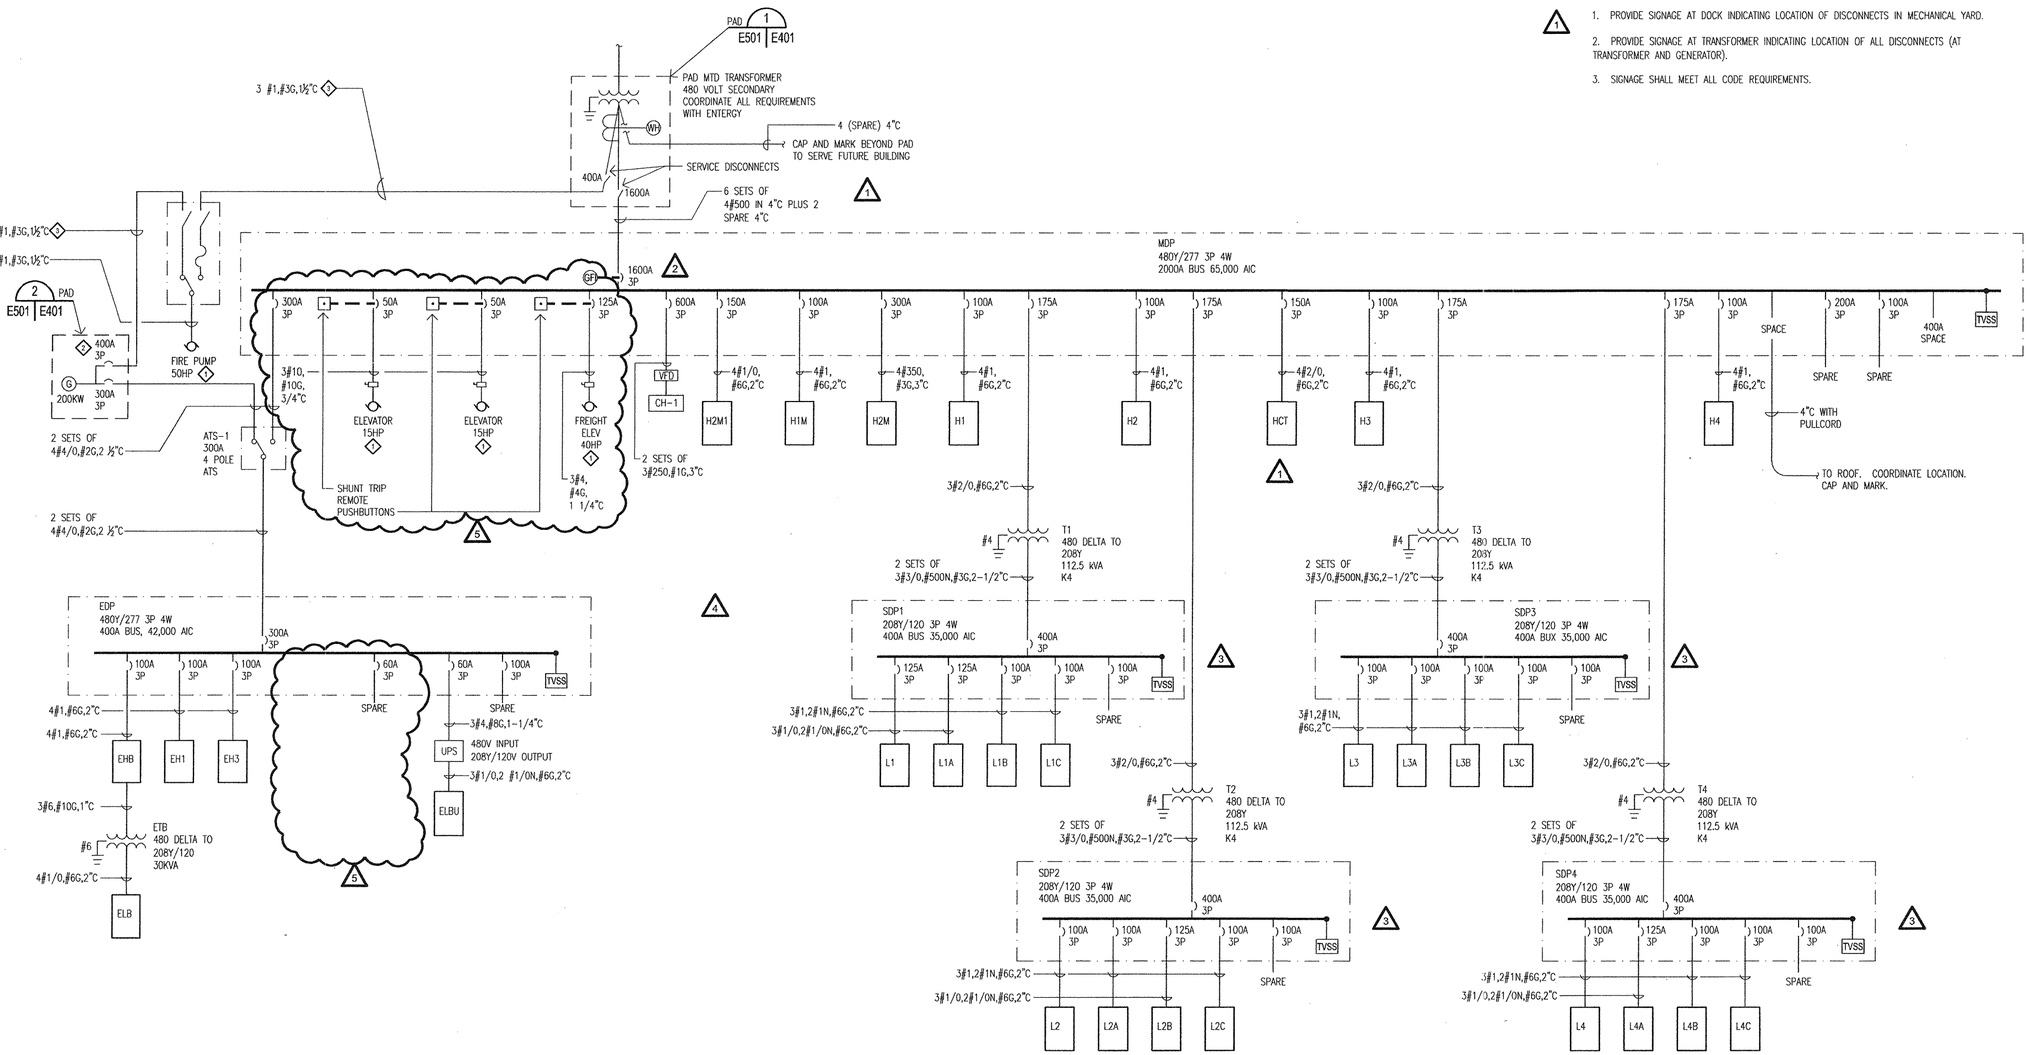

GENERAL NOTES:

1. PROVIDE SIGNAGE AT DOCK INDICATING LOCATION OF DISCONNECTS IN MECHANICAL YARD.
2. PROVIDE SIGNAGE AT TRANSFORMER INDICATING LOCATION OF ALL DISCONNECTS (AT TRANSFORMER AND GENERATOR).
3. SIGNAGE SHALL MEET ALL CODE REQUIREMENTS.

KEYED NOTES:

1. VERIFY HORSEPOWER CIRCUIT BREAKER SIZE AND VOLTAGE WITH EQUIPMENT SUPPLIER PRIOR TO BEGINNING ANY ASSOCIATED WORK. IF A CONFLICT EXISTS, NOTIFY ARCHITECT/ENGINEER IMMEDIATELY.
2. CIRCUIT BREAKER IS SIZED FOR LOCKED MOTOR CURRENT. VERIFY WITH ACTUAL FIRE PUMP BEING PROVIDED PRIOR TO BEGINNING ANY ASSOCIATED WORK.
3. PROTECT FIRE PUMP CONDUCTORS BY ROUTING OUTSIDE BUILDING OR ENCASING IN 2" (MIN.) CONCRETE OR PROVIDING 1-HOUR RATED CIRCUIT PROTECTIVE SYSTEM.

1 E501 | E501 SINGLE LINE DIAGRAM
NOT TO SCALE

POLK STANLEY YEARY ARCHITECTS, LTD.

700 SOUTH SCHILLER
LITTLE ROCK, AR 72201
501 378-0878
FAX 372-7629

21 W. MOUNTAIN, SUITE 227
FAYETTEVILLE, AR 72701
479-444-0473

CONSULTANTS:

OWNER'S PROJECT ADVISOR:
MOSES TUCKER REAL ESTATE, INC.

CIVIL ENGINEER:
McCLELLAND ENGINEERS

LANDSCAPE ARCHITECT:
LARSON BURNS SMITH

STRUCTURAL ENGINEER:
CROMWELL ENGINEERS INC.

MECH., ELEC., PLUMB. ENGINEER:
CROMWELL ENGINEERS INC.

SUSTAINABLE CONSULTANT:
BNIM / ELEMENTS

GLOBAL VILLAGE CONSULTANT
CAMBRIDGE SEVEN ASSOCIATES

INTERIOR DESIGNER:
POLK STANLEY YEARY

GENERAL CONTRACTOR:
CDI

GENERAL NOTES:

NOTES:

ISSUE DATE:
DECEMBER 15, 2003
CORE/SHELL
PACKAGE #5

REVISIONS:

#	DATE	DESCRIPTION
1	1/16/04	ADDENDUM #1
2	1/23/04	PACKAGE 5 - ADDM. 02
3	1/28/04	PACKAGE 5 - ADDM. 03
4	7/01/04	PACKAGE 7,100% ROLL UP
5	10/12/04	ASI #20

HEIFER INTERNATIONAL CENTER OFFICE BUILDING

LITTLE ROCK, ARKANSAS

PSY PROJECT NUMBER:
431C

CROMWELL ENGINEERS #65 — CERTIFICATE OF AUTHORIZATION — ARKANSAS - ENGINEER

STATE OF ARKANSAS REGISTERED PROFESSIONAL ENGINEER No. 9401 PAMELA S. ELLIOTT 12/15/03

CONTENTS:
ELECTRICAL SINGLE LINE DIAGRAM
SHEET NUMBER:

E501