

CONSULTANTS:

OWNER'S PROJECT ADVISOR:
MOSES TUCKER REAL ESTATE, INC.

CIVIL ENGINEER:
McCLELLAND ENGINEERS

LANDSCAPE ARCHITECT:
LARSON BURNS SMITH

STRUCTURAL ENGINEER:
CROMWELL ENGINEERS INC.

MECH., ELEC., PLUMB. ENGINEER:
CROMWELL ENGINEERS INC.

SUSTAINABLE CONSULTANT:
BNM / ELEMENTS

GLOBAL VILLAGE CONSULTANT
CAMBRIDGE SEVEN ASSOCIATES

INTERIOR DESIGNER:
POLK STANLEY YEARY

GENERAL CONTRACTOR:
CDI

GENERAL NOTES:

NOTES:

ISSUE DATE:
DECEMBER 15, 2003
CORE/SHELL
PACKAGE #5

REVISIONS:

#	DATE	DESCRIPTION
1	1-16-04	ADDENDUM #1
2	1-23-04	PACKAGE 5-ADDM. 02
3	7-1-04	PACKAGE 7, 100% ROLL UP
4	11-29-04	ASI #27

**HEIFER
INTERNATIONAL
CENTER
OFFICE BUILDING**

LITTLE ROCK, ARKANSAS


PSY PROJECT NUMBER:
431C

CONTENTS:

HVAC DETAILS


SHEET NUMBER:

M205

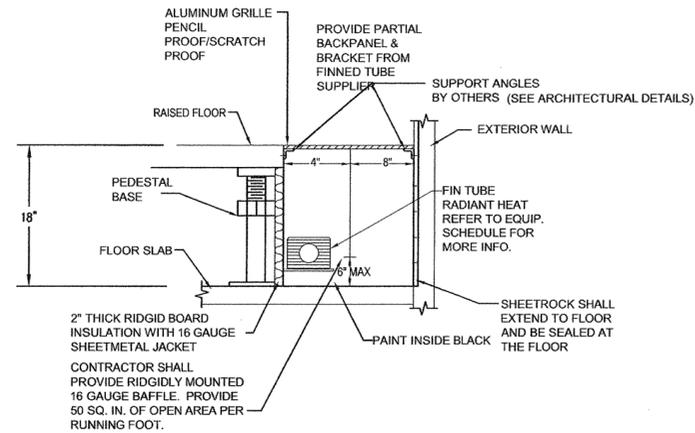


1 FIN TUBE RADIANT HEAT PANEL SECTION

M-205 | M-205 NO SCALE

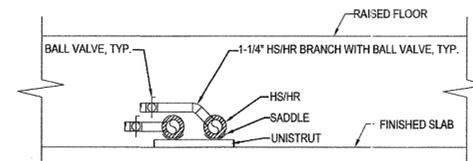


2 HOT WATER PIPING (UNDERFLOOR)

M-205 | M-205 NO SCALE

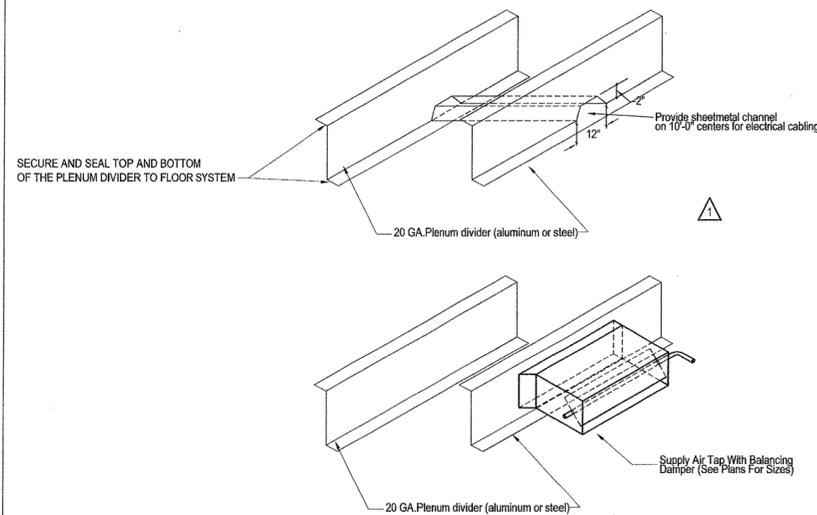


3 DUCTED PANEL AIR PLENUM

M-205 | M-205 NO SCALE

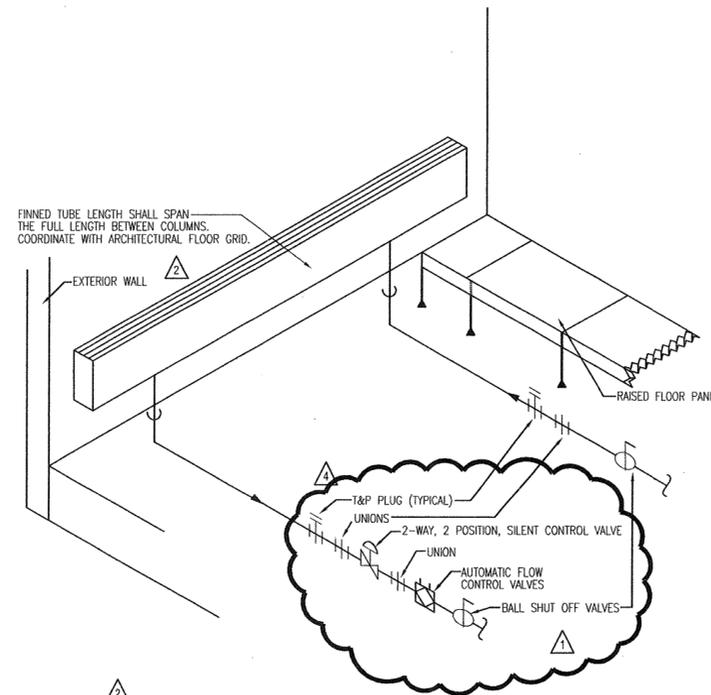

4 HOT WATER FIN TUBE RADIATION PIPING FED FROM BELOW RAISED FLOOR

M-205 | M-205 NO SCALE

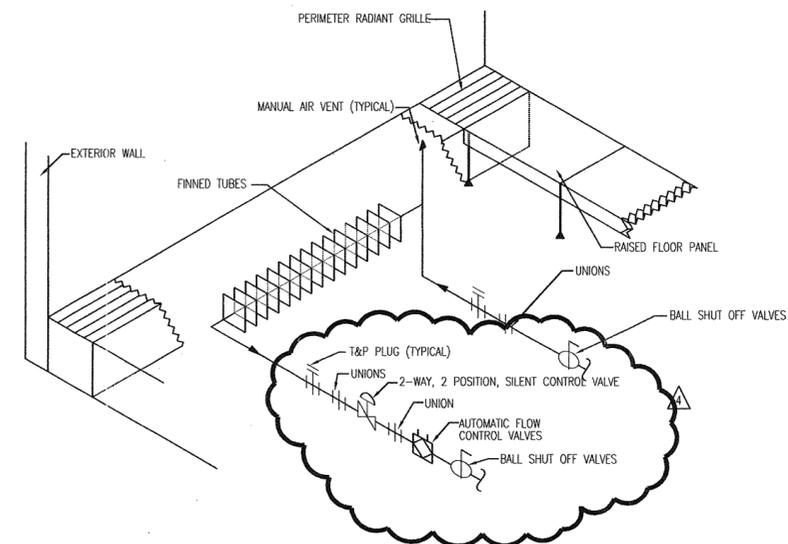

5 HOT WATER FIN TUBE RADIATION PIPING FED FROM BELOW RAISED FLOOR

M-205 | M-205 NO SCALE

