

**CONSULTANTS:**

OWNER'S PROJECT ADVISOR:  
MOSES TUCKER REAL ESTATE, INC.

CIVIL ENGINEER:  
McCLELLAND ENGINEERS

LANDSCAPE ARCHITECT:  
LARSON BURNS SMITH

STRUCTURAL ENGINEER:  
CROMWELL ENGINEERS INC.

MECH., ELEC., PLUMB. ENGINEER:  
CROMWELL ENGINEERS INC.

SUSTAINABLE CONSULTANT:  
BNIM / ELEMENTS

GLOBAL VILLAGE CONSULTANT  
CAMBRIDGE SEVEN ASSOCIATES

INTERIOR DESIGNER:  
POLK STANLEY YEARY

GENERAL CONTRACTOR:  
CDI

**GENERAL NOTES:**

**NOTES:**

ISSUE DATE:  
DECEMBER 15, 2003  
CORE/SHELL  
PACKAGE #5

**REVISIONS:**

#	DATE	DESCRIPTION
1	01/16/04	PKG. 5 / ADD #1
2	01/23/04	PACKAGE 5-ADDOM. 02
3	05/26/04	ASI #03
4	07/01/04	Package 7, 100% Roll-up
5	11/29/04	ASI #27
6	12/10/04	ASI #28


**HEIFER  
INTERNATIONAL  
CENTER  
OFFICE BUILDING**

LITTLE ROCK, ARKANSAS

PSY PROJECT NUMBER:  
431C

CONTENTS:  
FIRST FLOOR PLUMBING PLAN  
EAST END  
SHEET NUMBER:

**P101a**

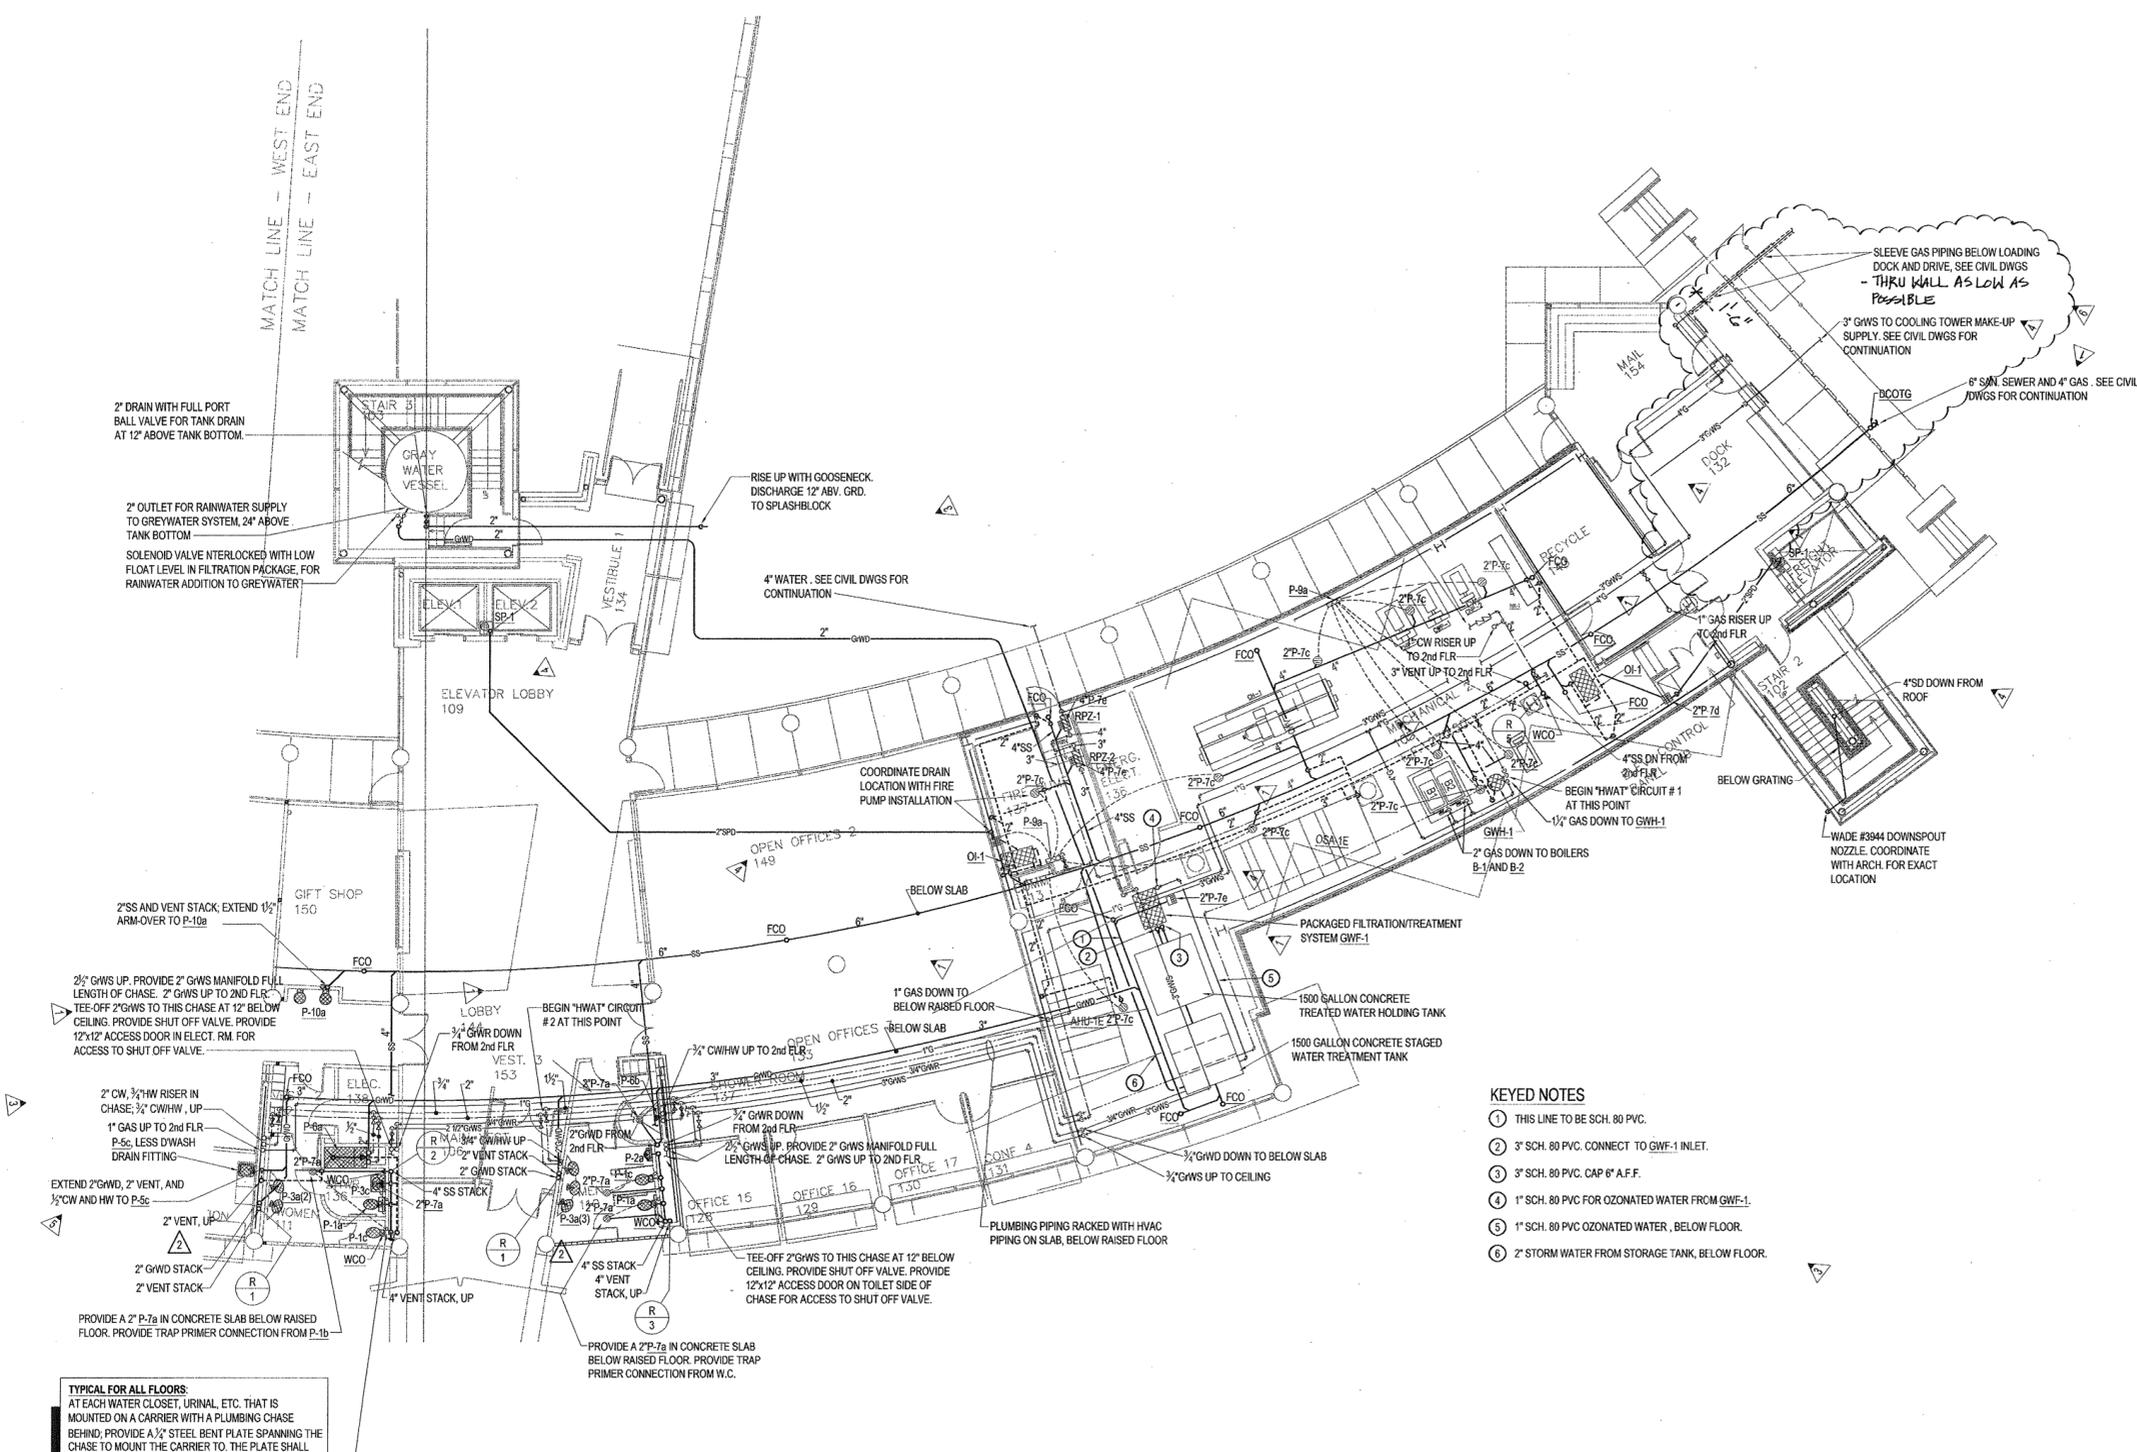

- KEYED NOTES**
- THIS LINE TO BE SCH. 80 PVC.
  - 3" SCH. 80 PVC. CONNECT TO GWF-1 INLET.
  - 3" SCH. 80 PVC. CAP 6" A.F.F.
  - 1" SCH. 80 PVC FOR OZONATED WATER FROM GWF-1.
  - 1" SCH. 80 PVC OZONATED WATER, BELOW FLOOR.
  - 2" STORM WATER FROM STORAGE TANK, BELOW FLOOR.

**TYPICAL FOR ALL FLOORS:**  
AT EACH WATER CLOSET, URINAL, ETC. THAT IS MOUNTED ON A CARRIER WITH A PLUMBING CHASE BEHIND, PROVIDE A 1/2" STEEL BENT PLATE SPANNING THE CHASE TO MOUNT THE CARRIER TO. THE PLATE SHALL BE TURNED DOWN 4" ON EACH END AND SECURED TO THE CHASE WALLS.  
ATTACHMENT TO CONCRETE WALL SHALL BE MADE WITH EXPANSION ANCHORS.  
ATTACHMENT TO FRAME WALL SHALL BE MADE BY BRACING ACROSS STUDS WITH ANGLE FRAMING AND BOLTING THRU THE ANGLE. SUPPORTING STUDS SHALL BE REINFORCED WITH ANGLE FRAMING.  
VERIFY SIZE OF PLATE TO ACCOMMODATE CARRIER.

**1 FIRST FLOOR PLUMBING PLAN - EAST END**  
SCALE: 1/8" = 1'-0"

