

- CONSULTANTS:**
- OWNER'S PROJECT ADVISOR:  
MOSES TUCKER REAL ESTATE, INC.
  - CIVIL ENGINEER:  
MCLELLAND ENGINEERS
  - LANDSCAPE ARCHITECT:  
LARSON BURNS SMITH
  - STRUCTURAL ENGINEER:  
CROMWELL ENGINEERS INC.
  - MECH., ELEC., PLUMB. ENGINEER:  
CROMWELL ENGINEERS INC.
  - SUSTAINABLE CONSULTANT:  
BNIM / ELEMENTS
  - GLOBAL VILLAGE CONSULTANT  
CAMBRIDGE SEVEN ASSOCIATES
  - INTERIOR DESIGNER:  
POLK STANLEY YEARY
  - GENERAL CONTRACTOR:  
CDI

**GENERAL NOTES:**

NOTES:


ISSUE DATE:  
DECEMBER 15, 2003  
CORE/SHELL  
PACKAGE #5  
REVISIONS:


#	DATE	DESCRIPTION
1	01/23/04	PACKAGE 5-ADDM. 02
2	07/01/04	Package 7, 100% Roll-up

**HEIFER  
INTERNATIONAL  
CENTER  
OFFICE BUILDING**  
LITTLE ROCK, ARKANSAS


PSY PROJECT NUMBER:  
431C

CONTENTS:  
PLUMBING  
RISER DIAGRAMS  
SHEET NUMBER:


**P201**

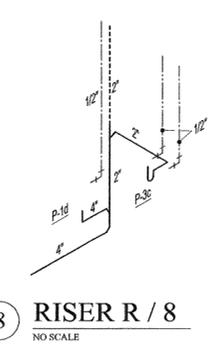


**8 RISER R / 8**  
NO SCALE

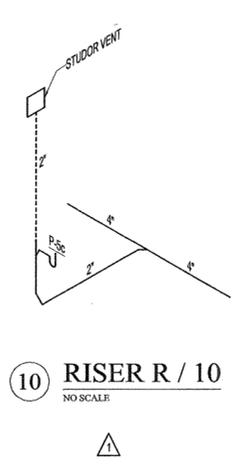


**10 RISER R / 10**  
NO SCALE

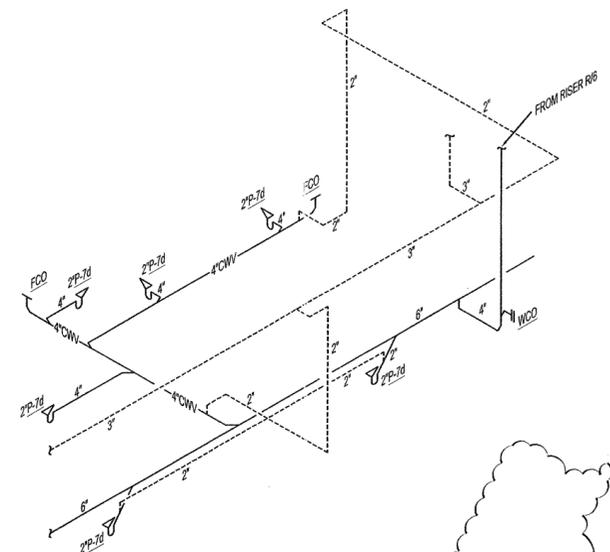


**5 RISER R / 5**  
NO SCALE

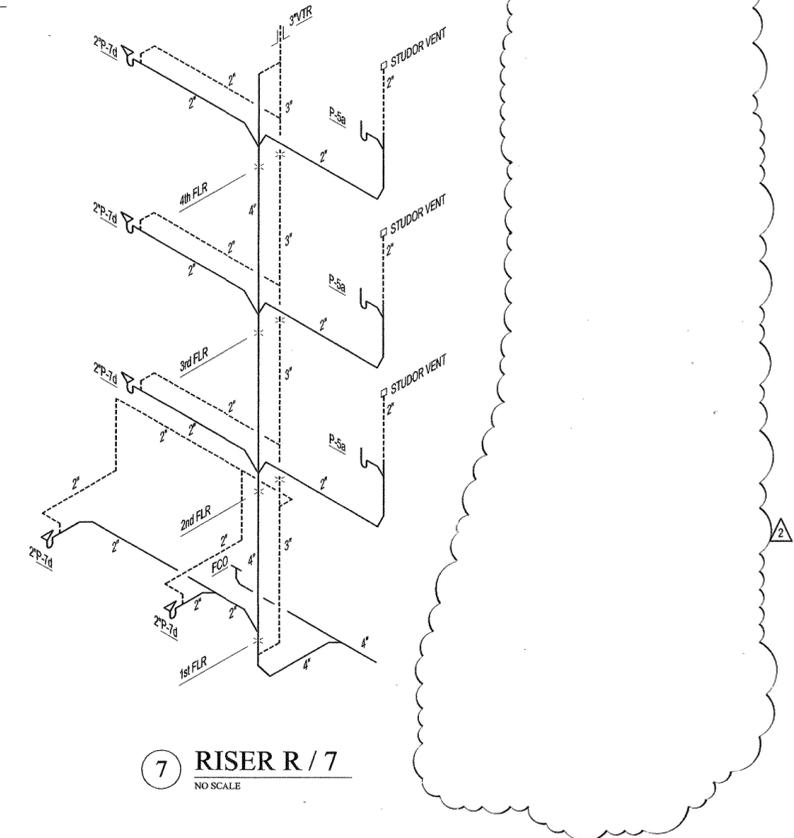


**7 RISER R / 7**  
NO SCALE

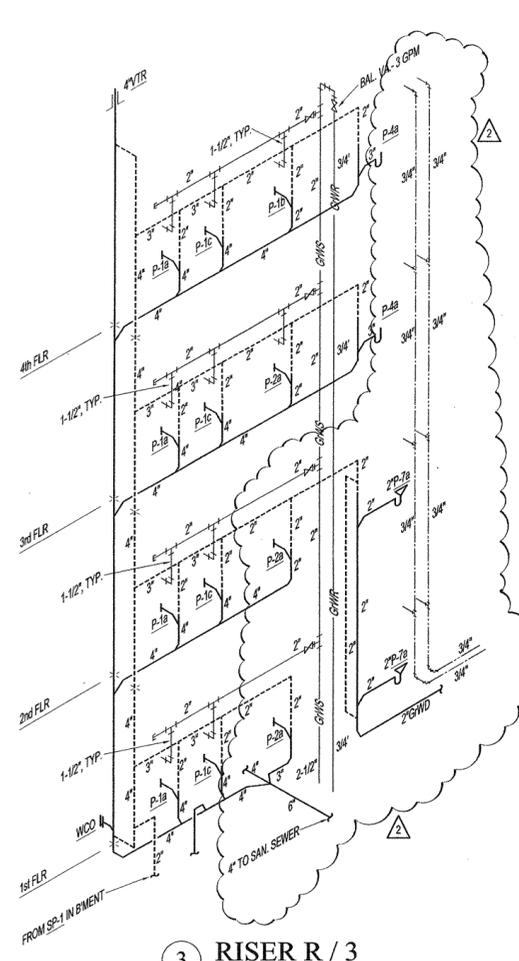


**3 RISER R / 3**  
NO SCALE

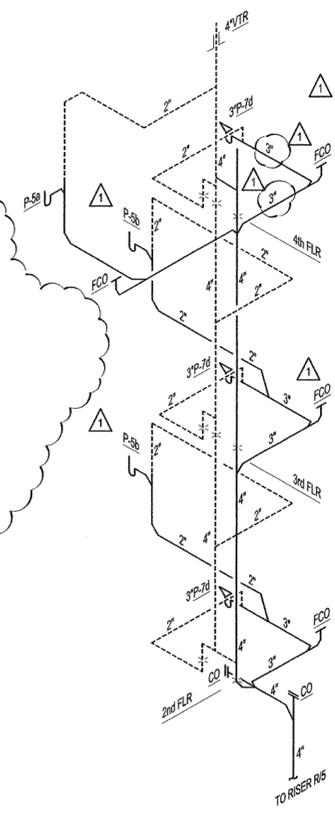


**6 RISER R / 6**  
NO SCALE

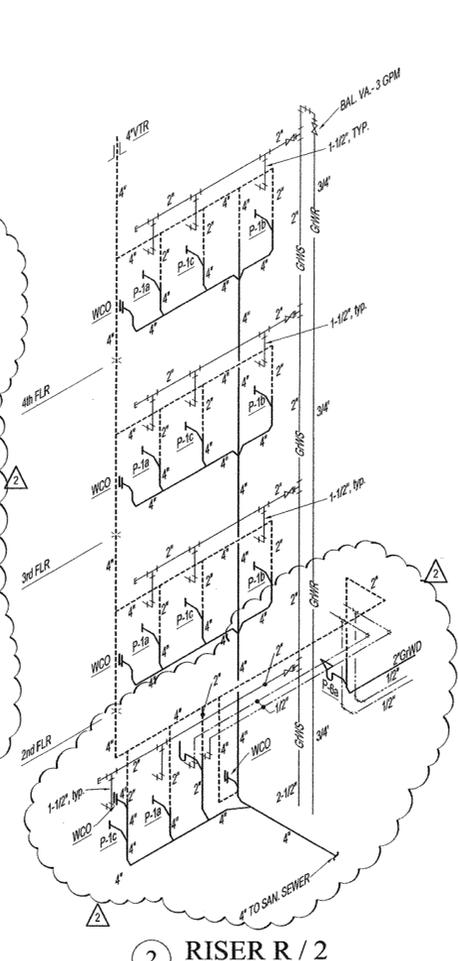

**2 RISER R / 2**  
NO SCALE

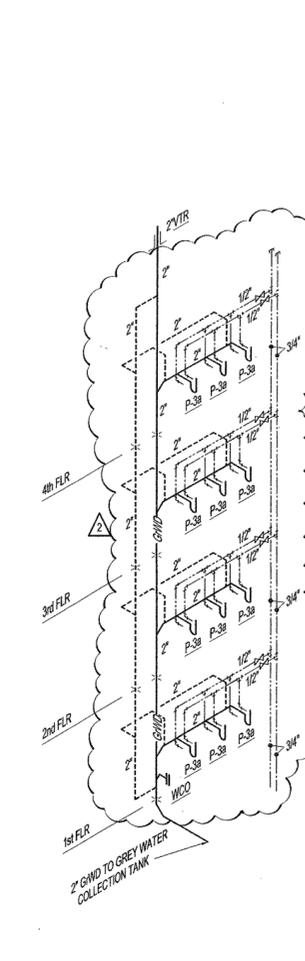

**1 RISER R / 1**  
NO SCALE

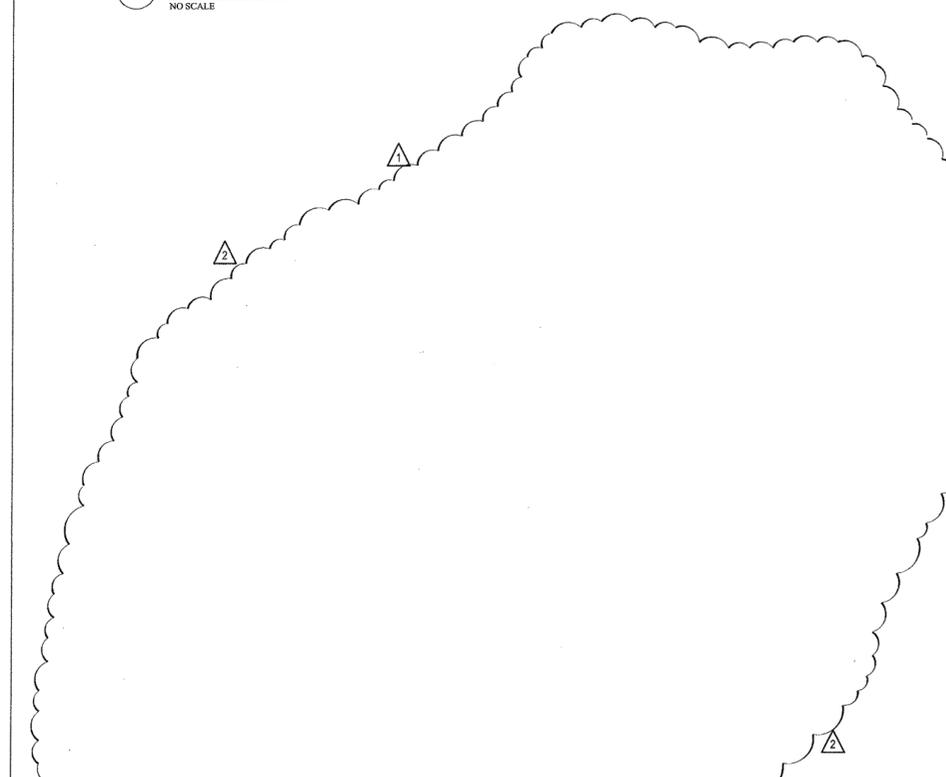

**4 RISER R / 4**  
NO SCALE

