




1 GREY WATER TREATMENT TANKS
NO SCALE

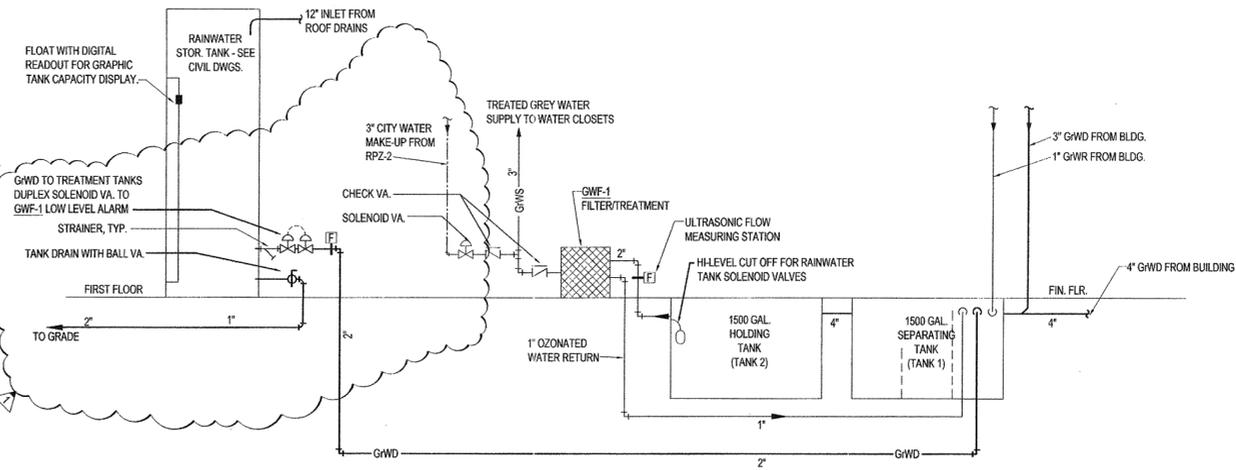


2 GREY WATER PIPING SCHEMATIC
NO SCALE

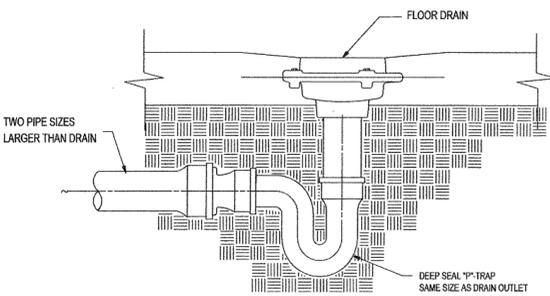


3 COMBINATION WASTE AND VENT DRAIN
NO SCALE

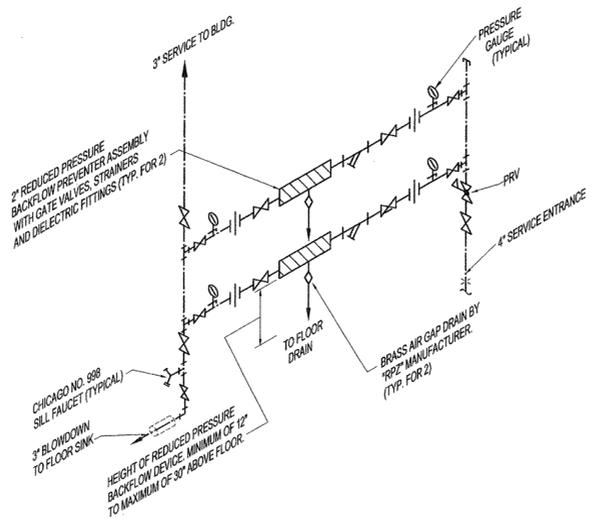


4 RPZ-1 BACKFLOW PREVENTER
NO SCALE

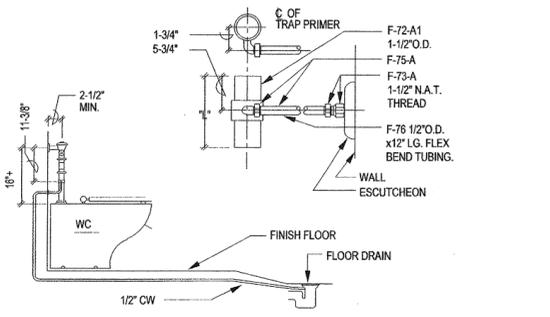


6 WATER CLOSET TRAP PRIMER
NO SCALE

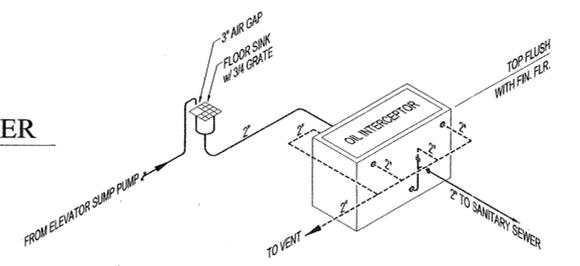


5 OIL INTERCEPTOR @ ELEVATOR SUMP
NO SCALE

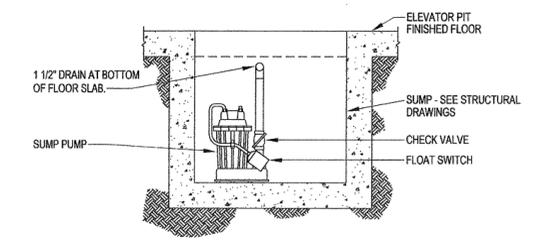


7 ELEVATOR SUMP PUMP
NO SCALE

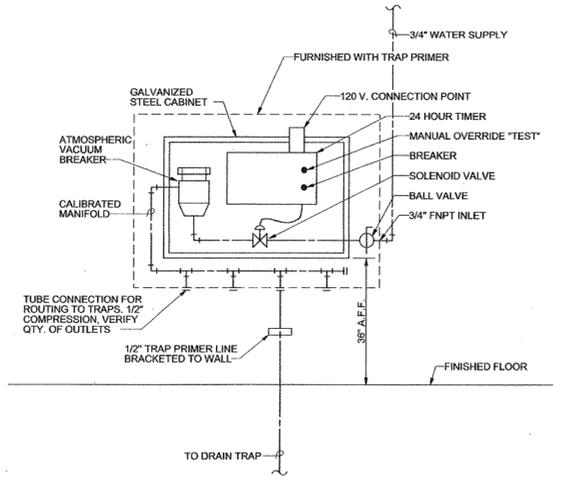


8 ELECTRONIC TRAP PRIMER - P-9a (P-9b SIMILAR)
NO SCALE

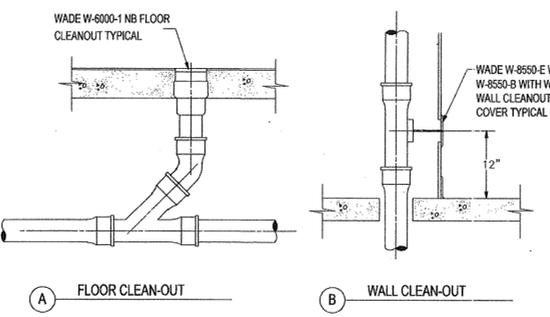

9 TYPICAL CLEANOUTS
NO SCALE

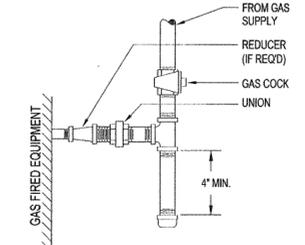

10 TYPICAL GAS CONNECTION
NO SCALE

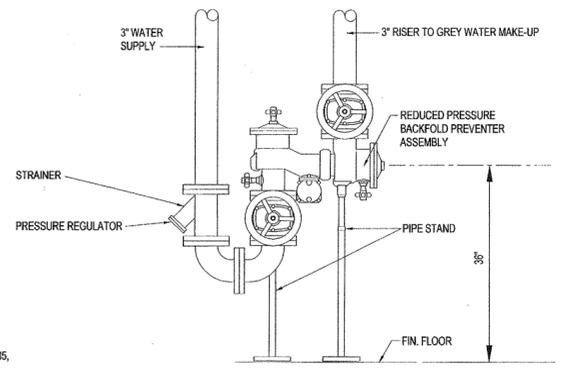

11 RPZ-2 BACKFLOW PREVENTER
NO SCALE

POLK STANLEY YEARY ARCHITECTS, LTD.
700 SOUTH SCHILLER LITTLE ROCK, AR 72201
501 378-8878
FAX 372-7629
21 W. MOUNTAIN, SUITE 227 FAYETTEVILLE, AR 72701
479-444-0473

CONSULTANTS:
OWNER'S PROJECT ADVISOR: MOSES TUCKER REAL ESTATE, INC.
CIVIL ENGINEER: McCLELLAND ENGINEERS
LANDSCAPE ARCHITECT: LARSON BURNS SMITH
STRUCTURAL ENGINEER: CROMWELL ENGINEERS INC.
MECH., ELEC., PLUMB. ENGINEER: CROMWELL ENGINEERS INC.
SUSTAINABLE CONSULTANT: BNIM / ELEMENTS
GLOBAL VILLAGE CONSULTANT: CAMBRIDGE SEVEN ASSOCIATES
INTERIOR DESIGNER: POLK STANLEY YEARY
GENERAL CONTRACTOR: CDI

GENERAL NOTES:

NOTES:

ISSUE DATE: DECEMBER 15, 2003
CORE/SHELL PACKAGE #5


REVISIONS:

#	DATE	DESCRIPTION
1	07/01/04	Package 7, 100% Roll-up

HEIFER INTERNATIONAL CENTER OFFICE BUILDING
LITTLE ROCK, ARKANSAS

PSY PROJECT NUMBER: 431C

CONTENTS: PLUMBING DETAILS
SHEET NUMBER: **P301**

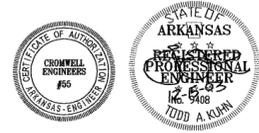

DATE PLOTTED: 12/15/03 10:00 AM