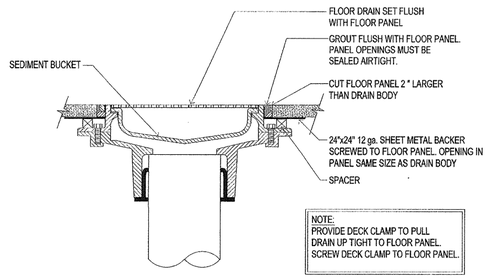

1 FLOOR DRAIN @ RAISED FLOOR
NO SCALE

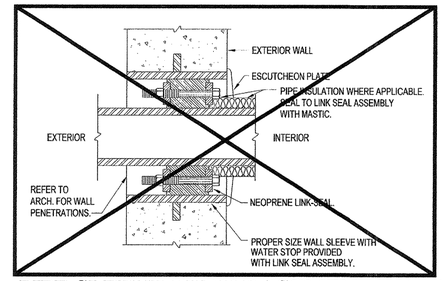

2 PIPE SLEEVE THRU BASEMENT WALL
NO SCALE

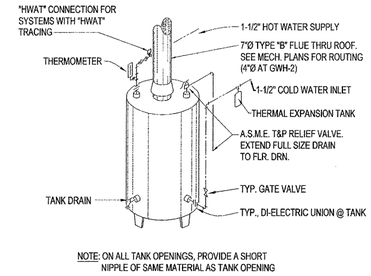

3 TYPICAL WATER HEATER PIPING
NO SCALE

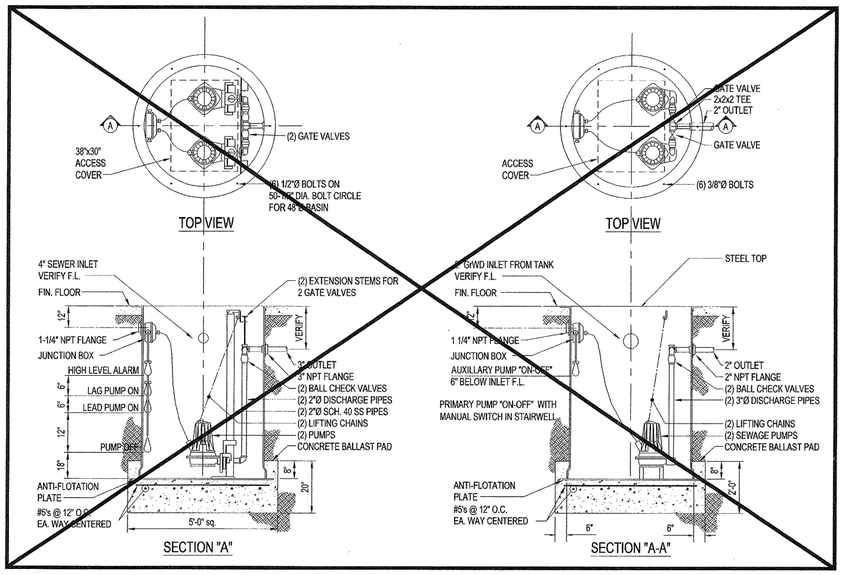

4 SUMP PUMP SP-2
NO SCALE

5 SUMP PUMP SP-3
NO SCALE

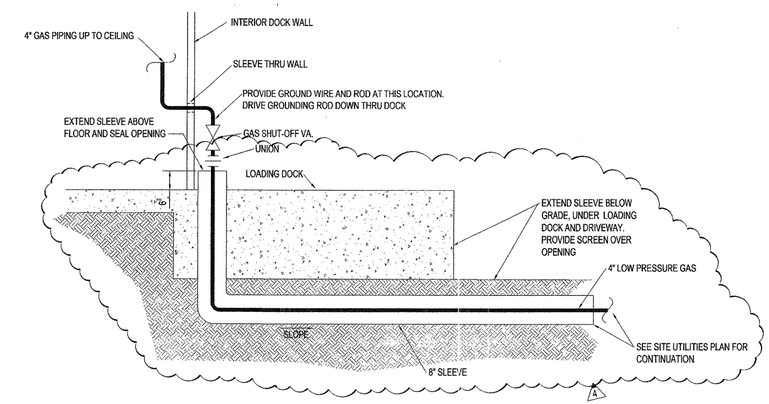

7 GAS SLEEVE AT DOCK
NO SCALE

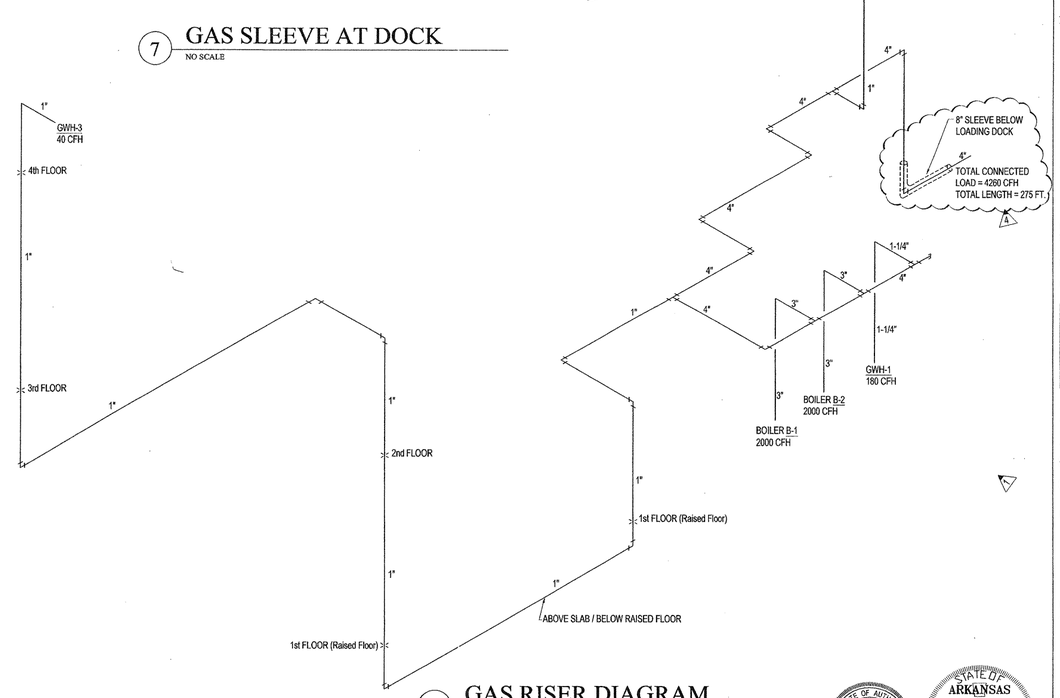

6 GAS RISER DIAGRAM
NO SCALE

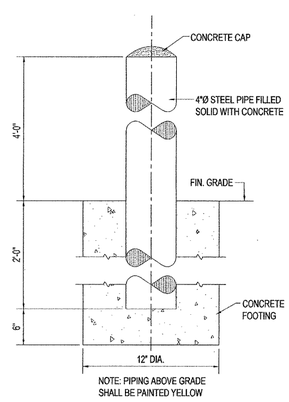

8 GAS RISER PIPE BOLLARD
NO SCALE

POLK STANLEY YEARY ARCHITECTS, LTD.

700 SOUTH SCHILLER
LITTLE ROCK, AR 72201
501 378-0878
FAX 372-7629

21 W. MOUNTAIN, SUITE 227
FAYETTEVILLE, AR 72701
479-444-0473

CONSULTANTS:

OWNER'S PROJECT ADVISOR:
MOSES TUCKER REAL ESTATE, INC.

CIVIL ENGINEER:
McCLELLAND ENGINEERS

LANDSCAPE ARCHITECT:
LARSON BURNS SMITH

STRUCTURAL ENGINEER:
CROMWELL ENGINEERS INC.

MECH., ELEC., PLUMB. ENGINEER:
CROMWELL ENGINEERS INC.

SUSTAINABLE CONSULTANT:
BNIM / ELEMENTS

GLOBAL VILLAGE CONSULTANT
CAMBRIDGE SEVEN ASSOCIATES

INTERIOR DESIGNER:
POLK STANLEY YEARY

GENERAL CONTRACTOR:
CDI

GENERAL NOTES:

NOTES:

ISSUE DATE:
DECEMBER 15, 2003
CORE/SHELL
PACKAGE #5

REVISIONS:

#	DATE	DESCRIPTION
1	01-22-04	PKG. 5 / ADD. #1
2	01-28-04	PKG. 5 / ADD. #3
3	07/01/04	Package 7, 100% Roll-up
4	12/10/04	ASI #28

HEIFER INTERNATIONAL CENTER OFFICE BUILDING

LITTLE ROCK, ARKANSAS

PSY PROJECT NUMBER:
431C

CONTENTS:
PLUMBING DETAILS

SHEET NUMBER:
P302