

CONSULTANTS:
 OWNER'S PROJECT ADVISOR:
 MOSES TUCKER REAL ESTATE, INC.
 CIVIL ENGINEER:
 McCLELLAND ENGINEERS
 LANDSCAPE ARCHITECT:
 LARSON BURNS SMITH
 STRUCTURAL ENGINEER:
 CROMWELL ENGINEERS INC.
 MECH., ELEC., PLUMB. ENGINEER:
 CROMWELL ENGINEERS INC.
 SUSTAINABLE CONSULTANT:
 BNIM/ELEMENTS
 GLOBAL VILLAGE CONSULTANT
 CAMBRIDGE SEVEN ASSOCIATES
 INTERIOR DESIGNER:
 POLK STANLEY YEARY
 GENERAL CONTRACTOR:
 CDI

GENERAL NOTES:
 NOTES:

ISSUE DATE:
 NOVEMBER 17, 2003
 STRUCTURAL/FOUNDATION
 PACKAGE #4


REVISIONS:

#	DATE	DESCRIPTION	#	DATE	DESCRIPTION
1	01/19/2004	PACKAGE 4 - ADDM. 04	6	06/23/2004	ASI #6
2	02/26/2004	PACKAGE 4 - ADDM. 05	7	08/26/2004	ASI #17
3	03/17/2004	PACKAGE 4 - ADDM. 06			
4	04/13/2004	PACKAGE 4 - ADDM. 09			
5	06/1/2004	ASI #2			


HEIFER INTERNATIONAL CENTER OFFICE BUILDING
 LITTLE ROCK, ARKANSAS

PSY PROJECT NUMBER:
 431C

CONTENTS:
 SLAB ON GRADE PLAN - WEST END
 SHEET NUMBER:
S101d

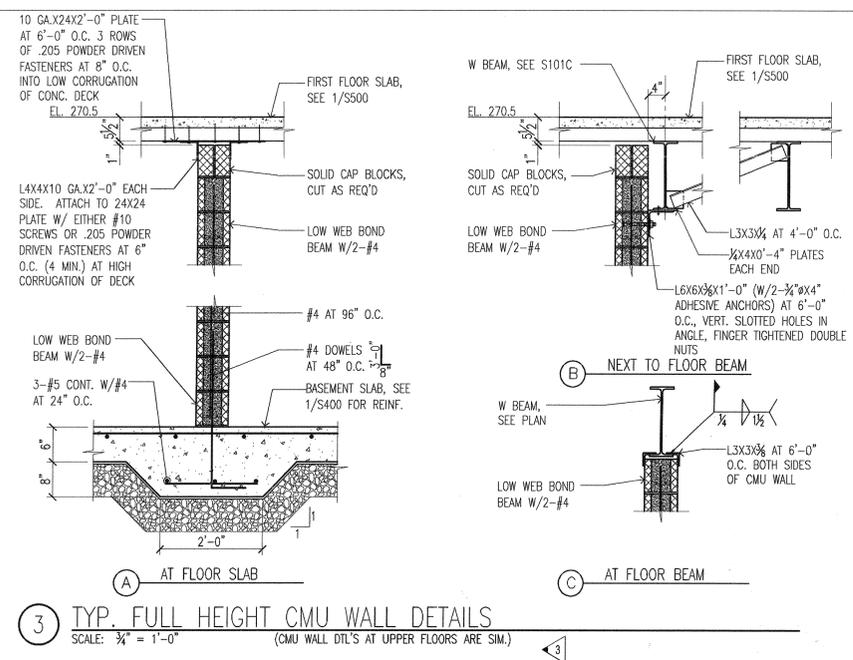

2 NOT USED
 SCALE: 3/4" = 1'-0"

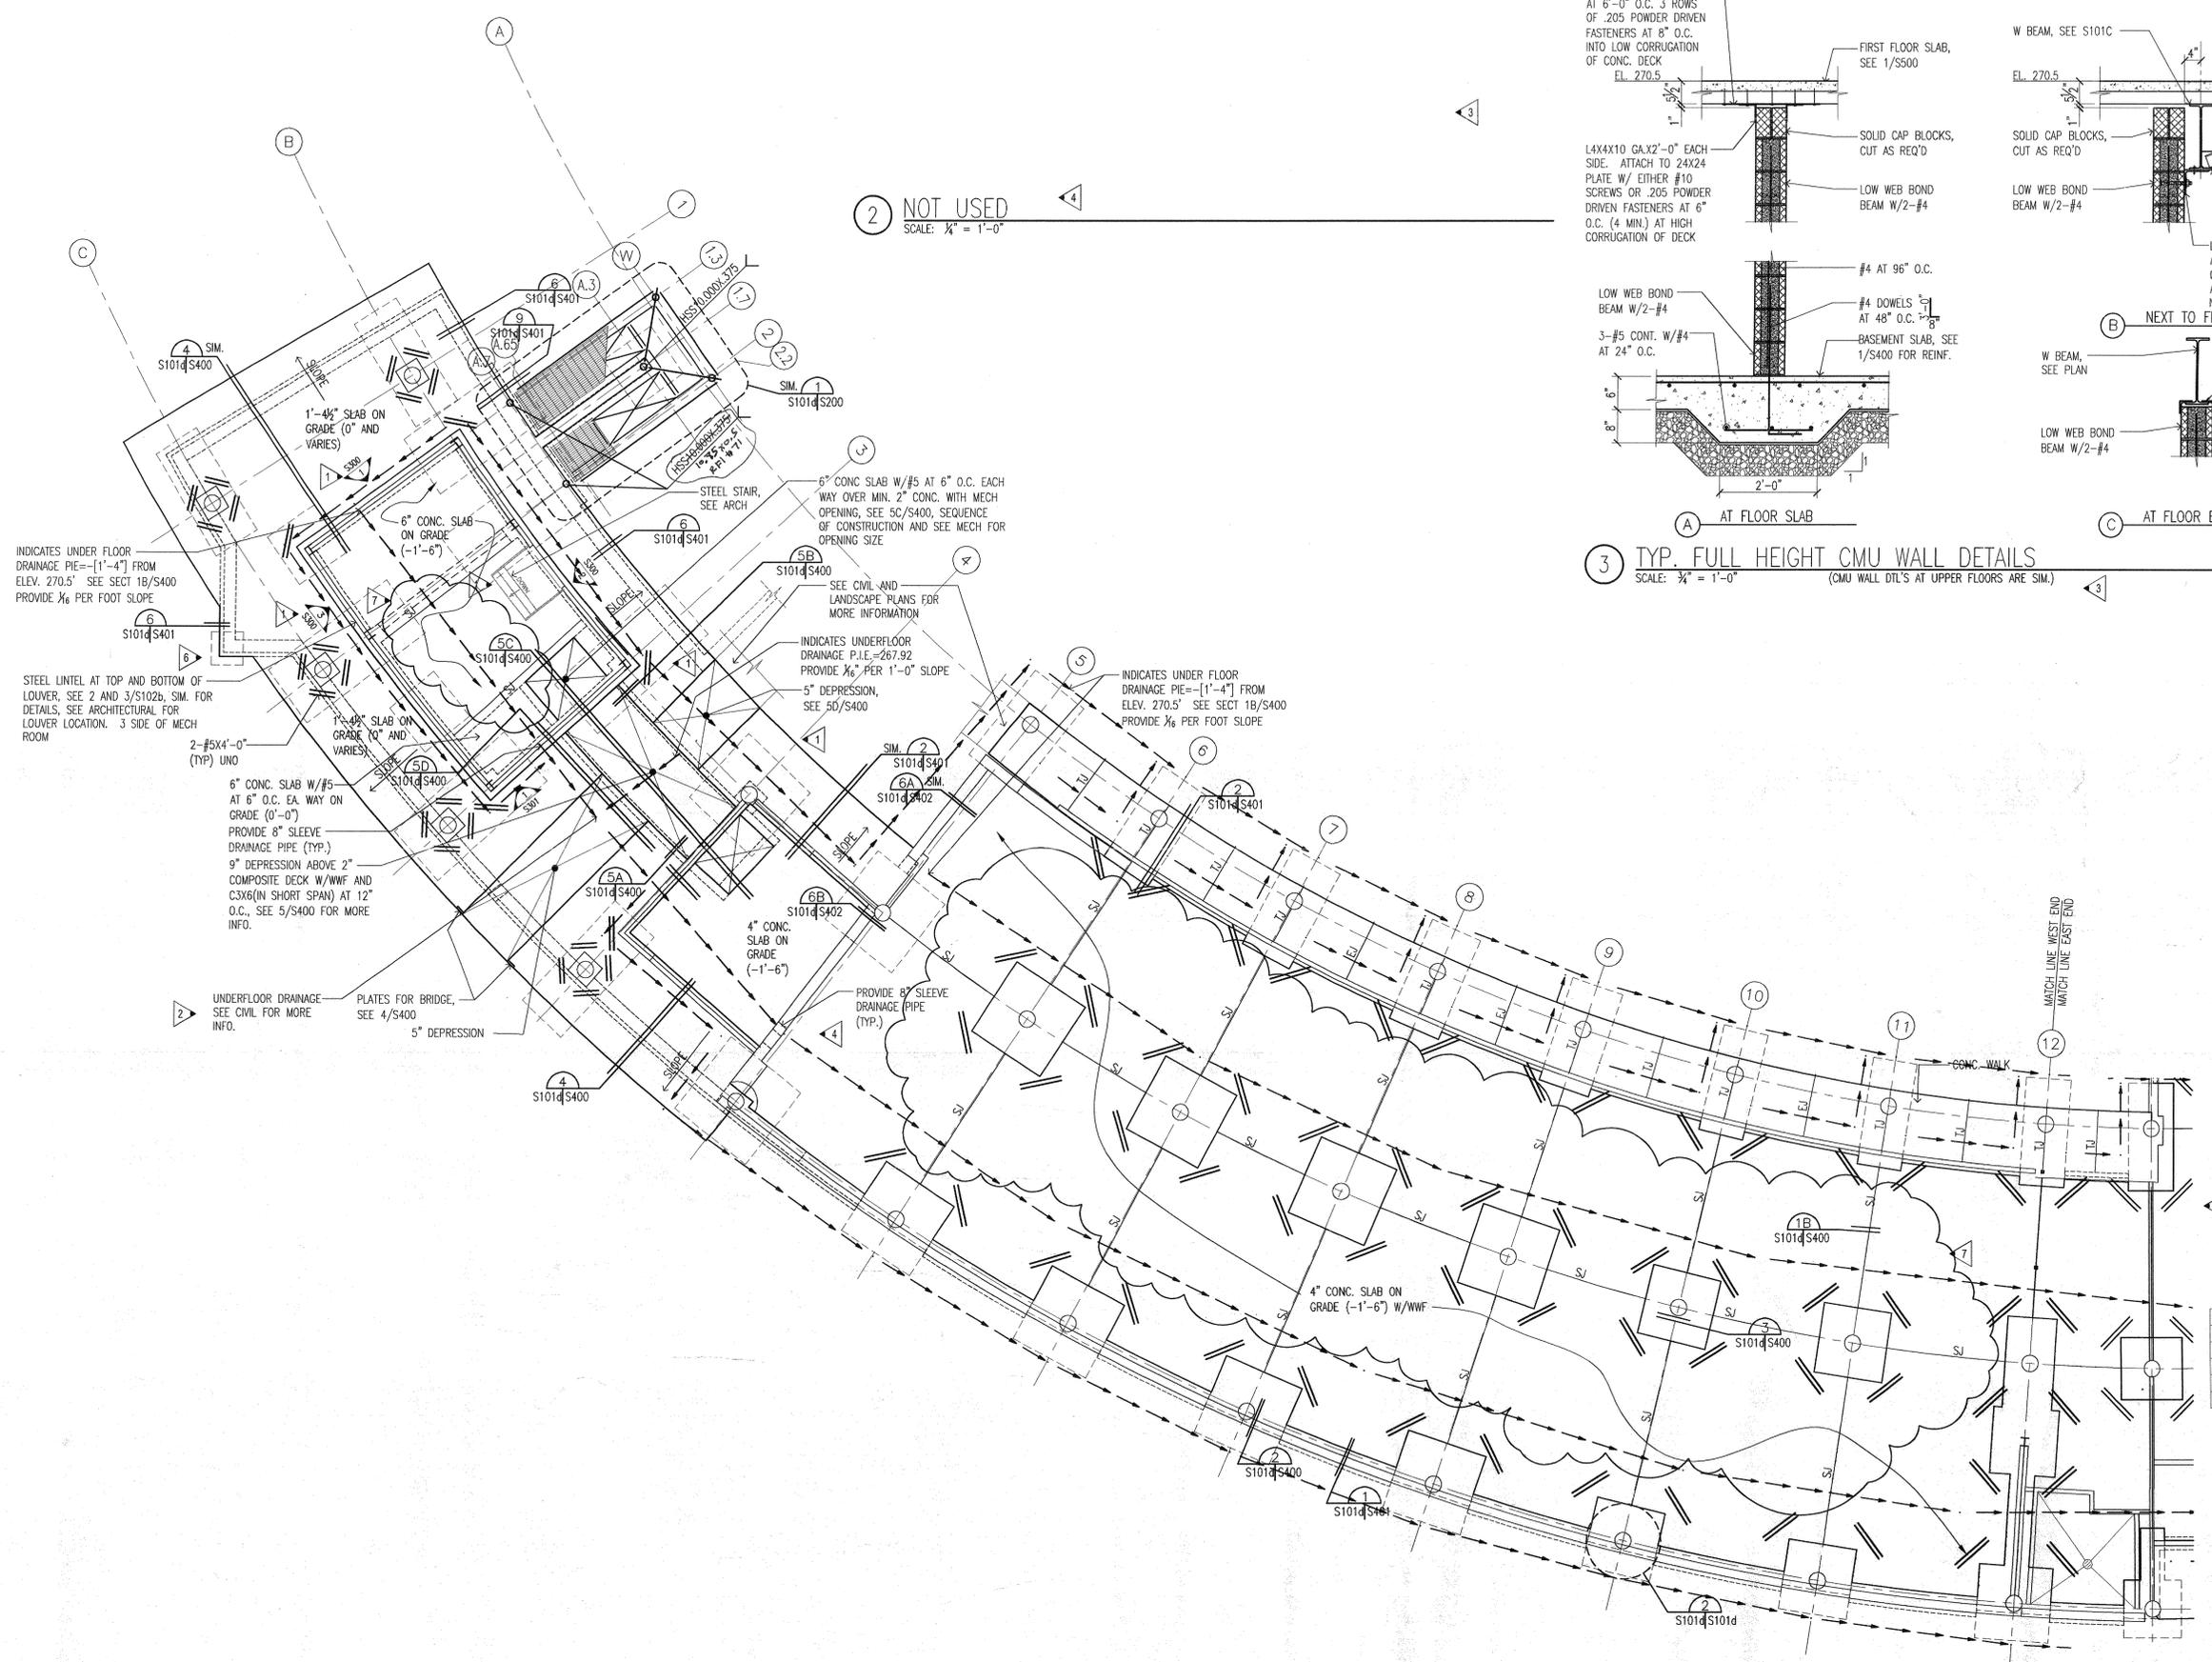

1 SLAB ON GRADE PLAN - WEST END
 SCALE: 3/8" = 1'-0"

1. SEE SH. S002 FOR PLAN SHOWING SLAB ELEV'S AND THICKNESS.
 2. SEE SHEET G003 AND ARCH. PLANS FOR DIM.'S NOT GIVEN

TOP OF STEEL ELEVATIONS:
 HI = -5 1/2" BELOW RAISED ARCH FLOOR
 MID = -7" BELOW RAISED ARCH FLOOR
 LO = -1'-11 1/2" BELOW RAISED ARCH FLOOR
 AS TYPICAL T.O.S. NOT SHOWN ON PLAN

