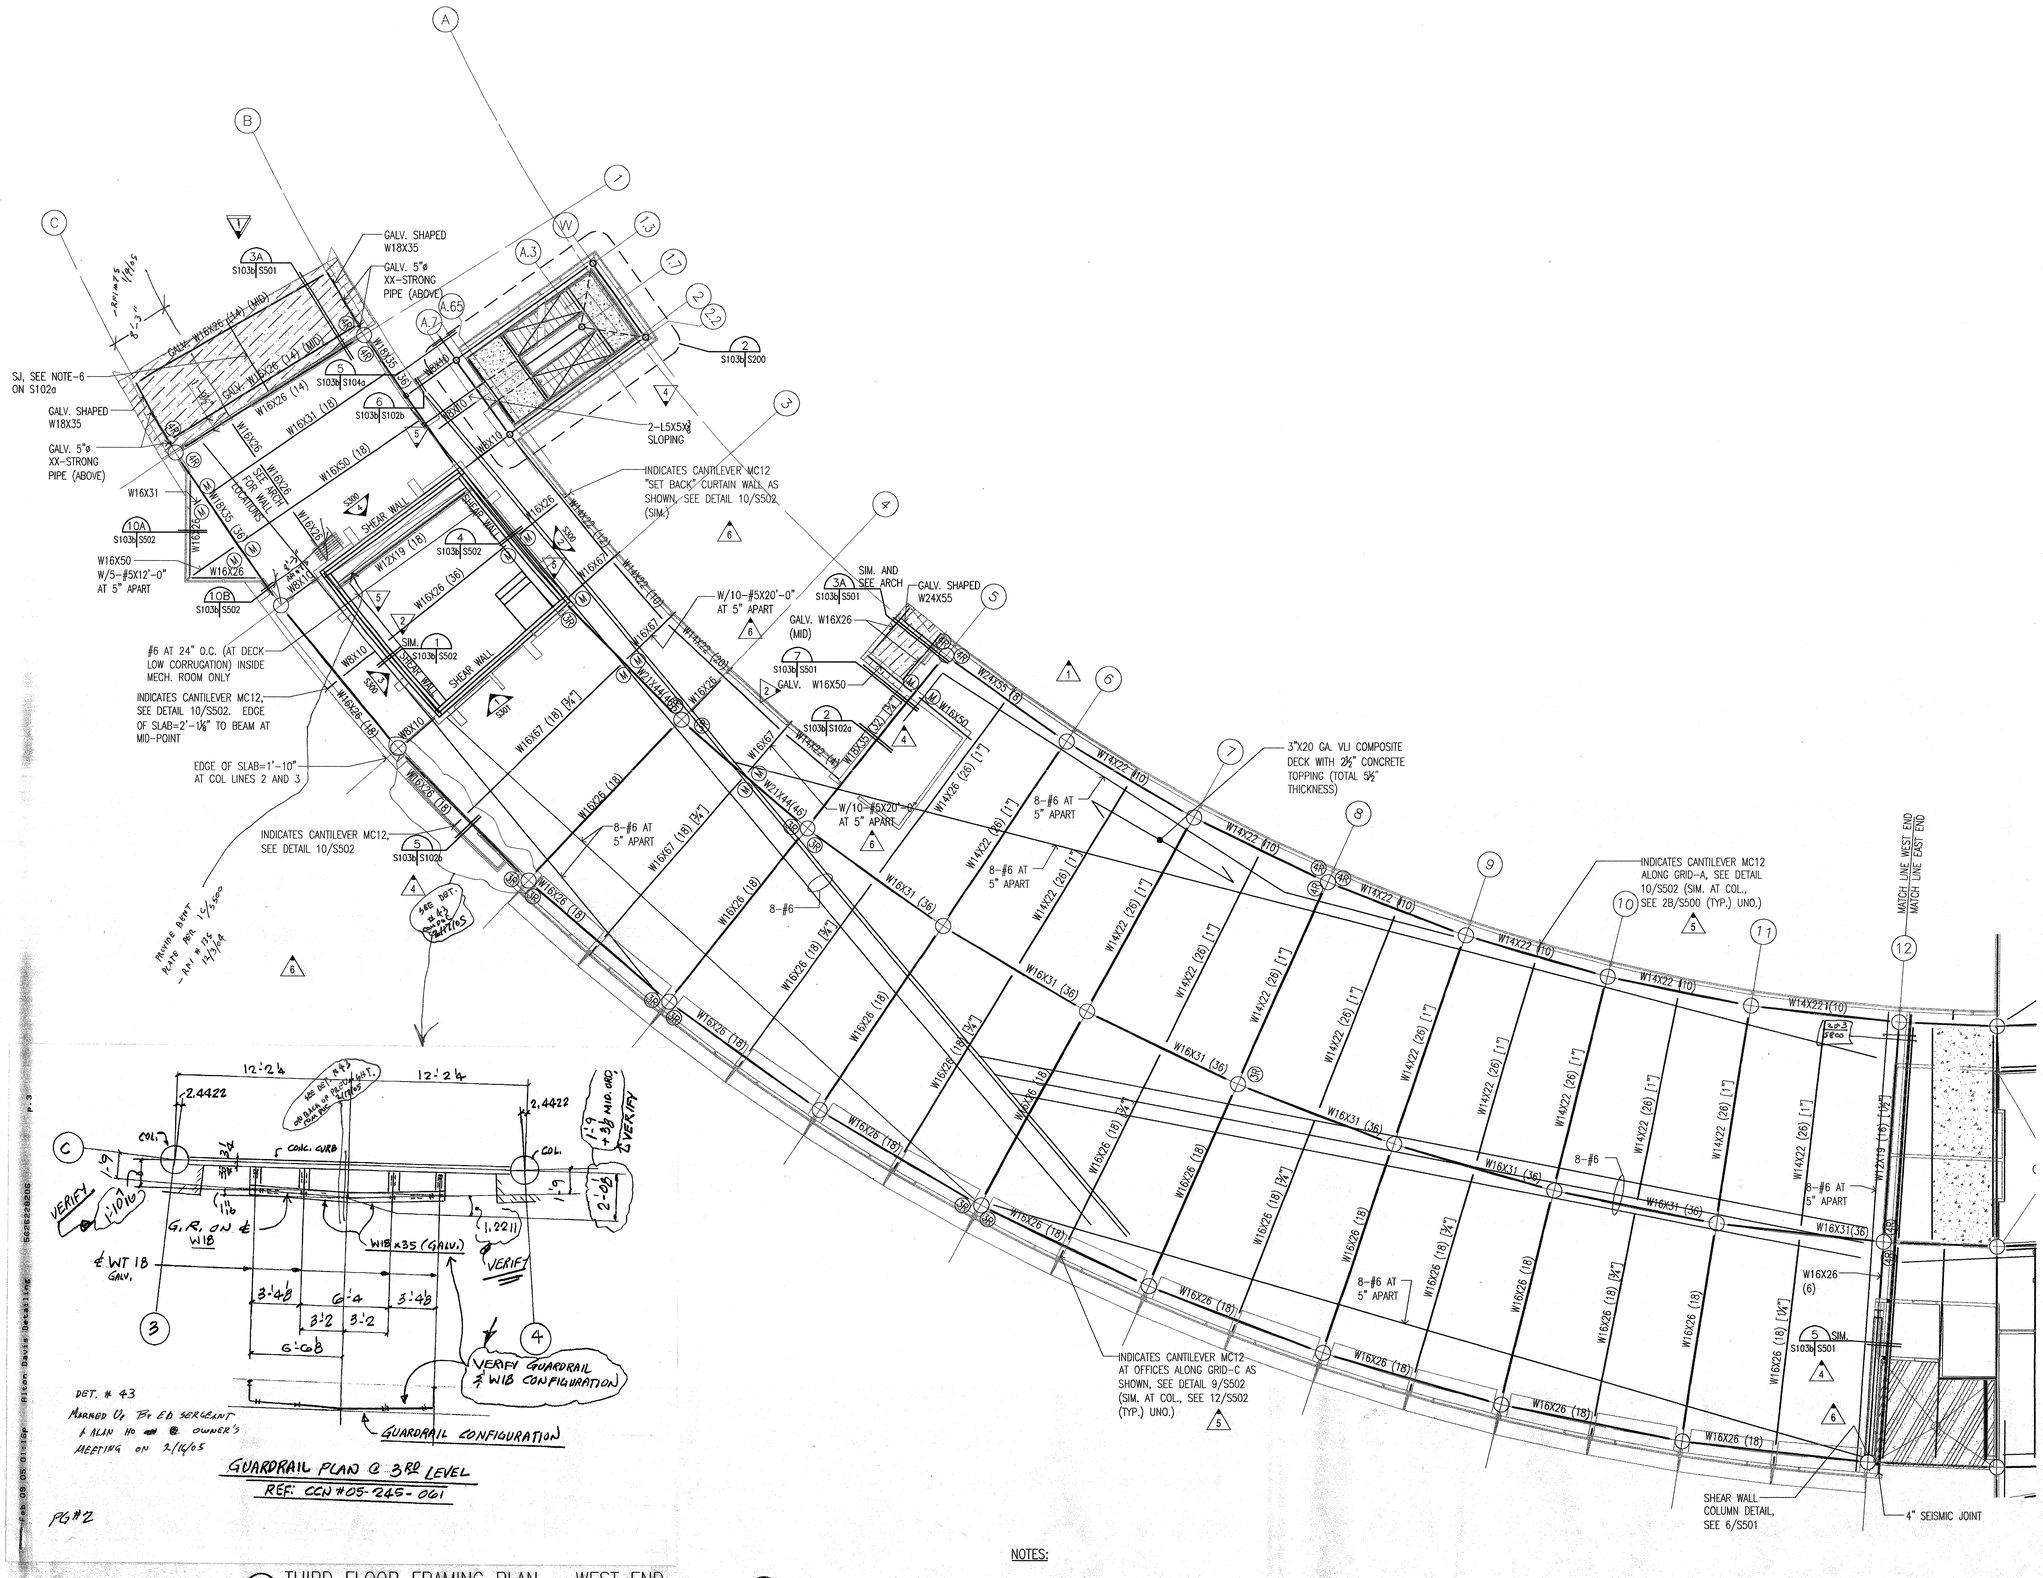

1 THIRD FLOOR FRAMING PLAN – WEST END

SCALE: ⅛" = 1'-0"

NORTH

TOP OF STEEL ELEVATIONS:
HI = –5½" BELOW RAISED ARCH FLOOR
MID = –7" BELOW RAISED ARCH FLOOR
LO = –1'-11½" BELOW RAISED ARCH FLOOR
AS TYPICAL T.O.S. NOT SHOWN ON PLAN

NOTES:

1. SEE NOTES ON S102a

POLK STANLEY YEARY
ARCHITECTS, LTD.

700 SOUTH SCHILLER
LITTLE ROCK, AR 72201
501 378-0878
FAX 372-7629

21 W. MOUNTAIN, SUITE 227
FAYETTEVILLE, AR 72701
479-444-0473

CONSULTANTS:

OWNER'S PROJECT ADVISOR:
MOSES TUCKER REAL ESTATE, INC.

CIVIL ENGINEER:
McCLELLAND ENGINEERS

LANDSCAPE ARCHITECT:
LARSON BURNS SMITH

STRUCTURAL ENGINEER:
CROMWELL ENGINEERS INC.

MECH., ELEC., PLUMB. ENGINEER:
CROMWELL ENGINEERS INC.

SUSTAINABLE CONSULTANT:
BNIM / ELEMENTS

GLOBAL VILLAGE CONSULTANT
CAMBRIDGE SEVEN ASSOCIATES

INTERIOR DESIGNER:
POLK STANLEY YEARY

GENERAL CONTRACTOR:
CDI

GENERAL NOTES:

NOTES:

ISSUE DATE:
NOVEMBER 17, 2003
STRUCTURAL/FOUNDATION PACKAGE #4

REVISIONS:

#	DATE	DESCRIPTION
1	12/1/2003	ADDENDUM 1
2	12/11/2003	ADDENDUM 2
3	01/19/2004	PACKAGE 4 - ADDM. 04
4	02/26/2004	PACKAGE 4 - ADDM. 05
5	03/23/2004	PACKAGE 4 - ADDM. 07
6	06/1/2004	ASI #2

HEIFER INTERNATIONAL CENTER OFFICE BUILDING

LITTLE ROCK, ARKANSAS

PSY PROJECT NUMBER:
431C

CONTENTS:
THIRD FLOOR FRAMING PLAN - WEST END

SHEET NUMBER:
S103b

CERTIFICATE OF AUTHORIZATION CROMWELL ENGINEERS #55 ARKANSAS ENGINEERS

ARKANSAS REGISTERED PROFESSIONAL ENGINEER 12/17/03