

CONSULTANTS:

OWNER'S PROJECT ADVISOR:
MOSES TUCKER REAL ESTATE, INC.

CIVIL ENGINEER:
MCLELLAND ENGINEERS

LANDSCAPE ARCHITECT:
LARSON BURNS SMITH

STRUCTURAL ENGINEER:
CROMWELL ENGINEERS INC.

MECH., ELEC., PLUMB. ENGINEER:
CROMWELL ENGINEERS INC.

SUSTAINABLE CONSULTANT:
BNM / ELEMENTS

GLOBAL VILLAGE CONSULTANT
CAMBRIDGE SEVEN ASSOCIATES

INTERIOR DESIGNER:
POLK STANLEY YEARY

GENERAL CONTRACTOR:
CDI

GENERAL NOTES:

NOTES:

ISSUE DATE:
NOVEMBER 17, 2003
STRUCTURAL FOUNDATION
PACKAGE #4

REVISIONS:

#	DATE	DESCRIPTION
1	12/1/2003	ADDENDUM 1
2	12/11/2003	ADDENDUM 2
3	01/19/2004	PACKAGE 4 - ADDM. 04
4	02/26/2004	PACKAGE 4 - ADDM. 05
5	03/23/2004	PACKAGE 4 - ADDM. 07
6	06/1/2004	ASI #2
7	6/21/2004	ASH#3
8	7/01/2004	PACKAGE 7
9	7/12/2004	ASH#8
10	7/16/2004	ASH#10
11	8/26/2004	ASH#17

HEIFER INTERNATIONAL CENTER OFFICE BUILDING
LITTLE ROCK, ARKANSAS

PSY PROJECT NUMBER:
431C


CONTENTS:
FOURTH FLOOR FRAMING
PLAN - EAST END
SHEET NUMBER:
S104a




1 FOURTH FLOOR FRAMING PLAN - EAST END

SCALE: 3/8" = 1'-0"
TOP OF STEEL ELEVATIONS:
HI = -5 1/2" BELOW RAISED ARCH FLOOR
MID = -7" BELOW RAISED ARCH FLOOR
LO = -1'-11 1/2" BELOW RAISED ARCH FLOOR
AS TYPICAL T.O.S. NOT SHOWN ON PLAN

ADD CONC. CURB @ LEVELS 2, 3, 4 ALONG C.L. - C. BEYOND G.L. 12.813 AND G.L. 14.15 TO SUPPORT GLASS BALCONY. CURB @ EDGE OF SLAB, 6" HIGH, TD OR CURB = FIN. CONC. 2000. 608 1/2" x 26" FOR REINFORCEMENT.
- PER FAX BY MD SARGENT - PARCO - 10/31/04.

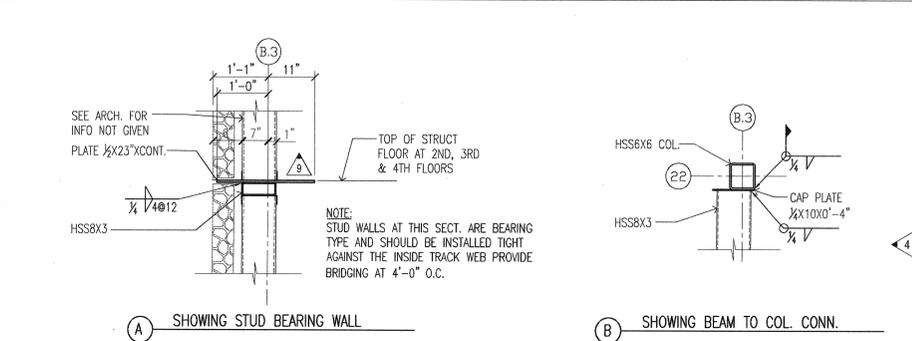

2 SECTION AT FREIGHT ELEV. SOUTH WALL
SCALE: 3/8" = 1'-0" (REF. 12/S603a)

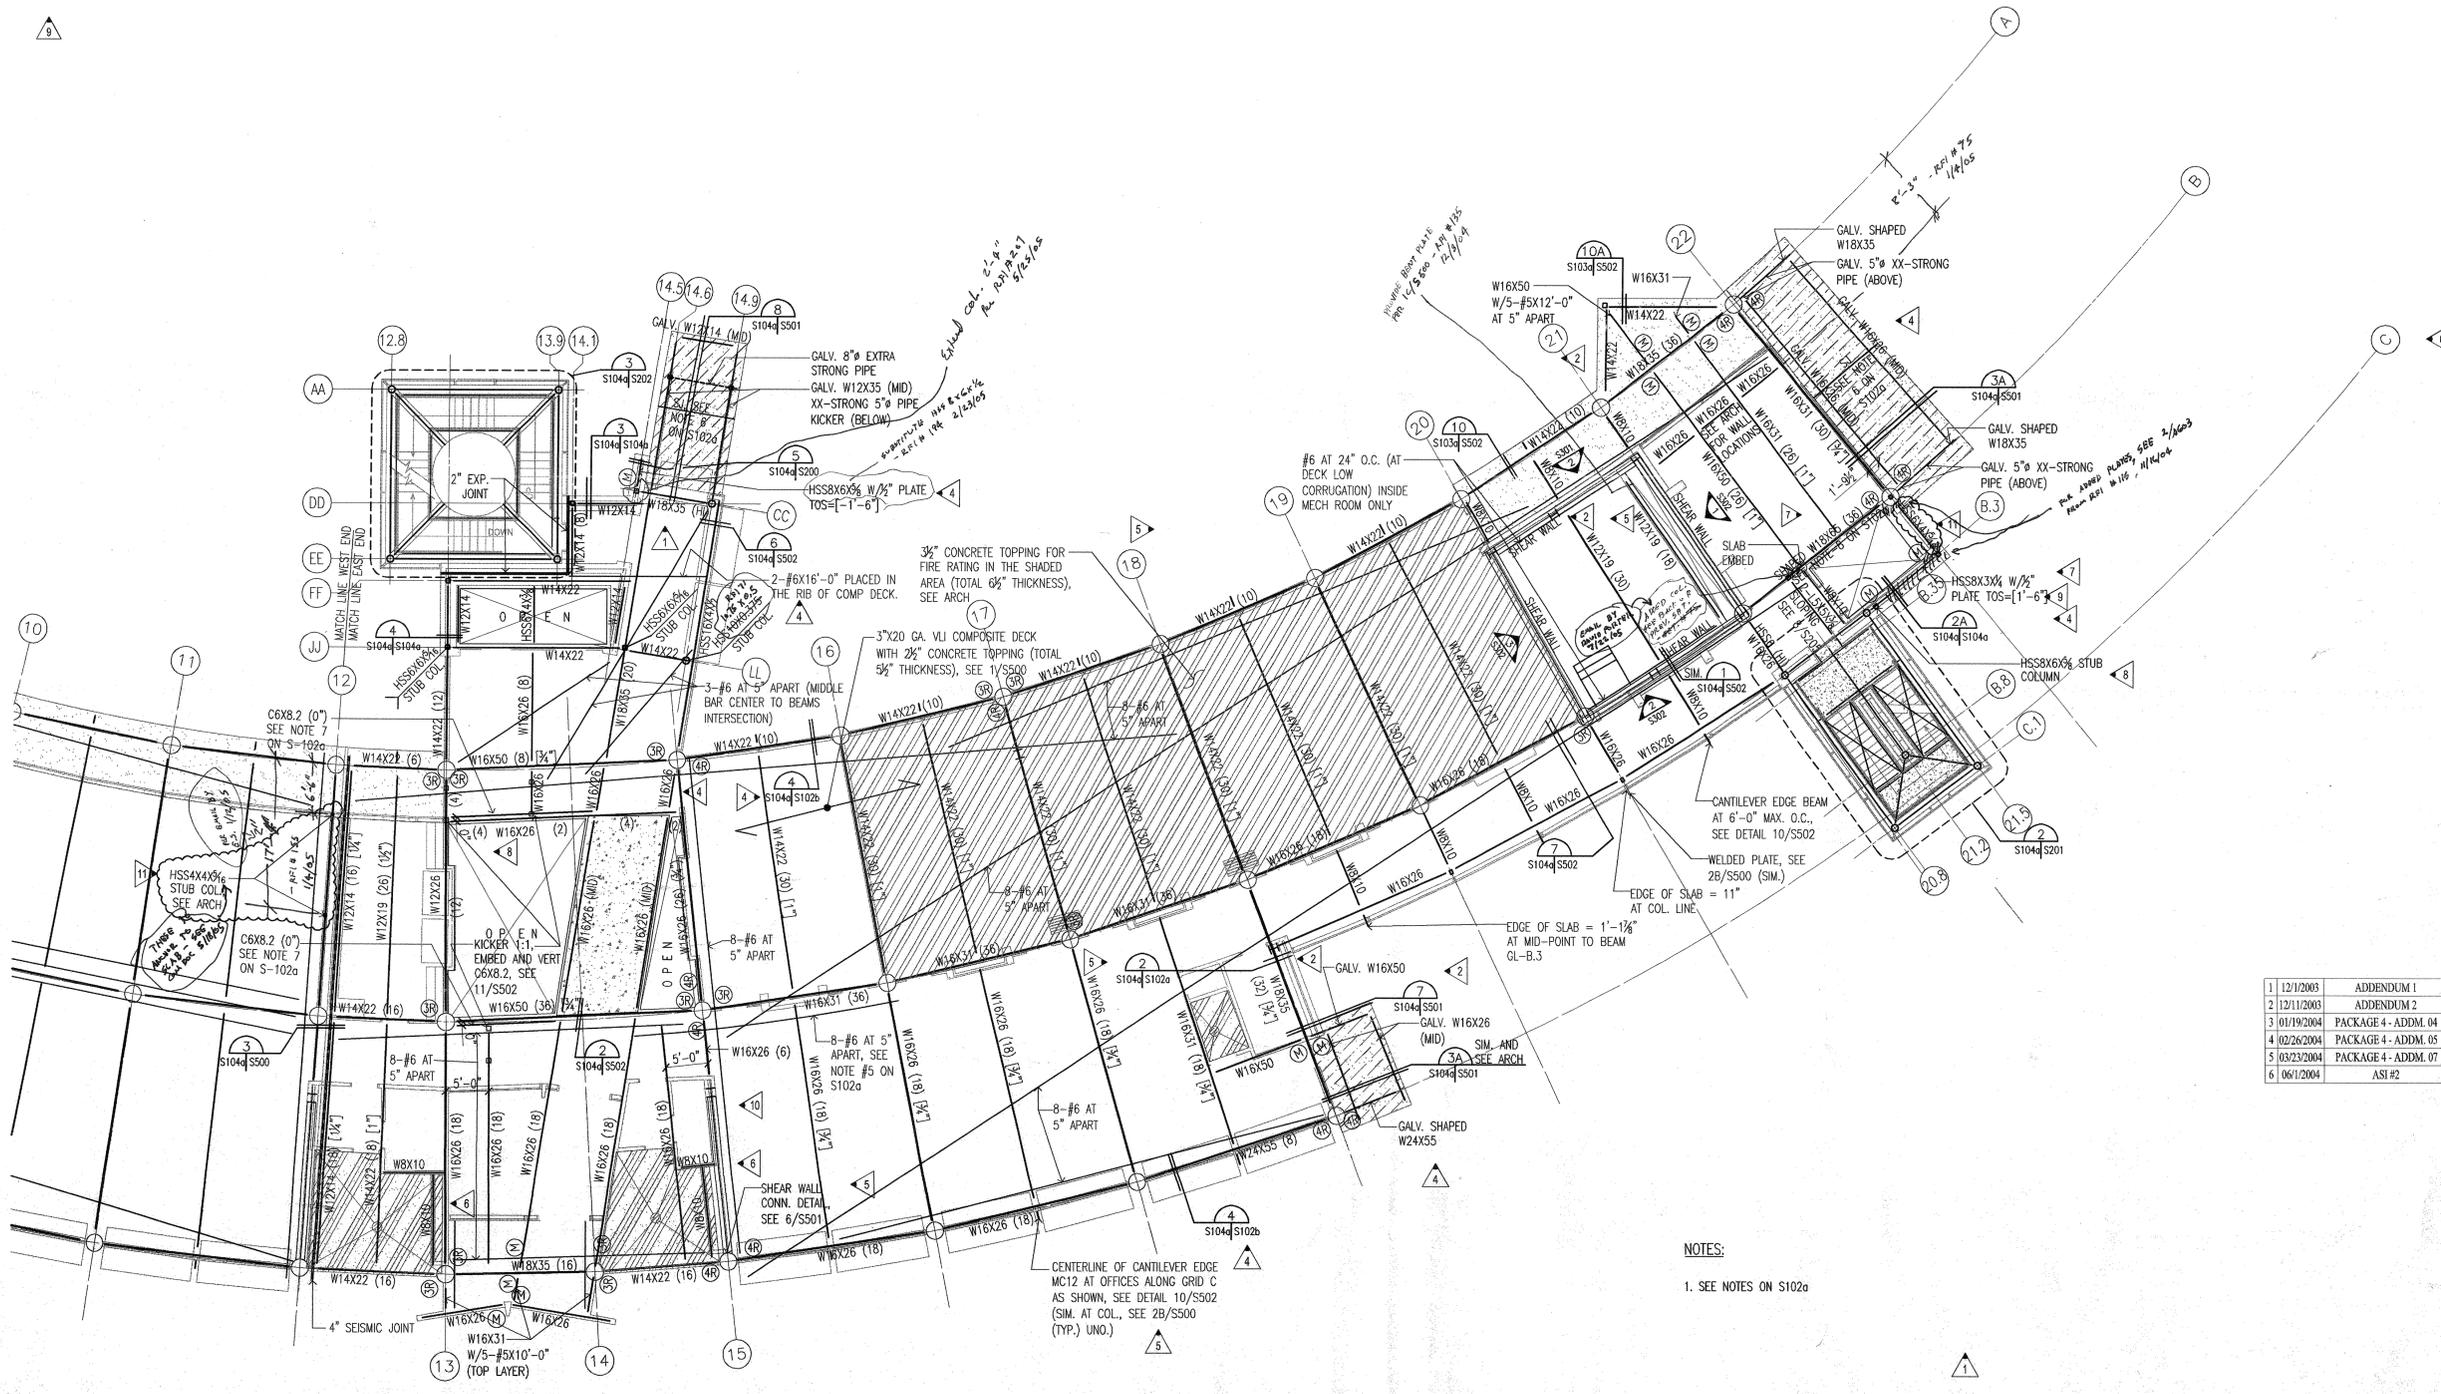

F:\Projects\2001\2001_066\2001066.dwg, 08/27/2004 9:52:57 AM