

**CONSULTANTS:**  
 OWNER'S PROJECT ADVISOR:  
 MOSES TUCKER REAL ESTATE, INC.  
 CIVIL ENGINEER:  
 McCLELLAND ENGINEERS  
 LANDSCAPE ARCHITECT:  
 LARSON BURNS SMITH  
 STRUCTURAL ENGINEER:  
 CROMWELL ENGINEERS INC.  
 MECH., ELEC., PLUMB. ENGINEER:  
 CROMWELL ENGINEERS INC.  
 SUSTAINABLE CONSULTANT:  
 BNM / ELEMENTS  
 GLOBAL VILLAGE CONSULTANT  
 CAMBRIDGE SEVEN ASSOCIATES  
 INTERIOR DESIGNER:  
 POLK STANLEY YEARY  
 GENERAL CONTRACTOR:  
 CDI

**GENERAL NOTES:**

**NOTES:**



ISSUE DATE:  
 NOVEMBER 17, 2003  
 STRUCTURAL/FOUNDATION  
 PACKAGE #4  
 REVISIONS:

#	DATE	DESCRIPTION
1	12/1/2003	ADDENDUM 1
2	12/1/2003	ADDENDUM 2
3	01/19/2004	PACKAGE 4 - ADDM. 04
4	02/26/2004	PACKAGE 4 - ADDM. 05
5	03/23/2004	PACKAGE 4 - ADDM. 07
6	06/1/2004	ASI #2

**HEIFER INTERNATIONAL CENTER OFFICE BUILDING**  
 LITTLE ROCK, ARKANSAS

PSY PROJECT NUMBER:  
 431C

CONTENTS:  
 FOURTH FLOOR FRAMING PLAN - WEST END  
 SHEET NUMBER:  
**S104b**

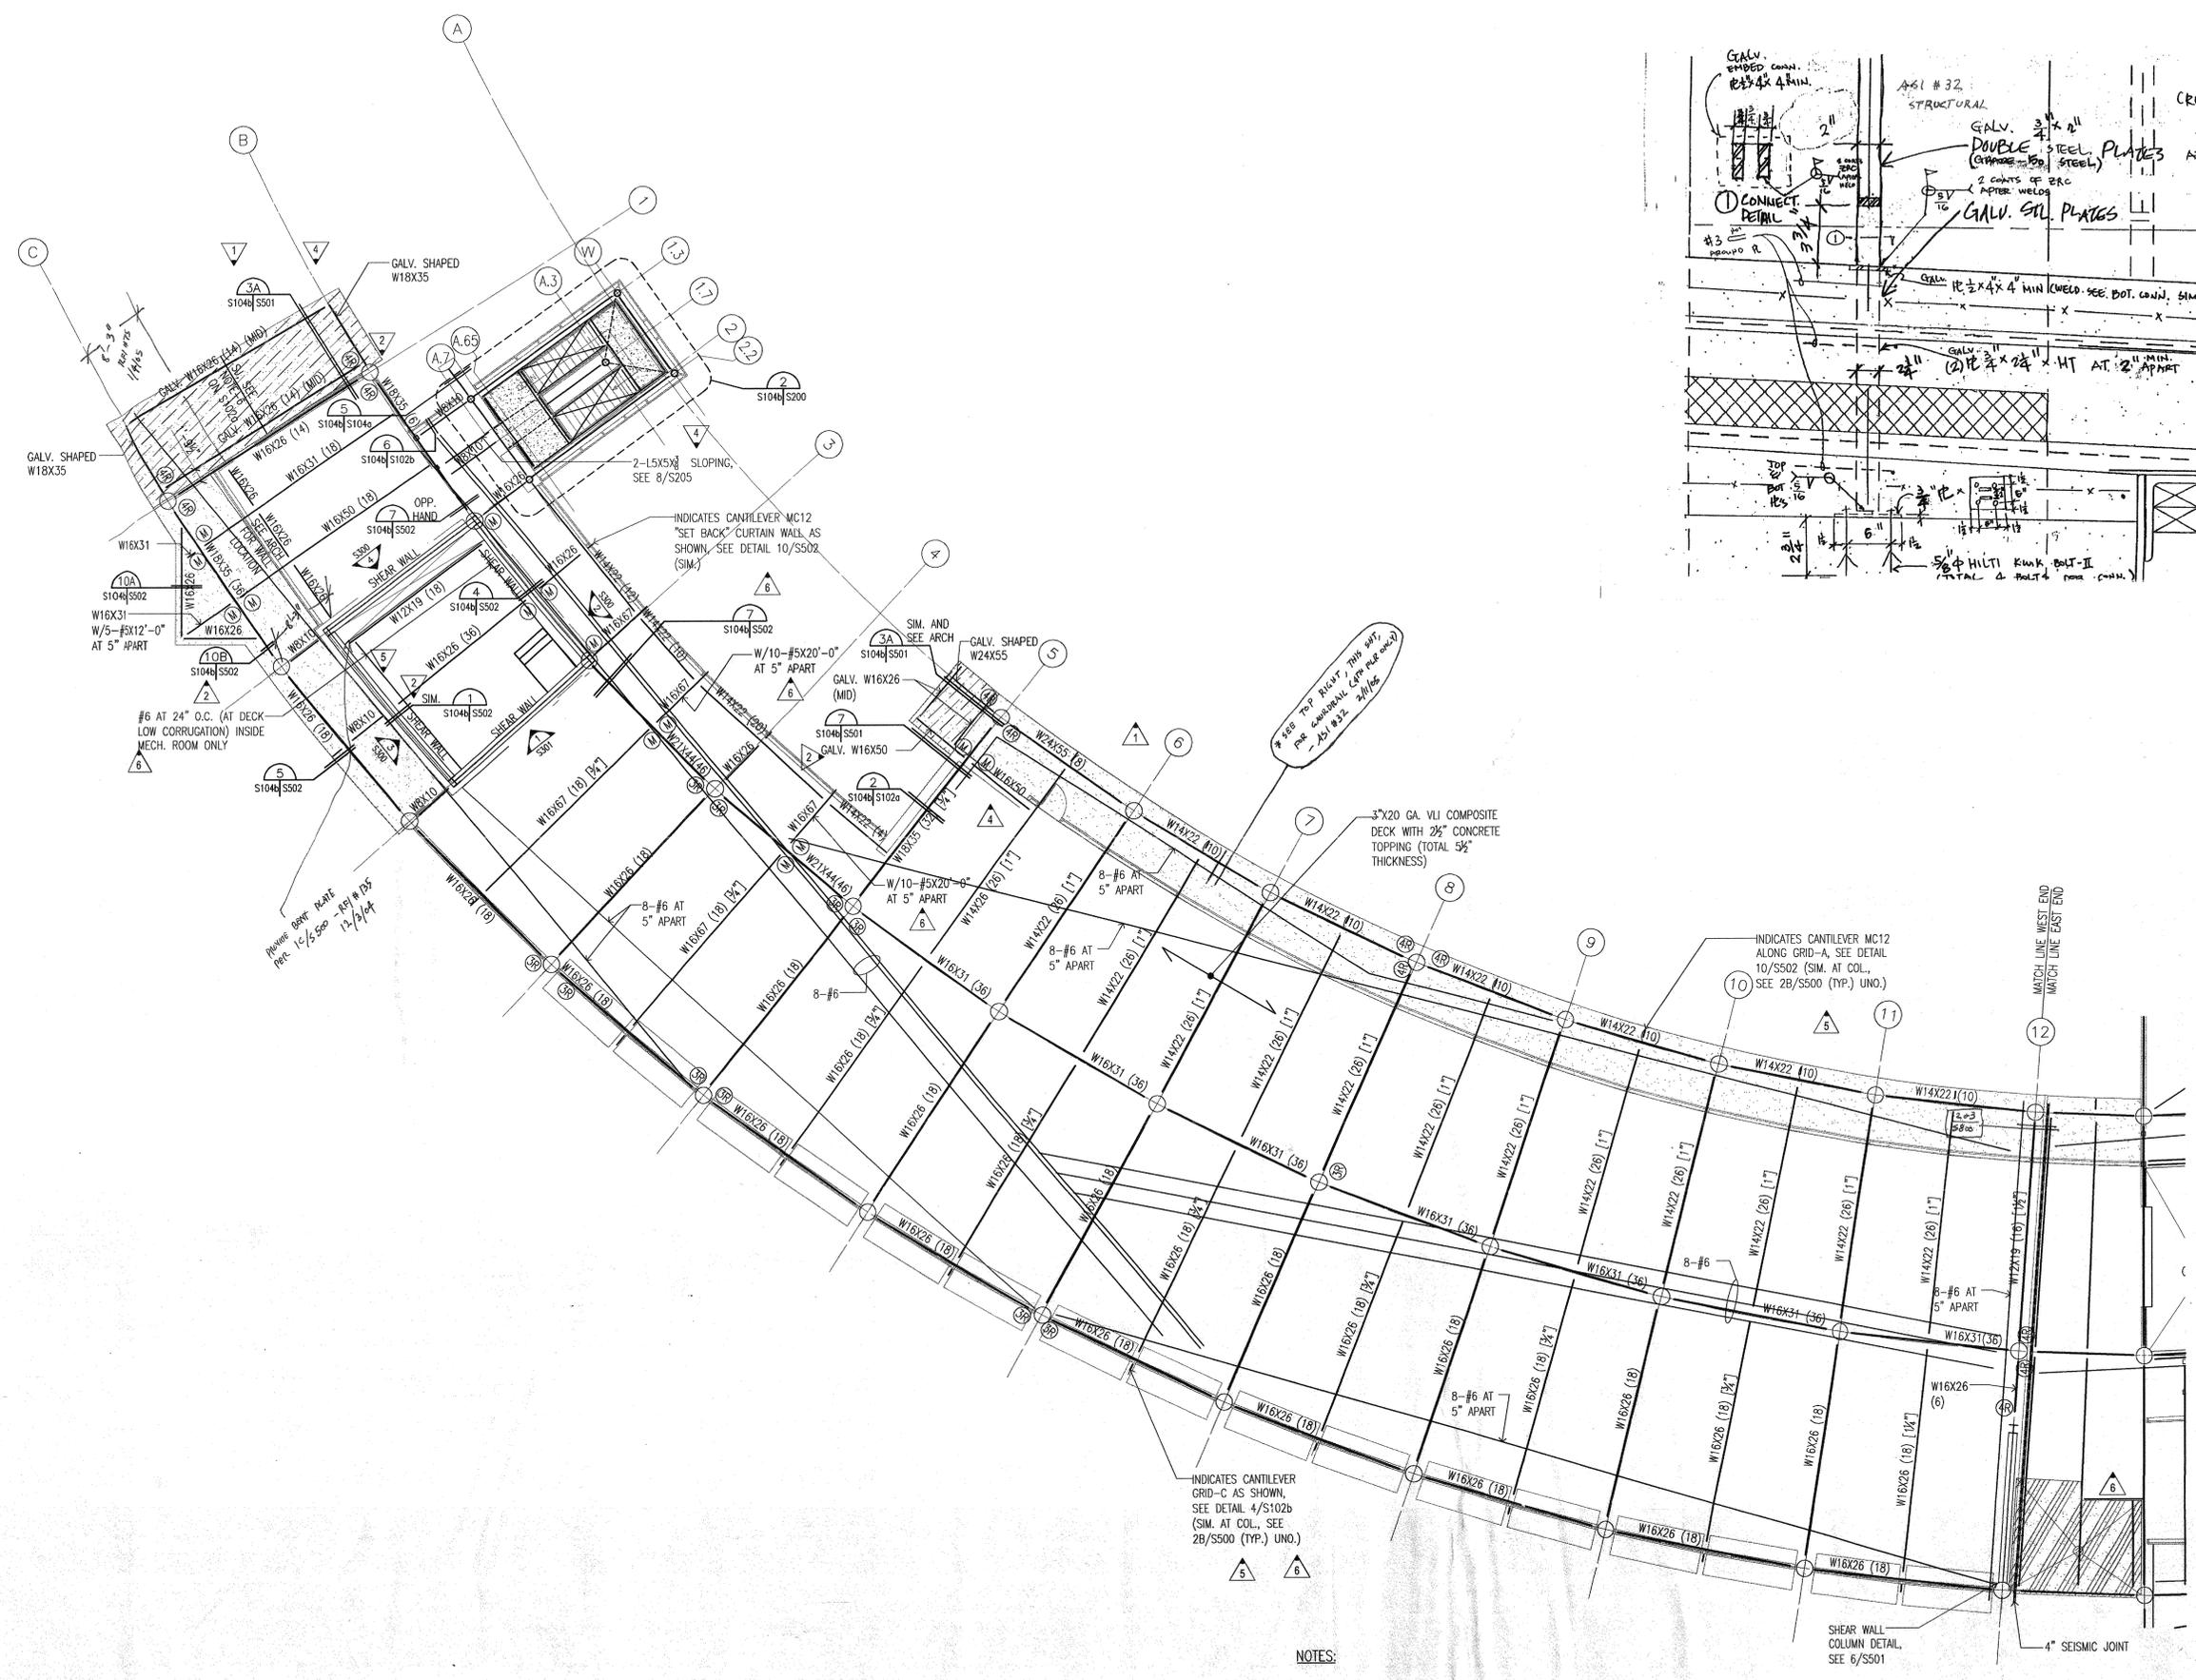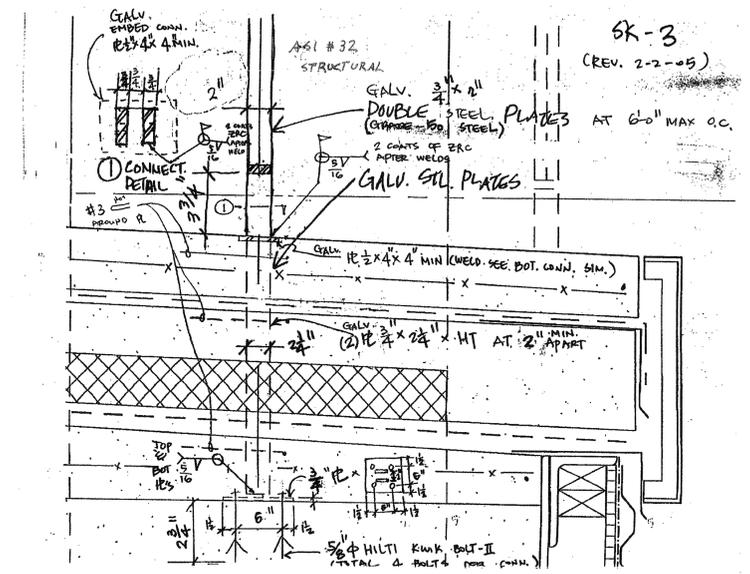

**1** FOURTH FLOOR FRAMING PLAN - WEST END  
 SCALE: 3/8" = 1'-0"

TOP OF STEEL ELEVATIONS:  
 HI = -5 1/2" BELOW RAISED ARCH FLOOR  
 MID = -7" BELOW RAISED ARCH FLOOR  
 LO = -1'-1 1/4" BELOW RAISED ARCH FLOOR  
 AS TYPICAL T.O.S. NOT SHOWN ON PLAN



**NOTES:**  
 1. SEE NOTES ON S102a

