

CONSULTANTS:

OWNER'S PROJECT ADVISOR:
MOSES TUCKER REAL ESTATE, INC.

CIVIL ENGINEER:
McCLELLAND ENGINEERS

LANDSCAPE ARCHITECT:
LARSON BURNS SMITH

STRUCTURAL ENGINEER:
CROMWELL ENGINEERS INC.

MECH., ELEC., PLUMB. ENGINEER:
CROMWELL ENGINEERS INC.

SUSTAINABLE CONSULTANT:
BNIM / ELEMENTS

GLOBAL VILLAGE CONSULTANT
CAMBRIDGE SEVEN ASSOCIATES

INTERIOR DESIGNER:
POLK STANLEY YEARY

GENERAL CONTRACTOR:
CDI

GENERAL NOTES:

NOTES:

ISSUE DATE:
NOVEMBER 17, 2003
STRUCTURAL/FOUNDATION
PACKAGE #4

REVISIONS:

#	DATE	DESCRIPTION
1	12/1/2003	ADDENDUM 1
2	12/1/2003	ADDENDUM 2
3	01/19/2004	PACKAGE 4 - ADDM. 04
4	06/1/2004	ASI #2
5	07/16/2004	ASI #10
6	08/26/2004	ASI #17

**HEIFER
INTERNATIONAL
CENTER
OFFICE BUILDING**


LITTLE ROCK, ARKANSAS

PSY PROJECT NUMBER:
431C

CONTENTS:
ROOF FRAMING PLAN - WEST
END

SHEET NUMBER:

S105b

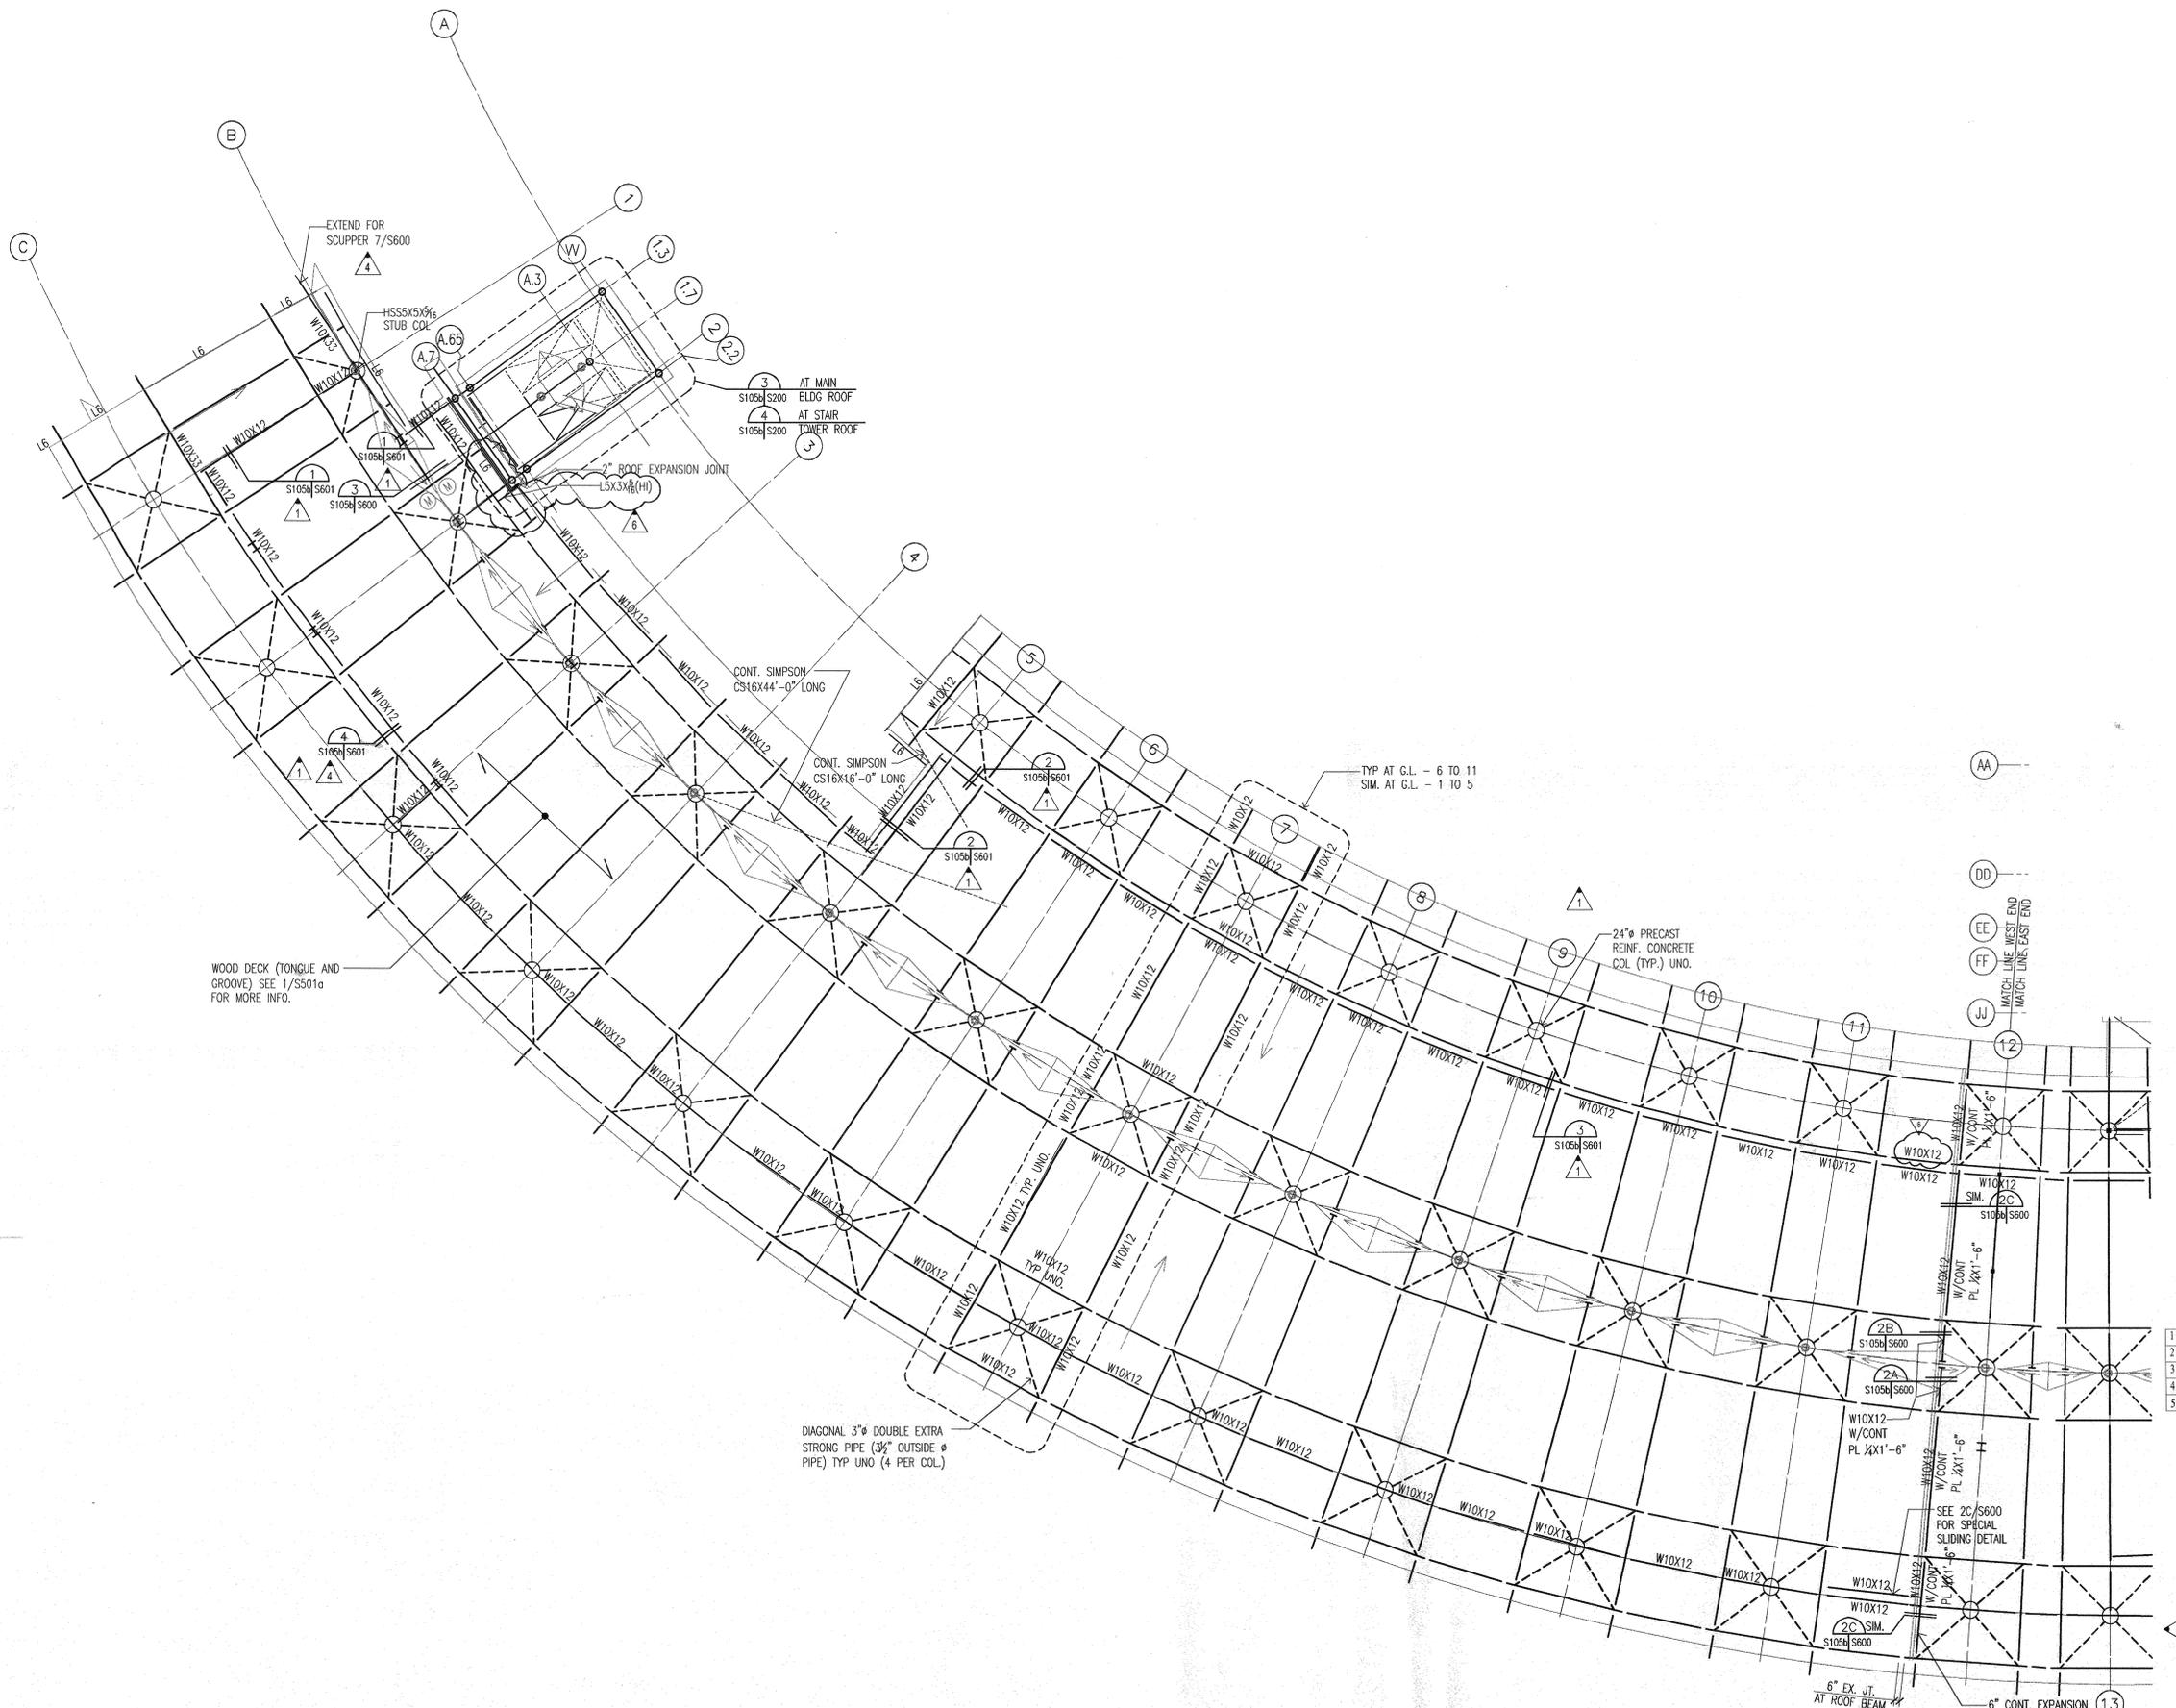

1 ROOF FRAMING PLAN - WEST END
SCALE: 1/8"=1'-0"
FOR NOTES AND TOP OF STEEL, SEE S105b



F:\Projects\2001\2001_066\2001066.dwg, S105b.dwg, 08/27/2004, 9:56:52 AM