

CONSULTANTS:
 OWNER'S PROJECT ADVISOR:
 MOSES TUCKER REAL ESTATE, INC.
 CIVIL ENGINEER:
 McCLELLAND ENGINEERS
 LANDSCAPE ARCHITECT:
 LARSON BURNS SMITH
 STRUCTURAL ENGINEER:
 CROMWELL ENGINEERS INC.
 MECH., ELEC., PLUMB. ENGINEER:
 CROMWELL ENGINEERS INC.
 SUSTAINABLE CONSULTANT:
 BNIM / ELEMENTS
 GLOBAL VILLAGE CONSULTANT
 CAMBRIDGE SEVEN ASSOCIATES
 INTERIOR DESIGNER:
 POLK STANLEY YEARY
 GENERAL CONTRACTOR:
 CDI

GENERAL NOTES:

NOTES:


ISSUE DATE:
 DECEMBER 15, 2003
 CORE/SHELL
 PACKAGE #5
 REVISIONS:

#	DATE	DESCRIPTION
1	6/01/2004	ASI #2
2	7/01/2004	PACKAGE 7
3	8/26/2004	AS#17


HEIFER INTERNATIONAL CENTER OFFICE BUILDING
 LITTLE ROCK, ARKANSAS

PSY PROJECT NUMBER:
 431C


CONTENTS:
 STAIR #1 FRAMING PLAN
 SHEET NUMBER:
S200

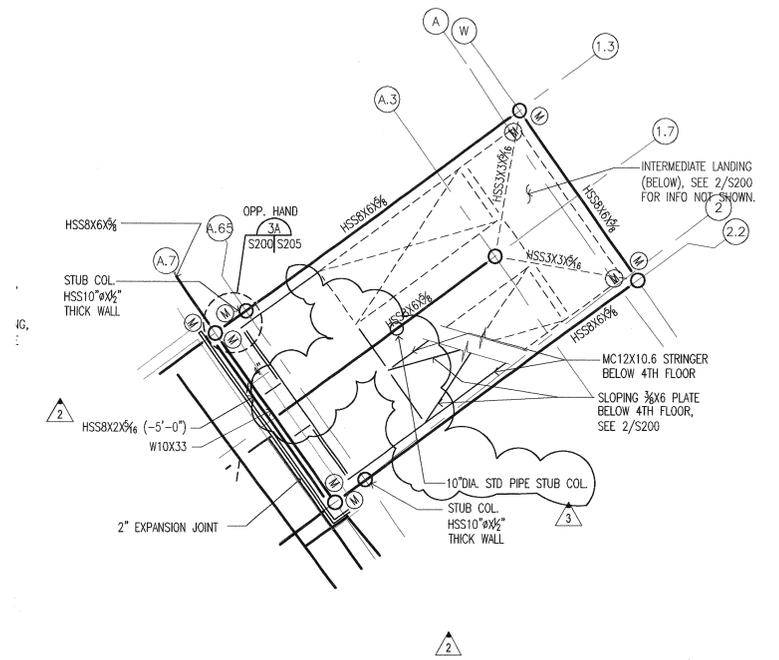

3 STAIR #1 FRAMING PLAN AT MAIN ROOF
 SCALE: 1/4"=1'-0" T.O.S. = 328'-0"

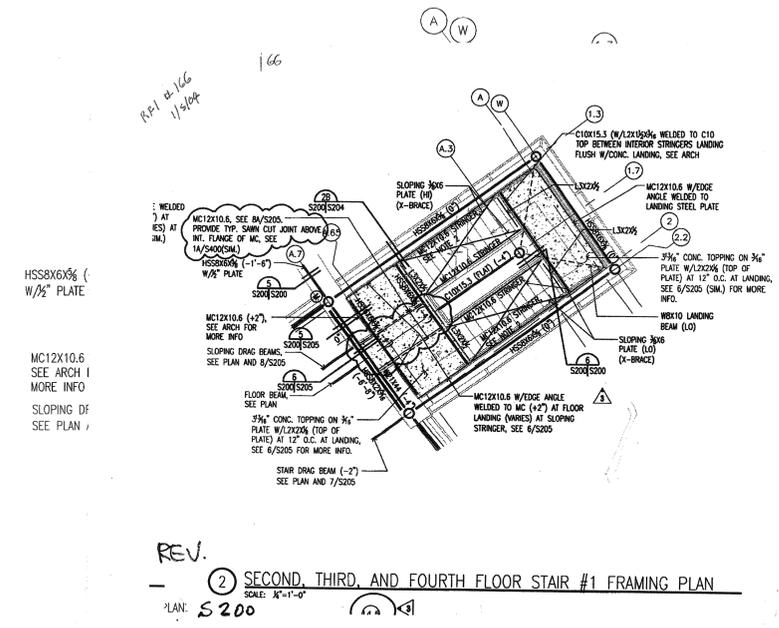


2 SECOND, THIRD, AND FOURTH FLOOR STAIR #1 FRAMING PLAN
 SCALE: 1/4"=1'-0"

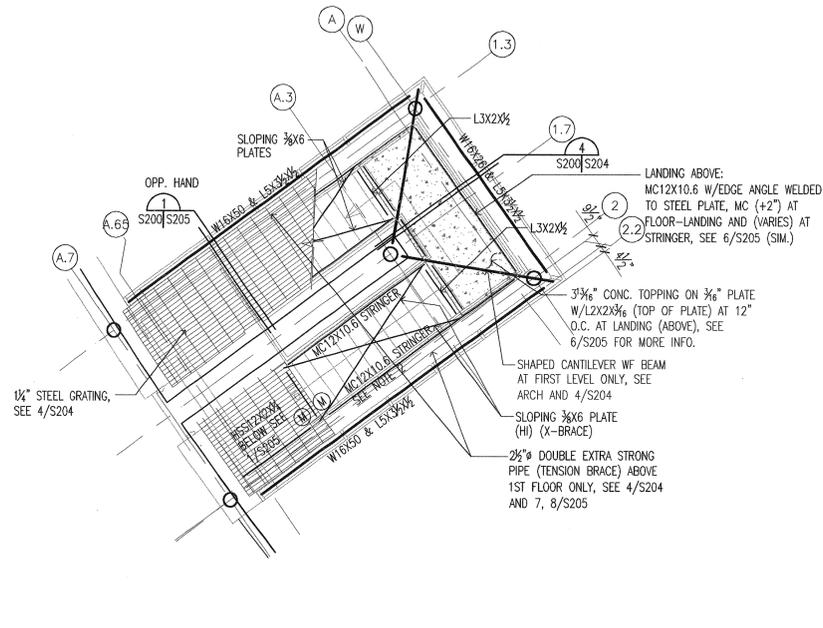


1 FIRST FLOOR STAIR #1 FRAMING PLAN
 SCALE: 1/4"=1'-0"


NOTE:
 1. SEE 1/S205 FOR GALV. STEEL INFO.
 2. MC12 CONT. AT INTERMEDIATE LANDINGS

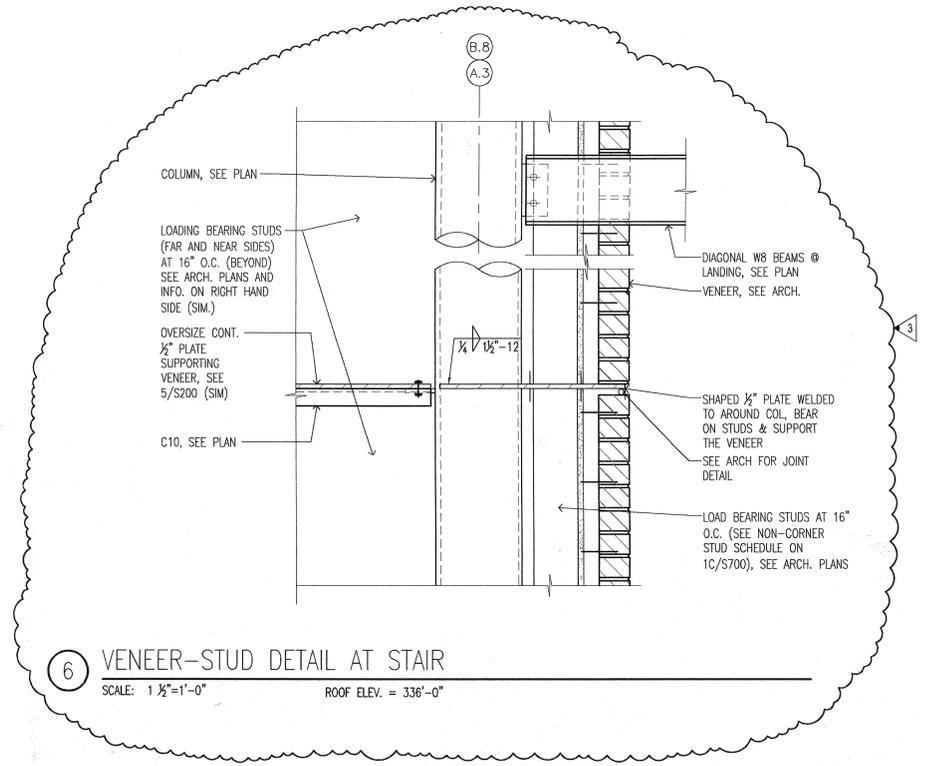

6 VENEER-STUD DETAIL AT STAIR
 SCALE: 1 1/2"=1'-0" ROOF ELEV. = 336'-0"

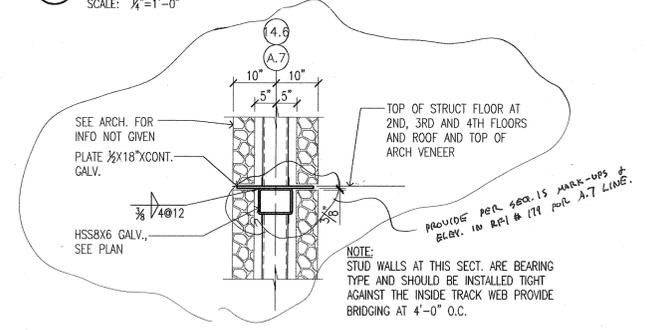

5 TYP SECTION ALONG CANTILEVERED WALLS AT GL A.7 AND 14.6
 SCALE: 3/4"=1'-0"

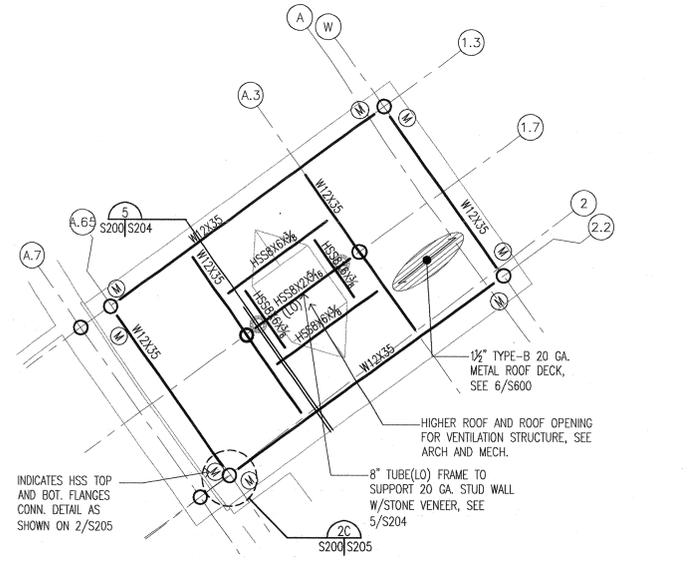

4 STAIR #1 ROOF FRAMING PLAN
 SCALE: 1/4"=1'-0" ROOF ELEV. = 336'-0"

