

CONSULTANTS:
 OWNER'S PROJECT ADVISOR:
 MOSES TUCKER REAL ESTATE, INC.
 CIVIL ENGINEER:
 McCLELLAND ENGINEERS
 LANDSCAPE ARCHITECT:
 LARSON BURNS SMITH
 STRUCTURAL ENGINEER:
 CROMWELL ENGINEERS INC.
 MECH., ELBC., PLUMB. ENGINEER:
 CROMWELL ENGINEERS INC.
 SUSTAINABLE CONSULTANT:
 BNIM / ELEMENTS
 GLOBAL VILLAGE CONSULTANT
 CAMBRIDGE SEVEN ASSOCIATES
 INTERIOR DESIGNER:
 POLK STANLEY YEARY
 GENERAL CONTRACTOR:
 CDI

GENERAL NOTES:

NOTES:

ISSUE DATE:
 DECEMBER 15, 2003
CORE/SHELL PACKAGE #5

REVISIONS:


#	DATE	DESCRIPTION
1	6/01/04	ASI #2
2	8/26/04	ASI #17
3	9/28/04	ASI #19

HEIFER INTERNATIONAL CENTER OFFICE BUILDING
 LITTLE ROCK, ARKANSAS


PSY PROJECT NUMBER:
 431C

CONTENTS:
 STAIR SECTIONS


SHEET NUMBER:
 S204

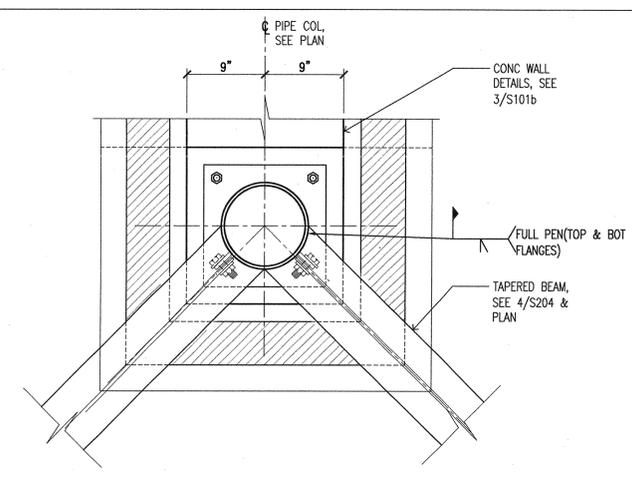


3 PLAN DETAIL AT STAIR INTERIOR COLUMN
 SCALE: 1/2"=1'-0"

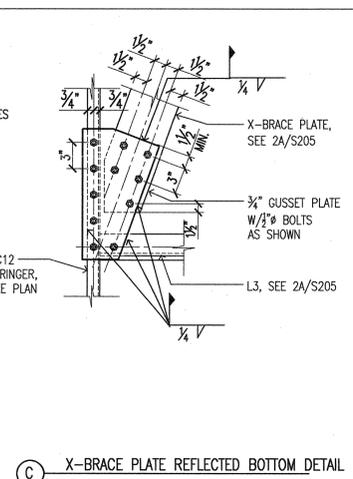


C X-BRACE PLATE REFLECTED BOTTOM DETAIL

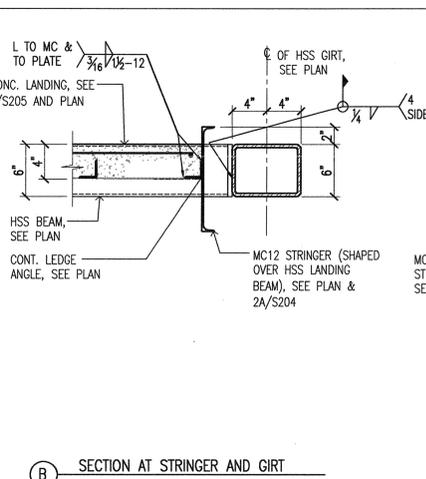


B SECTION AT STRINGER AND GIRT

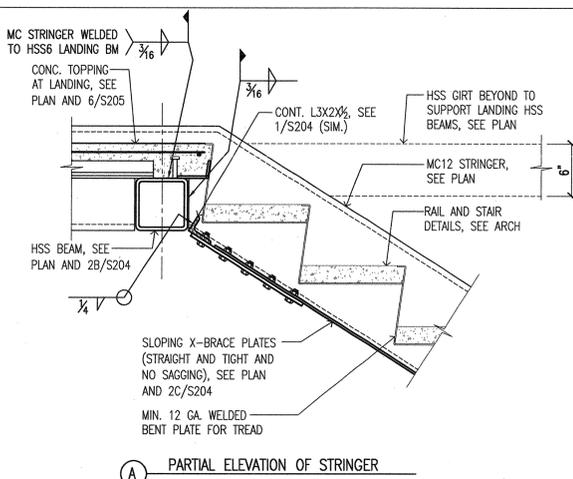


A PARTIAL ELEVATION OF STRINGER

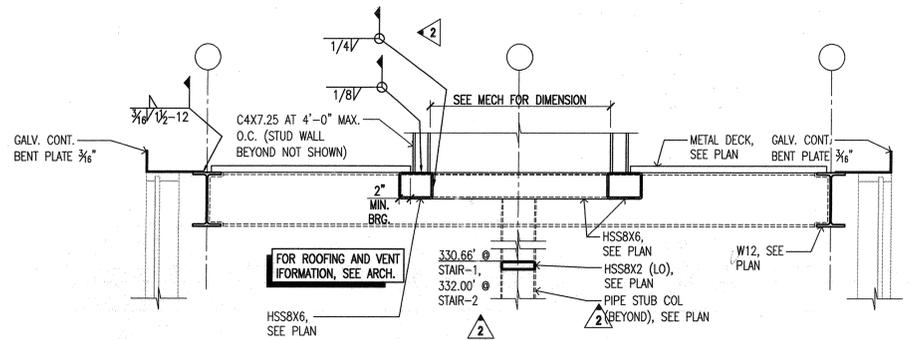

5 SECTION AT STAIR ROOF VENTILATION OPENING
 SCALE: 3/4"=1'-0"

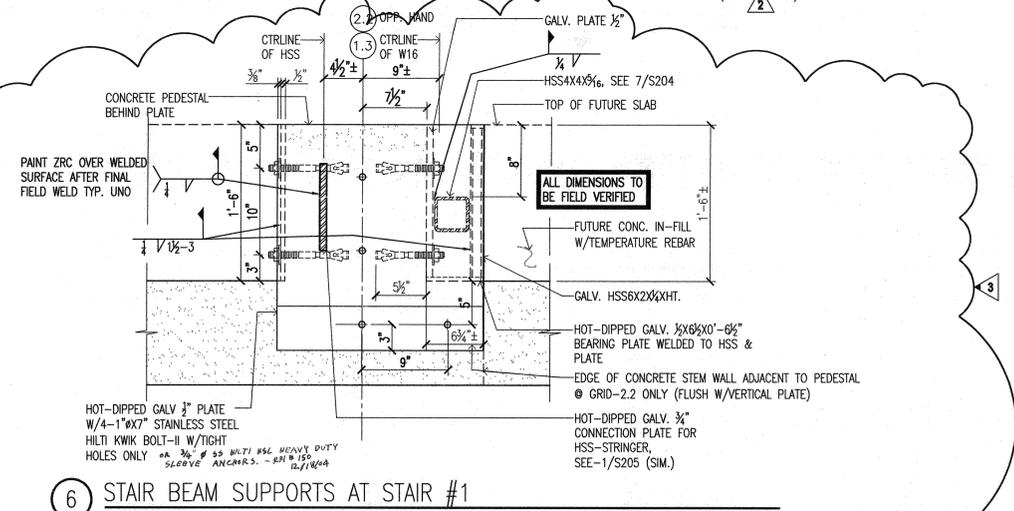


6 STAIR BEAM SUPPORTS AT STAIR #1
 NOT TO SCALE

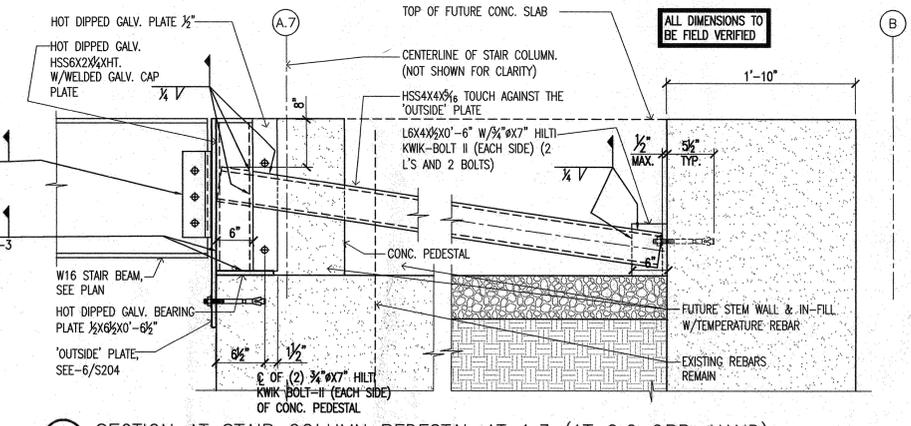

7 SECTION AT STAIR COLUMN PEDESTAL AT 1.3 (AT 2.2 OPP. HAND)
 NOT TO SCALE

1 NOT USED
 SCALE: AS NOTED

2 SECTION AT STAIR #1 AND #2 (FLOOR LEVEL)
 SCALE: 1/2"=1'-0"

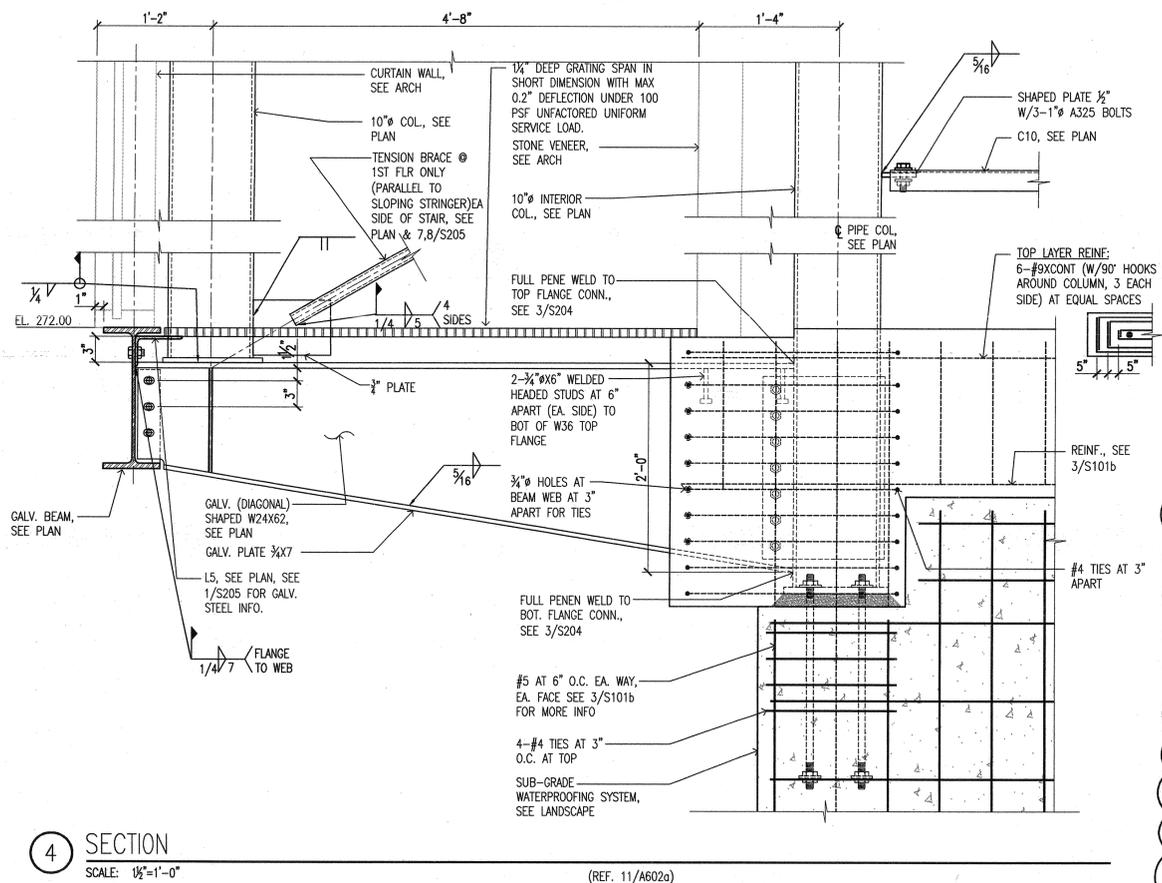

4 SECTION
 SCALE: 1/2"=1'-0"

08/12/03
 08/12/03
 08/12/03