

POLK STANLEY YEARY ARCHITECTS, LTD.
 700 SOUTH SCHILLER
 LITTLE ROCK, AR 72201
 501 378-0878
 FAX 572-7629
 21 W. MOUNTAIN, SUITE 227
 FAYETTEVILLE, AR 72701
 479-444-0473

CONSULTANTS:
 OWNER'S PROJECT ADVISOR:
 MOSES TUCKER REAL ESTATE, INC.
 CIVIL ENGINEER:
 McCLELLAND ENGINEERS
 LANDSCAPE ARCHITECT:
 LARSON BURNS SMITH
 STRUCTURAL ENGINEER:
 CROMWELL ENGINEERS INC.
 MECH., ELEC., PLUMB. ENGINEER:
 CROMWELL ENGINEERS INC.
 SUSTAINABLE CONSULTANT:
 BNIM / ELEMENTS
 GLOBAL VILLAGE CONSULTANT
 CAMBRIDGE SEVEN ASSOCIATES
 INTERIOR DESIGNER:
 POLK STANLEY YEARY
 GENERAL CONTRACTOR:
 CDI

GENERAL NOTES:

NOTES:

REVISIONS:

#	DATE	DESCRIPTION
1	6/01/2004	ASH#2
2	7/01/2004	PACKAGE-7
3	8/26/2004	ASH#17
4	9/28/2004	ASH#19


ISSUE DATE:
 DECEMBER 15, 2003
CORE/SHELL
PACKAGE #5
REVISIONS:

HEIFER INTERNATIONAL CENTER OFFICE BUILDING
 LITTLE ROCK, ARKANSAS


PSY PROJECT NUMBER:
 431C

CONTENTS:
 STAIR SECTIONS


SHEET NUMBER:
 S205

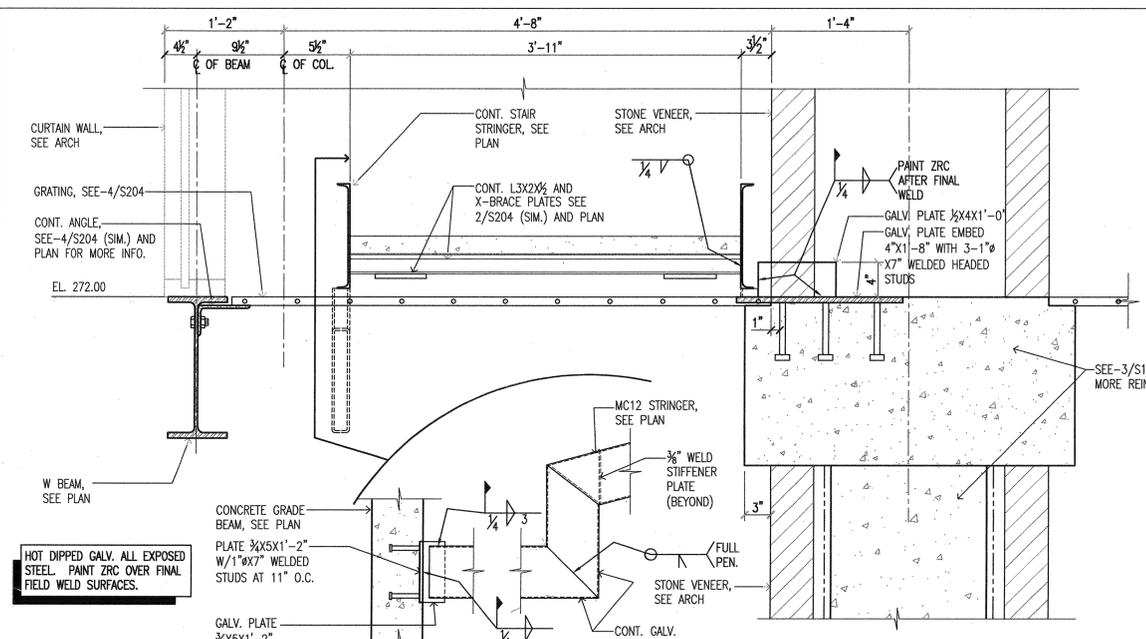

1 SECTION
 SCALE: 1/2"=1'-0"

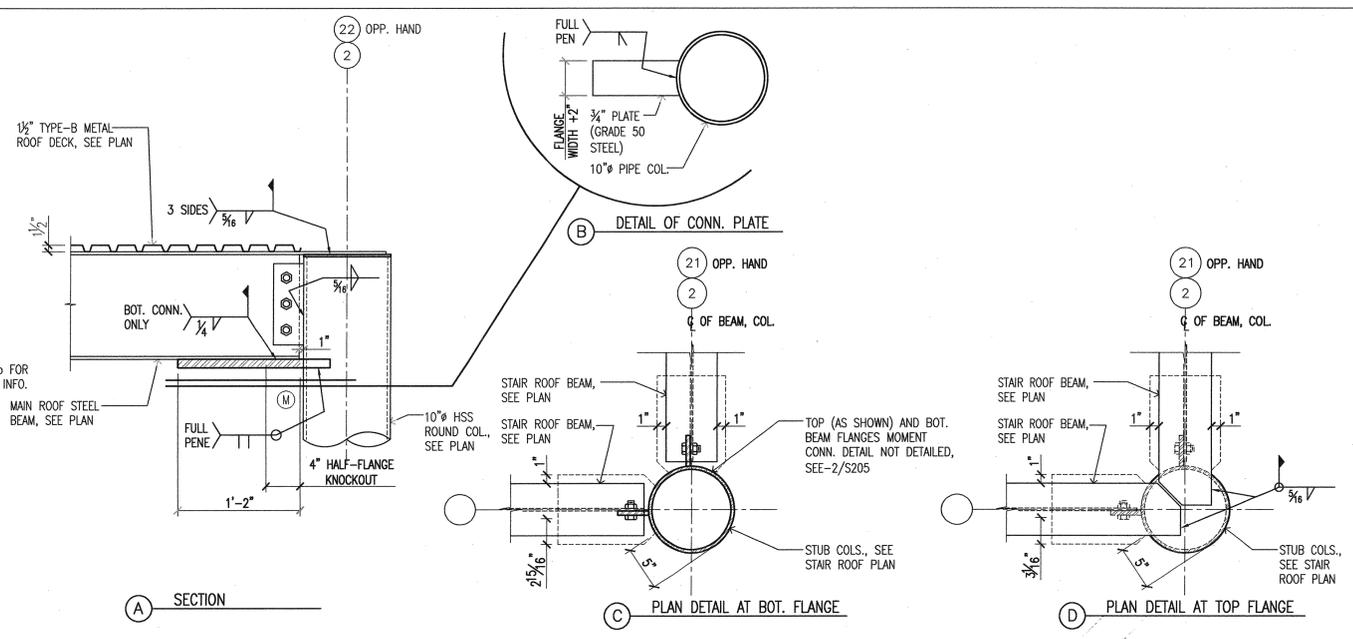


2 STAIR #1 AND #2 ROOF BEAM WITH MOMENT CONN. (LOOKING NORTH)
 SCALE: 1/2"=1'-0"

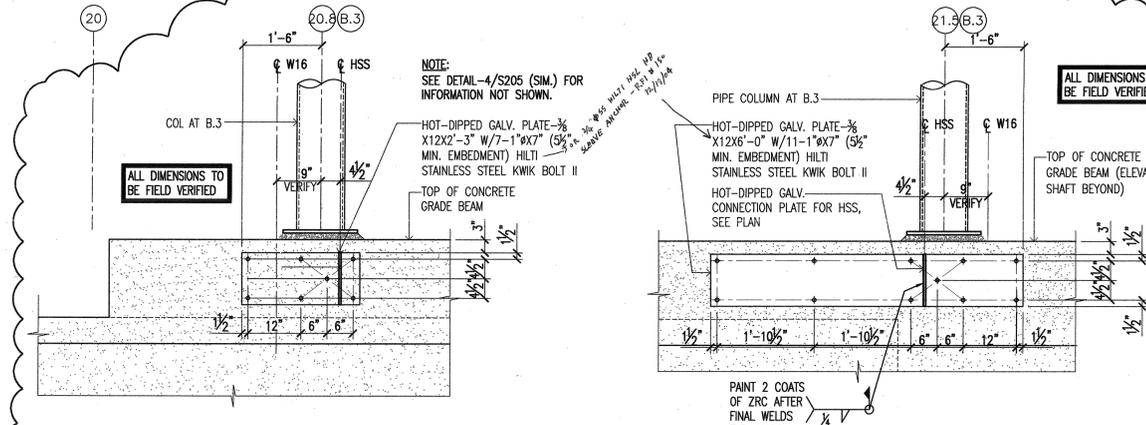


3 EXT. ELEVATION DETAIL AT GRID-20.8 (STAIR#2)
 SCALE: NO


4 EXT. ELEVATION DETAIL AT GRID-21.5 (STAIR#2)
 SCALE: NO

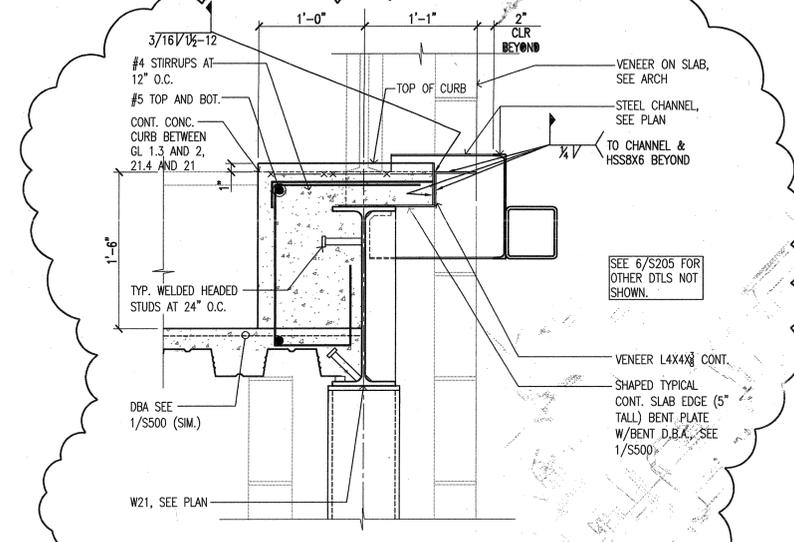


5 STAIRS #1 & 2 VENEER SUPPORT DETAIL
 SCALE: 1/2"=1'-0"

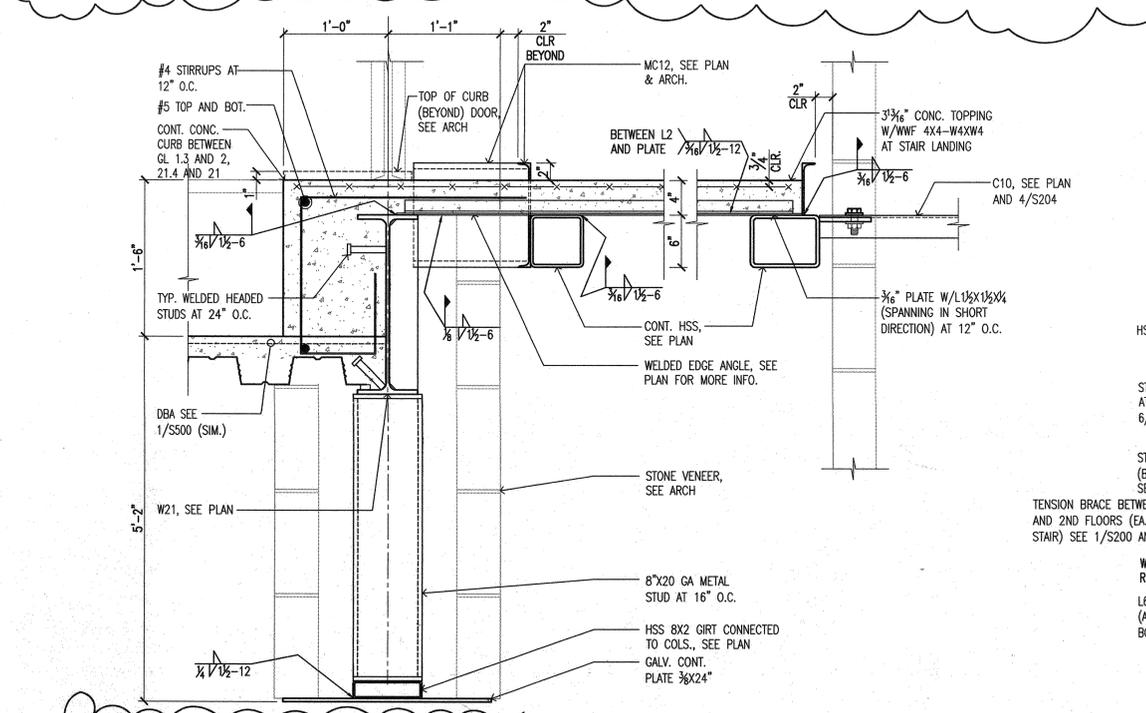

6 STAIRS #1 & 2 FLOOR LANDING DETAIL
 SCALE: 1/2"=1'-0"

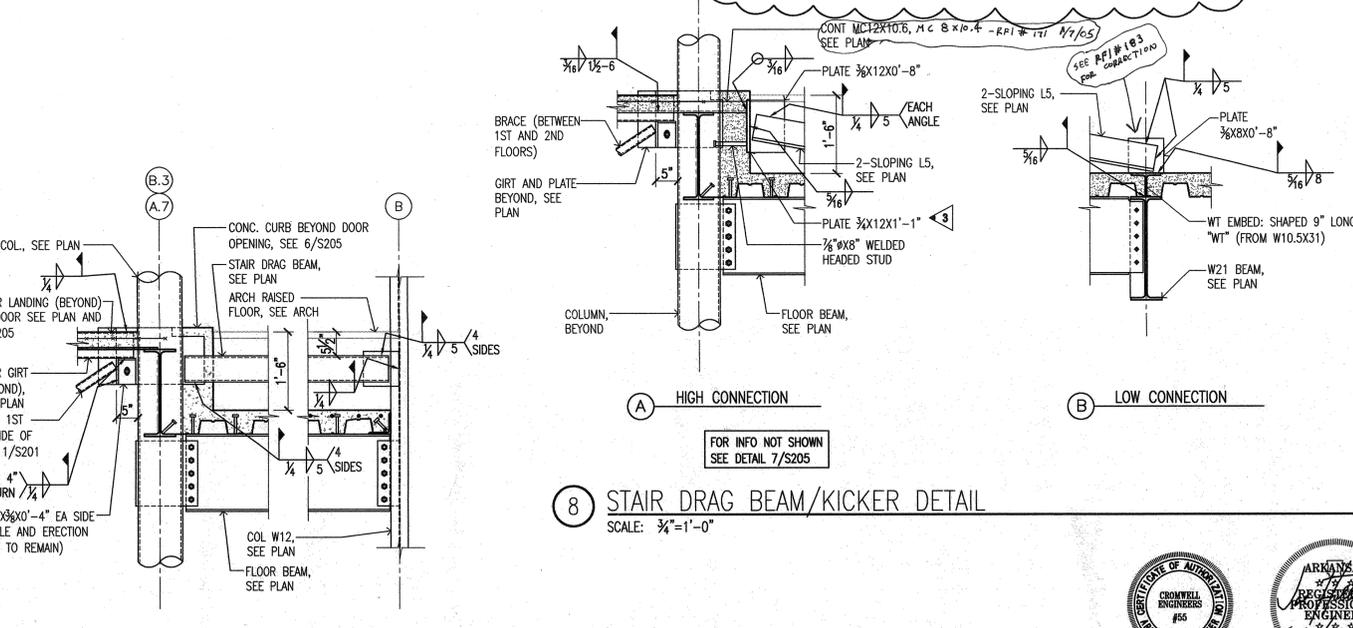

7 STAIR DRAG BEAM DETAIL
 SCALE: 3/4"=1'-0"

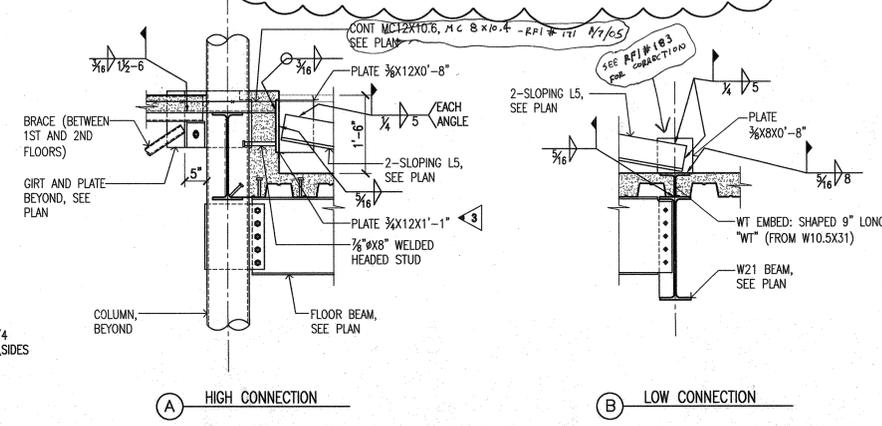

8 STAIR DRAG BEAM/KICKER DETAIL
 SCALE: 3/4"=1'-0"

