

CONSULTANTS:

OWNER'S PROJECT ADVISOR:
MOSES TUCKER REAL ESTATE, INC.

CIVIL ENGINEER:
McCLELLAND ENGINEERS

LANDSCAPE ARCHITECT:
LARSON BURNS SMITH

STRUCTURAL ENGINEER:
CROMWELL ENGINEERS INC.

MECH., ELEC., PLUMB. ENGINEER:
CROMWELL ENGINEERS INC.

SUSTAINABLE CONSULTANT:
ENM / ELEMENTS

GLOBAL VILLAGE CONSULTANT
CAMBRIDGE SEVEN ASSOCIATES

INTERIOR DESIGNER:
POLK STANLEY YEARY

GENERAL CONTRACTOR:
CDI

GENERAL NOTES:

NOTES:

ISSUE DATE:
NOVEMBER 17, 2003
STRUCTURAL/FOUNDATION
PACKAGE #4

REVISIONS:


#	DATE	DESCRIPTION
1	01/19/2004	PACKAGE 4 - ADDM 04
2	02/26/2004	PACKAGE 4 - ADDM 05
3	03/23/2004	PACKAGE 4 - ADDM 07
4	07/01/2004	PACKAGE 7
5	07/16/2004	ASH#10

**HEIFER
INTERNATIONAL
CENTER
OFFICE BUILDING**
LITTLE ROCK, ARKANSAS


PSY PROJECT NUMBER:
431C

CONTENTS:
SHEAR WALL ELEVATIONS


SHEET NUMBER:
S300

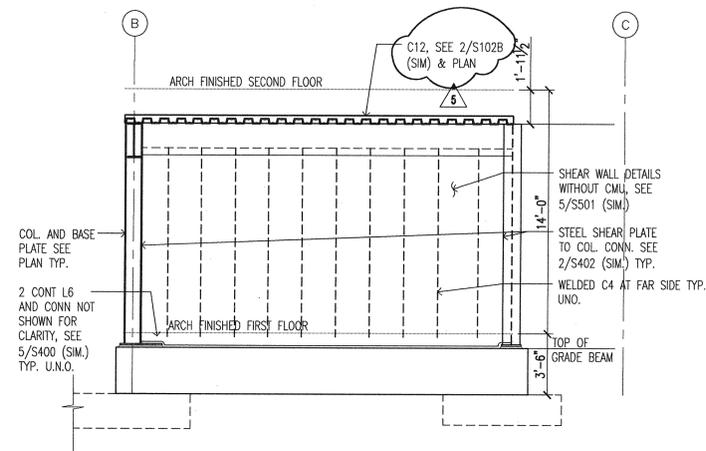


① WEST SHEAR WALL ELEVATION AT MECH. ROOM 1 AT GRID 1.3
SCALE: 1/4"=1'-0"

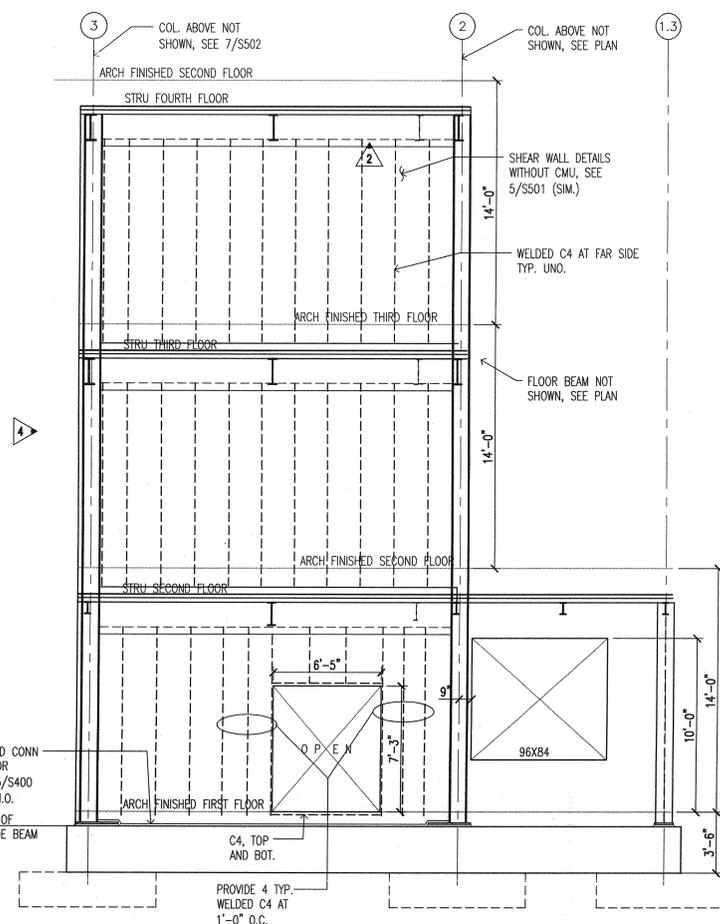

② NORTH SHEAR WALL ELEVATION AT MECH. ROOM 1 AT GRID B
SCALE: 1/4"=1'-0" NOTE: FACE OF WALL IS RADIUSED TO MATCH BUILDING.

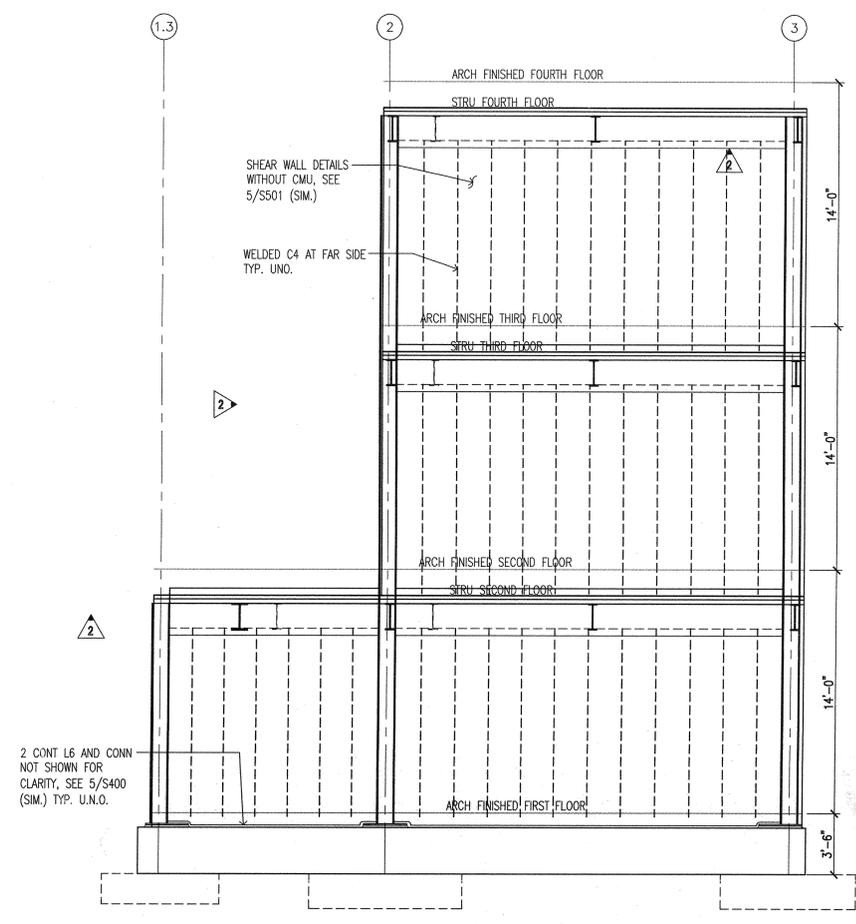

③ SOUTH SHEAR WALL ELEVATION AT MECH. ROOM 1
SCALE: 1/4"=1'-0" NOTE: FACE OF WALL IS RADIUSED TO MATCH BUILDING.

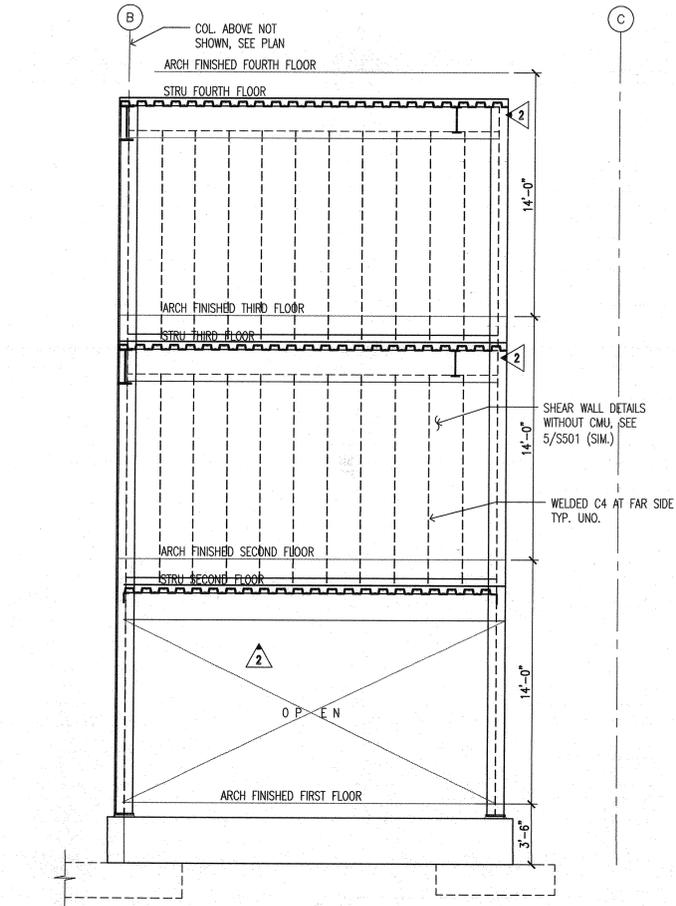

④ WEST SHEAR WALL ELEVATION AT MECH. ROOM 1 AT GRID 2
SCALE: 1/4"=1'-0"

NOTE:
VERIFY ALL OPENING SIZES
AND LOCATIONS WITH MECHANICAL
AND ARCHITECTURAL DWGS.